


**VERIFICATION FORM FOR COMMUNITY PUBLIC WATER SYSTEMS  
CLAIMING NO LEAD SERVICE LINES**

The owner or operator of all community public water systems must identify and map areas of their distribution system that are known or are likely to contain lead service lines. Systems must submit a copy of the applicable map to the Ohio Department of Health and the Ohio Department of Job and Family Services. Systems must also submit a report to the director containing at least both of the following: (1) The applicable map with narrative, and (2) A list of sampling locations used to collect samples as required by Ohio Revised Code (ORC) Section 6109.121 and any rules adopted thereunder, including contact information for the owner and occupant of each sampling site.

Should a water system determine no lead service lines exist in their distribution system, they must provide information stating they reviewed, at the minimum, historical permit records and local ordinances, distribution maintenance records and information pertaining to installation dates or materials for all services lines. This information must be verified below.

I HEREBY CERTIFY THAT THE FOLLOWING METHOD(S) WERE USED TO DETERMINE NO LEAD SERVICE LINES EXIST IN THIS WATER SYSTEM'S DISTRIBUTION SYSTEM, AS REQUIRED BY ORC 6109.121(F):

LEAD SERVICE LINE VERIFICATION
<p><b>This PWS states they have no lead service lines and has reviewed the following information (select one or more of the following):</b></p> <ul style="list-style-type: none"><li><input type="checkbox"/> Historical permit records and/or local ordinances</li><li><input checked="" type="checkbox"/> Distribution maintenance records (i.e. meter replacement, waterline break repairs)</li><li><input type="checkbox"/> Information pertaining to installation dates for all service lines (i.e. after 1986 when lead services lines were banned)</li><li><input type="checkbox"/> Service line material of all service lines is known (i.e. all service lines are known to be PVC)</li></ul>

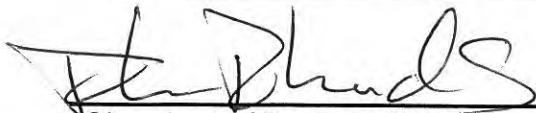  
\_\_\_\_\_  
Signature of Responsible Person                      Date 3-9-17

John Roberts                      owner  
\_\_\_\_\_  
Printed Name and Title of Responsible Person

PWS NAME: Gnon Heights  
PWS ID:    OH 1202012  
COUNTY: CLARK

<p><b>For Ohio EPA use only:</b></p> <p>Date Verification Rec'd: _____</p>
--

FEB 24 2017

Southwest District


2-20-17

Enon Heights M.H.P  
4460 Dayton Rd  
SPID Ohio 45502

Since 2003 observing Contractors Repair water supply lines. To the best of my knowledge the map is accurate as I remember. Our water lines are galvanized or Black Plastic water supply line. There are no lead water lines or shut offs in the Truiken Park. all testing over the over the years show the same results, of all possible contaminants that are required to test for, most were never detected or those that were detected they were well below the limits set by the Ohio I.P.U. In addition plumbing materials manufactured after 2014 were required to have less than 0.25% lead by weight and have the lowest risk of contributing lead to drinking water. IT should be noted however, although prohibited some use of ~~the~~ leaded components may have occurred after the prohibitions became effective



ENON HEIGHTS  
M.H.P  
4460 DIXTON RD  
SPRINGFIELD OHIO 45502

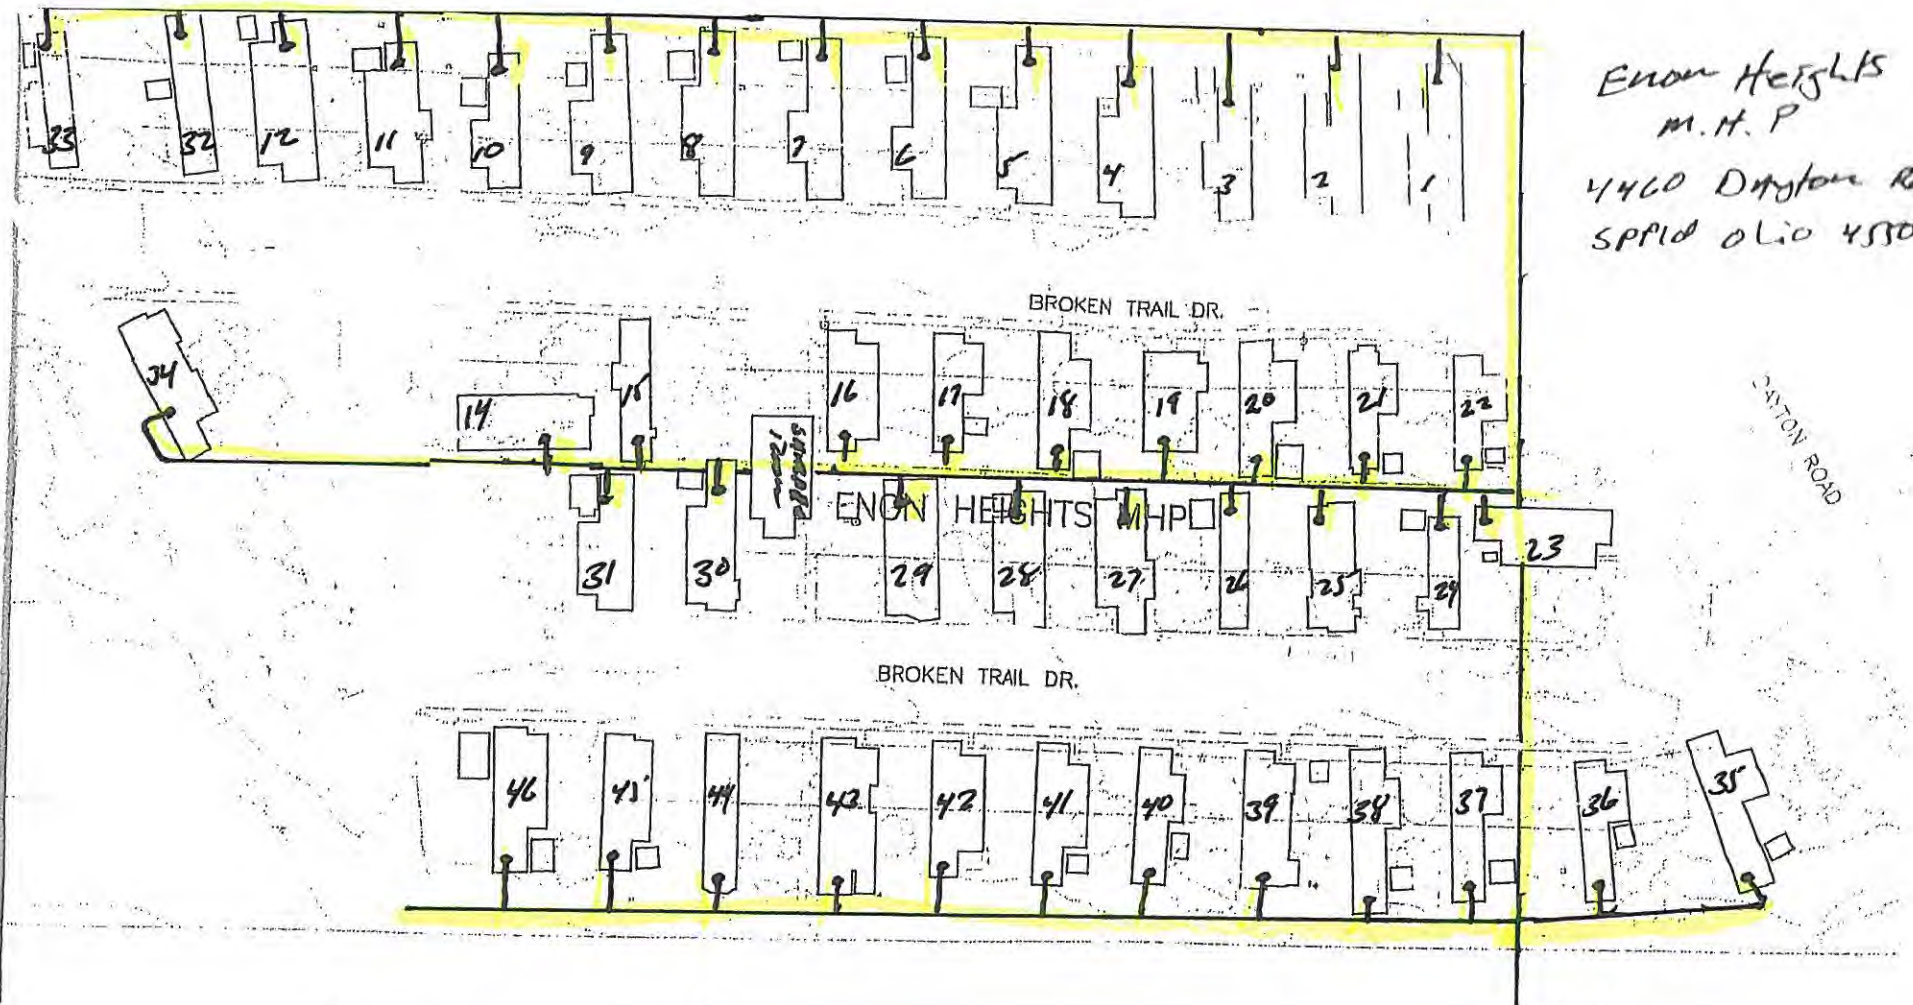

Pole Banner

Pump House

Plastic & Salvage  
Water Lines

NO Lead  
Service Lines @ Pipes

Building in Ohio Built prior to 1994 or that used Plumbing material or solder Manufactured before 1994 may have materials with greater ~~RESISTANCE~~ <sup>LEAD</sup> and are ~~at~~ at a higher risk of contributing Lead <sup>TO THE</sup> Drinking than materials Manufactured after 1994. In addition <sup>TO</sup> Buildings Built and plumbing materials manufactured after 2014 were Required to have less than 0.25% Lead BY weight and have the LOWEST <sup>SOUBSE</sup> ~~RISK~~ <sup>RISK</sup> for contributing lead to the drinking water. It should be noted however that, although prohibited some use of Leaded solder or Lead components may have occurred after the prohibitory became effective.

# What's in the Water?

RECEIVED  
OHIO EPA

FEB 24 2017

Southwest District

## *A report on the water quality at the Enon Heights Mobile Home Park*

The Enon Heights Mobile Home Park has been providing water to its residents for many years. As a public water system, we are required by certain government agencies to do regular testing of the water to insure that it is safe.

The US Environmental Protection Agency is now requiring all community water systems to provide a report to the consumers on the quality of the water. With the assistance of our certified water operators, we have compiled the following report.

We are pleased to report that of the five possible contaminants that we are required to test for, most were never detected. Of those that were detected, they were below the limits set by the Ohio Environmental Protection Agency. This information is presented in a chart on page two.

Because much of the information in this report is technical in nature, we encourage you to call the EPA Safe Drinking Water Hotline (1-800-426-4791), if you have any questions.