


VILLAGE OF LOCKLAND, OHIO

WATER RECORDS

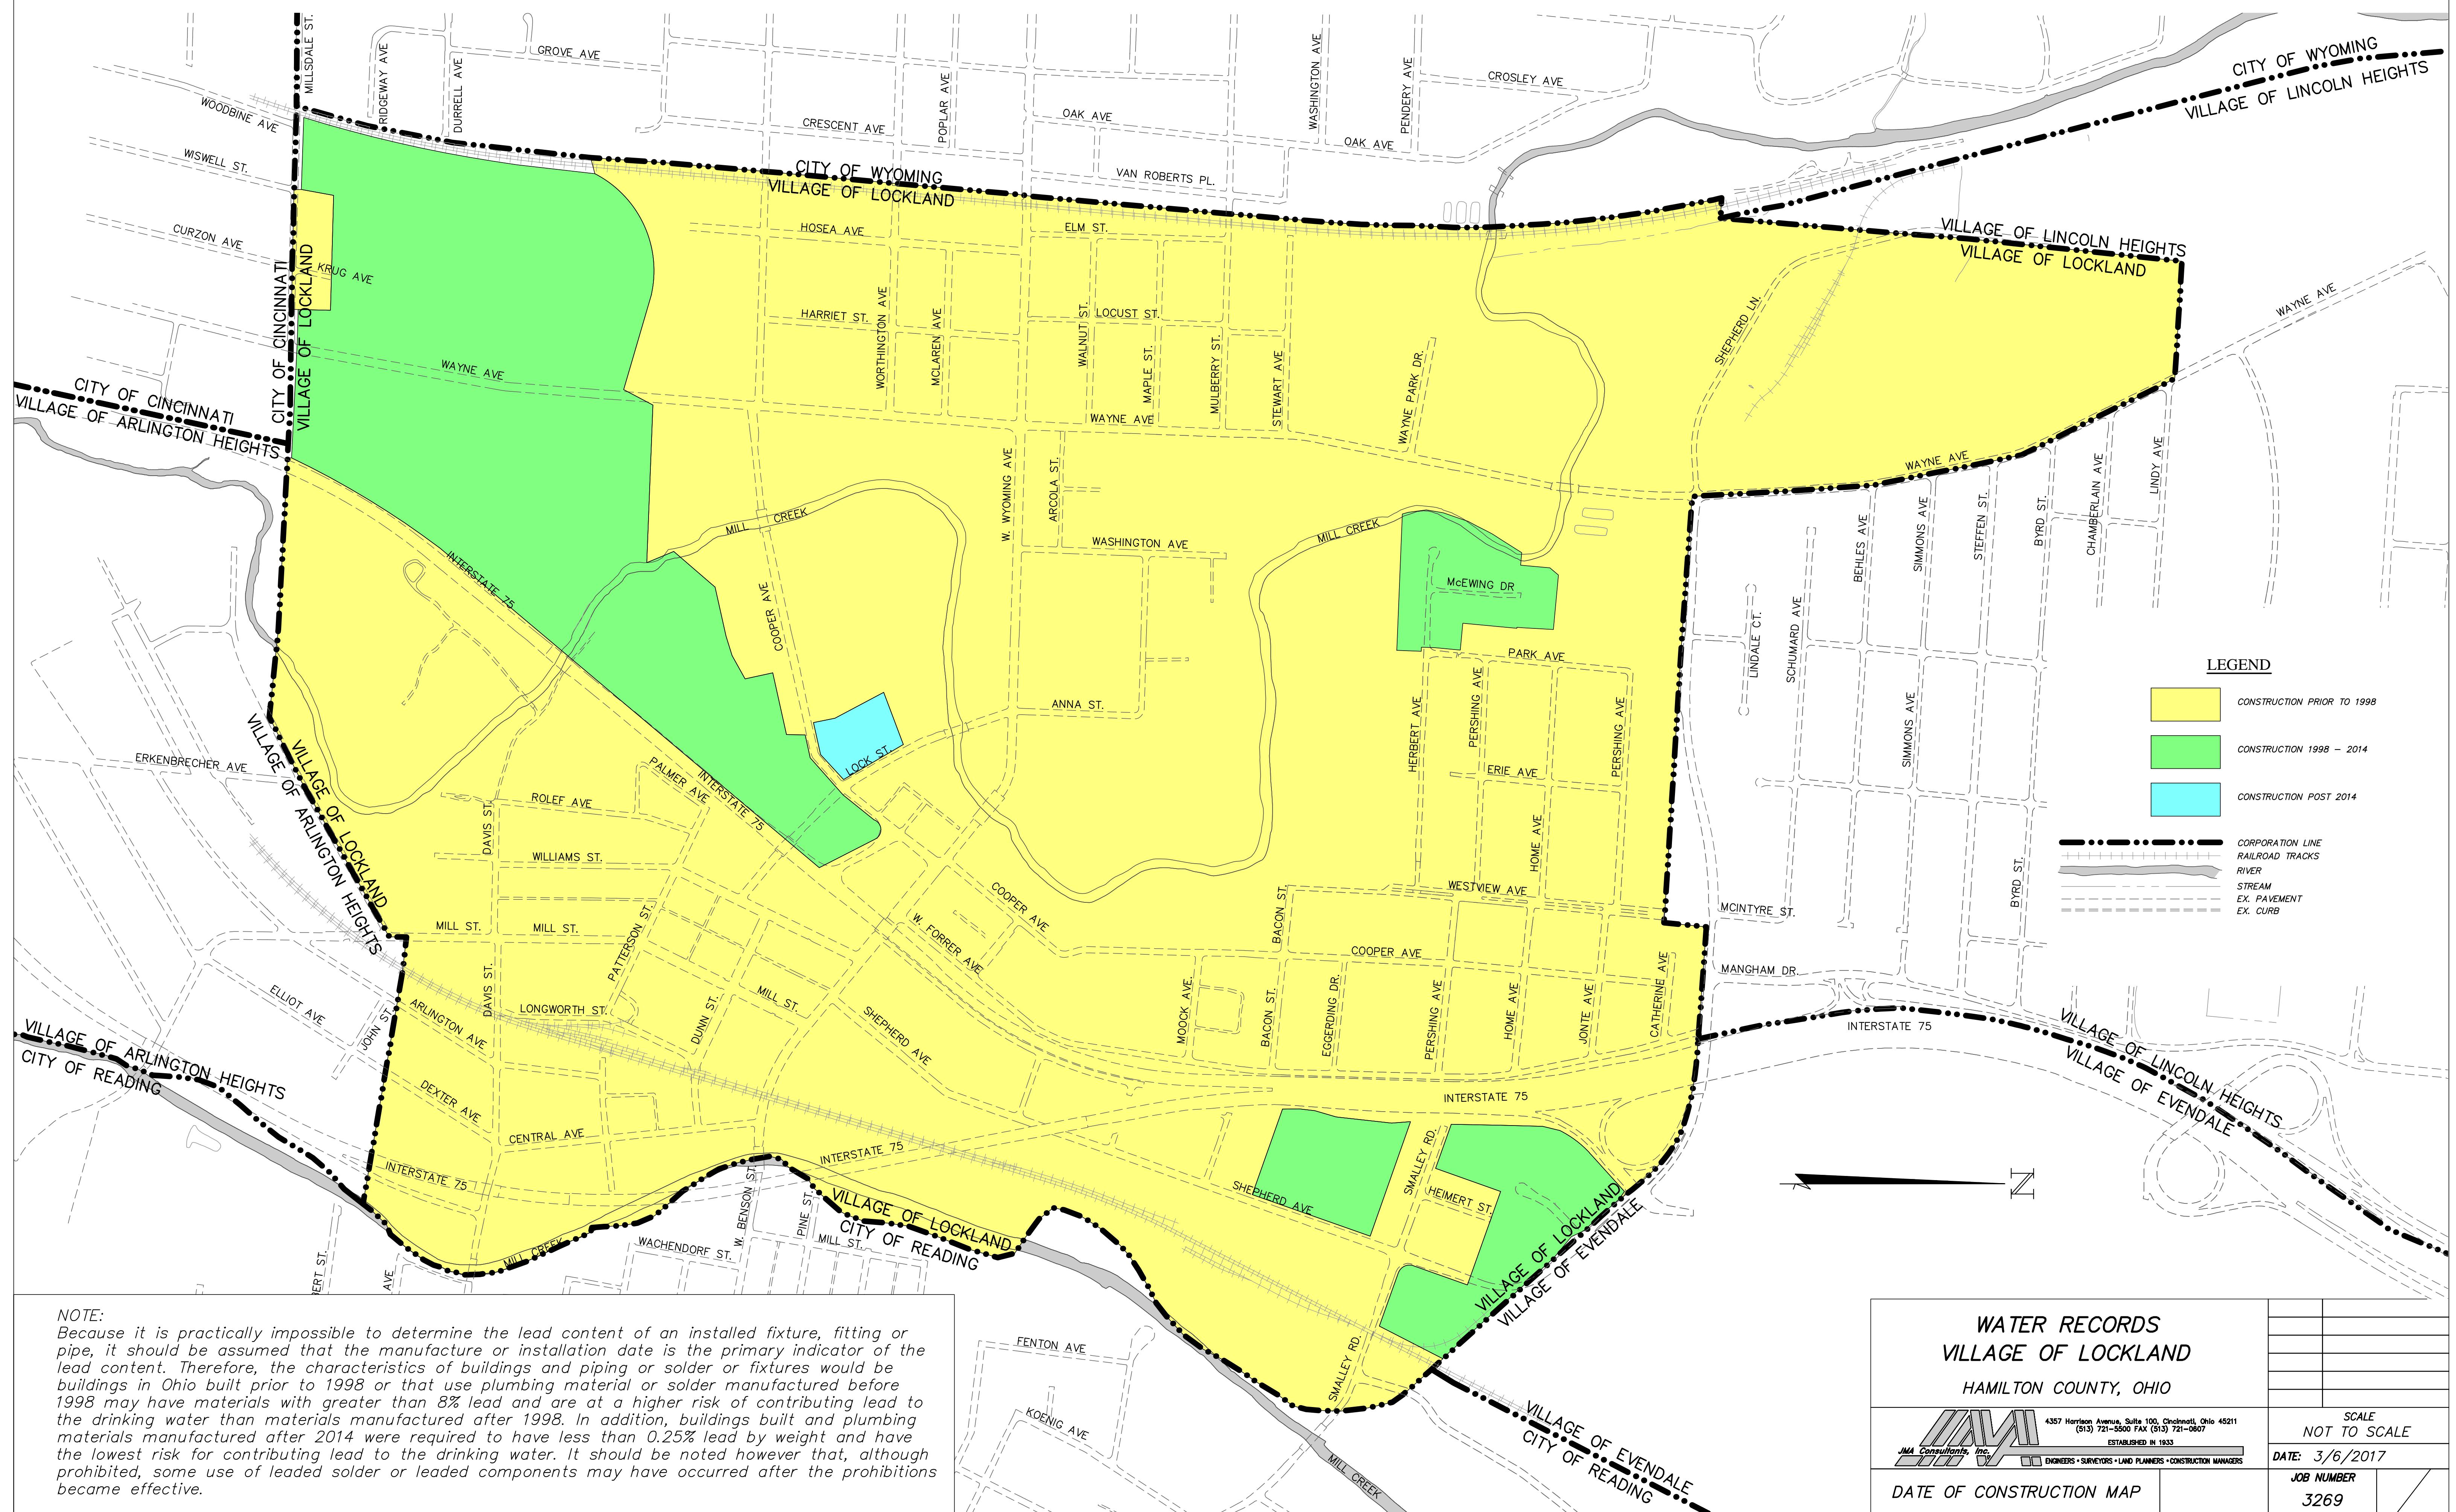

LOCKLAND, OHIO WATER DISTRICT

Water Service Mapping Project

The Village of Lockland was established in 1828. The majority of the Village streets and water mains serve residential homes. Office, retail and light industrial buildings are confined primarily to the following streets: Wyoming Avenue, S. Cooper Avenue, Shepherd Drive, Anthony Wayne, Smalley Road, and Mill Street.

Because it is practically impossible to determine the lead content of an installed fixture, fitting or pipe, it should be assumed that the manufacture or installation date is the primary indicator of the lead content. Therefore, the characteristics of buildings and piping or solder or fixtures would be buildings in Ohio built prior to 1998 or that use plumbing material or solder manufactured before 1998 may have materials with greater than 8% lead and are at a higher risk of contributing lead to the drinking water than materials manufactured after 1998. In addition, buildings built and plumbing materials manufactured after 2014 were required to have less than 0.25% lead by weight and have the lowest risk for contributing lead to the drinking water. It should be noted however that, although prohibited, some use of leaded solder or leaded components may have occurred after the prohibitions became effective.

Approximately 95% of the residential homes were built prior to 1998 with only a few homes built in the 2000's. The majority of office, retail and light industrial buildings were built prior to 1998 with the exception of 3 office parks which were built in the 2000's. These three office park water services are all copper.

The source of Lockland's drinking water is three wells, about 200 feet deep, each having the capacity to pump 700 to 900 gallons per minute, that's more than 1,000,000 gallons per day. The wells are located three miles north of Lockland in Sharonville, Ohio. This source has provided a dependable water supply since the early 1940's.

The wells are susceptible to contamination due to the sensitive nature of the sand and gravel aquifer in which the water wells are located and existing potential contaminant sources (e.g. commercial and manufacturing establishments). The wells' depth, however, of about 200 feet, provides some natural protection against the downward migration of contamination.

Since 1999, in order to minimize any future potential contamination to the well field, Lockland has been active in implementing EPA recommended strategies, including:

- Wellhead Protection Delineation in 1999
- Wellhead Protection Inventory of Potential Pollution Sources in 2001
- Resurvey of Potential Sources in 2002, 2003, 2007, and 2008
- In the spring of 2015 another Resurvey of Potential Sources was initiated
- Implemented Wellhead Management Plan in 2003

Ohio EPA awarded Lockland a certificate commending the Village for our Wellhead Protection Program.


The well water is pumped from the well field to the Lockland water treatment plant for the following processes:


- *Reduce the Well Water Hardness.* The well water hardness, averaging 385 mg/l (parts per million), is reduced to an average of 170 mg/l by adding lime (calcium hydroxide) to precipitate the hardness as calcium carbonate.
- *Stabilization.* Corrosion and lime scale deposits in the water distribution system and residential plumbing are minimized by adjusting the water pH with carbon dioxide and adding 1 mg/l sodium hexameta phosphate (Calgon).
- *Treatment.* Is achieved by the addition of chlorine to the water. The average chlorine residual in the distribution system was 0.2 mg/l; the maximum was 0.5 mg/l. The EPA maximum residual is 4.0 mg/l.
- *Filtration.* Is achieved by running the water through 2 sand and gravel gravity filters before distribution to Lockland customers.

The Village of Lockland has made a visual survey of the water taps as they enter each home or business to read meters. The results were added to the water system maps. Lead lines were shown as yellow on the maps and non-lead lines were shown as green on the maps. These determinations were made for the portion of the service lines from the stop cock to the meter. If the Village was not able to make a visual determination of the service line, then the service line was shown as grey on the maps. To date there are 58 addresses with lead service lines, 528 addresses without lead service lines and 818 addresses that are unknown. Please see the maps and spreadsheets for the locations.

VILLAGE OF LOCKLAND, OHIO

WATER RECORDS

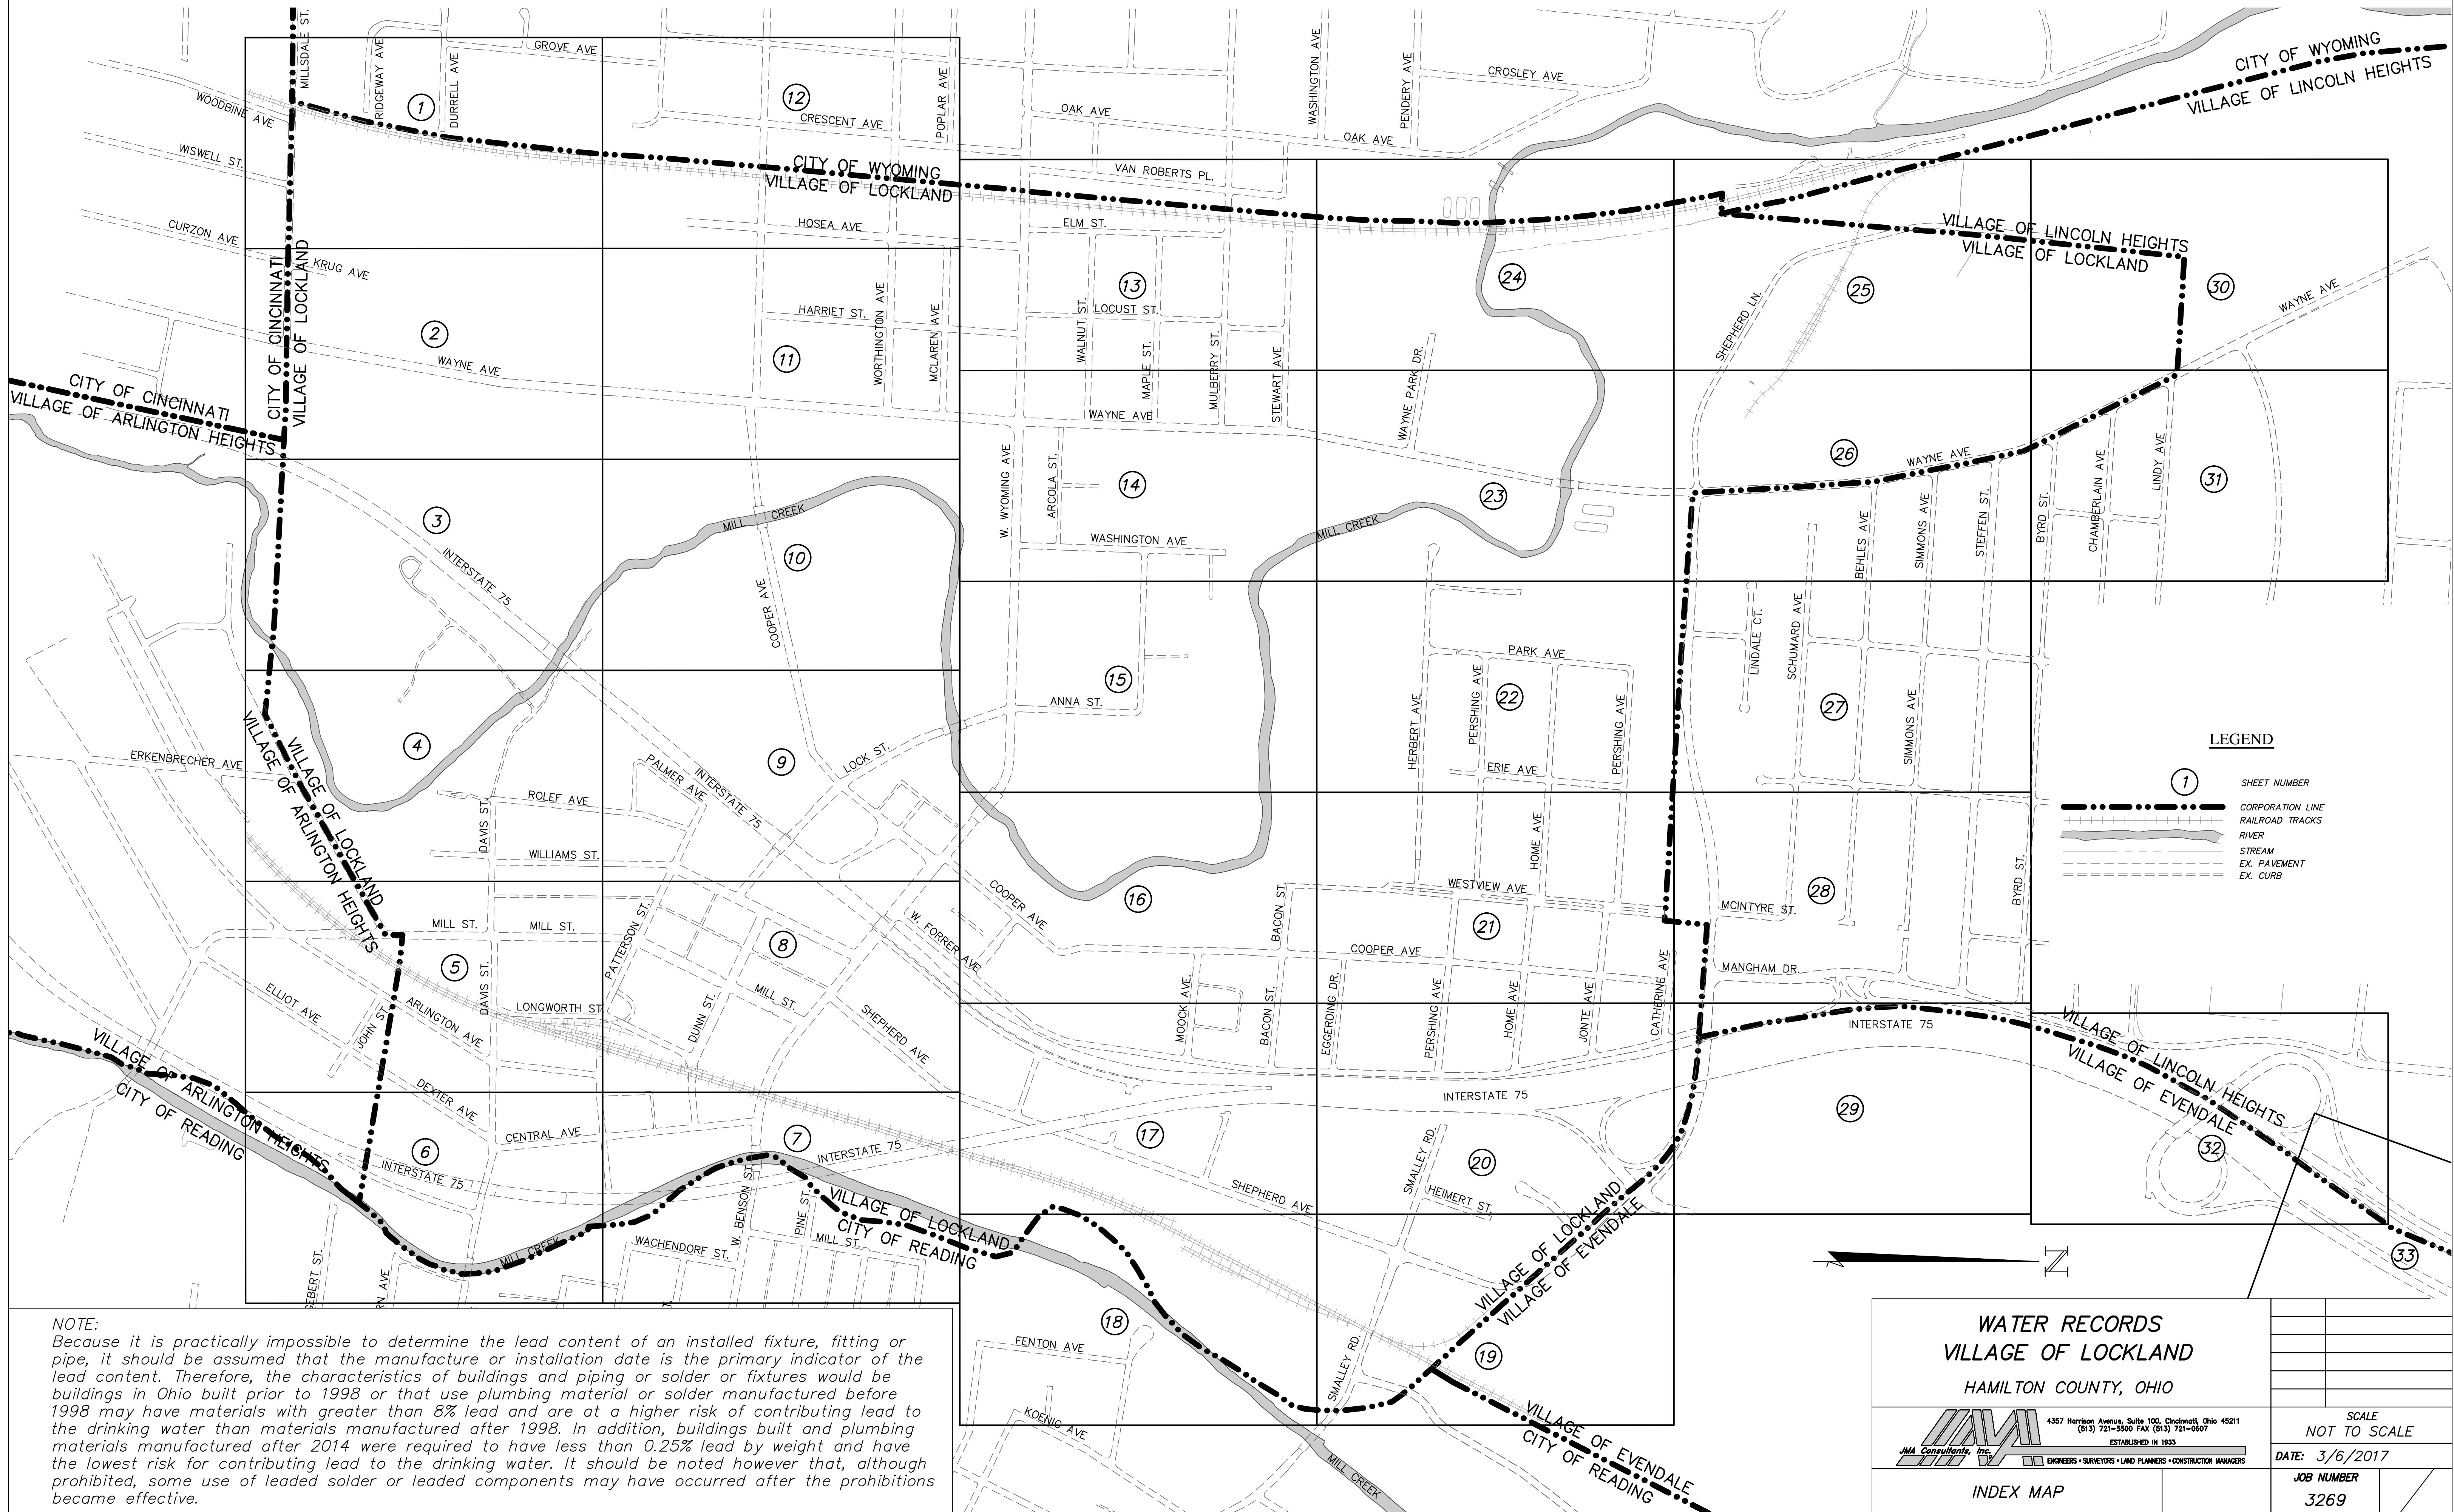

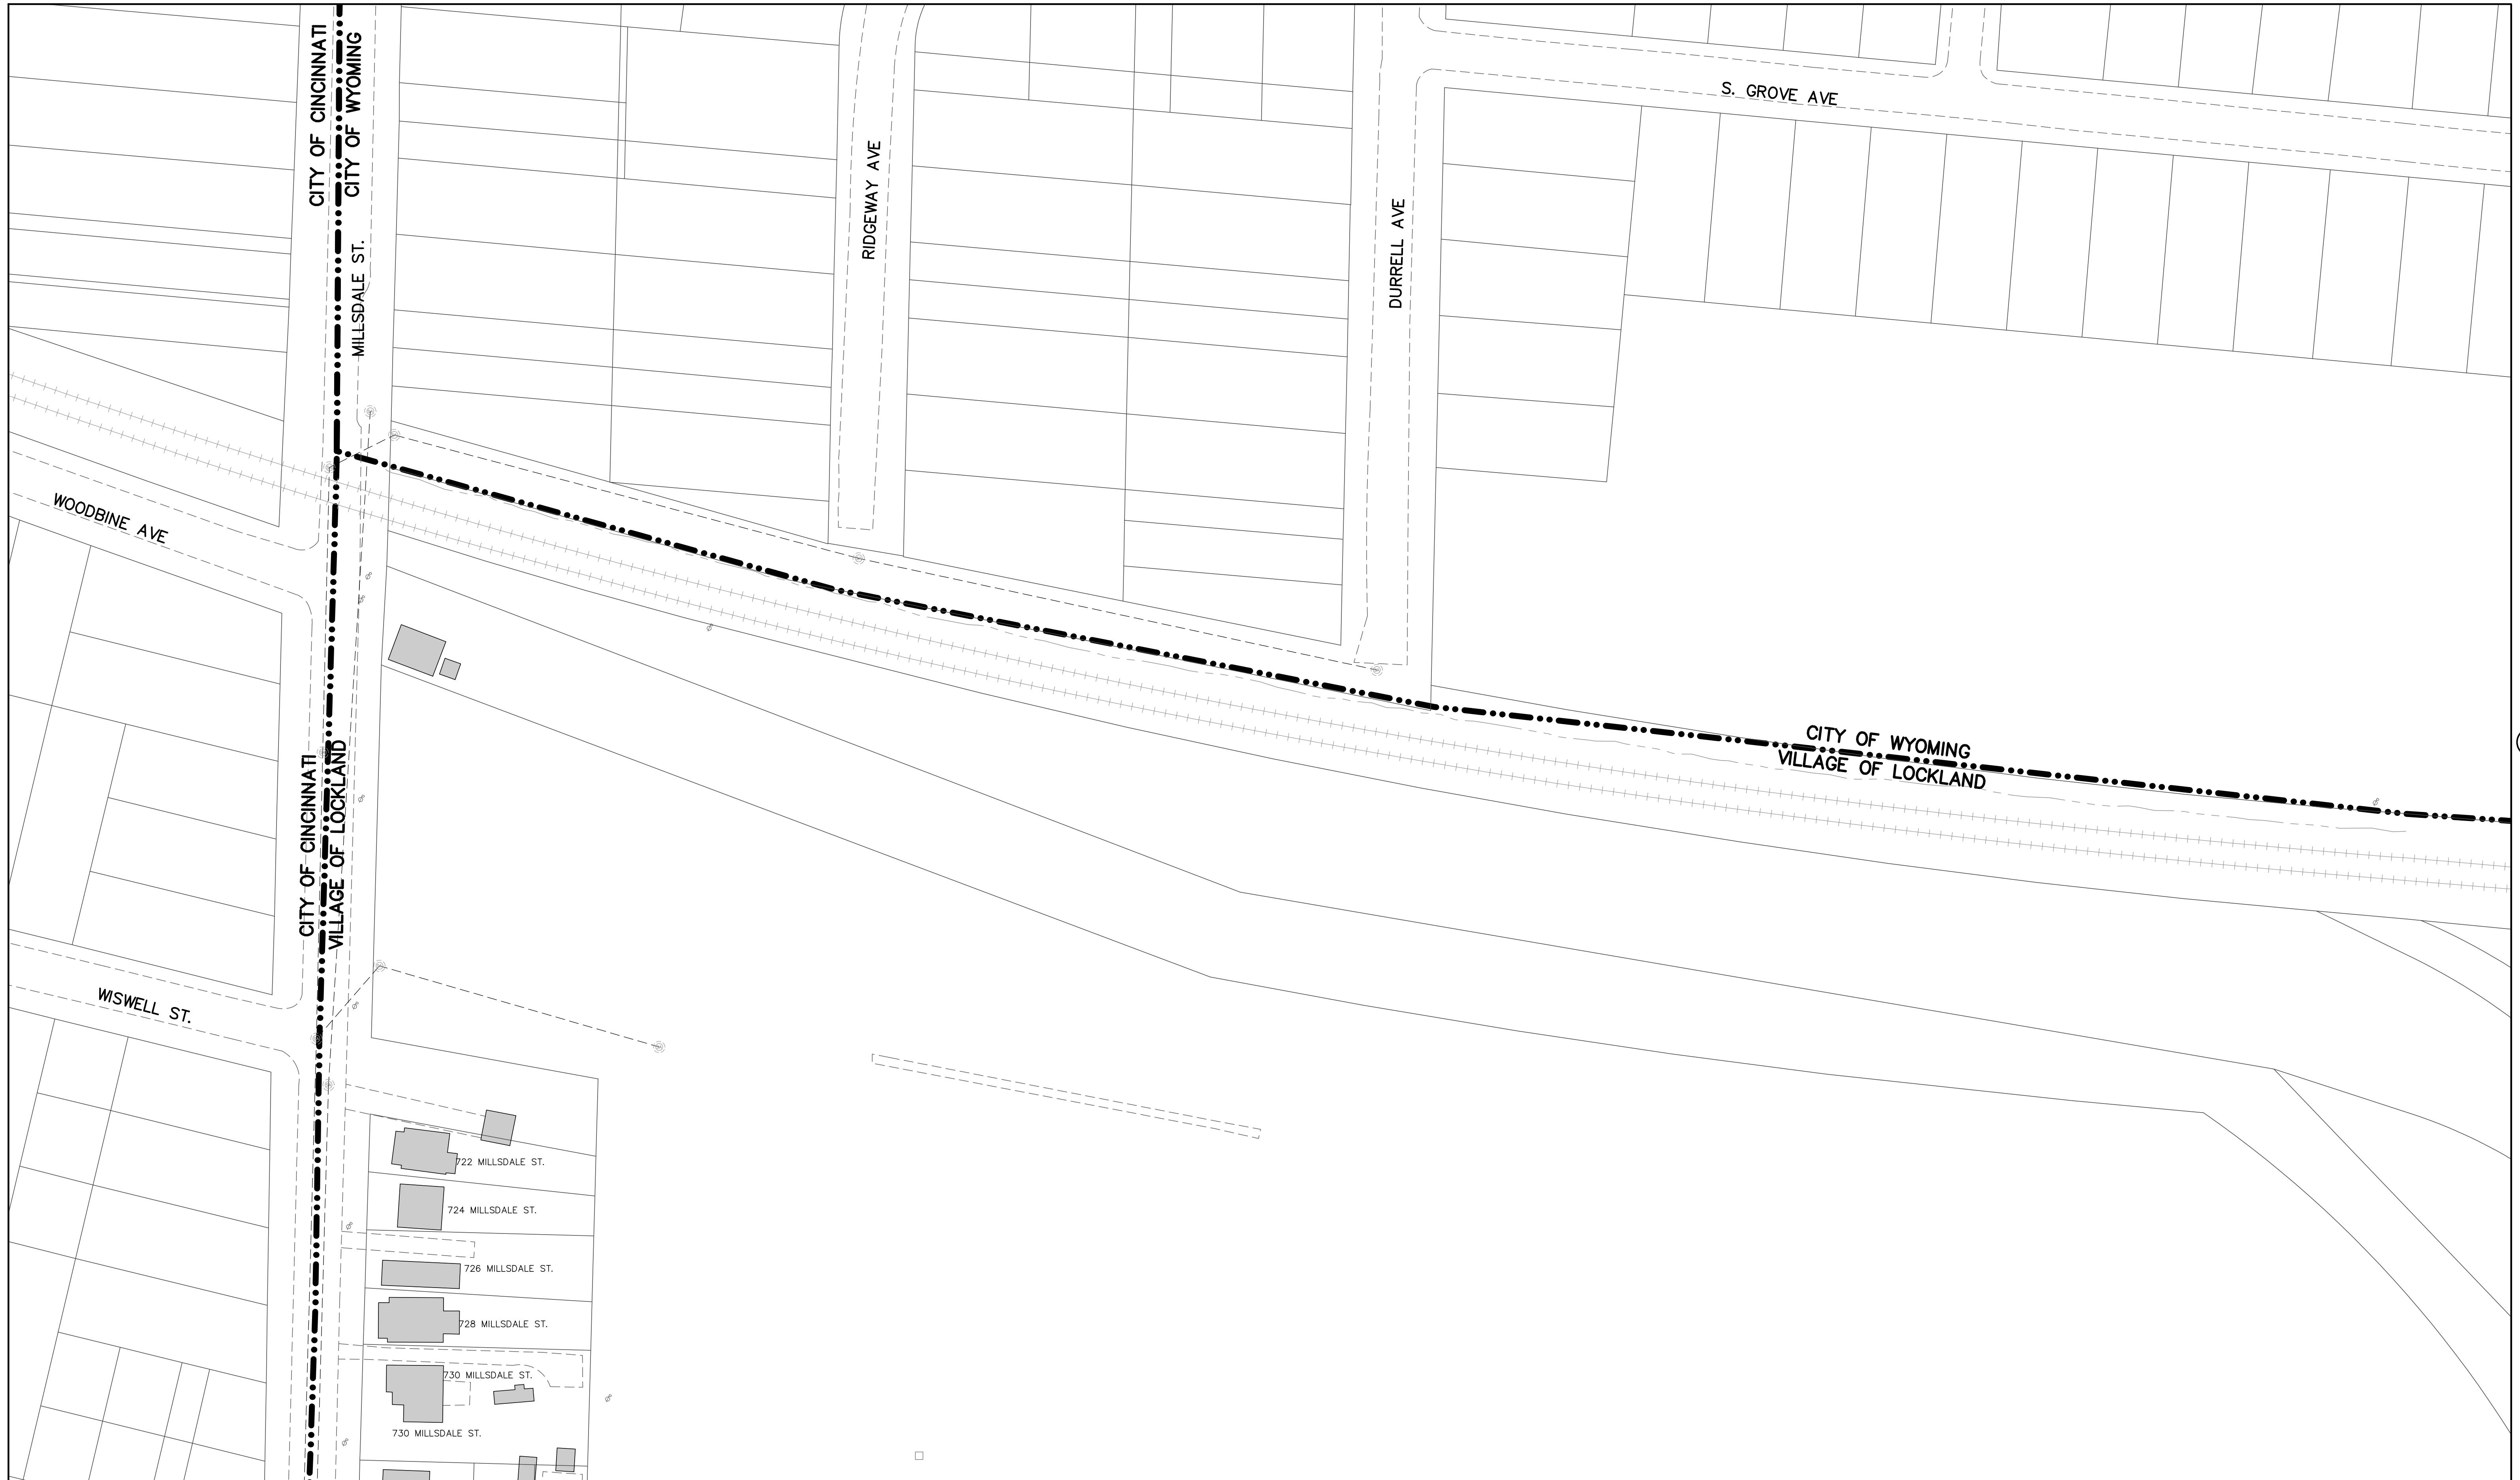

LEGEND

○ F.H.	EX. FIRE HYDRANT
☒ W.V.	EX. WATER VALVE
○ W.M.	EX. WATER METER
○ W.B.	EX. WATER BOX
○ CWDV	EX. WATER VALVE CHAMBER
☒ W.V.	EX. WATER VALVE M.H.
☒ U.P.	EX. UTILITY POLE
☒ S.M.H.	EX. SANITARY M.H.
☒ I.	EX. INLET
☒ ADJACENT SHEET NUMBER	

	BUILDING WITH LEAD WATER SERVICE BUILT PRIOR TO 1998 FROM STOP COCK TO METER
	BUILDING WITH NON-LEAD WATER SERVICE BUILT PRIOR TO 2014 FROM STOP COCK TO METER
	BUILDING WITH NO INFORMATION ON WATER SERVICE

(2)

SCALE : 1" = 50'
0 25 50 100

WATER RECORDS
VILLAGE OF LOCKLAND
HAMILTON COUNTY, OHIO

4357 Harrison Avenue, Suite 100, Cincinnati, Ohio 45211
(513) 721-5500 FAX (513) 721-0607
ESTABLISHED IN 1933
JMA Consultants, Inc. ENGINEERS • SURVEYORS • LAND PLANNERS • CONSTRUCTION MANAGERS

SCALE
1"=50'
DATE: 3/6/2017
JOB NUMBER
3269 1 / 36




LEGEND

○ F.H.	EX. FIRE HYDRANT
☒ W.V.	EX. WATER VALVE
○ W.M.	EX. WATER METER
○ W.B.	EX. WATER BOX
○ CWDV	EX. WATER VALVE CHAMBER
○ W.V.	EX. WATER VALVE M.H.
☒	EX. UTILITY POLE
○	EX. SANITARY M.H.
○	EX. INLET
○	ADJACENT SHEET NUMBER

	BUILDING WITH LEAD WATER SERVICE BUILT PRIOR TO 1998 FROM STOP COCK TO METER
	BUILDING WITH NON-LEAD WATER SERVICE BUILT PRIOR TO 2014 FROM STOP COCK TO METER
	BUILDING WITH NO INFORMATION ON WATER SERVICE

(3)


**WATER RECORDS
VILLAGE OF LOCKLAND

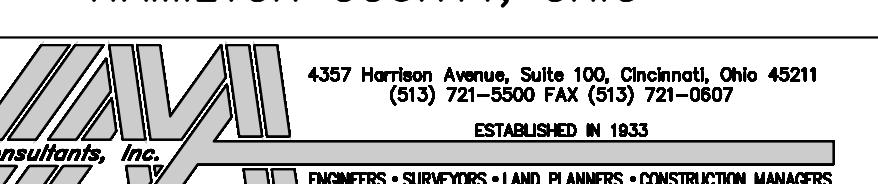


SCALE
1" = 50'
DATE: 3/6/2017

JOB NUMBER
3269 2 / 36

(2)

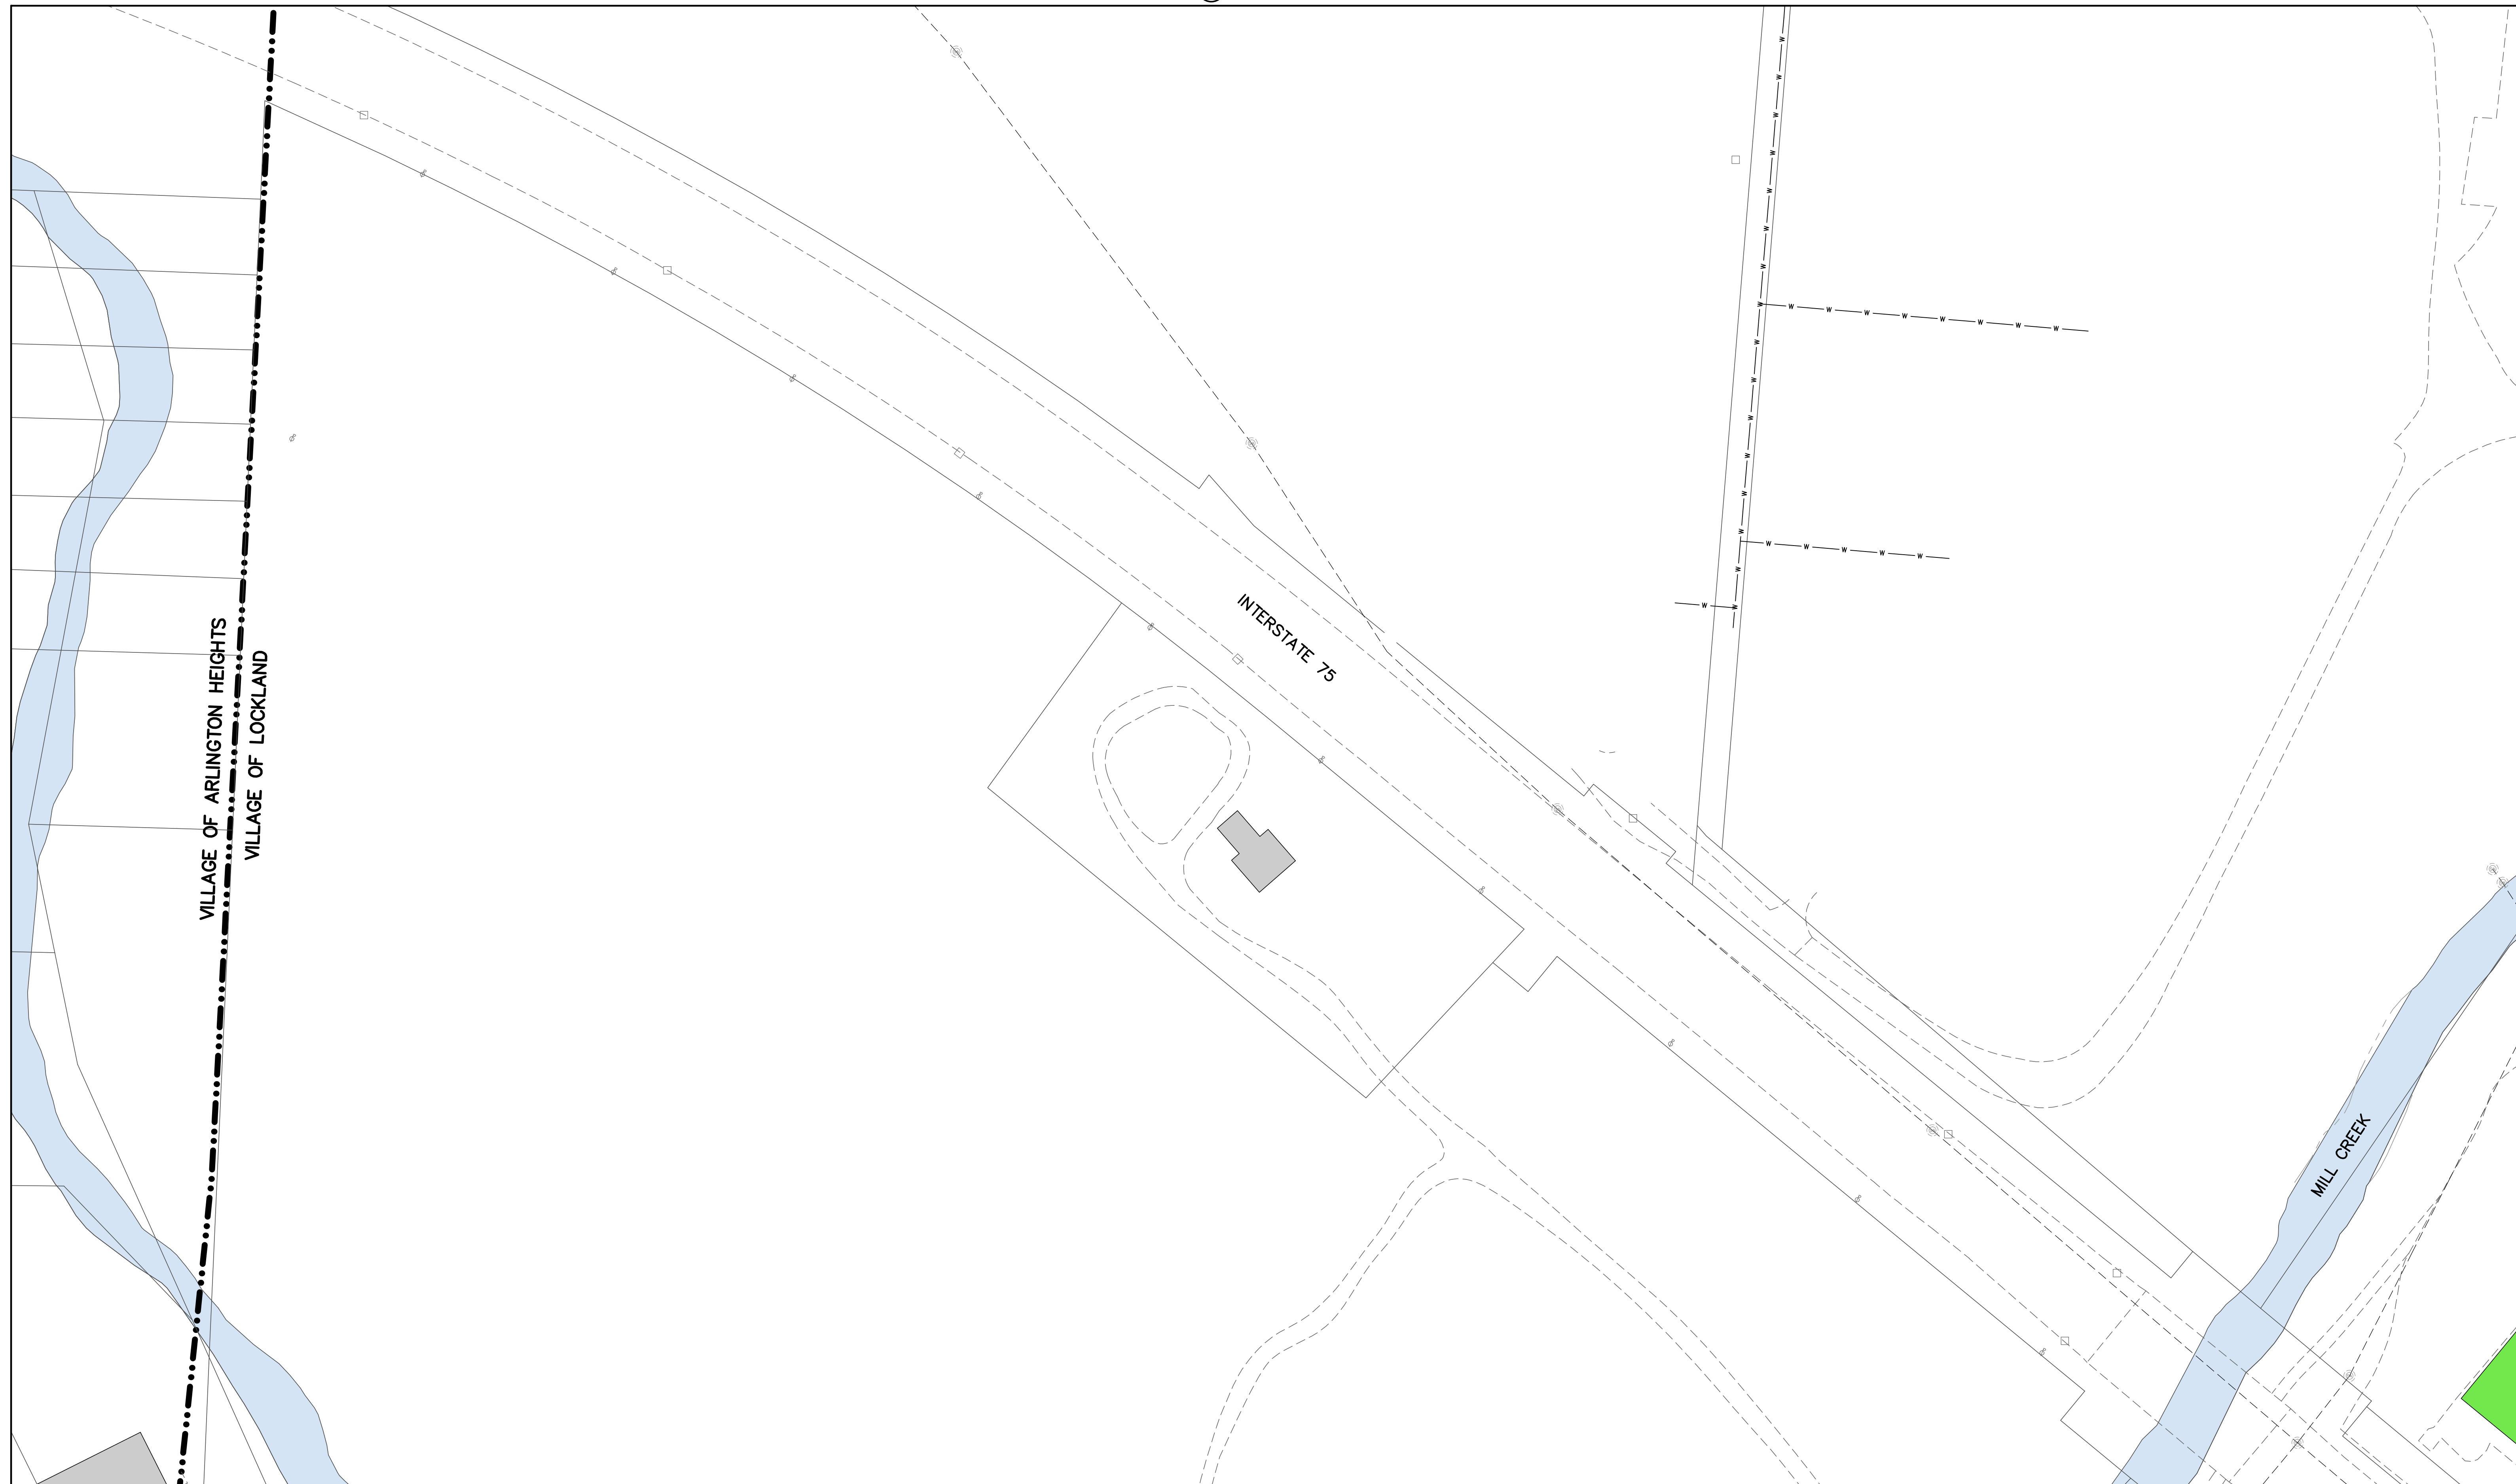

(4)

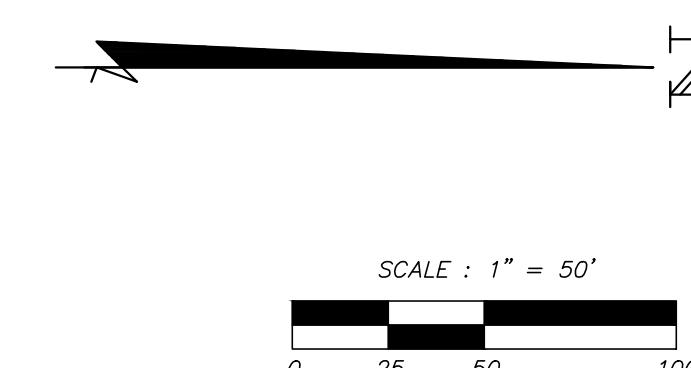

WATER RECORDS
VILLAGE OF LOCKLAND
HAMILTON COUNTY, OHIO

JMA Consultants, Inc. 4357 Harrison Avenue, Suite 100, Cincinnati, Ohio 45211
(513) 721-5500 FAX (513) 721-0607
ESTABLISHED IN 1933
ENGINEERS • SURVEYORS • LAND PLANNERS • CONSTRUCTION MANAGERS

SCALE
1" = 50'
DATE: 3/6/2017
JOB NUMBER
3269


LEGEND


○ F.H.	EX. FIRE HYDRANT
☒ W.V.	EX. WATER VALVE
○ W.M.	EX. WATER METER
○ W.B.	EX. WATER BOX
○ CWDV	EX. WATER VALVE CHAMBER
☒ W.V.	EX. WATER VALVE M.H.
☒ W.M.	EX. UTILITY POLE
☒ W.B.	EX. SANITARY M.H.
☒ W.V.	EX. INLET
○ ADJACENT SHEET NUMBER	

— W — EX. 4" W.M. — W —	EX. WATER MAIN

BUILDING WITH NO INFORMATION ON WATER SERVICE

WATER RECORDS
VILLAGE OF LOCKLAND

HAMILTON COUNTY, OHIO

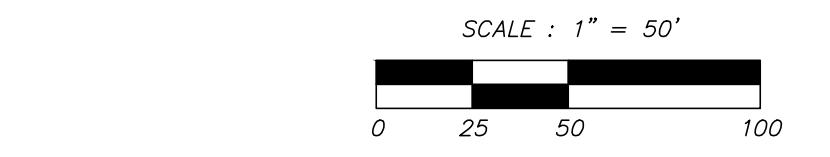
 SCALE
1" = 50'
4357 Harrison Avenue, Suite 100, Cincinnati, Ohio 45211
(513) 721-5500 FAX (513) 721-0607
ESTABLISHED IN 1933

DATE: 3/6/2017

 JOB NUMBER
3269

4 / 36



LEGEND

F.H.	EX. FIRE HYDRANT
W.V.	EX. WATER VALVE
W.M.	EX. WATER METER
W.B.	EX. WATER BOX
CWDV	EX. WATER VALVE CHAMBER
W.V.	EX. WATER VALVE M.H.
	EX. UTILITY POLE
	EX. SANITARY M.H.
	EX. INLET
	ADJACENT SHEET NUMBER

	BUILDING WITH LEAD WATER SERVICE BUILT PRIOR TO 1998 FROM STOP COCK TO METER
	BUILDING WITH NON-LEAD WATER SERVICE BUILT PRIOR TO 2014 FROM STOP COCK TO METER
	BUILDING WITH NO INFORMATION ON WATER SERVICE
	STREAM
	EX. PAVEMENT
	EX. CURB
	EX. PROPERTY LINE

(6)

(4)


(8)

**WATER RECORDS
VILLAGE OF LOCKLAND

4357 Harrison Avenue, Suite 100, Cincinnati, Ohio 45211
(513) 721-5500 FAX (513) 721-0607
ESTABLISHED IN 1933
JMA Consultants, Inc. ENGINEERS • SURVEYORS • LAND PLANNERS • CONSTRUCTION MANAGERS

SCALE
1" = 50'
DATE: 3/6/2017

JOB NUMBER
3269 5 / 36

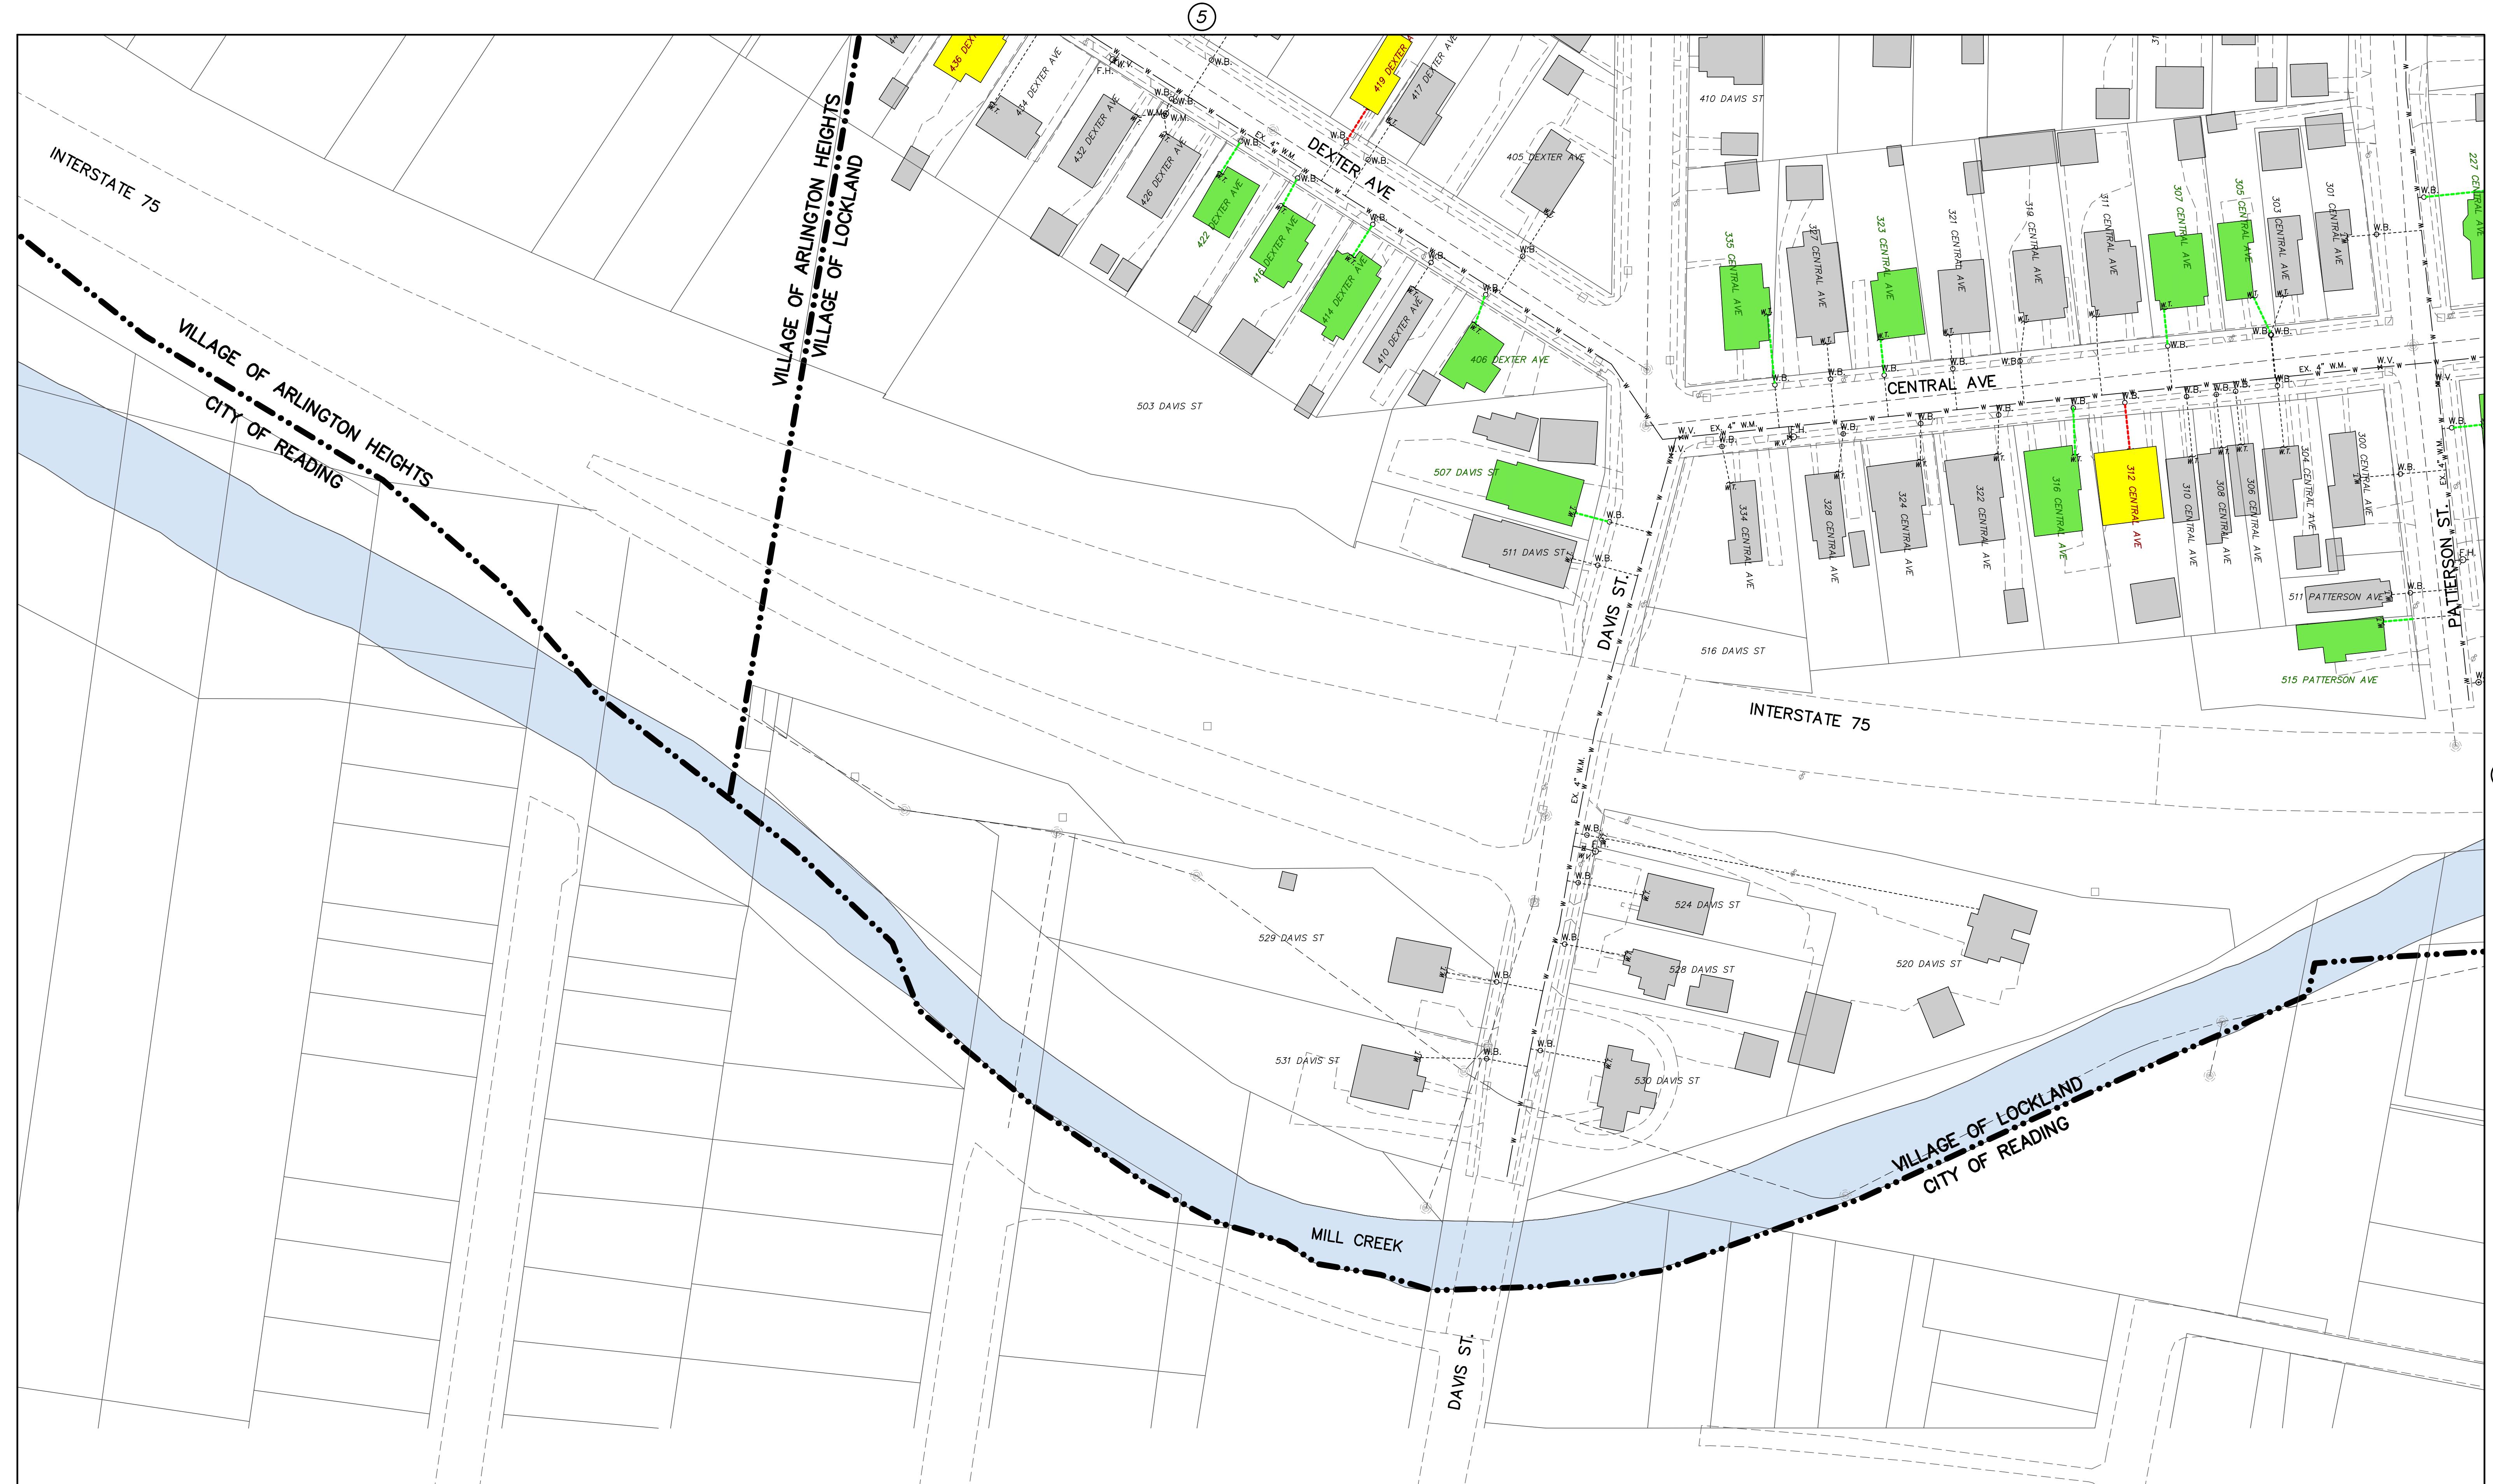

LEGEND


○ F.H.	EX. FIRE HYDRANT
☒ W.V.	EX. WATER VALVE
○ W.M.	EX. WATER METER
○ W.B.	EX. WATER BOX
○ CWDV	EX. WATER VALVE CHAMBER
☒ W.V.	EX. WATER VALVE M.H.
○ U.P.	EX. UTILITY POLE
○ S.M.H.	EX. SANITARY M.H.
○ I.N.	EX. INLET
ADJACENT SHEET NUMBER	2

[Yellow Box]	BUILDING WITH LEAD WATER SERVICE BUILT PRIOR TO 1998 FROM STOP COCK TO METER
[Green Box]	BUILDING WITH NON-LEAD WATER SERVICE BUILT PRIOR TO 2014 FROM STOP COCK TO METER
[Grey Box]	BUILDING WITH NO INFORMATION ON WATER SERVICE

(5)

(7)


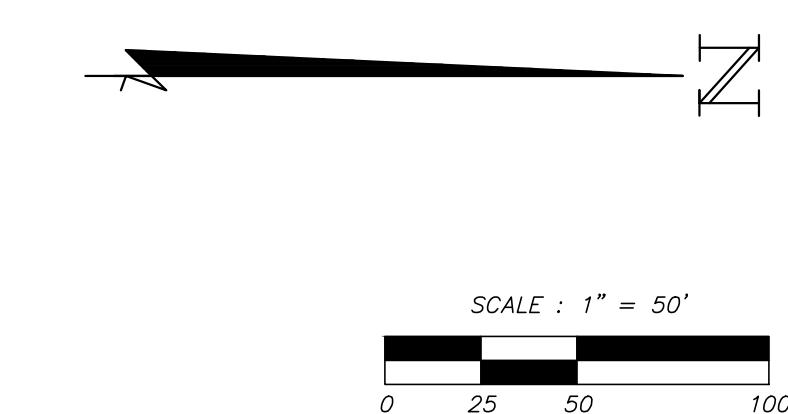


4357 Harrison Avenue, Suite 100, Cincinnati, Ohio 45211
(513) 721-5500 FAX (513) 721-0607
ESTABLISHED IN 1933
JMA Consultants, Inc. ENGINEERS • SURVEYORS • LAND PLANNERS • CONSTRUCTION MANAGERS

SCALE
1"=50'
DATE: 3/6/2017

JOB NUMBER
3269

6 / 36

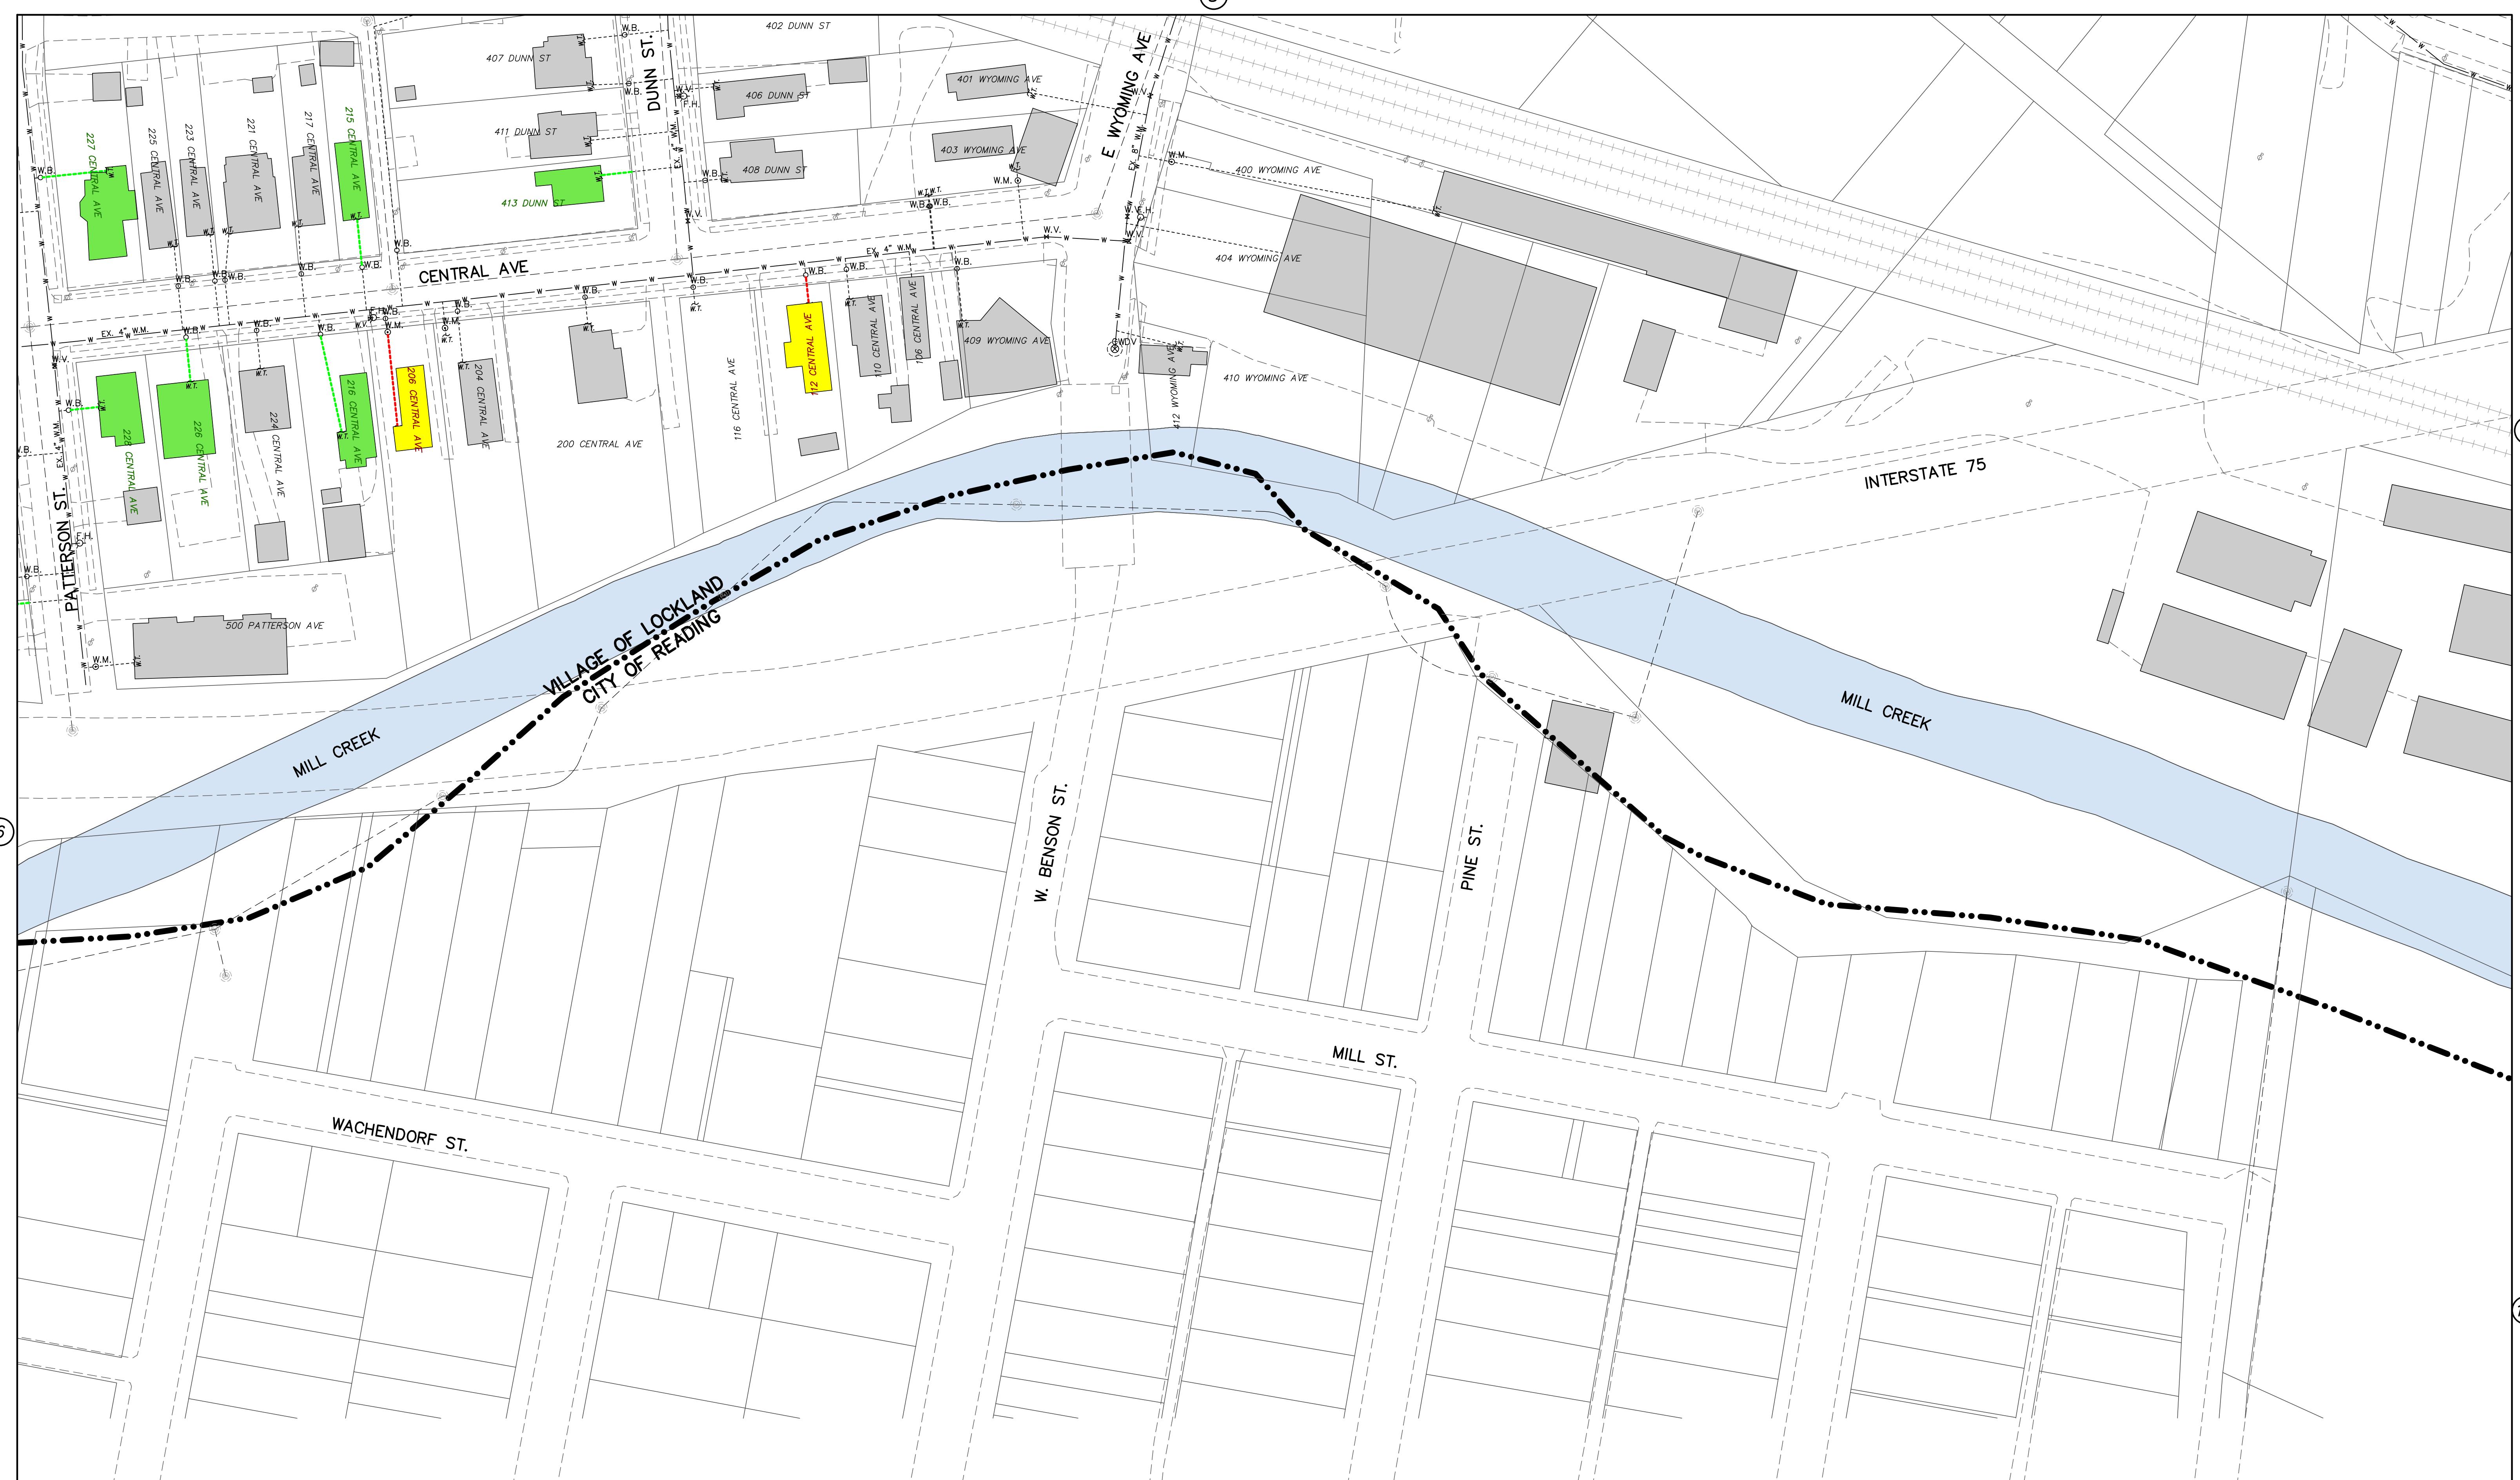

LEGEND

○ F.H.	EX. FIRE HYDRANT
✖ W.V.	EX. WATER VALVE
○ W.M.	EX. WATER METER
○ W.B.	EX. WATER BOX
○ CWDV	EX. WATER VALVE CHAMBER
✖ W.V. M.H.	EX. WATER VALVE M.H.
✖ U.P.	EX. UTILITY POLE
✖ S.M.H.	EX. SANITARY M.H.
✖ I.	EX. INLET
○ Adjacent Sheet Number	

— W — W — EX. 4" W.M. — W —	EX. WATER MAIN EX. WATER SERVICE - LEAD EX. WATER SERVICE - NON-LEAD EX. WATER SERVICE - MATERIAL NOT IDENTIFIED
— W — W — EX. 4" W.M. — W —	EX. SANITARY LINE RAILROAD TRACKS CORPORATION LINE
— W — W — EX. 4" W.M. — W —	RIVER STREAM
— W — W — EX. 4" W.M. — W —	EX. PAVEMENT EX. CURB EX. PROPERTY LINE
— W — W — EX. 4" W.M. — W —	BUILDING WITH LEAD WATER SERVICE BUILT PRIOR TO 1998 FROM STOP COCK TO METER
— W — W — EX. 4" W.M. — W —	BUILDING WITH NON-LEAD WATER SERVICE BUILT PRIOR TO 2014 FROM STOP COCK TO METER
— W — W — EX. 4" W.M. — W —	BUILDING WITH NO INFORMATION ON WATER SERVICE

WATER RECORDS VILLAGE OF LOCKLAND HAMILTON COUNTY, OHIO

4357 Harrison Avenue, Suite 100, Cincinnati, Ohio 45211
(513) 721-5500 FAX (513) 721-0607
ESTABLISHED IN 1933
JMA Consultants, Inc. ENGINEERS • SURVEYORS • LAND PLANNERS • CONSTRUCTION MANAGERS

SCALE
1" = 50'
DATE: 3/6/2017

JOB NUMBER
3269 7 / 36

SCALE : 1" = 50'
0 25 50 100

8

18

17

2



LEGEND

○ F.H.	EX. FIRE HYDRANT
☒ W.V.	EX. WATER VALVE
○ W.M.	EX. WATER METER
○ W.B.	EX. WATER BOX
○ CWDV	EX. WATER VALVE CHAMBER
☒ W.V.I.	EX. WATER VALVE M.H.
☒ U.P.	EX. UTILITY POLE
☒ S.M.H.	EX. SANITARY M.H.
☒ I.	EX. INLET
— ADJACENT SHEET NUMBER	

— EX. 4" W.M.	EX. WATER MAIN

7


**WATER RECORDS
VILLAGE OF LOCKLAND

SCALE
1" = 50'
DATE: 3/6/2017
JOB NUMBER
3269
8 / 36

4357 Harrison Avenue, Suite 100, Cincinnati, Ohio 45211
(513) 721-5500 FAX (513) 721-0607
ESTABLISHED IN 1933
JMA Consultants, Inc. ENGINEERS • SURVEYORS • LAND PLANNERS • CONSTRUCTION MANAGERS

SCALE : 1" = 50'
0 25 50 100

2

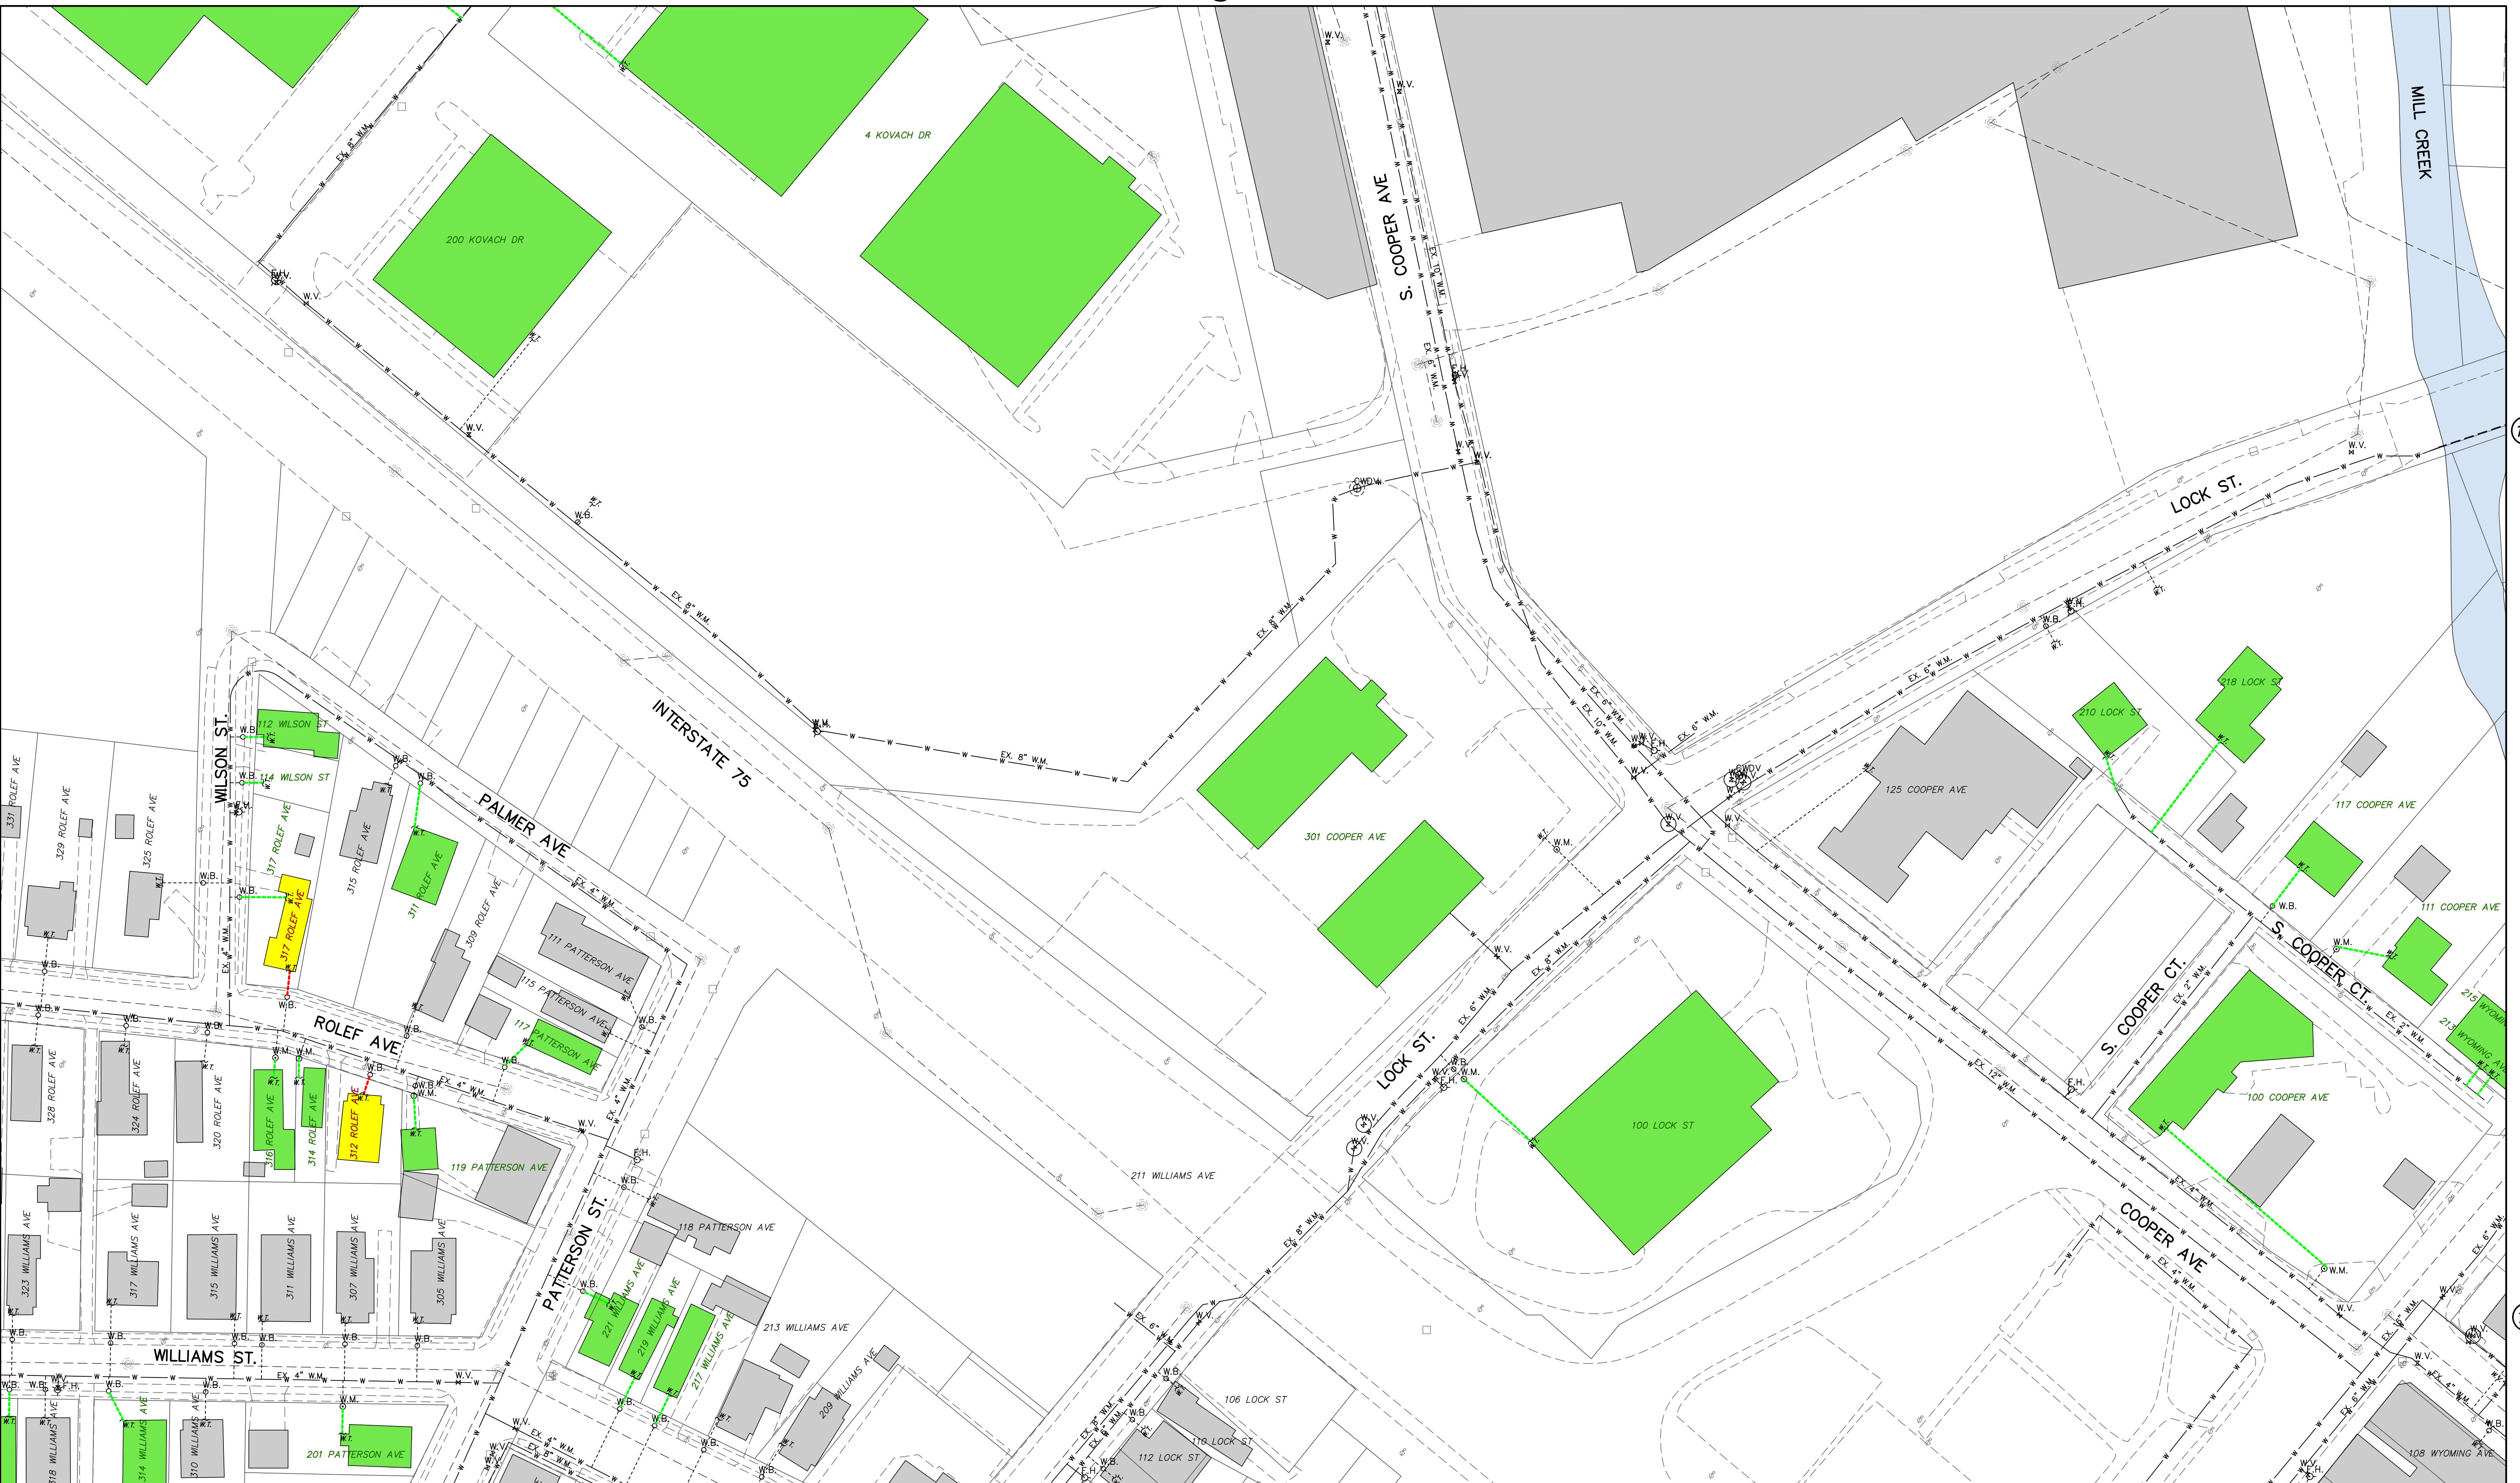

LEGEND

○ F.H.	EX. FIRE HYDRANT
☒ W.V.	EX. WATER VALVE
○ W.M.	EX. WATER METER
○ W.B.	EX. WATER BOX
○ CWDV	EX. WATER VALVE CHAMBER
☒ W.V.M.H.	EX. WATER VALVE M.H.
☒ U.P.	EX. UTILITY POLE
☒ I.	EX. SANITARY M.H.
☒ IN.	EX. INLET
— Adjacent Sheet Number	

— EX. 4" W.M.	EX. WATER MAIN
— EX. 6" W.M.	EX. WATER SERVICE - LEAD
— EX. 6" W.M.	EX. WATER SERVICE - NON-LEAD
— EX. 6" W.M.	EX. WATER SERVICE - MATERIAL NOT IDENTIFIED
— EX. 6" W.M.	EX. SANITARY LINE
— EX. 6" W.M.	RAILROAD TRACKS
— EX. 6" W.M.	CORPORATION LINE
— EX. 6" W.M.	RIVER
— Stream	STREAM
— Pavement	EX. PAVEMENT
— Curb	EX. CURB
— Property Line	EX. PROPERTY LINE

BUILDING WITH LEAD WATER SERVICE BUILT PRIOR TO 1998 FROM STOP COCK TO METER

BUILDING WITH NON-LEAD WATER SERVICE BUILT PRIOR TO 2014 FROM STOP COCK TO METER

BUILDING WITH NO INFORMATION ON WATER SERVICE

(8)

(10)

(15)

(16)

(1)

2

**WATER RECORDS
VILLAGE OF LOCKLAND

SCALE
1" = 50'
4357 Harrison Avenue, Suite 100, Cincinnati, Ohio 45211
(513) 721-5500 FAX (513) 721-0607
ESTABLISHED IN 1933
JMA Consultants, Inc. ■ ENGINEERS • SURVEYORS • LAND PLANNERS • CONSTRUCTION MANAGERS

DATE: 3/6/2017
JOB NUMBER
3269



9 / 36



(2)

(9)

(11)

(14)

(15)

**WATER RECORDS
VILLAGE OF LOCKLAND
HAMILTON COUNTY, OHIO**

4357 Harrison Avenue, Suite 100, Cincinnati, Ohio 45211
(513) 721-5500 FAX (513) 721-0607
ESTABLISHED IN 1933
JMA Consultants, Inc. ENGINEERS • SURVEYORS • LAND PLANNERS • CONSTRUCTION MANAGERS

SCALE : 1" = 50'
DATE: 3/6/2017
JOB NUMBER
3269

SCALE : 1" = 50'
0 25 50 100



LEGEND

○ F.H.	EX. FIRE HYDRANT
☒ W.V.	EX. WATER VALVE
○ W.M.	EX. WATER METER
○ W.B.	EX. WATER BOX
○ CWDV	EX. WATER VALVE CHAMBER
☒ W.M.H.	EX. WATER M.H.
☒ U.P.	EX. UTILITY POLE
☒ S.M.H.	EX. SANITARY M.H.
☒ I.	EX. INLET
○ ADJACENT SHEET NUMBER	

[Yellow Box]	BUILDING WITH LEAD WATER SERVICE BUILT PRIOR TO 1998 FROM STOP COCK TO METER
[Green Box]	BUILDING WITH NON-LEAD WATER SERVICE BUILT PRIOR TO 2014 FROM STOP COCK TO METER
[Grey Box]	BUILDING WITH NO INFORMATION ON WATER SERVICE

(10)

(12)

**WATER RECORDS
VILLAGE OF LOCKLAND

4357 Harrison Avenue, Suite 100, Cincinnati, Ohio 45211
(513) 721-5500 FAX (513) 721-0607
ESTABLISHED IN 1933

SCALE
1" = 50'
JMA Consultants, Inc. ENGINEERS • SURVEYORS • LAND PLANNERS • CONSTRUCTION MANAGERS

DATE: 3/6/2017
JOB NUMBER
3269
11 / 36

1

LEGEND

F.H.	EX. FIRE HYDRANT
W.V.	EX. WATER VALVE
W.M.	EX. WATER METER
W.B.	EX. WATER BOX
CWDV	EX. WATER VALVE CHAMBER
W.V.	EX. WATER VALVE M.H.
Utility Pole	EX. UTILITY POLE
M.H.	EX. SANITARY M.H.
Inlet	EX. INLET
Adjacent Sheet Number	ADJACENT SHEET NUMBER

 Yellow Box	BUILDING WITH LEAD WATER SERVICE BUILT PRIOR TO 1998 FROM STOP COCK TO METER
 Green Box	BUILDING WITH NON-LEAD WATER SERVICE BUILT PRIOR TO 2014 FROM STOP COCK TO METER
 Grey Box	BUILDING WITH NO INFORMATION ON WATER SERVICE

11



SCALE : 1" = 50'
 0 25 50 100

WATER RECORDS
VILLAGE OF LOCKLAND
 HAMILTON COUNTY, OHIO

SCALE
 1" = 50'
 DATE: 3/6/2017
 JOB NUMBER
 3269 12 / 36

4357 Harrison Avenue, Suite 100, Cincinnati, Ohio 45211
 (513) 721-5500 FAX (513) 721-0607
 ESTABLISHED IN 1933

JMA Consultants, Inc. ENGINEERS • SURVEYORS • LAND PLANNERS • CONSTRUCTION MANAGERS




(2)

(14)

WATER RECORDS VILLAGE OF LOCKLAND HAMMOND COUNTY, OHIO

SCALE
1" = 50'
4357 Harrison Avenue, Suite 100, Cincinnati, Ohio 45211
(513) 721-5500 FAX (513) 721-0607
ESTABLISHED IN 1933
JMA Consultants, Inc. ENGINEERS • SURVEYORS • LAND PLANNERS • CONSTRUCTION MANAGERS
DATE: 3/6/2017
JOB NUMBER
3269
13 / 36

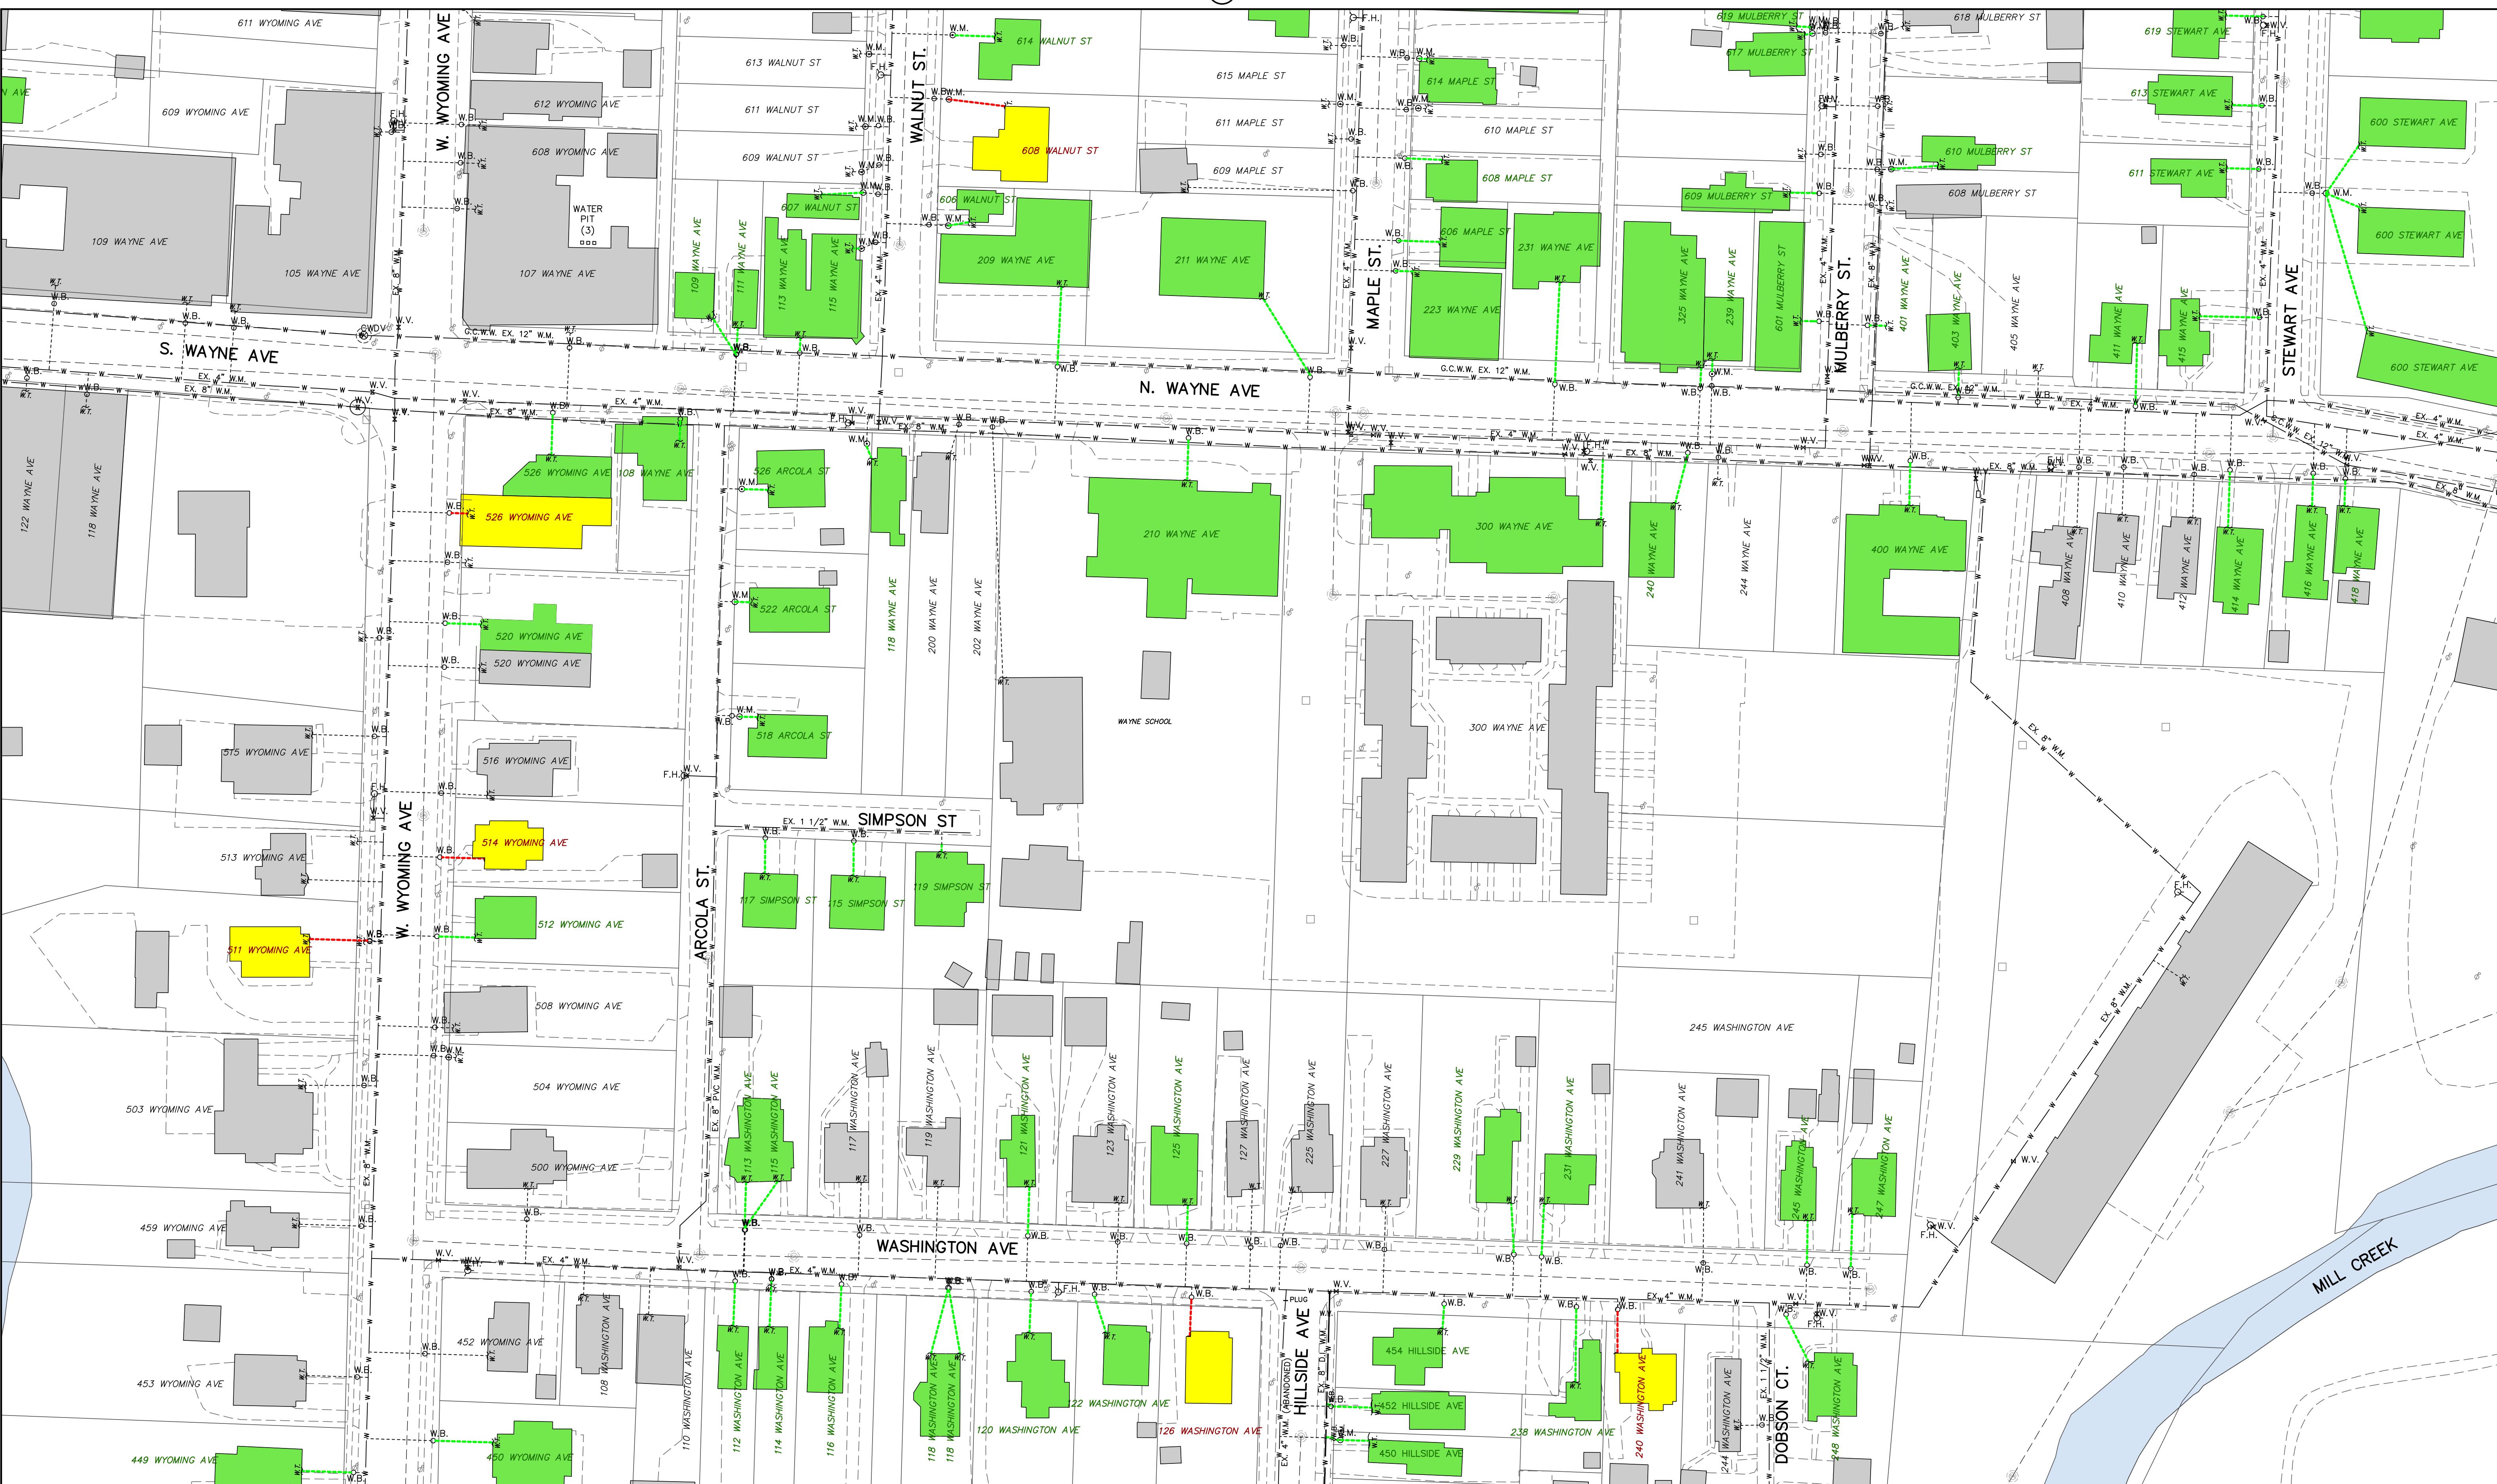

LEGEND

EX. F.H.	EX. 4" W.M.	EX. WATER MAIN
EX. W.V.	EX. 4" W.M.	EX. WATER SERVICE - LEAD
EX. W.M.	EX. 4" W.M.	EX. WATER SERVICE - NON-LEAD
EX. W.B.	EX. 4" W.M.	EX. WATER SERVICE - MATERIAL NOT IDENTIFIED
EX. CWDV	EX. 4" W.M.	EX. SANITARY LINE
EX. W.V.C.H.	EX. 4" W.M.	RAILROAD TRACKS
EX. UTILITY POLE	EX. 4" W.M.	CORPORATION LINE
EX. SANITARY M.H.	EX. 4" W.M.	RIVER
EX. INLET	EX. 4" W.M.	STREAM
ADJACENT SHEET NUMBER		EX. PAVEMENT
		EX. CURB
		EX. PROPERTY LINE

Yellow Box:	BUILDING WITH LEAD WATER SERVICE BUILT PRIOR TO 1998 FROM STOP COCK TO METER
Green Box:	BUILDING WITH NON-LEAD WATER SERVICE BUILT PRIOR TO 2014 FROM STOP COCK TO METER
Grey Box:	BUILDING WITH NO INFORMATION ON WATER SERVICE

15

SCALE : 1" = 50'
0 25 50 100

**WATER RECORDS
VILLAGE OF LOCKLAND

4357 Harrison Avenue, Suite 100, Cincinnati, Ohio 45211
(513) 721-5500 FAX (513) 721-0607
ESTABLISHED IN 1933



SCALE
1" = 50'
DATE: 3/6/2017

JOB NUMBER
3269 14 / 36



LEGEND

○ F.H.	EX. FIRE HYDRANT
☒ W.V.	EX. WATER VALVE
○ W.M.	EX. WATER METER
○ W.B.	EX. WATER BOX
○ CWDV	EX. WATER VALVE CHAMBER
☒ W.V.	EX. WATER VALVE M.H.
☒ U.P.	EX. UTILITY POLE
☒ S.M.H.	EX. SANITARY M.H.
☒ I.	EX. INLET
○ Adjacent Sheet Number	

— W — W — EX. 4" W.M. — W —	EX. WATER MAIN


- BUILDING WITH LEAD WATER SERVICE BUILT PRIOR TO 1998 FROM STOP COCK TO METER
- BUILDING WITH NON-LEAD WATER SERVICE BUILT PRIOR TO 2014 FROM STOP COCK TO METER
- BUILDING WITH NO INFORMATION ON WATER SERVICE

16

SCALE : 1" = 50'
0 25 50 100

WATER RECORDS VILLAGE OF LOCKLAND HAMILTON COUNTY, OHIO

SCALE
1"=50'
ESTABLISHED IN 1933
4357 Harrison Avenue, Suite 100, Cincinnati, Ohio 45211
(513) 721-5500 FAX (513) 721-0607
JMA Consultants, Inc. ENGINEERS • SURVEYORS • LAND PLANNERS • CONSTRUCTION MANAGERS
DATE: 3/6/2017
JOB NUMBER 3269 15/36

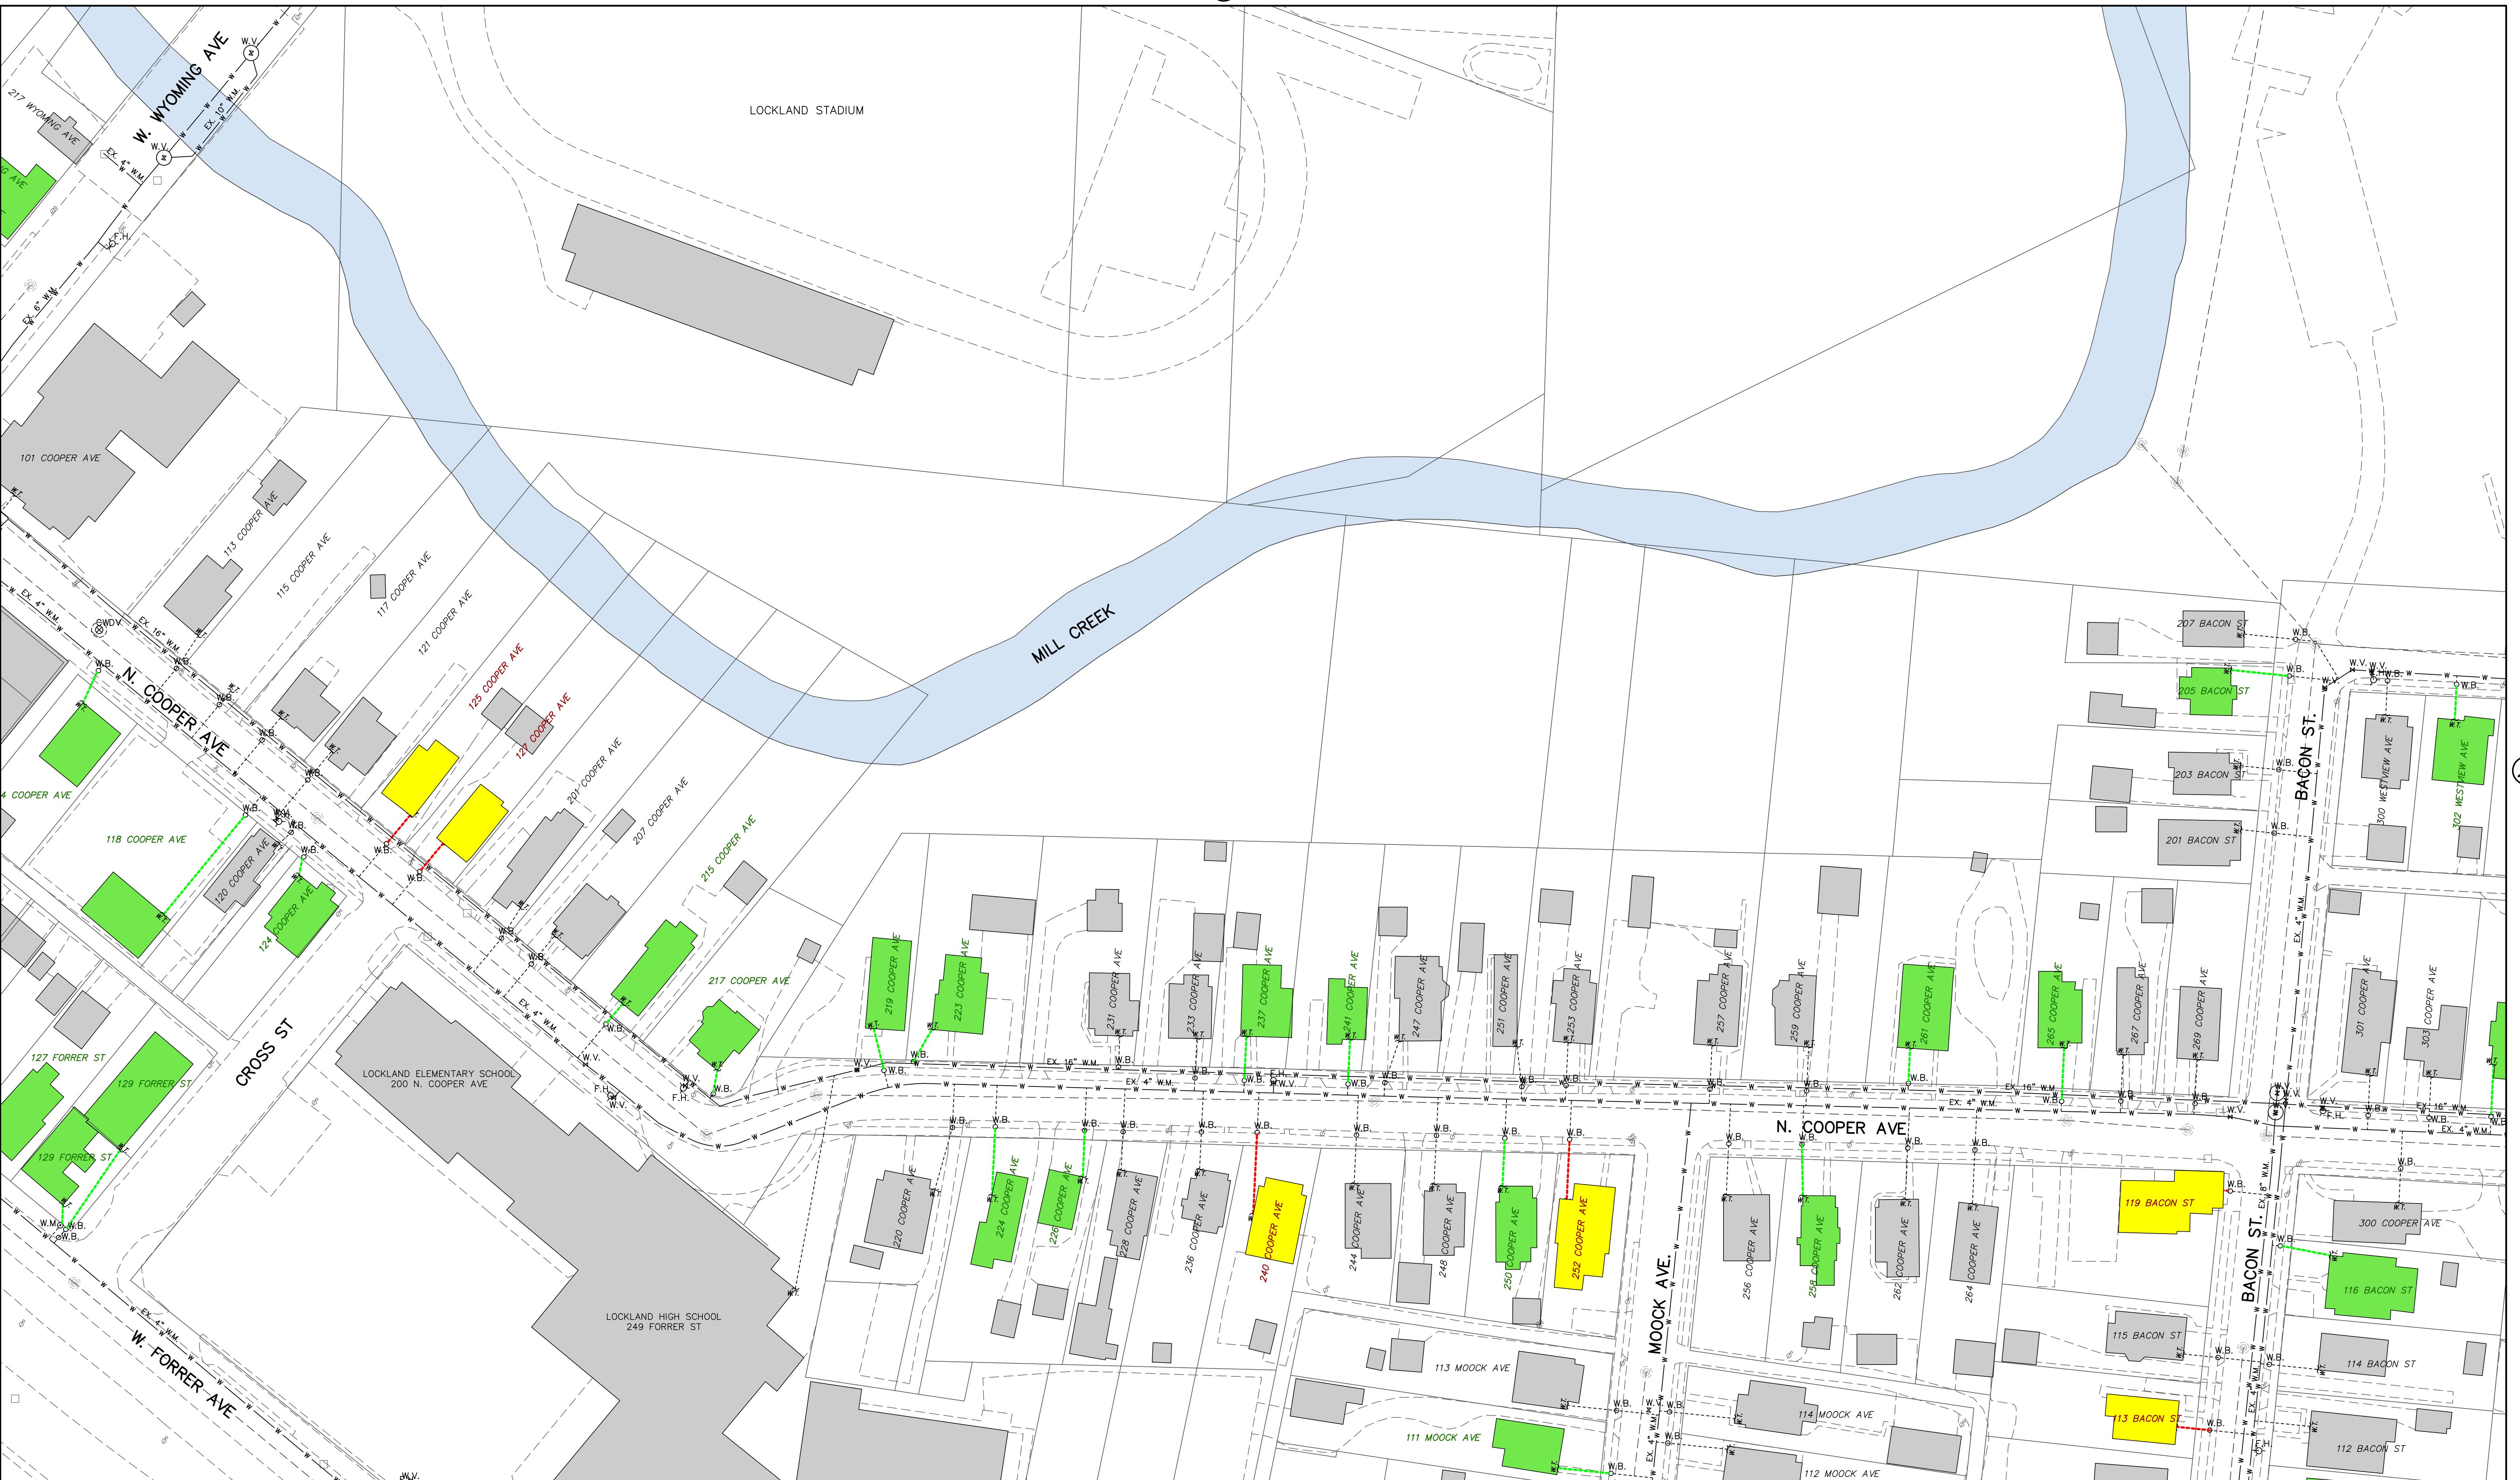


LEGEND

F.H.	EX. FIRE HYDRANT
W.V.	EX. WATER VALVE
W.M.	EX. WATER METER
W.B.	EX. WATER BOX
CWDV	EX. WATER VALVE CHAMBER
W.V.	EX. WATER M.H.
	EX. UTILITY POLE
	EX. SANITARY M.H.
	EX. INLET
	ADJACENT SHEET NUMBER

	BUILDING WITH LEAD WATER SERVICE BUILT PRIOR TO 1998 FROM STOP COCK TO METER
	BUILDING WITH NON-LEAD WATER SERVICE BUILT PRIOR TO 2014 FROM STOP COCK TO METER
	BUILDING WITH NO INFORMATION ON WATER SERVICE

(17)

**WATER RECORDS
VILLAGE OF LOCKLAND

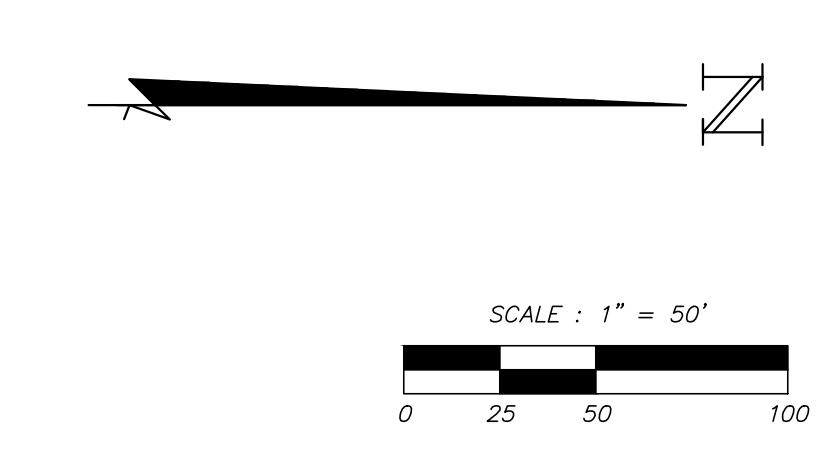

4357 Harrison Avenue, Suite 100, Cincinnati, Ohio 45211
(513) 721-5500 FAX (513) 721-0607
ESTABLISHED IN 1933
JMA Consultants, Inc. ENGINEERS • SURVEYORS • LAND PLANNERS • CONSTRUCTION MANAGERS

SCALE
1" = 50'
DATE: 3/6/2017
JOB NUMBER
3269
16 / 36




LEGEND

EX. F.H.	EX. FIRE HYDRANT
W.V.	EX. WATER VALVE
W.M.	EX. WATER METER
W.B.	EX. WATER BOX
CWDV	EX. WATER VALVE CHAMBER
W.V.	EX. WATER VALVE M.H.
U.P.	EX. UTILITY POLE
M.H.	EX. SANITARY M.H.
I.N.	EX. INLET
	ADJACENT SHEET NUMBER

	BUILDING WITH LEAD WATER SERVICE BUILT PRIOR TO 1998 FROM STOP COCK TO METER
	BUILDING WITH NON-LEAD WATER SERVICE BUILT PRIOR TO 2014 FROM STOP COCK TO METER
	BUILDING WITH NO INFORMATION ON WATER SERVICE
	STREAM
	EX. PAVEMENT
	EX. CURB
	EX. PROPERTY LINE

(18)

**WATER RECORDS
VILLAGE OF LOCKLAND
HAMMOND COUNTY, OHIO**

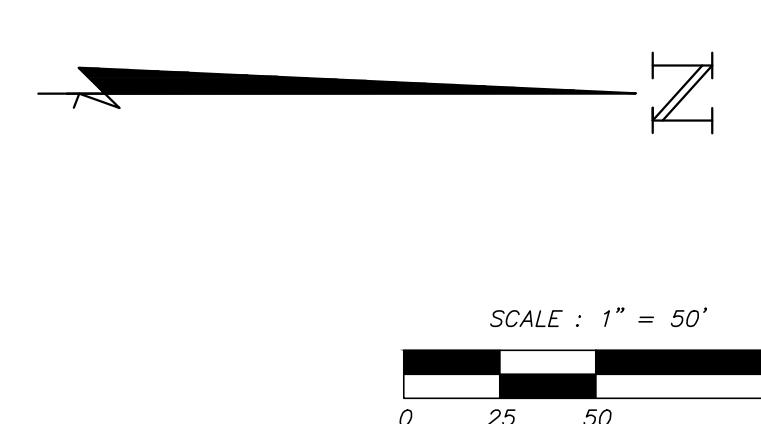

4357 Harrison Avenue, Suite 100, Cincinnati, Ohio 45211
(513) 721-5500 FAX (513) 721-0607
ESTABLISHED IN 1933
JMA Consultants, Inc. ENGINEERS • SURVEYORS • LAND PLANNERS • CONSTRUCTION MANAGERS

SCALE
1" = 50'
DATE: 3/6/2017
JOB NUMBER
3269



LEGEND

○ F.H.	EX. FIRE HYDRANT
☒ W.V.	EX. WATER VALVE
○ W.M.	EX. WATER METER
○ W.B.	EX. WATER BOX
○ CWDV	EX. WATER VALVE CHAMBER
☒ W.V.	EX. WATER VALVE M.H.
☒ U.P.	EX. UTILITY POLE
☒ S.M.H.	EX. SANITARY M.H.
☒ I.	EX. INLET
○ Adjacent Sheet Number	EX. 4" W.M.
○ Adjacent Sheet Number	EX. WATER MAIN
○ Adjacent Sheet Number	EX. WATER SERVICE - LEAD
○ Adjacent Sheet Number	EX. WATER SERVICE - NON-LEAD
○ Adjacent Sheet Number	EX. WATER SERVICE - MATERIAL NOT IDENTIFIED
○ Adjacent Sheet Number	EX. SANITARY LINE
○ Adjacent Sheet Number	RAILROAD TRACKS
○ Adjacent Sheet Number	CORPORATION LINE
○ Adjacent Sheet Number	RIVER
○ Adjacent Sheet Number	STREAM
○ Adjacent Sheet Number	EX. PAVEMENT
○ Adjacent Sheet Number	EX. CURB
○ Adjacent Sheet Number	EX. PROPERTY LINE

[Yellow Box]	BUILDING WITH LEAD WATER SERVICE BUILT PRIOR TO 1998 FROM STOP COCK TO METER
[Green Box]	BUILDING WITH NON-LEAD WATER SERVICE BUILT PRIOR TO 2014 FROM STOP COCK TO METER
[Grey Box]	BUILDING WITH NO INFORMATION ON WATER SERVICE

2

WATER RECORDS VILLAGE OF LOCKLAND HAMILTON COUNTY, OHIO

SCALE
1" = 50'
DATE: 3/6/2017
JOB NUMBER
3269
18 / 36

SCALE : 1" = 50'
0 25 50 100

4357 Harrison Avenue, Suite 100, Cincinnati, Ohio 45211
(513) 721-5500 FAX (513) 721-0607
ESTABLISHED IN 1933
JMA Consultants, Inc. ENGINEERS • SURVEYORS • LAND PLANNERS • CONSTRUCTION MANAGERS



LEGEND


EX. F.H.	EX. FIRE HYDRANT
W.V.	EX. WATER VALVE
W.M.	EX. WATER METER
W.B.	EX. WATER BOX
CWDV	EX. WATER VALVE CHAMBER
W.V.	EX. WATER M.H.
U.P.	EX. UTILITY POLE
S.M.H.	EX. SANITARY M.H.
I.N.	EX. INLET
ADJACENT SHEET NUMBER	

	BUILDING WITH LEAD WATER SERVICE BUILT PRIOR TO 1998 FROM STOP COCK TO METER
	EX. WATER SERVICE - LEAD
	EX. WATER SERVICE - NON-LEAD
	EX. WATER SERVICE - MATERIAL NOT IDENTIFIED
	EX. SANITARY LINE
	RAILROAD TRACKS
	CORPORATION LINE
	RIVER
	STREAM
	EX. PAVEMENT
	EX. CURB
	EX. PROPERTY LINE

(20)

WATER RECORDS VILLAGE OF LOCKLAND HAMILTON COUNTY, OHIO

SCALE
1" = 50'
4357 Harrison Avenue, Suite 100, Cincinnati, Ohio 45211
(513) 721-5500 FAX (513) 721-0607
ESTABLISHED IN 1933
JMA Consultants, Inc. ENGINEERS • SURVEYORS • LAND PLANNERS • CONSTRUCTION MANAGERS
DATE: 3/6/2017
JOB NUMBER
3269
19 / 36

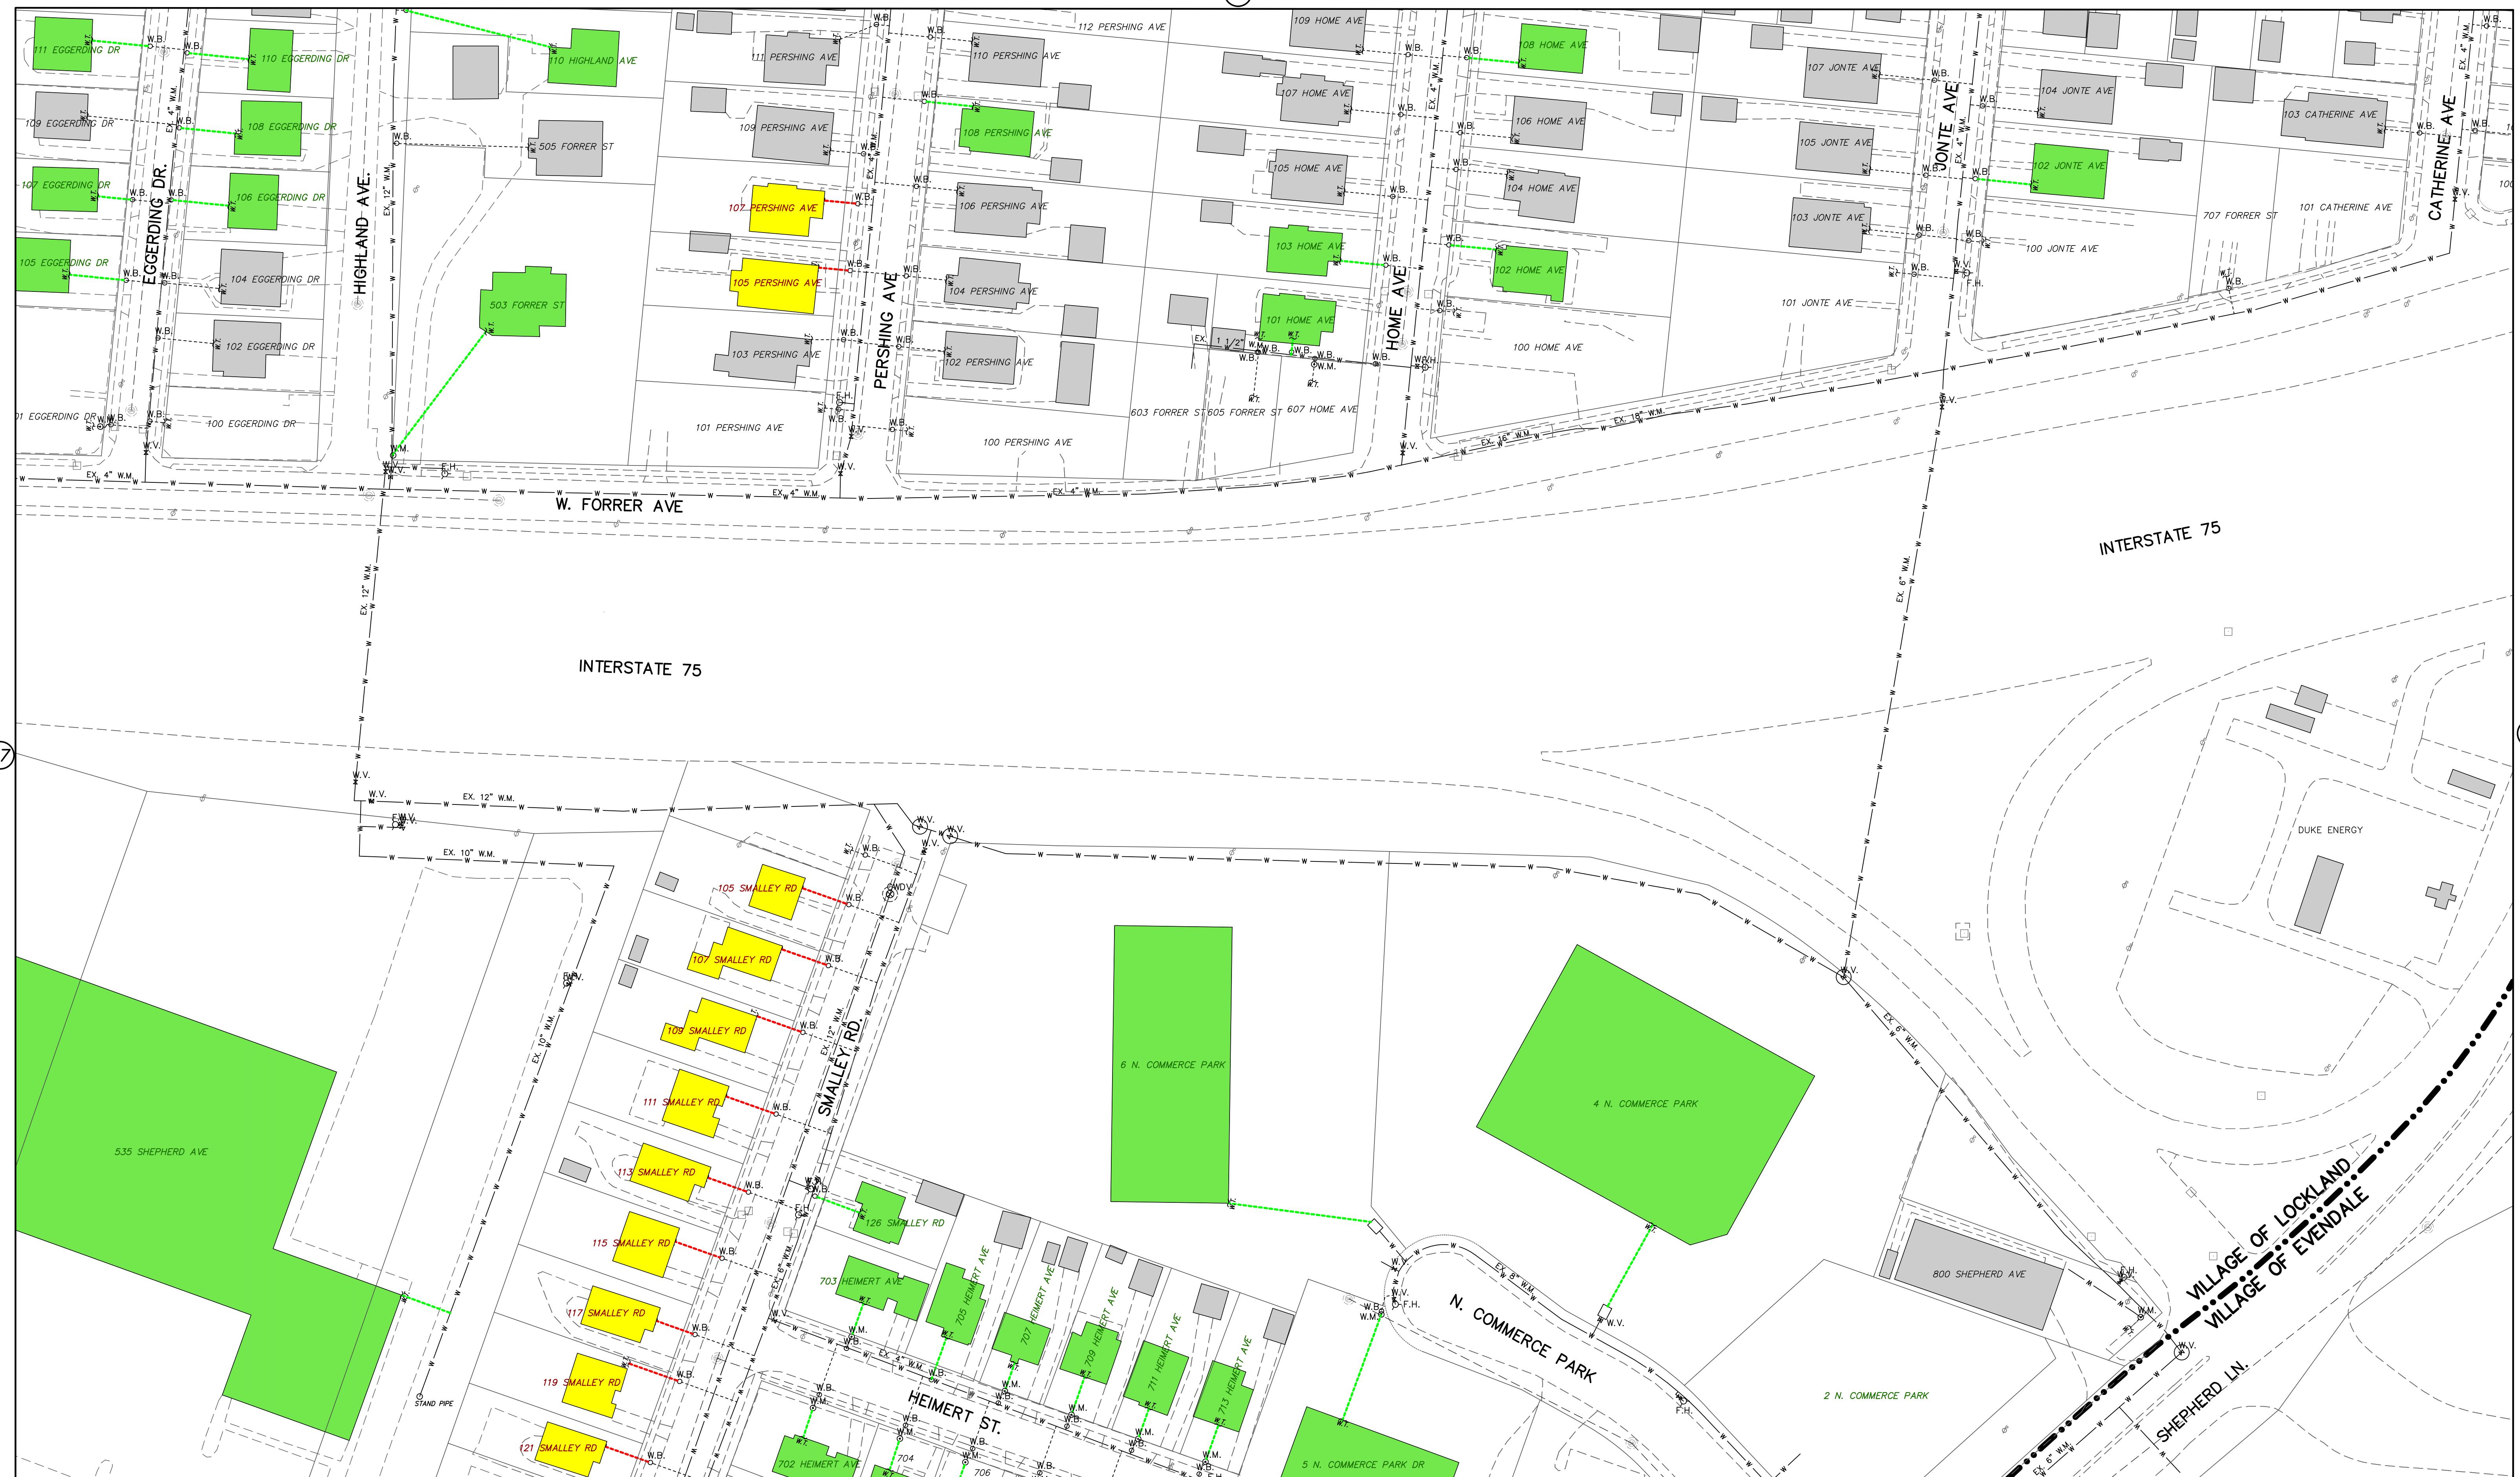

LEGEND

○ F.H.	EX. FIRE HYDRANT
☒ W.V.	EX. WATER VALVE
○ W.M.	EX. WATER METER
○ W.B.	EX. WATER BOX
○ CWDV	EX. WATER VALVE CHAMBER
☒ W.V.	EX. WATER M.H.
☒ U.P.	EX. UTILITY POLE
☒ S.M.H.	EX. SANITARY M.H.
☒ I.	EX. INLET
○ ADJACENT SHEET NUMBER	

[Yellow Box]	BUILDING WITH LEAD WATER SERVICE BUILT PRIOR TO 1998 FROM STOP COCK TO METER
[Green Box]	BUILDING WITH NON-LEAD WATER SERVICE BUILT PRIOR TO 2014 FROM STOP COCK TO METER
[Gray Box]	BUILDING WITH NO INFORMATION ON WATER SERVICE
—	RAILROAD TRACKS
—	CORPORATION LINE
—	STREAM
—	EX. PAVEMENT
—	EX. CURB
—	EX. PROPERTY LINE

19

**WATER RECORDS
VILLAGE OF LOCKLAND

4357 Harrison Avenue, Suite 100, Cincinnati, Ohio 45211
(513) 721-5500 FAX (513) 721-0607
ESTABLISHED IN 1933
JMA Consultants, Inc. ENGINEERS • SURVEYORS • LAND PLANNERS • CONSTRUCTION MANAGERS

SCALE
1" = 50'
DATE: 3/6/2017

JOB NUMBER
3269 20 / 36

SCALE : 1" = 50'
0 25 50 100

2



LEGEND

EX. F.H.	EX. FIRE HYDRANT
W.V.	EX. WATER VALVE
W.M.	EX. WATER METER
W.B.	EX. WATER BOX
CWDV	EX. WATER VALVE CHAMBER
W.V.	EX. WATER M.H.
	EX. UTILITY POLE
	EX. SANITARY M.H.
	EX. INLET
	ADJACENT SHEET NUMBER

	BUILDING WITH LEAD WATER SERVICE BUILT PRIOR TO 1998 FROM STOP COCK TO METER
	BUILDING WITH NON-LEAD WATER SERVICE BUILT PRIOR TO 2014 FROM STOP COCK TO METER
	BUILDING WITH NO INFORMATION ON WATER SERVICE
	STREAM
	EX. PAVEMENT
	EX. CURB
	EX. PROPERTY LINE

20


4357 Harrison Avenue, Suite 100, Cincinnati, Ohio 45211
(513) 721-5500 FAX (513) 721-0607
ESTABLISHED IN 1933
JMA Consultants, Inc. ENGINEERS • SURVEYORS • LAND PLANNERS • CONSTRUCTION MANAGERS

SCALE : 1" = 50'
DATE: 3/6/2017
JOB NUMBER
3269
21/36

22

22



LEGEND

EX. F.H.	EX. FIRE HYDRANT
W.V.	EX. WATER VALVE
W.M.	EX. WATER METER
W.B.	EX. WATER BOX
CWDV	EX. WATER VALVE CHAMBER
W.V.	EX. WATER VALVE M.H.
	EX. UTILITY POLE
	EX. SANITARY M.H.
	EX. INLET
	ADJACENT SHEET NUMBER

	BUILDING WITH LEAD WATER SERVICE BUILT PRIOR TO 1998 FROM STOP COCK TO METER
	BUILDING WITH NON-LEAD WATER SERVICE BUILT PRIOR TO 2014 FROM STOP COCK TO METER
	BUILDING WITH NO INFORMATION ON WATER SERVICE

**WATER RECORDS
VILLAGE OF LOCKLAND

4357 Harrison Avenue, Suite 100, Cincinnati, Ohio 45211
(513) 721-5500 FAX (513) 721-0607
ESTABLISHED IN 1933

SCALE
1" = 50'

DATE: 3/6/2017

JOB NUMBER
3269





LEGEND

- | | | |
|--|-------------------------|---------------------------|
| | F.H. | |
| | EX. FIRE HYDRANT | — W — W EX. 4" W.M. — W — |
| | EX. WATER VALVE | |
| | EX. WATER METER | |
| | EX. WATER BOX | |
| | EX. WATER VALVE CHAMBER | — — — — — — — — |
| | EX. WATER VALVE M.H. | |
| | EX. UTILITY POLE | |
| | EX. SANITARY M.H. | |
| | EX. INLET | |
| | ADJACENT SHEET NUMBER | |
| | | |
| | | |

1

BUILDING WITH LEAD WATER SERVICE BUILT
PRIOR TO 1998 FROM STOP COCK TO METER

1

BUILDING WITH NON-LEAD WATER SERVICE LINE PRIOR TO 2014 FROM STOP COCK TO METER

1


1

BUILDING WITH NO INFORMATION ON WATER




1

*WATER RECORDS
VILLAGE OF LOCKLAND
HAMILTON COUNTY, OHIO*


Ohio 45211 07	<p style="text-align: center;"><i>SCALE</i> $1''=50'$</p>
<p style="text-align: center;"><i>DATE:</i> 3/6/2017</p>	

	JOB NUMBER 3269	23 / 36

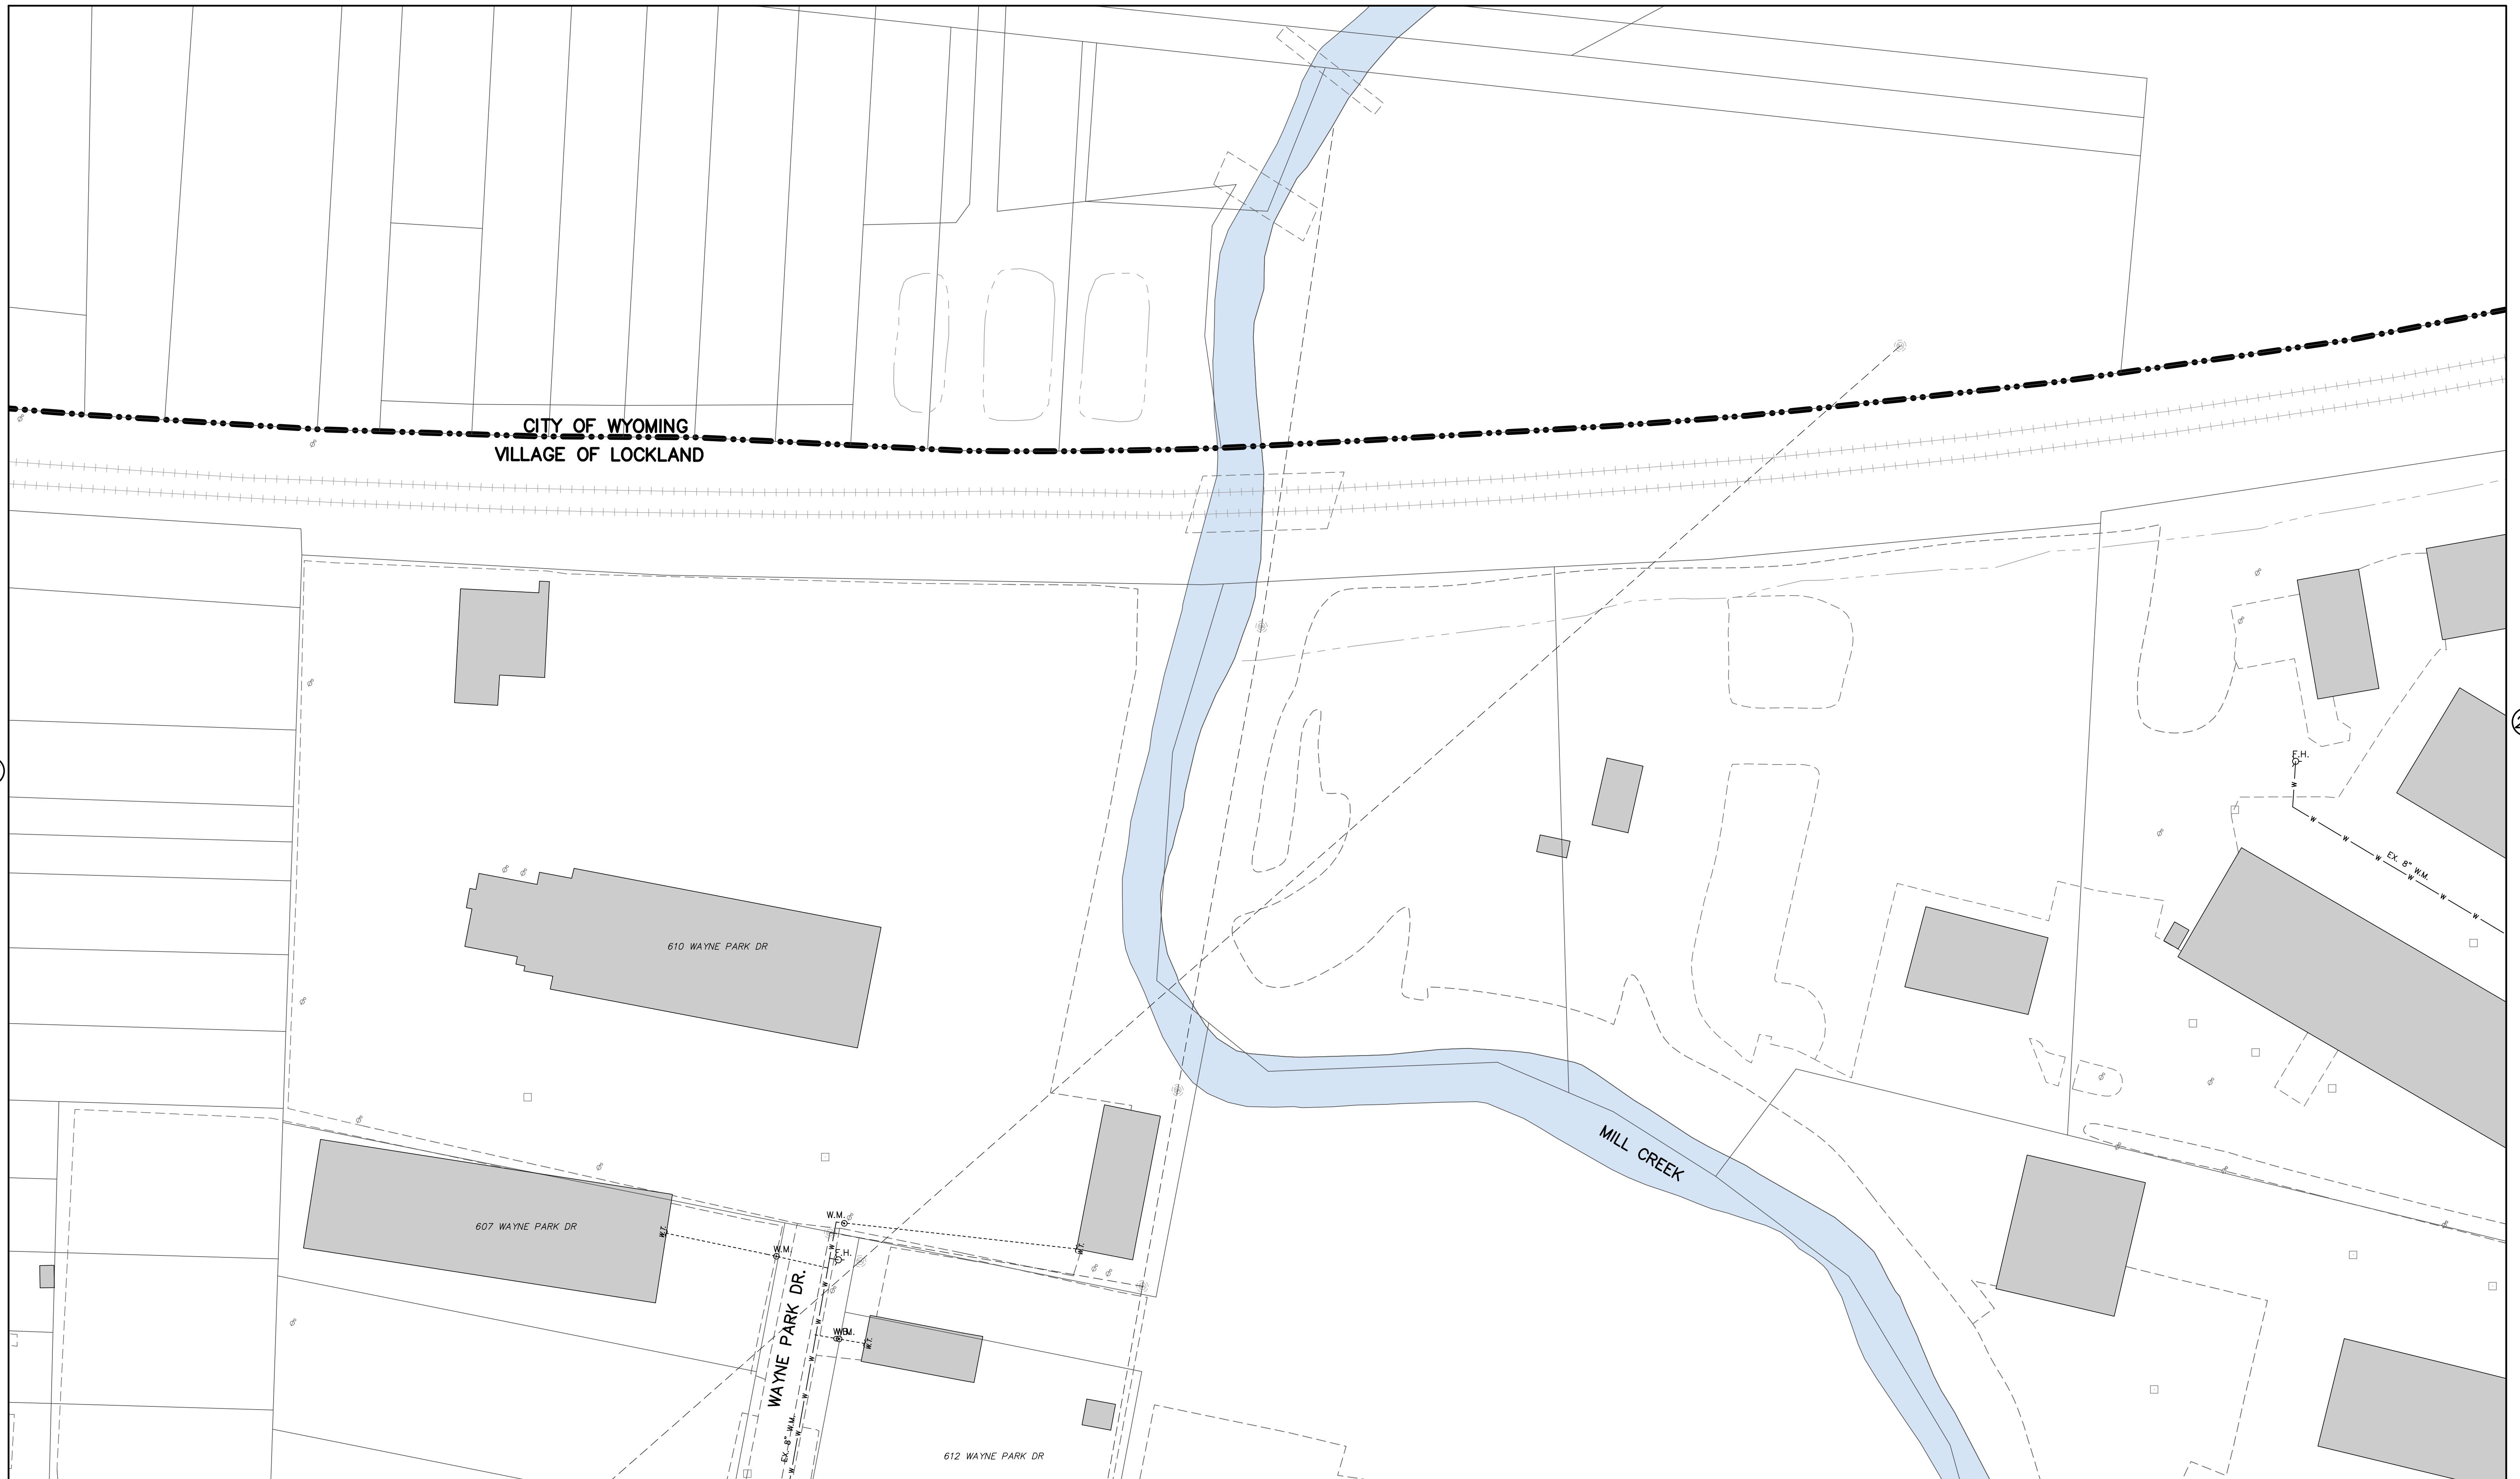
LEGEND

○ F.H.	EX. FIRE HYDRANT	— W — EX. 4" W.M.	EX. WATER MAIN
☒ W.V.	EX. WATER VALVE	— W — W — EX. 4" W.M.	EX. WATER SERVICE - LEAD
○ W.M.	EX. WATER METER	— W — W — EX. 4" W.M.	EX. WATER SERVICE - NON-LEAD
○ W.B.	EX. WATER BOX	— W — W — EX. 4" W.M.	EX. WATER SERVICE - MATERIAL NOT IDENTIFIED
○ CWDV	EX. WATER VALVE CHAMBER	— W — W — EX. 4" W.M.	EX. SANITARY LINE
☒ W.V.	EX. WATER VALVE M.H.	— W — W — EX. 4" W.M.	RAILROAD TRACKS
○ U.P.	EX. UTILITY POLE	— W — W — EX. 4" W.M.	CORPORATION LINE
○ S.	EX. SANITARY M.H.	— W — W — EX. 4" W.M.	RIVER
○ I.	EX. INLET	— W — W — EX. 4" W.M.	STREAM
(2)	ADJACENT SHEET NUMBER	— W — W — EX. 4" W.M.	EX. PAVEMENT
		— W — W — EX. 4" W.M.	EX. CURB
		— W — W — EX. 4" W.M.	EX. PROPERTY LINE

[Yellow Box]	BUILDING WITH LEAD WATER SERVICE BUILT PRIOR TO 1998 FROM STOP COCK TO METER
[Green Box]	BUILDING WITH NON-LEAD WATER SERVICE BUILT PRIOR TO 2014 FROM STOP COCK TO METER
[Grey Box]	BUILDING WITH NO INFORMATION ON WATER SERVICE

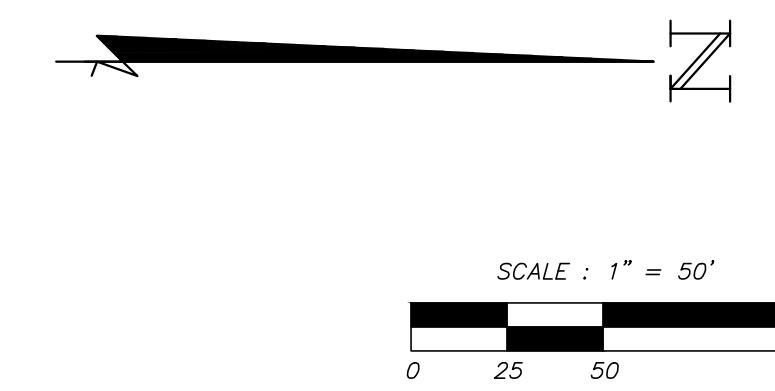23

**WATER RECORDS
VILLAGE OF LOCKLAND
HAMILTON COUNTY, OHIO**

4357 Harrison Avenue, Suite 100, Cincinnati, Ohio 45211
(513) 721-5500 FAX (513) 721-0607
ESTABLISHED IN 1933
JMA Consultants, Inc. ENGINEERS • SURVEYORS • LAND PLANNERS • CONSTRUCTION MANAGERS

SCALE
1" = 50'
DATE: 3/6/2017
JOB NUMBER
3269




LEGEND

EX. F.H.	EX. FIRE HYDRANT
W.V.	EX. WATER VALVE
W.M.	EX. WATER METER
W.B.	EX. WATER BOX
CWDV	EX. WATER VALVE CHAMBER
(W.V.)	EX. WATER VALVE M.H.
U.P.	EX. UTILITY POLE
M.H.	EX. SANITARY M.H.
INLET	EX. INLET
ADJACENT SHEET NUMBER	

	BUILDING WITH LEAD WATER SERVICE BUILT PRIOR TO 1998 FROM STOP COCK TO METER
	BUILDING WITH NON-LEAD WATER SERVICE BUILT PRIOR TO 2014 FROM STOP COCK TO METER
	BUILDING WITH NO INFORMATION ON WATER SERVICE

26

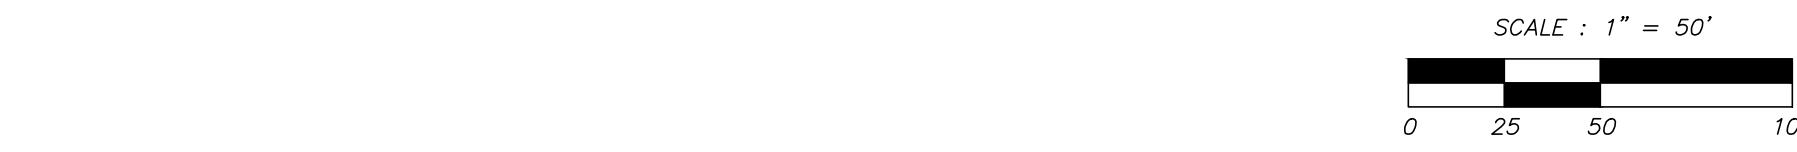

**WATER RECORDS
VILLAGE OF LOCKLAND
HAMILTON COUNTY, OHIO**

JMA Consultants, Inc. 4357 Harrison Avenue, Suite 100, Cincinnati, Ohio 45211
(513) 721-5500 FAX (513) 721-0607
ESTABLISHED IN 1933
ENGINEERS • SURVEYORS • LAND PLANNERS • CONSTRUCTION MANAGERS

SCALE
1" = 50'
DATE: 3/6/2017
JOB NUMBER
3269



LEGEND

F.H.	EX. FIRE HYDRANT	W.M.	EX. 4" W.M.
W.V.	EX. WATER VALVE	W.M.	EX. WATER SERVICE - LEAD
W.M.	EX. WATER METER	W.M.	EX. WATER SERVICE - NON-LEAD
W.B.	EX. WATER BOX	W.M.	EX. WATER SERVICE - MATERIAL NOT IDENTIFIED
CWDV	EX. WATER VALVE CHAMBER	W.M.	EX. SANITARY LINE
W.V.	EX. WATER M.H.	W.M.	RAILROAD TRACKS
U.P.	EX. UTILITY POLE	W.M.	CORPORATION LINE
S.M.H.	EX. SANITARY M.H.	W.M.	RIVER
I.	EX. INLET	W.M.	STREAM
	ADJACENT SHEET NUMBER		EX. PAVEMENT
			EX. CURB
			EX. PROPERTY LINE

	BUILDING WITH LEAD WATER SERVICE BUILT PRIOR TO 1998 FROM STOP COCK TO METER
	BUILDING WITH NON-LEAD WATER SERVICE BUILT PRIOR TO 2014 FROM STOP COCK TO METER
	BUILDING WITH NO INFORMATION ON WATER SERVICE

27

**WATER RECORDS
VILLAGE OF LOCKLAND

SCALE
1" = 50'
4357 Harrison Avenue, Suite 100, Cincinnati, Ohio 45211
(513) 721-5500 FAX (513) 721-0607
ESTABLISHED IN 1933
JMA Consultants, Inc. ■ ENGINEERS • SURVEYORS • LAND PLANNERS • CONSTRUCTION MANAGERS

DATE: 3/6/2017
JOB NUMBER
3269

SCALE : 1" = 50'
0 25 50 100

2



LEGEND

F.H.	EX. FIRE HYDRANT	W.M.	EX. 4" W.M.
W.V.	EX. WATER VALVE	W.	W.
W.M.	EX. WATER METER	W.	W.
W.B.	EX. WATER BOX	W.	W.
CWDV	EX. WATER VALVE CHAMBER	W.	W.
W.V.M.H.	EX. WATER M.H.	W.	W.
U.P.	EX. UTILITY POLE	W.	W.
S.M.H.	EX. SANITARY M.H.	W.	W.
I.	EX. INLET	W.	W.

ADJACENT SHEET NUMBER

	BUILDING WITH LEAD WATER SERVICE BUILT PRIOR TO 1998 FROM STOP COCK TO METER
	BUILDING WITH NON-LEAD WATER SERVICE BUILT PRIOR TO 2014 FROM STOP COCK TO METER
	BUILDING WITH NO INFORMATION ON WATER SERVICE

(28)

(26)

(28)

(26)

WATER RECORDS
VILLAGE OF LOCKLAND
HAMILTON COUNTY, OHIO

4357 Harrison Avenue, Suite 100, Cincinnati, Ohio 45211
(513) 721-5500 FAX (513) 721-0607
ESTABLISHED IN 1933
JMA Consultants, Inc.

SCALE
1" = 50'
DATE: 3/6/2017

JOB NUMBER
3269
27 / 36



LEGEND

- | | | | | |
|--|-----------------------|-------------------------|-----------------------------|---|
| | F.H. | EX. FIRE HYDRANT | — W — W — EX. 4" W.M. — W — | EX. WATER MAIN |
| | W.V. | EX. WATER VALVE | | EX. WATER SERVICE - LEAD |
| | W.M. | EX. WATER METER | | EX. WATER SERVICE - NON-LEAD |
| | W.B. | EX. WATER BOX | | EX. WATER SERVICE - MATERIAL NOT IDENTIFIED |
| | CWDV | EX. WATER VALVE CHAMBER | — — — — — — — — | EX. SANITARY LINE |
| | W.V. | EX. WATER VALVE M.H. | | RAILROAD TRACKS |
| | EX. UTILITY POLE | | | CORPORATION LINE |
| | EX. SANITARY M.H. | | | RIVER |
| | EX. INLET | | | STREAM |
| | ADJACENT SHEET NUMBER | | | EX. PAVEMENT |
| | | | | EX. CURB |
| | | | | EX. PROPERTY LINE |

A solid yellow rectangle with a black border.

**BUILDING WITH LEAD WATER SERVICE BUILT

PRIOR TO 2014 FROM STOP COCK TO METER

BUILDING WITH NO INFORMATION ON WATER SERVICE

29

*WATER RECORDS
VILLAGE OF LOCKLAND
HAMILTON COUNTY, OHIO*



SCALE
1" = 50'

3/6/2017

JOB NUMBER
3269



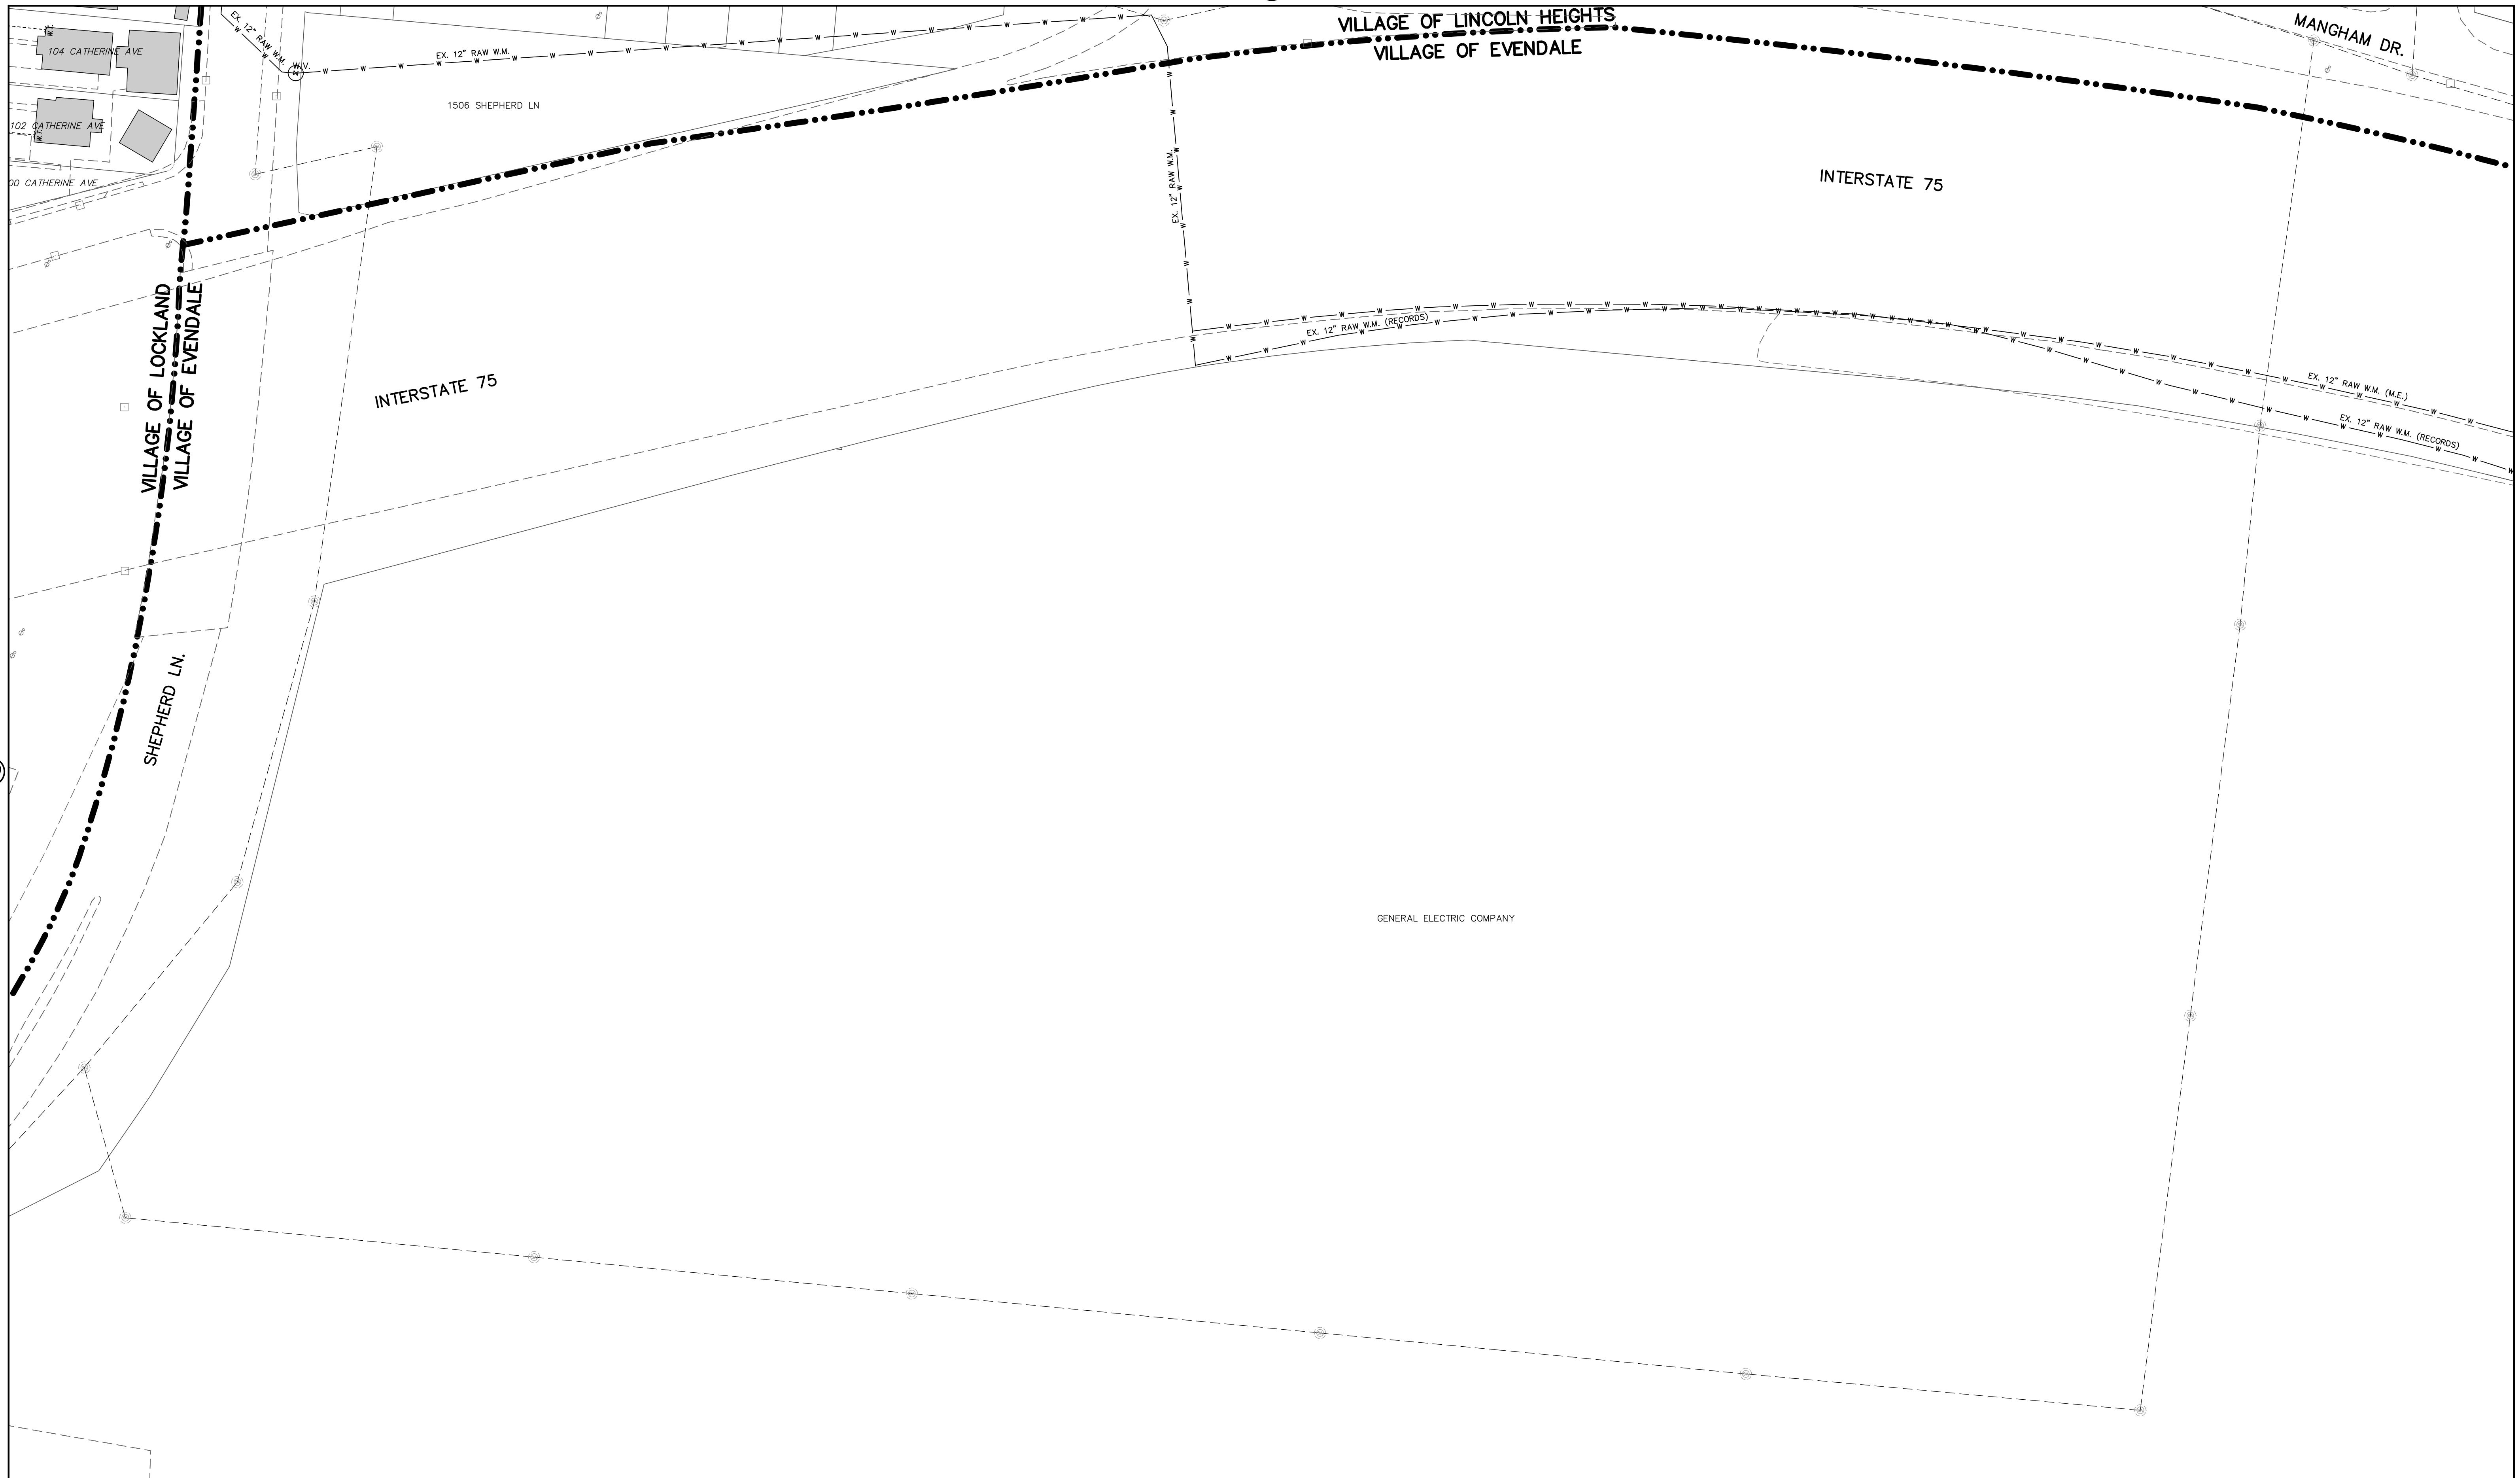

GENERAL ELECTRIC COMPANY

LEGEND

F.H.	EX. FIRE HYDRANT
W.V.	EX. WATER VALVE
W.M.	EX. WATER METER
W.B.	EX. WATER BOX
CWDV	EX. WATER VALVE CHAMBER
W.V.	EX. WATER VALVE M.H.
U.P.	EX. UTILITY POLE
S.M.H.	EX. SANITARY M.H.
I.	EX. INLET
	ADJACENT SHEET NUMBER

EX. 4" W.M.	EX. WATER MAIN
EX. 12" W.M.	EX. WATER SERVICE - LEAD
EX. 12" W.M.	EX. WATER SERVICE - NON-LEAD
EX. 12" W.M.	EX. WATER SERVICE - MATERIAL NOT IDENTIFIED
EX. SANITARY LINE	
RAILROAD TRACKS	
CORPORATION LINE	
RIVER	
STREAM	
EX. PAVEMENT	
EX. CURB	
EX. PROPERTY LINE	

- BUILDING WITH LEAD WATER SERVICE BUILT PRIOR TO 1998 FROM STOP COCK TO METER
- BUILDING WITH NON-LEAD WATER SERVICE BUILT PRIOR TO 2014 FROM STOP COCK TO METER
- BUILDING WITH NO INFORMATION ON WATER SERVICE

SCALE : 1" = 50'
0 25 50 100

WATER RECORDS
VILLAGE OF LOCKLAND
HAMILTON COUNTY, OHIO

4357 Harrison Avenue, Suite 100, Cincinnati, Ohio 45211
(513) 721-5500 FAX (513) 721-0607
ESTABLISHED IN 1933
JMA Consultants, Inc. ENGINEERS • SURVEYORS • LAND PLANNERS • CONSTRUCTION MANAGERS

SCALE
1" = 50'
DATE: 3/6/2017
JOB NUMBER
3269



30



26

2

LEGEND

	EX. FIRE HYDRANT
	EX. WATER VALVE
	EX. WATER METER
	EX. WATER BOX
	EX. WATER VALVE CHAMBER
	EX. UTILITY POLE
	EX. SANITARY M.H.
	EX. INLET
	ADJACENT SHEET NUMBER


	EX. WATER MAIN
	EX. WATER SERVICE - LEAD
	EX. WATER SERVICE - NON-LEAD
	EX. WATER SERVICE - MATERIAL NOT IDENTIFIED
	EX. SANITARY LINE
	RAILROAD TRACKS
	CORPORATION LINE
	RIVER
	STREAM
	EX. PAVEMENT
	EX. CURB
	EX. PROPERTY LINE

- BUILDING WITH LEAD WATER SERVICE BUILT PRIOR TO 1998 FROM STOP COCK TO METER
- BUILDING WITH NON-LEAD WATER SERVICE BUILT PRIOR TO 2014 FROM STOP COCK TO METER
- BUILDING WITH NO INFORMATION ON WATER SERVICE

**WATER RECORDS
VILLAGE OF LOCKLAND

SCALE : 1" = 50'
4357 Harrison Avenue, Suite 100, Cincinnati, Ohio 45211
(513) 721-5500 FAX (513) 721-0607
ESTABLISHED IN 1933

DATE: 3/6/2017

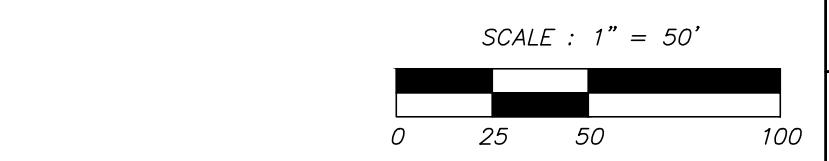JOB NUMBER
3269

31 / 36