



RECEIVED
OHIO EPA

MAR 03 2017

Southwest District

THE VILLAGE OF UNION CITY, OHIO

*419 E. Elm Street
Union City, Ohio 45390*

MAYOR
Hon. Zachary Pruitt
937-968-4305 ext. 1

VILLAGE ADMINISTRATOR/FISCAL OFFICER
Karen Stubbs
937-968-4305 ext. 2

TAX ADMINISTRATOR
Tonya Coning
937-968-4305 ext. 3

TO WHOM IT MAY CONCERN


February 24, 2017

Following is narrative description of documentation of service lines and water mains;

As far as we know Village of Union City has 600 service lines total with 570 active accounts 18 service lines are known to be non-lead lines. The remaining 552 service lines are prior to 1986, which we believe to have copper service lines and inside copper plumbing that consist of copper tubing with lead solder. Because it is practically impossible to determine the lead content of an installed fixture, fitting or pipe, it should be assumed that the manufacture or installation date is the primary indicator of the lead content. Therefore, the characteristics of buildings and piping solder or fixtures would be buildings in Ohio built prior to 1998 or that use plumbing material or solder manufactured before 1998 may have materials with greater than 8% lead and are at a higher risk of contributing lead to the drinking water than materials manufactured after 1998. In addition, buildings built and plumbing materials manufactured after 2014 were required to have less than 0.25% lead by weight and have the lowest risk for contributing lead to the drinking water. it should be noted however that, although prohibited, some use of leaded solder or leaded components may have occurred after the prohibitions became effective.

The following service lines are non-lead lines for the following reasons:

- | | |
|----------------------|---|
| 605 Elm St. | Lead service line was replaced from water main to home using 3/4 inch CTS plastic-Nov. 2016 |
| 124 NW Deerfield St. | Service had a leak service line was replaced from water main to meter with 3/4 inch CTS plastic- Nov. 2016. |
| 419 S. Division St. | installed new curb stop and found service line to be copper on both sides on curb stop-Sept. 2016 |

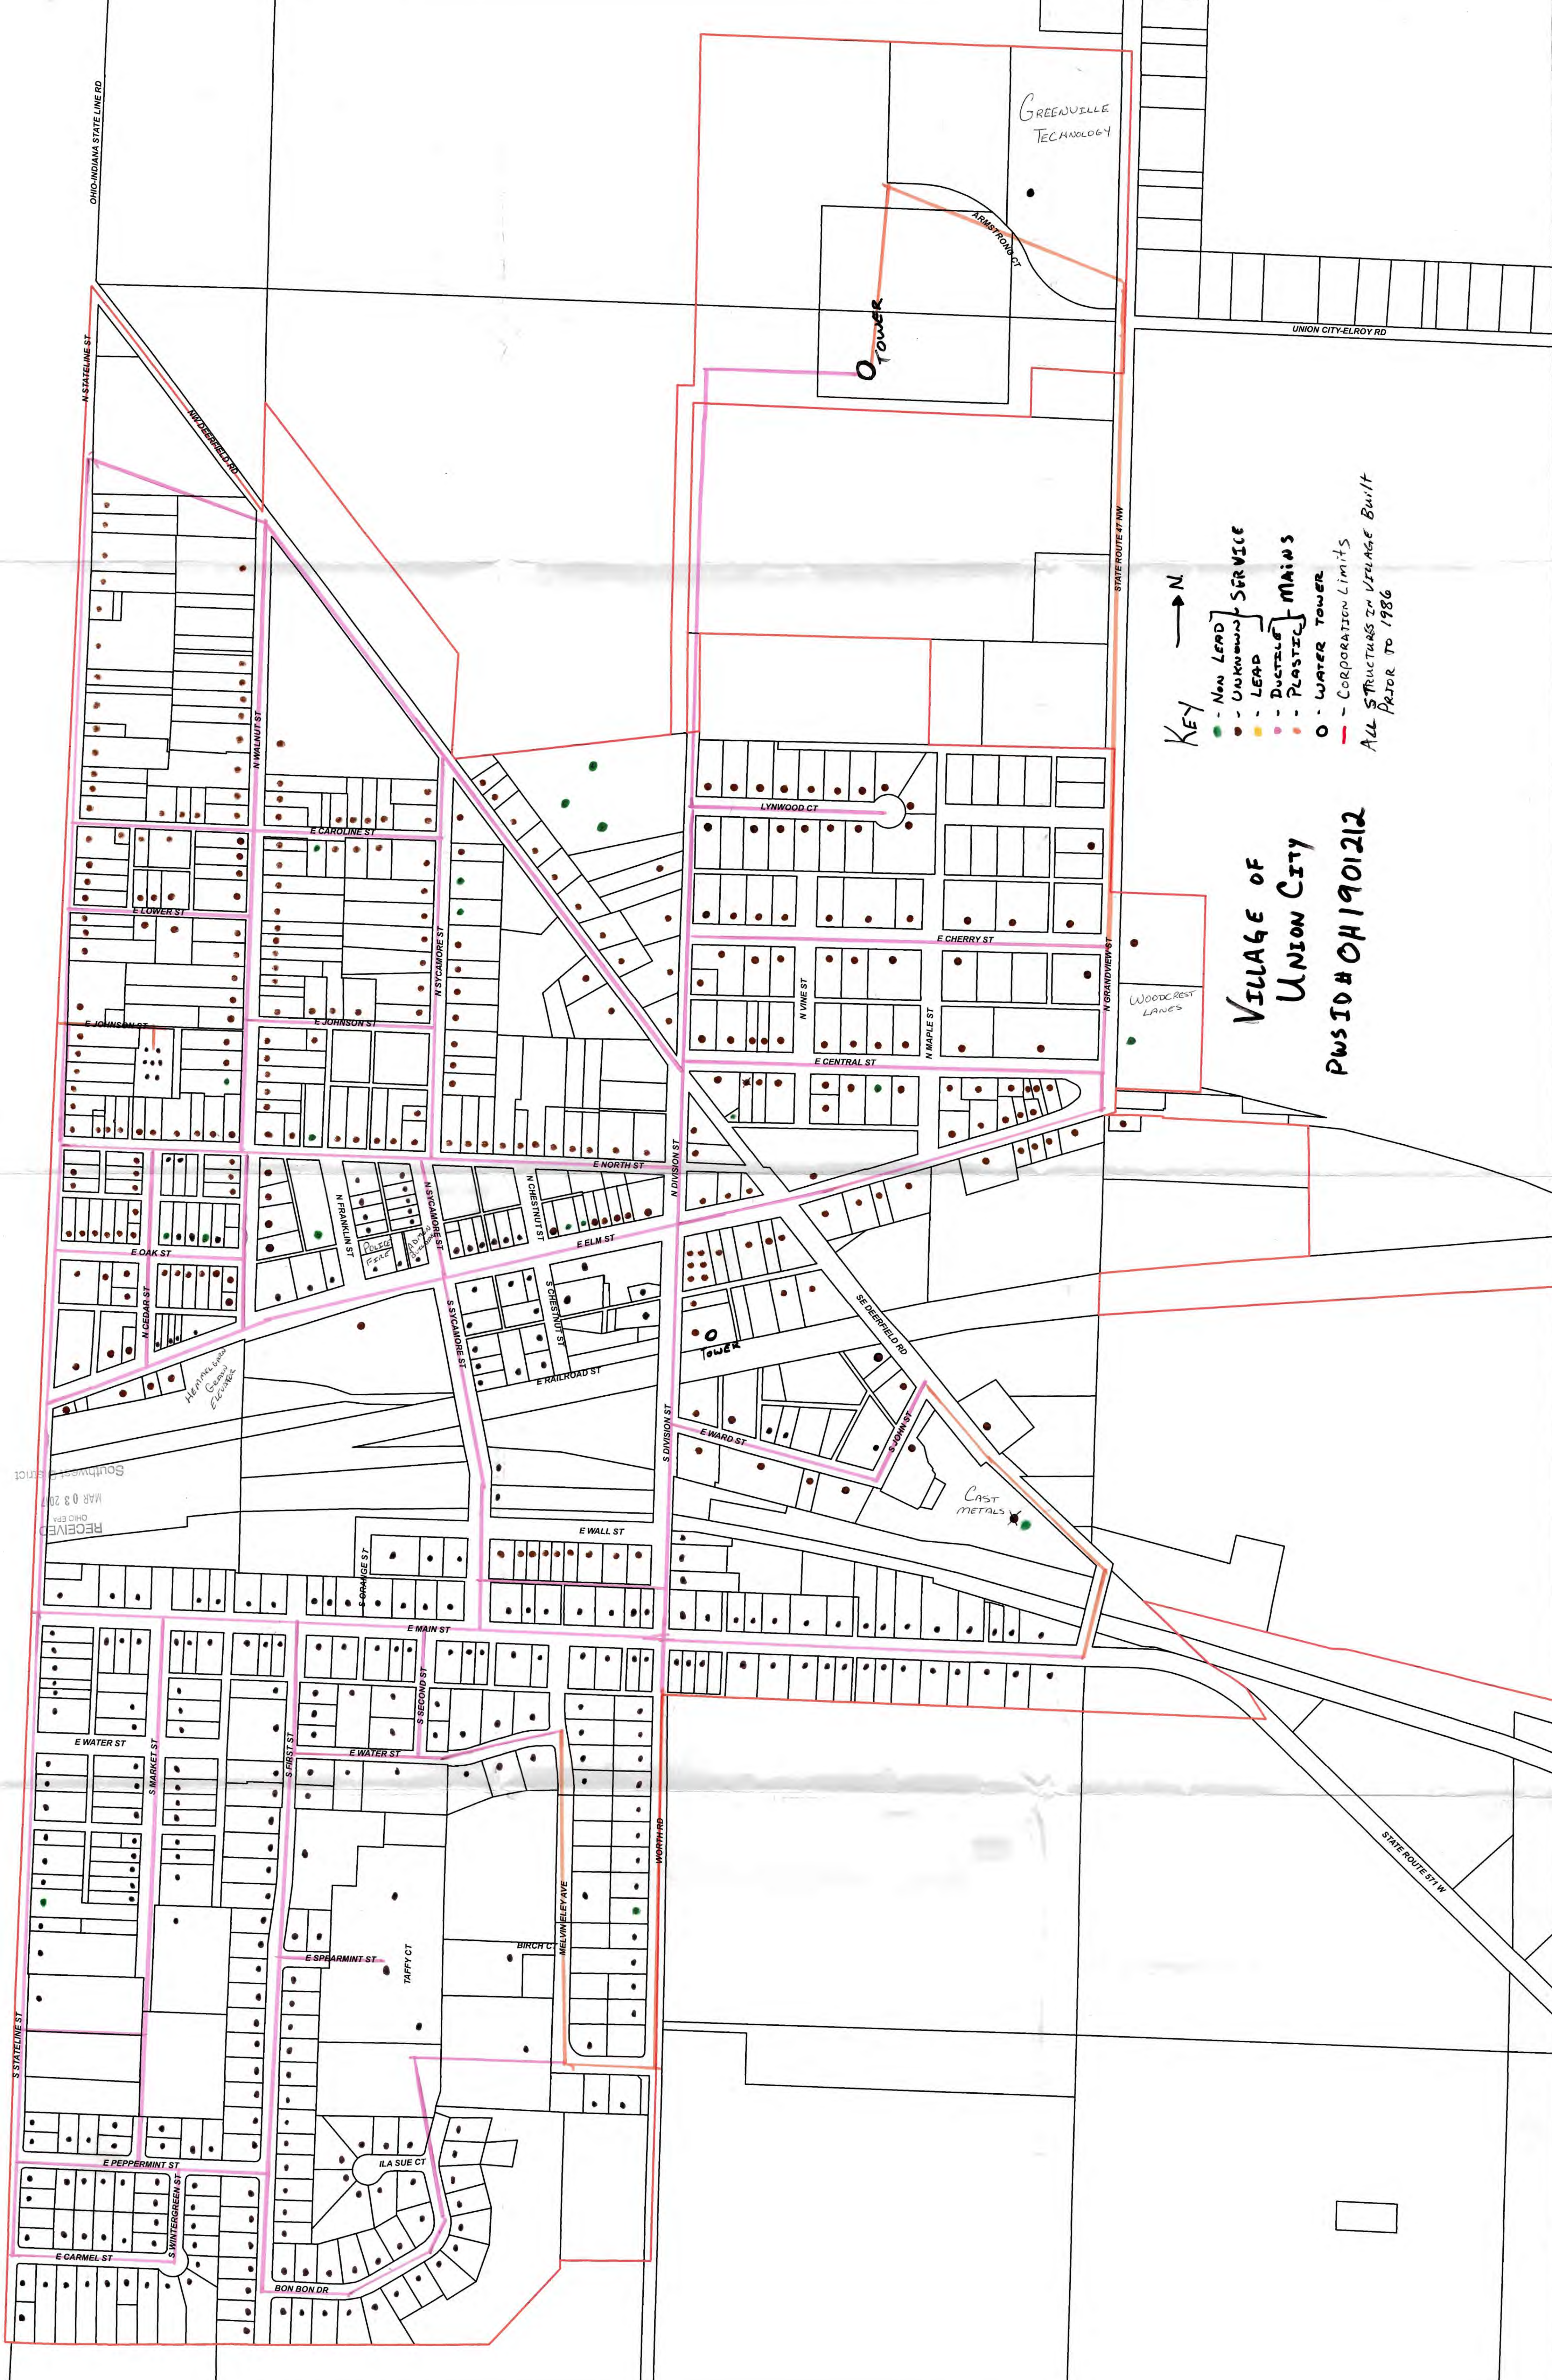

- KEY
 - - UNKNOWN SERVICE
 - - LEAD
 - - DUCTILE MAINS
 - - PLASTIC MAINS
 - - WATER TOWER
 - - - CORPORATION LIMITS
 - - - ALL STRUCTURES IN VILLAGE BUILT PRIOR TO 1986

VILLAGE OF
UNION CITY
PWSID # OH1901212

GREENVILLE
TECHNOLOGY

UNION CITY-ELROY RD


N GRANDVIEW ST

SE DEERFIELD RD




TOWER

LYNWOOD CT

E CHERRY ST

E CENTRAL ST

E NORTH ST

E ELM ST

E RAILROAD ST

E WALL ST

E MAIN ST

E WATER ST

E WATER ST

E SPEARMINT ST

E PEPPERMINT ST

E CARMEL ST

BON BON DR

N STATELINE ST

N WALNUT ST


N SYCAMORE ST

N SYCAMORE ST

- 216 Cardline St. Leak at meter pit lead line from water main to meter pit was replaced with 3/4 inch copper- June 2016
- 201 Oak St. replaced a leaking service line from water main to curb stop with 3/4 copper-Aug. 2016
- 341 S. Stateline St. replaced lead service line from water main to meter with 3/4 inch copper- May 2016
- 319 Walnut St. replaced frozen lead service line from water main to meter with 3/4 copper-Dec. 2015
- 117 Franklin St. Installed new 2 inch copper service line from water main to meter pit- Oct. 2015
- 818 Central St. replaced leaking service line from water main to curb stop with 3/4 inch copper-Aug. 2015
- 280 N. Sycamore St. customer requested to replace 2 inch service line with 3/4 inch copper-June 2015
- 100 N. Grandview St. New service 2 inch CTS plastic from water main to curb stop- Apr. 2015
- 215 Oak St. lead service line found during water main break repair, replace service line with 3/4 inch copper-Jan. 2015
- 413 N. Division
415 N. Division
417 N. Division Connected all three address with 2 inch copper service line from water main to meter pit-Aug. 2014
- 305 SE Deerfield St. during road reconstruction new 3/4 inch copper service line was installed- July 2014
- 310 SE Deerfield St. During road reconstruction new 2 inch copper service line was installed-July 2014
- 319 North St. replaced lead service line with 3/4 inch copper during a water main repair-May 2014

Union City water mains are all 2 inch, 4 inch, 6 inch, and 8 inch C-900 and Ductile iron.

We believe that Village of Union City do have more lead service lines within the village. As we find these lead service lines we will continue to replace these services with copper or/and CTS plastic tubing and up date our maps as we replace lead service lines.

We believe that all homes in Union City, Ohio where built prior to 1986 which does contain lead lines and/or lead solder.

Reporting

Rick Snyder
Village of Union City
937-459-0924 cell