



## Map Legend

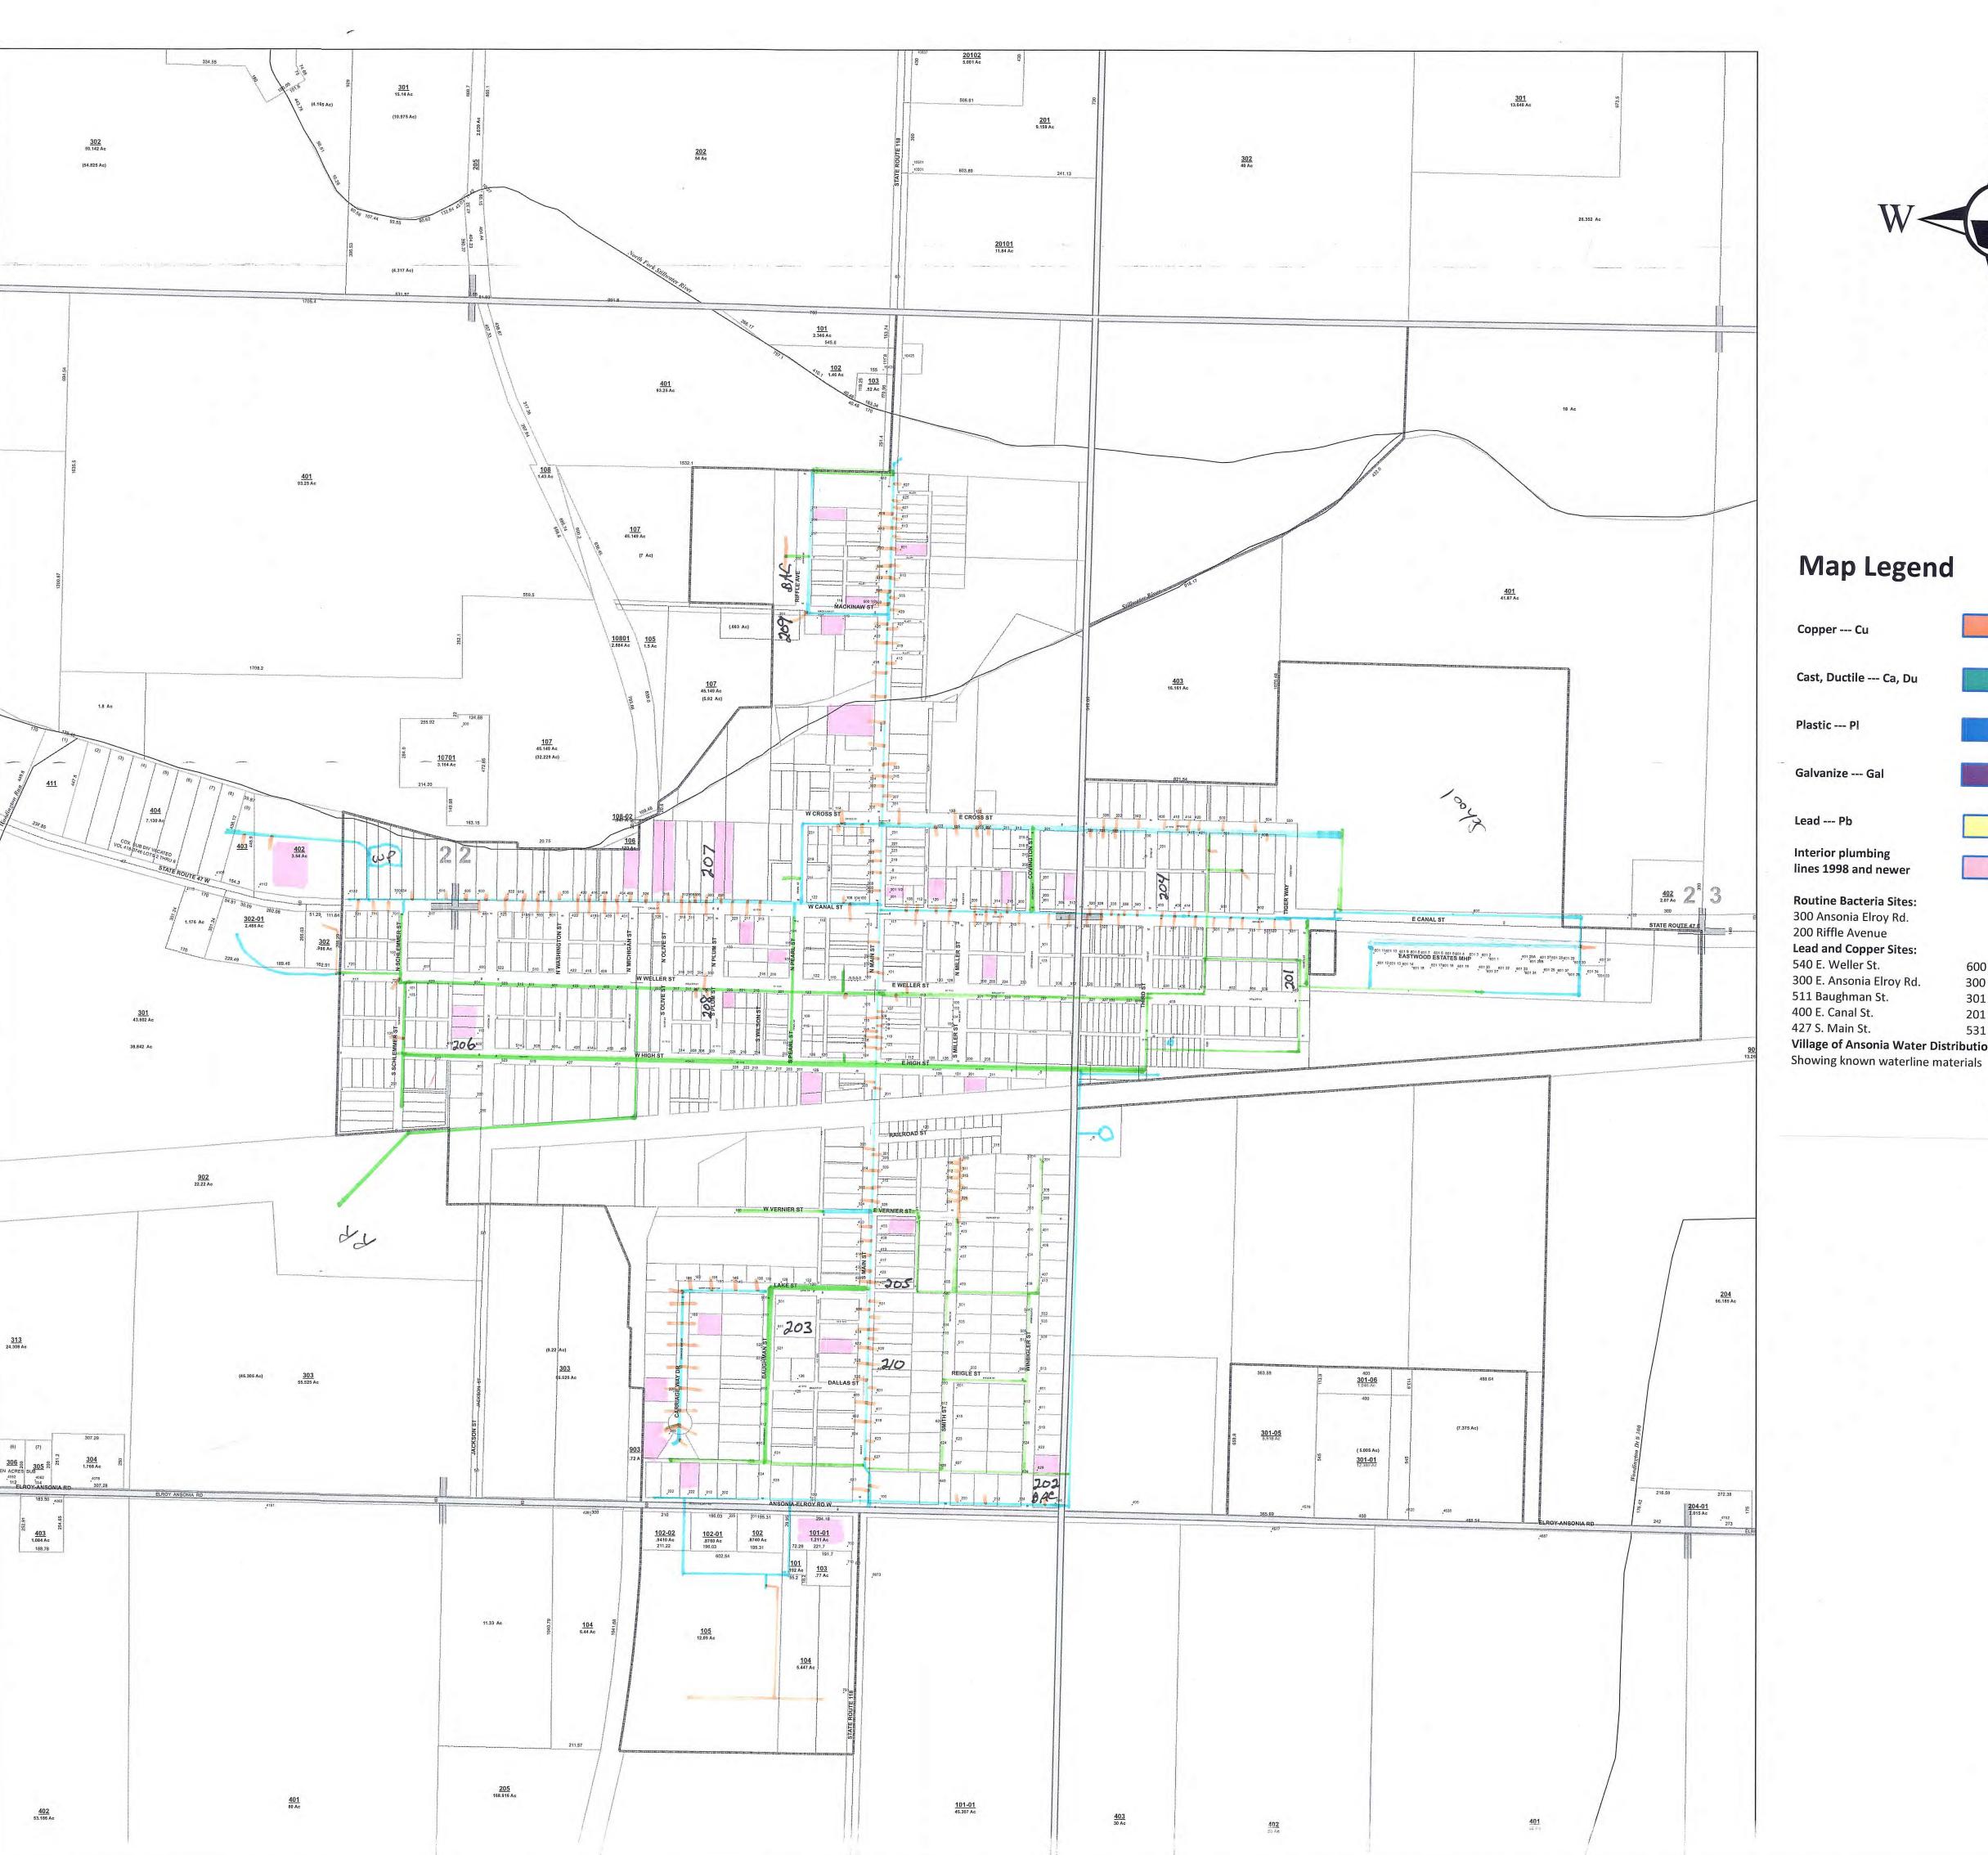

Prepared by PWD Don DeMange 3/2017

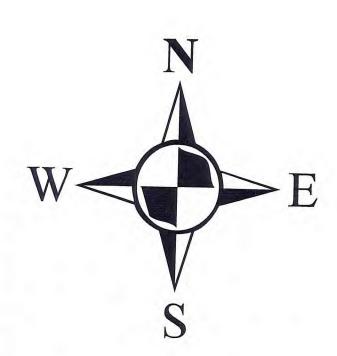



## Map Legend



Prepared by PWD Don DeMange 3/2017

## Village of Ansonia

202 N. Main St. PO Box 607 Ansonia, Ohio 45303 937 337-6781 ext 3

# Water Line Distribution Information

# Legend

Copper --- Cu



orange

Cast, Ductile --- Ca, Du



green

Plastic --- Pl



blue - Includes all plastics

**Galvanize --- Gal** 



purple

Lead --- Pb



yellow

**SMP ID#--Listed on Spreadsheet** 

2 Bacteria Sample Sites Listed on Spreadsheet