



5844 Jaysville-St. John's Rd
Greenville, Ohio 45331

Administrative Office | Phone: (937) 548-9057
Fax: (937) 548-8585

Community Services | Phone: (937) 548-3350
Fax: (937) 548-8585

All people are valuable and have potential

February 22, 2017

Scott Eardley
Ohio EPA Southwest District Office
401 E. Fifth Street
Dayton, OH 45402

RECEIVED
OHIO EPA

FEB 24 2017

Southwest District

Dear Mr. Eardley,


Per the requirements of Ohio House Bill 512, enclosed please find the map of the distribution system containing lead service lines for the Anthony Wayne School, PWS ID OH1930512, located at 4932 Children's Home Bradford Road, Greenville, OH 45331. The sample monitoring point identification information has already been submitted.

If you have any questions or need any additional information, please feel free to contact me at (937) 548-9057, ext. 3019.

Sincerely,

Tonya Clark
Business Manager


cc: Ohio Department of Health
Ohio Department of Job & Family Services

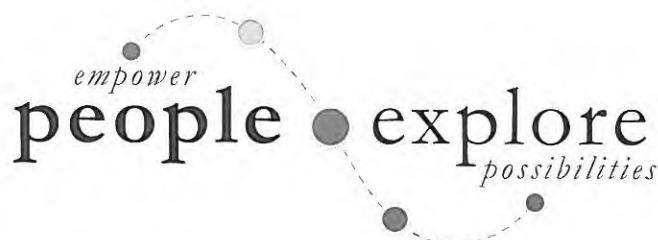



Childrens Home Bradford Road

Front Entrance

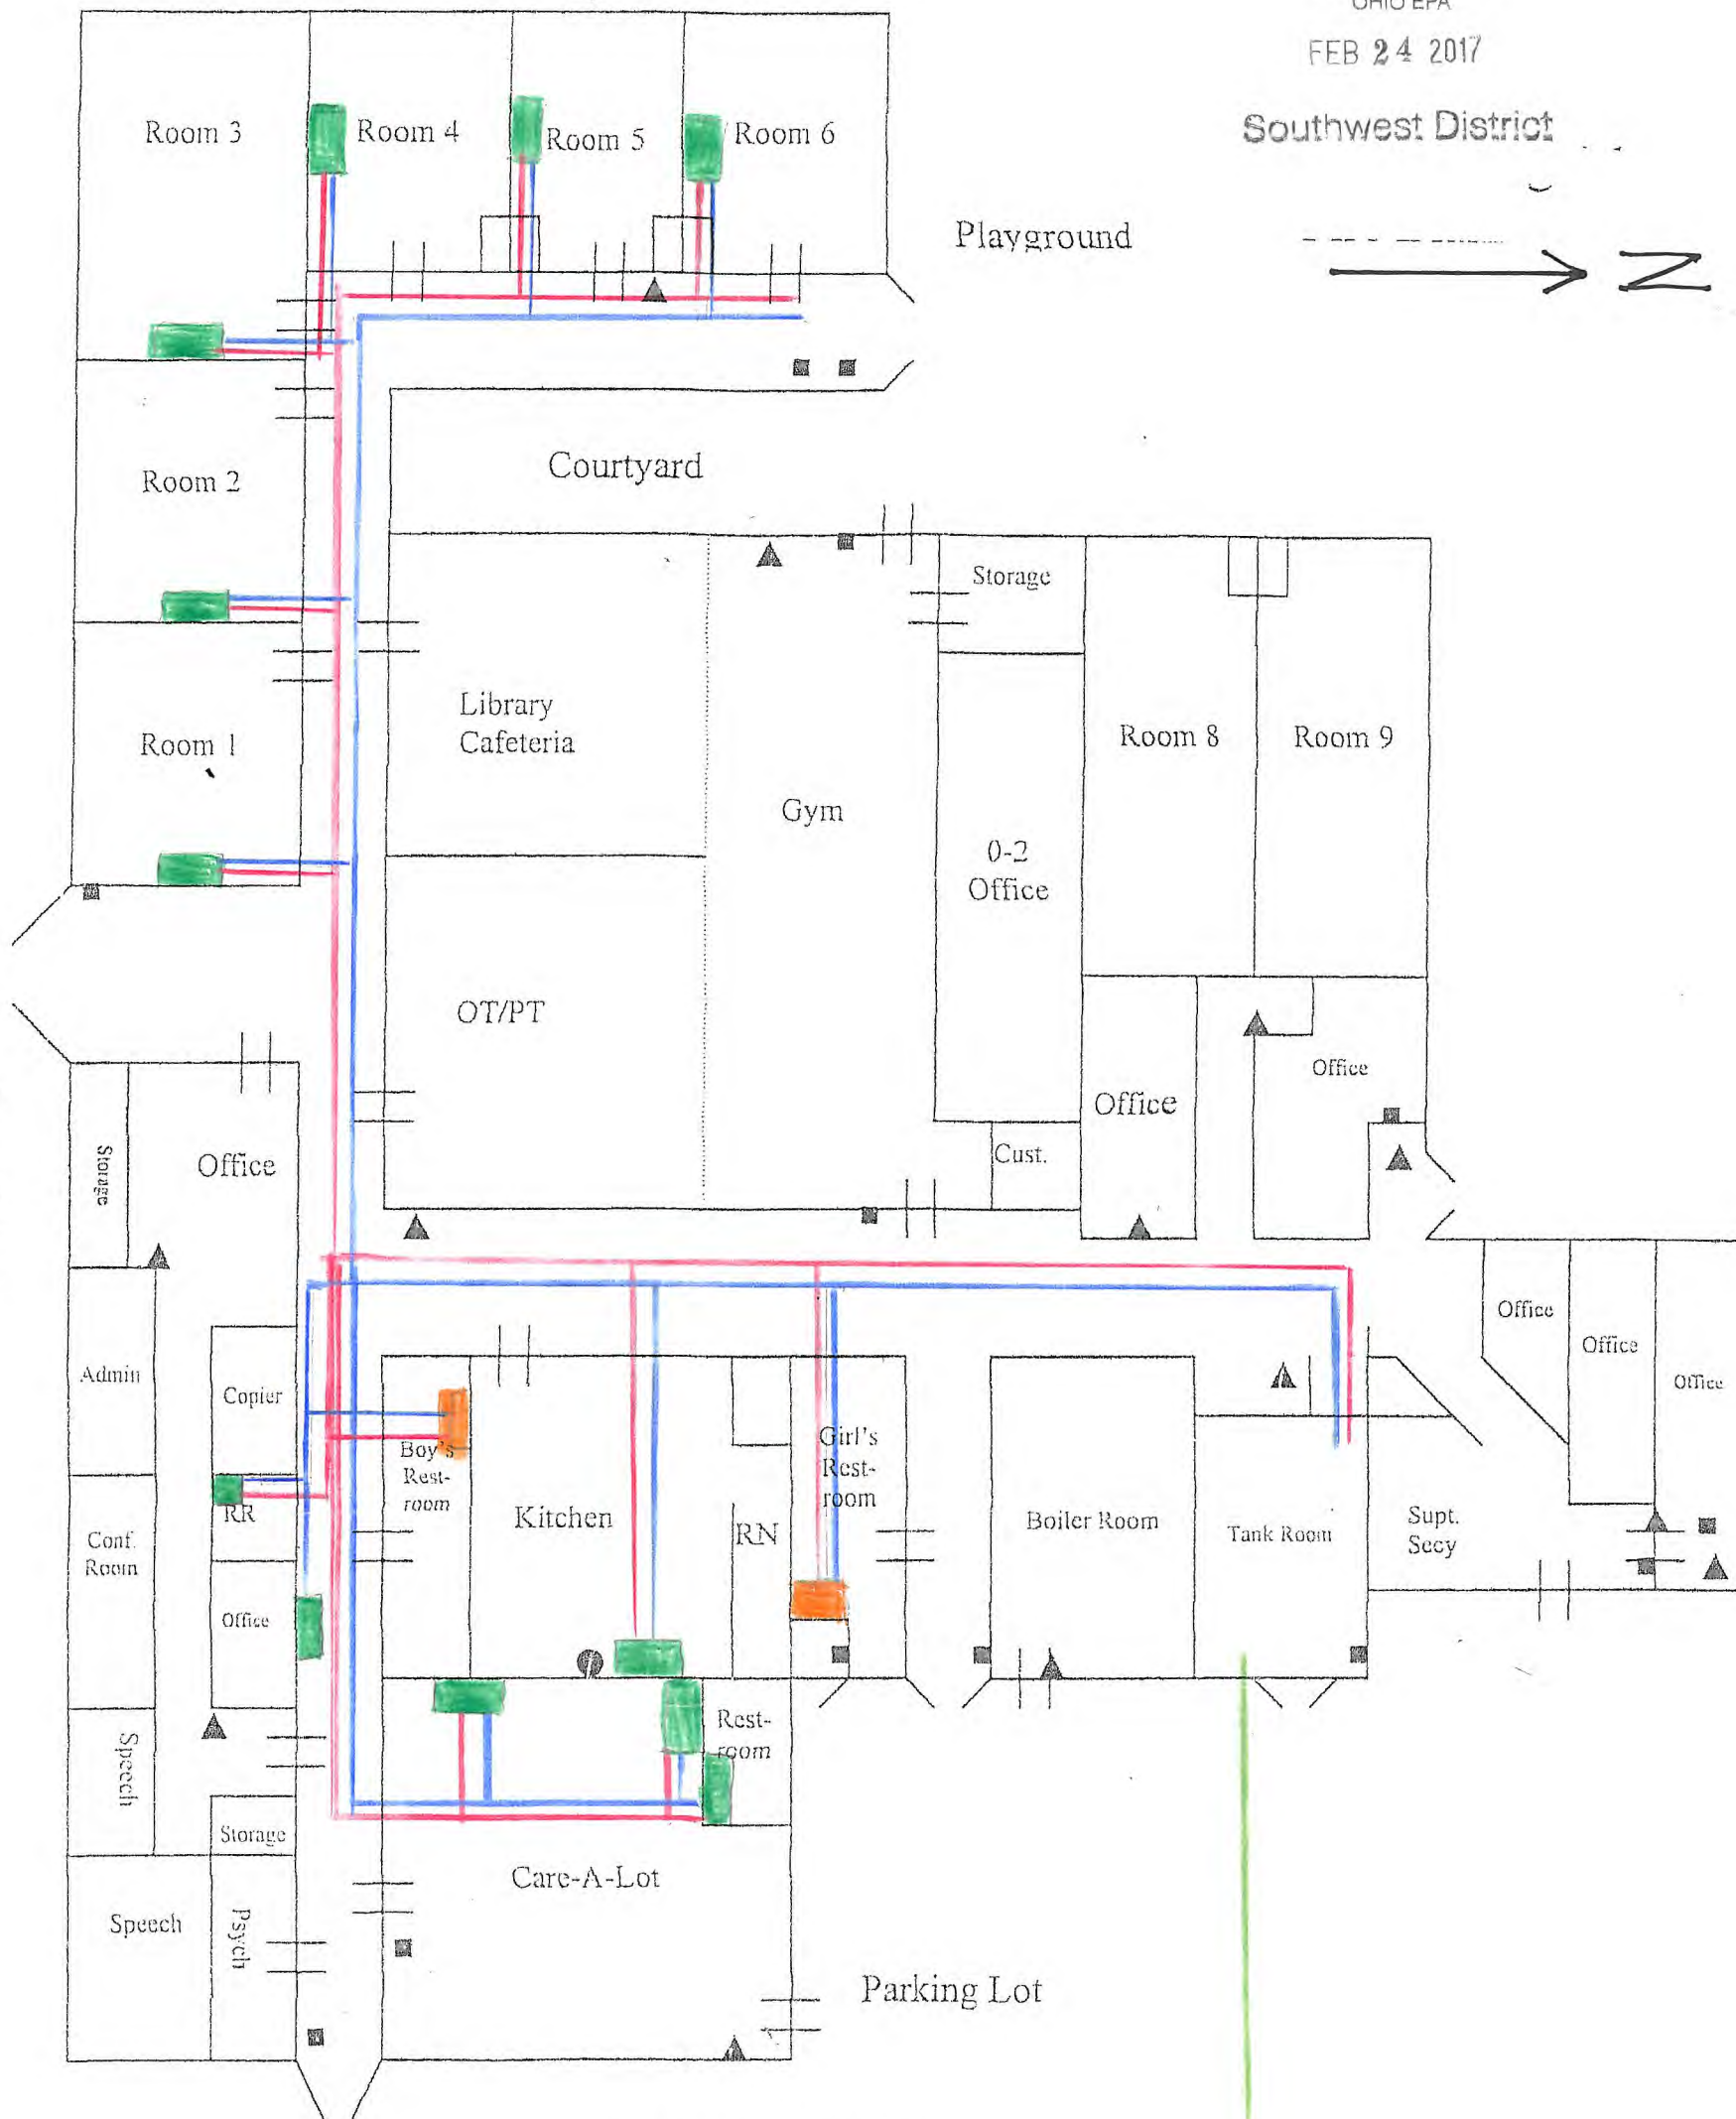

OH1930512

Anthony Wayne Early Childhood
 Center/Darke County Board of MR/DD
 4932 Child Home - Bradford Rd
 Greenville OH 45331
 Constructed 1966
 937-548-8323

- Sink fixtures installed pre 1998
- Sink fixtures installed Post 1998
- Cold Water copper pipe installed 1966
- Hot Water copper pipe installed 1966
- PVC Well water Service