

RECEIVED  
OHIO EPA

FEB 24 2017

Southwest District

# WEST MANCHESTER INDEX


MONROE TOWNSHIP

PREBLE COUNTY

OHIO

1986

PWSID # BH6801412

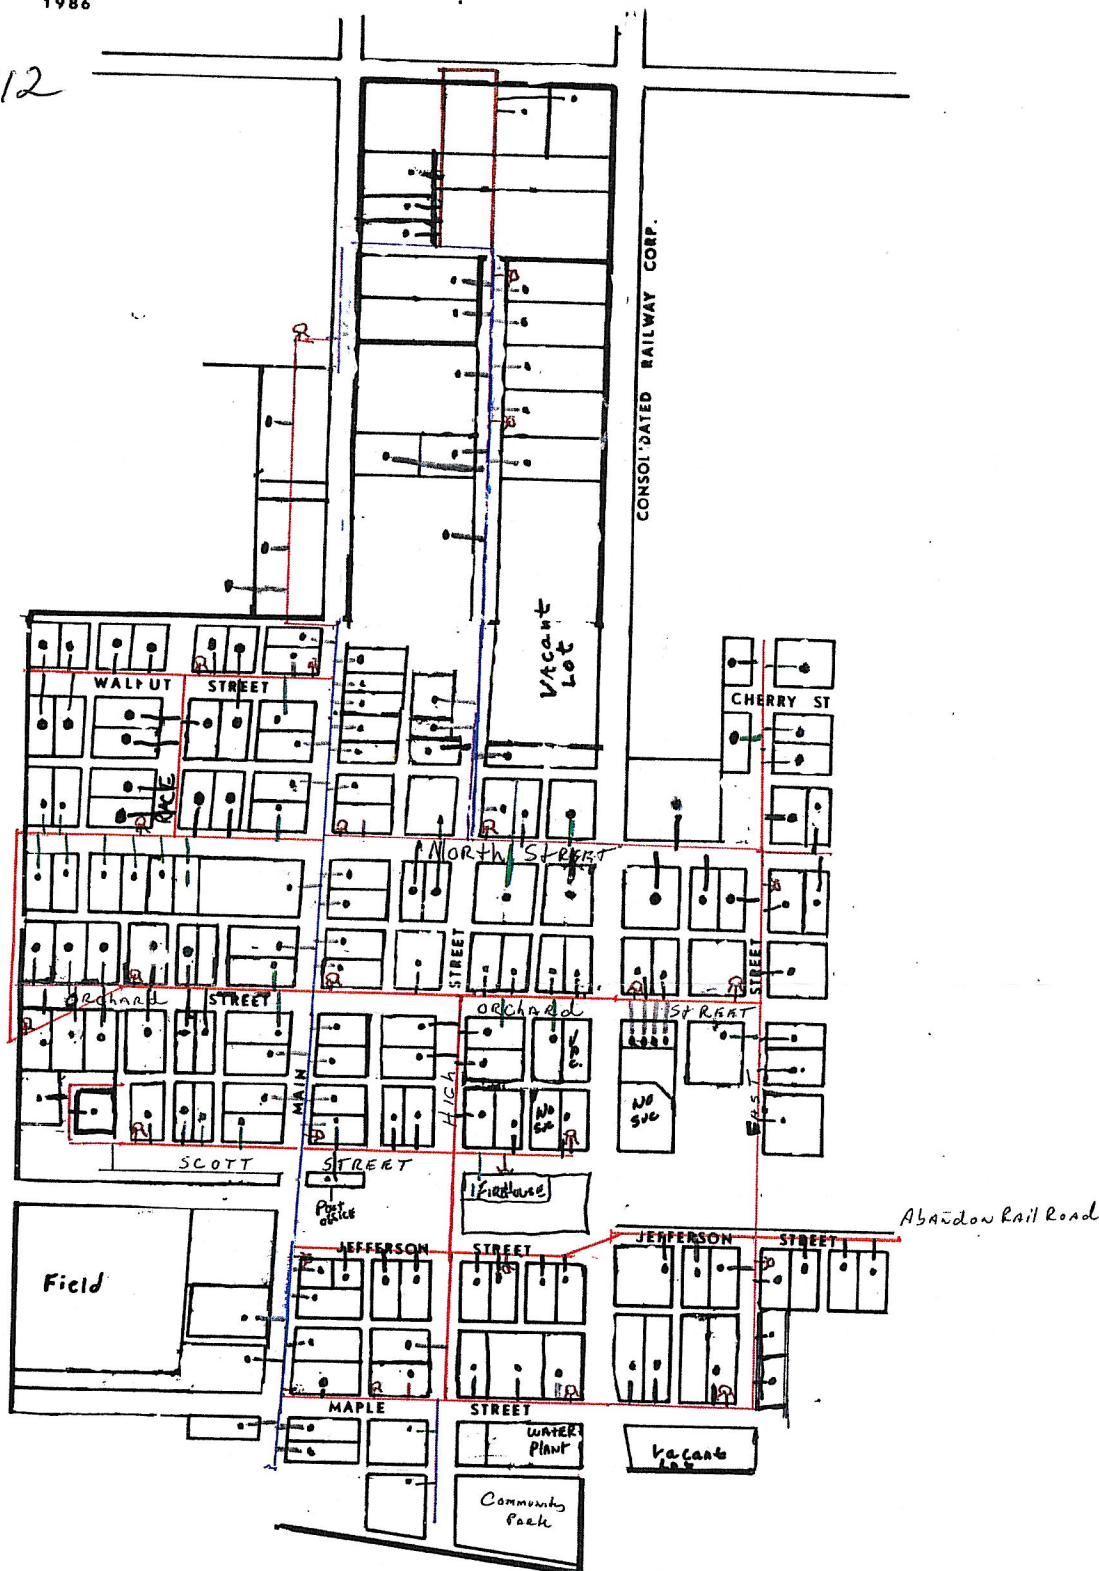

- 10" Plastic
- 6" Ductile Iron
- 4" Ductile Iron
- 2" Ductile Iron
- 3" 8" Plastic
- 2" Hydrant
- Plastic
- Copper
- unknown
- AC Pipe 4"
- Yellow Lead


## COUNTY COMMISSIONERS

JOAN BRUBAKER  
JON JORDAN  
PAUL RAY

## COUNTY ENGINEER

J STEPHEN SIMMONS

SCALE:

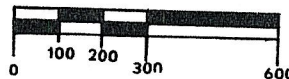

Copy Right Reserved By County Engineer




VILLAGE OF  
WEST MANCHESTER  
PWS ID# 04 0801412

RECEIVED  
OHIO EPA

FEB 24 2017

## Southwest District

- = Non lead
- = No Information
- = Lead

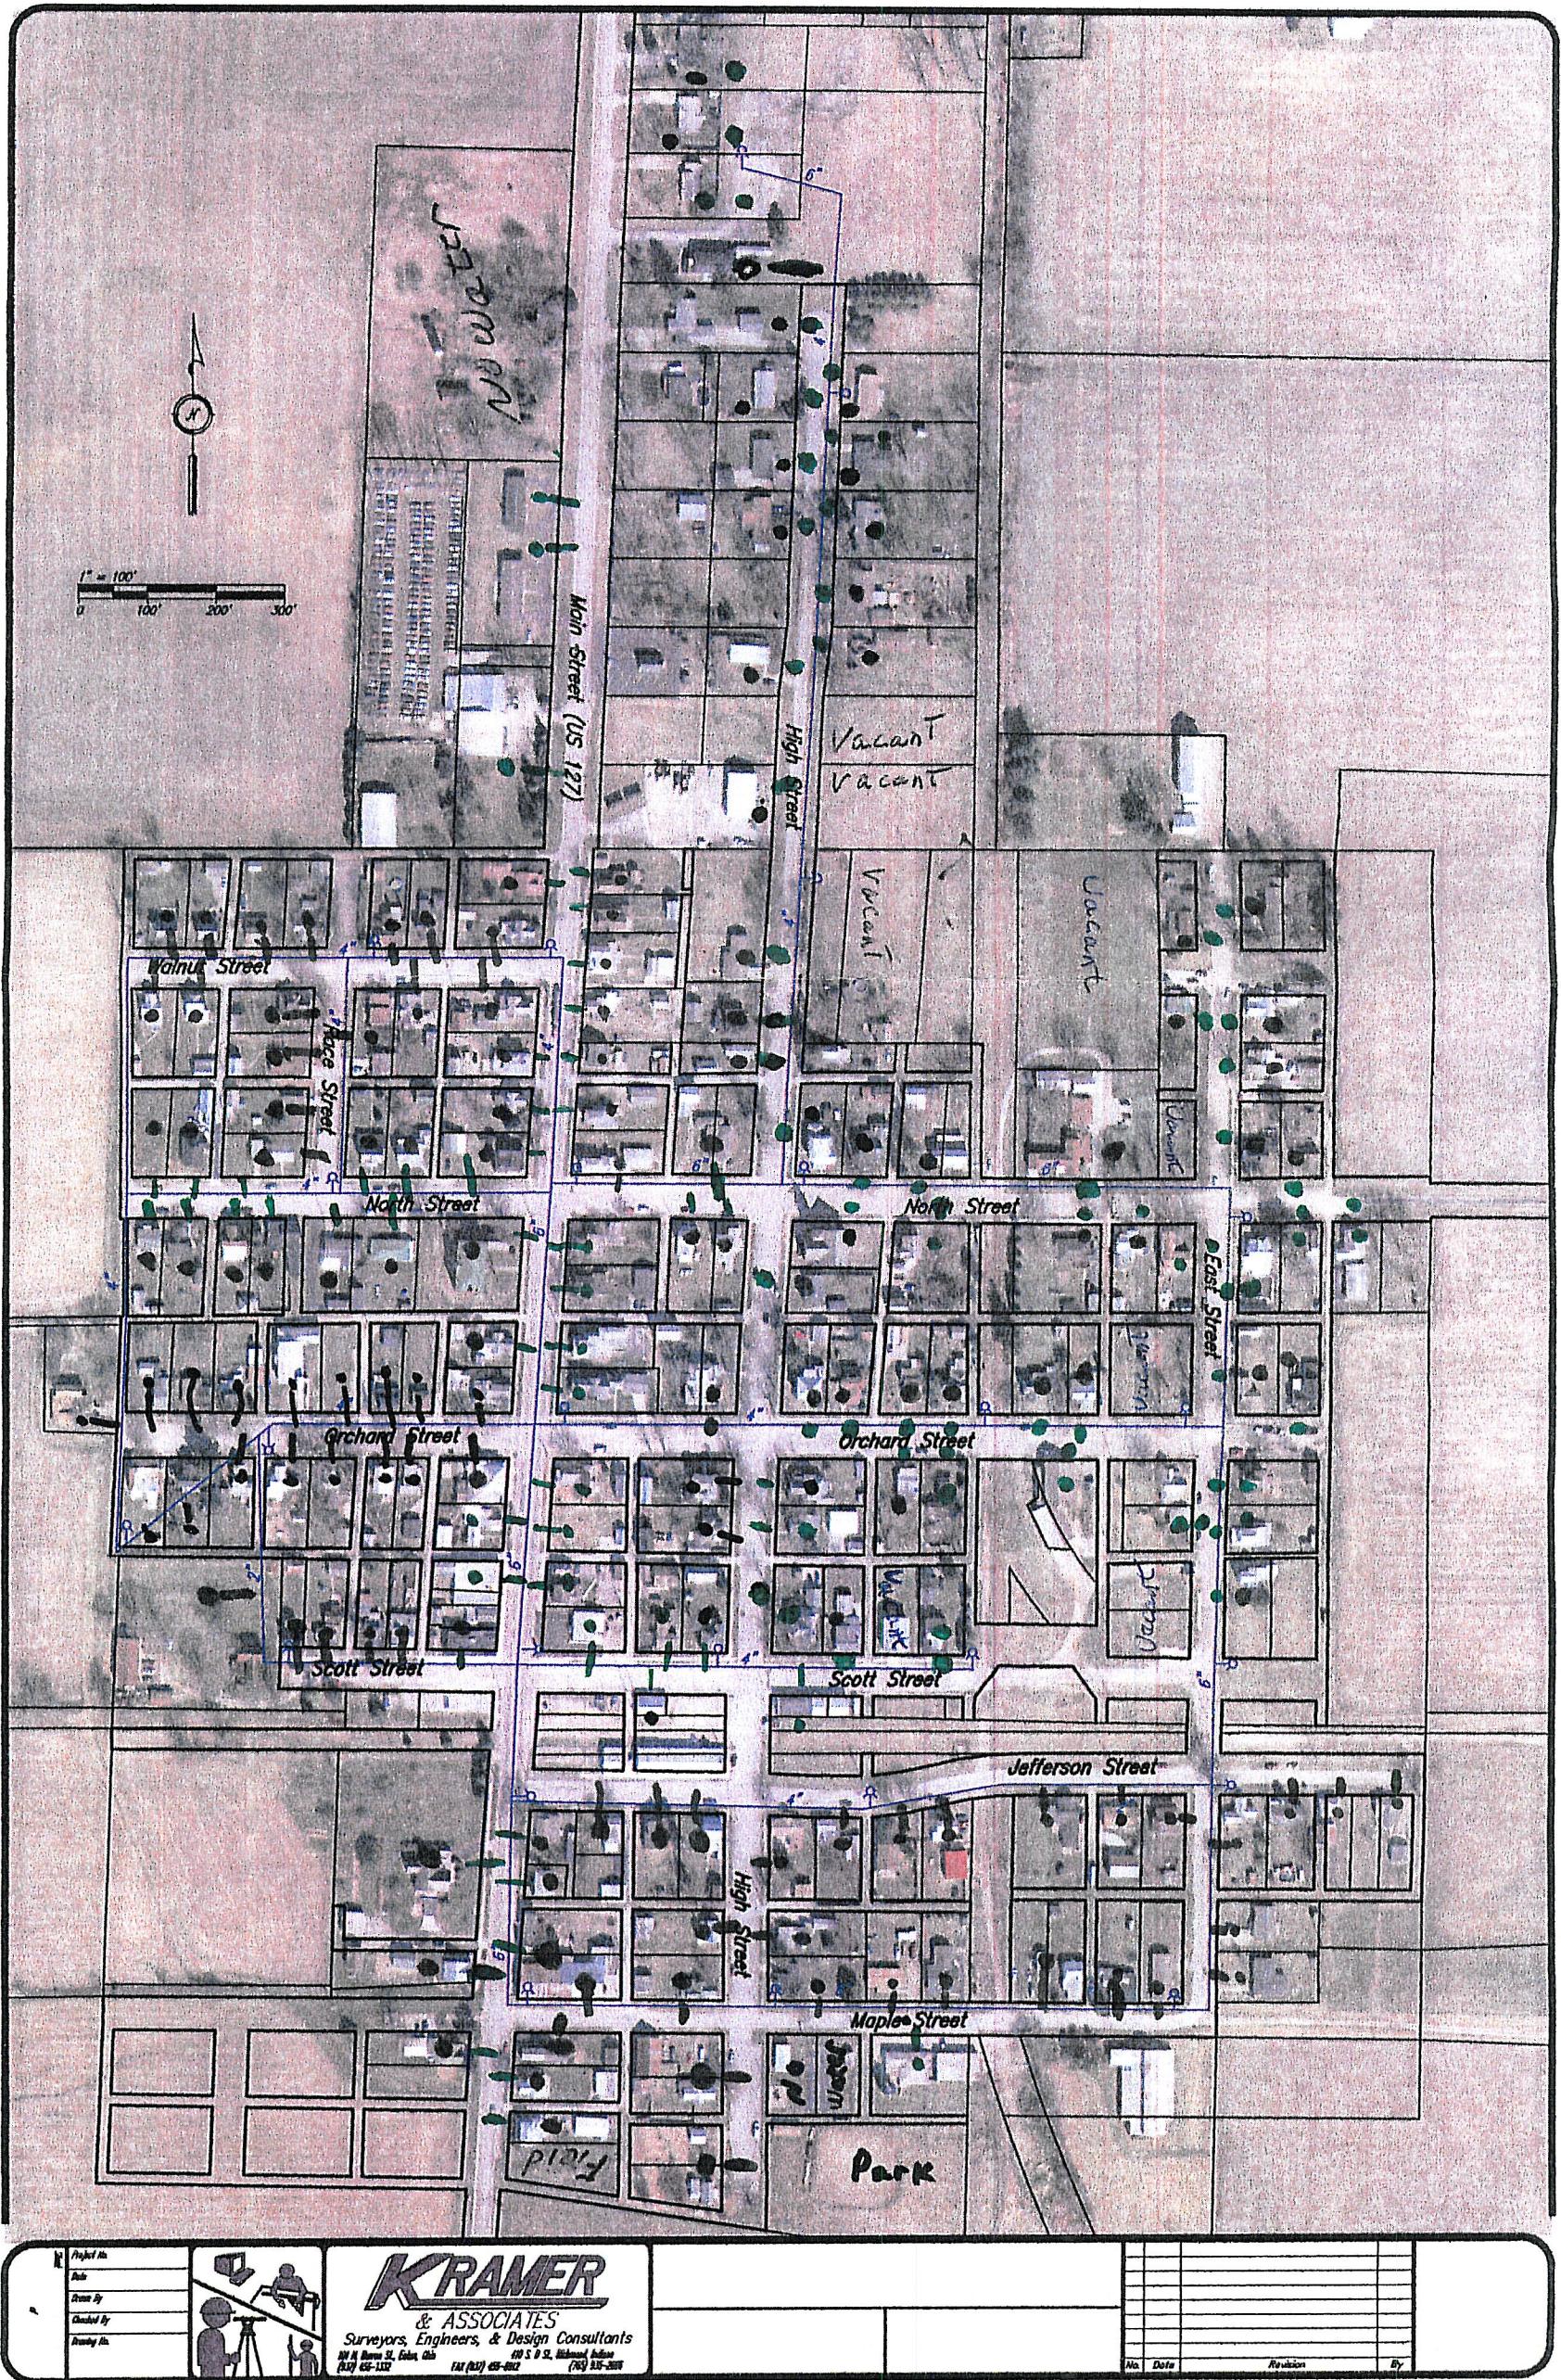



**VERIFICATION FORM FOR COMMUNITY PUBLIC WATER SYSTEMS  
CLAIMING NO LEAD SERVICE LINES**

The owner or operator of all community public water systems must identify and map areas of their distribution system that are known or are likely to contain lead service lines. Systems must submit a copy of the applicable map to the Ohio Department of Health and the Ohio Department of Job and Family Services. Systems must also submit a report to the director containing at least both of the following: (1) The applicable map with narrative, and (2) A list of sampling locations used to collect samples as required by Ohio Revised Code (ORC) Section 6109.121 and any rules adopted thereunder, including contact information for the owner and occupant of each sampling site.

Should a water system determine no lead service lines exist in their distribution system, they must provide information stating they reviewed, at the minimum, historical permit records and local ordinances, distribution maintenance records and information pertaining to installation dates or materials for all service lines. This information must be verified below.

I HEREBY CERTIFY THAT THE FOLLOWING METHOD(S) WERE USED TO DETERMINE NO LEAD SERVICE LINES EXIST IN THIS WATER SYSTEM'S DISTRIBUTION SYSTEM, AS REQUIRED BY ORC 6109.121(F):

**LEAD SERVICE LINE VERIFICATION**

This PWS states they have no lead service lines and has reviewed the following information (select one or more of the following):

- ☐ Historical permit records and/or local ordinances
- ☒ Distribution maintenance records (i.e. meter replacement, waterline break repairs)
- ☐ Information pertaining to installation dates for all service lines (i.e. after 1986 when lead services lines were banned)
- ☐ Service line material of all service lines is known (i.e. all service lines are known to be PVC)

Forrest Hayes                      2-28-17  
Signature of Responsible Person                      Date

Forrest Hayes  
Printed Name and Title of Responsible Person

PWS NAME: West Manchester  
PWS ID: OH 6801412  
COUNTY: Preble