


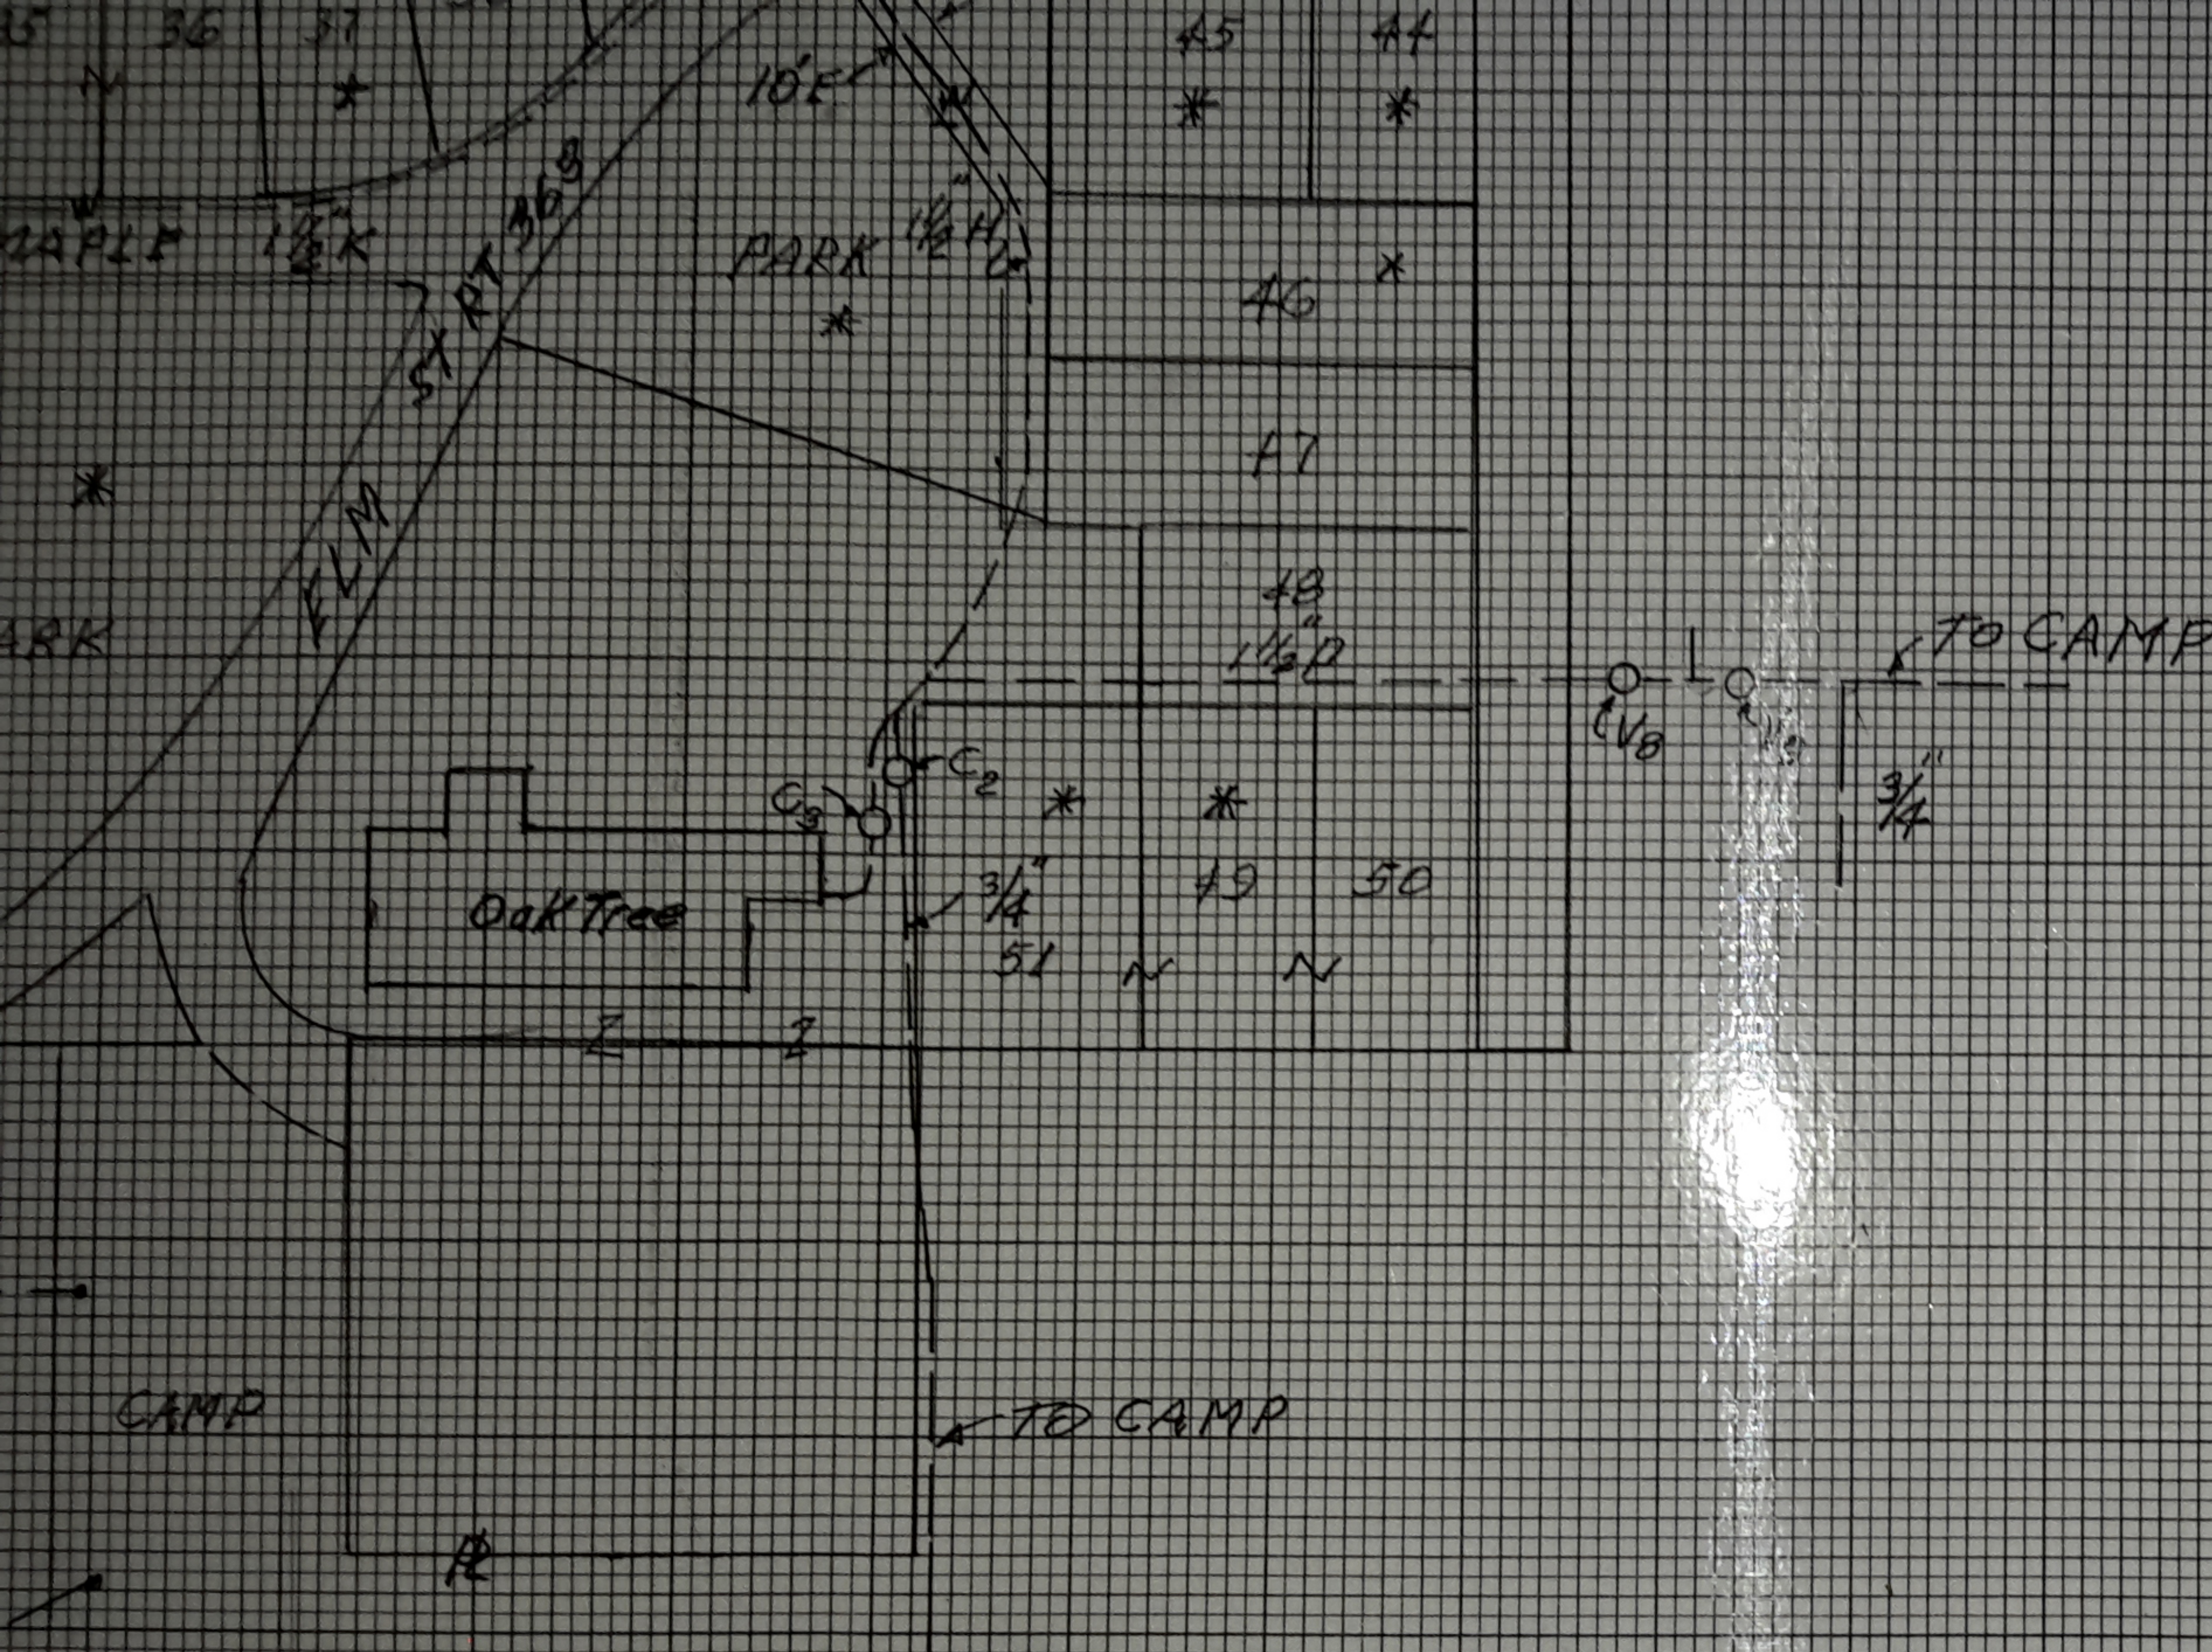

Scale 1" = 40'

NOTES AND LEGENDS

T-1 thru T28 are mobile home sites
 All 3", 2" and 1 1/2" lines are PVC
 or plastic hose. No lead pipes
 are or were used for service lines
 Oak Tree Restaurant was served by
 Private Well prior to 1967.
 Mobil home sites and Lots 52 thru 66
 did not exist until water system
 was put into service in 1967
 North camp put in service 2017

- K = Karlastic pipe 1967
- V = System Valve
- C = Customer Service Valve
- CAMP = Lotus Cove Campground
- 3"-21 = SDR21 PVC 2010
- * = No Service as of 1/20/17.

NORTHVIEW UTILITY DISTRIBUTION SYSTEM	
Date 1/20/17	
By: N.A.	By: KLH