

Country Meadows Condominiums
Lead and Copper Program

Country Meadows consists of 7 brick buildings and one home. There are three units in each building for a total of 21. The distribution system is 2-inch plastic line with a copper tribar with three $\frac{3}{4}$ inch lines one for each unit in front of each building. All joints are lead soldered outside and inside each unit. The pump house consists of 2-inch copper from the detention tanks thru softening units to the entry point of the distribution system. All joints are lead soldered. The only meter is in the pump house. The individual house is the same as the condo's. Five samples are required every three years. Samples are neither tier 1, 2, or 3 sites, they are marked as other. Indoor plumbing material is CuPb <83. All locations will be SMP ID as LC 201.

Because it is practically impossible to determine the lead content of an installed fixture, fitting or pipe, it should be assumed that the manufacture or installation date is the primary indicator of the lead content. Therefore, the characteristics of buildings and piping solder or fixtures would be buildings in Ohio built prior to 1998 or that use plumbing material or solder manufactured before 1998 may have materials with greater than 8% lead and are at a higher risk of contributing lead to the drinking water than materials manufactured after 1998. In addition, buildings built and plumbing materials manufactured after 2014 were required to have less than 0.25% lead by weight and have the lowest risk for contributing lead to the drinking water. It should be noted however that, although prohibited, some use of leaded solder or leaded components may have occurred after the prohibitions became effective.

Ron Trissel




Operator-in-Charge

937-778-1025-Home

937-541-3506-cell

COUNTRY MEADOWS CONDOMINIUMS

Built in 1969

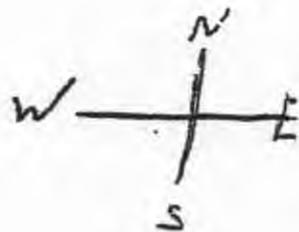


key

No Tier sites - (other)

SMP FD - LC: 201-210

 3/4 inch Lead solder copper pipe

 2 inch Black Plastic Pipe

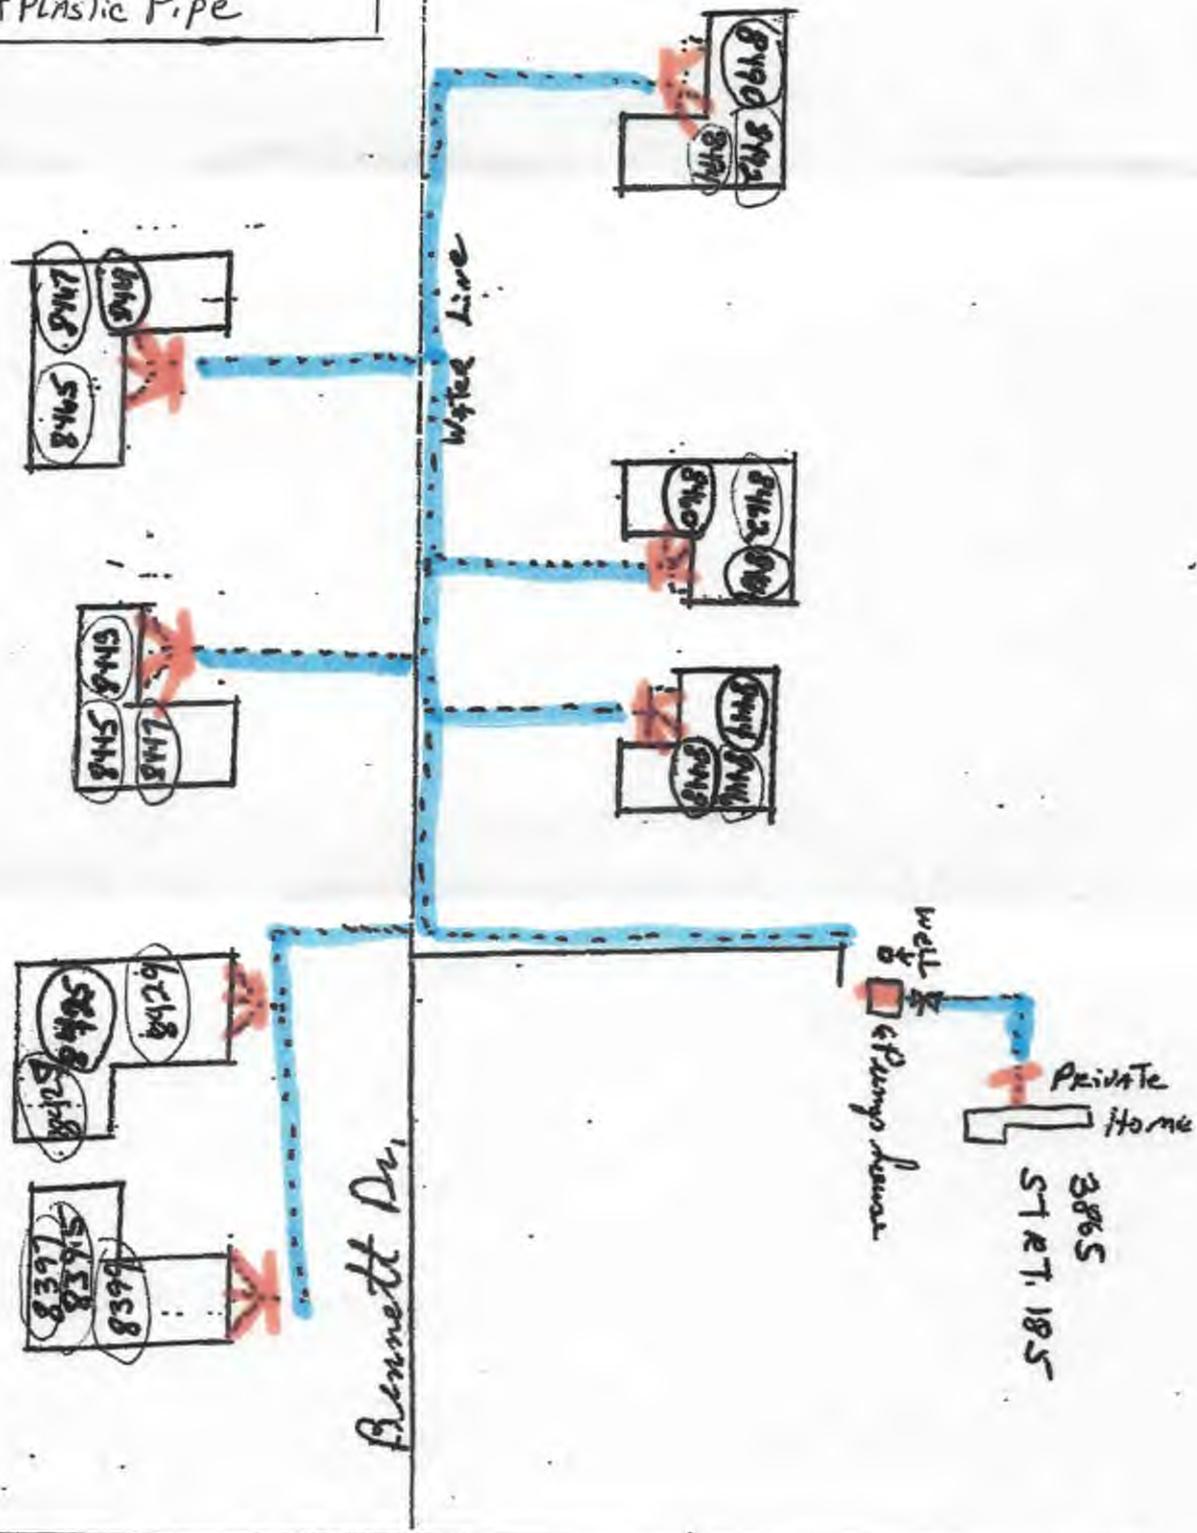

STATE ROUTE 185

VERIFICATION FORM FOR COMMUNITY PUBLIC WATER SYSTEMS CLAIMING NO LEAD SERVICE LINES

Systems must also submit a report to the director containing at least both of the following: (1) The applicable map with narrative, and (2) A list of sampling locations used to collect samples as required by Ohio Revised Code (ORC) Section 6109.121 and any rules adopted thereunder, including contact information for the owner and occupant of each sampling site.

Should a water system determine no lead service lines exist in their distribution system, they must provide information stating they reviewed, at the minimum, historical permit records and local ordinances, distribution maintenance records and information pertaining to installation dates or materials for all services lines. This information must be verified below.

I HEREBY CERTIFY THAT THE FOLLOWING METHOD(S) WERE USED TO DETERMINE NO LEAD SERVICE LINES EXIST IN THIS WATER SYSTEM'S DISTRIBUTION SYSTEM, AS REQUIRED BY ORC 6109.121(F):

LEAD SERVICE LINE VERIFICATION
<p>This PWS states they have no lead service lines and has reviewed the following information (select one or more of the following):</p> <ul style="list-style-type: none"> • Historical permit records and/or local ordinances • Distribution maintenance records (i.e. meter replacement, waterline break repairs) • Information pertaining to installation dates for all service lines (i.e. after 1986 when lead services lines were banned) • Service line material of all service lines is known (i.e. all service lines are known to be PVC)

<table style="width: 100%; border-collapse: collapse;"> <tr> <td style="width: 50%; border-bottom: 1px solid black;">Signature of Responsible Person</td> <td style="width: 50%; border-bottom: 1px solid black;">Date</td> </tr> <tr> <td style="border-bottom: 1px solid black;"><i>Ron Trissel</i></td> <td style="border-bottom: 1px solid black;">3/6/17</td> </tr> <tr> <td colspan="2" style="border-bottom: 1px solid black;">Printed Name and Title of Responsible Person</td> </tr> <tr> <td colspan="2" style="border-bottom: 1px solid black;"><i>Ron Trissel Operator-IN-CHARGE</i></td> </tr> </table>	Signature of Responsible Person	Date	<i>Ron Trissel</i>	3/6/17	Printed Name and Title of Responsible Person		<i>Ron Trissel Operator-IN-CHARGE</i>		<p>PWS NAME: <u>Country Meadows</u></p> <p>PWS ID:</p> <p>OH <u>5500012</u></p> <p>COUNTY: <u>Miami</u></p>
