

VILLAGE OF VERONA
138 Mill Street P.O. Box 676
Verona, OH 45378
(937)884-5522 Phone
(937)884-5521 Fax
"A Friendly Community"
www.verona@btzwoh.rr.com

March 7, 2017

Ohio EPA

Our water plant was not in operation until 1962. In 2000, the Village built our new state of the art water plant.

In 2011, the Village installed new 8" water lines and taps on South State St. In 2014, the Village installed new water lines and taps on E. Main St. In 2016, we installed new water lines and taps on West Main St. & North State St.

To my knowledge, all Village properties were built prior to 1998 and are connected with galvanized or copper plumbing. To my knowledge, there are no lead water lines in the Village.

Because it is practically impossible to determine the lead content of an installed fixture, fitting or pipe, it should be assumed that the manufacture or installation date is the primary indicator of the lead content. Therefore, the characteristics of buildings and piping solder or fixtures would be buildings in Ohio built prior to 1998 or that use plumbing material or solder manufactured before 1998 may have materials with greater than 8% lead and are at a higher risk of contributing lead to the drinking water than materials manufactured after 1998. In addition, buildings built and plumbing materials manufactured after 2014 were required to have less than 0.25% lead by weight and have the lowest risk for contributing lead to the drinking water. It should be noted however that, although prohibited, some use of leaded solder or leaded components may have occurred after the prohibitions became effective.

Please call me at 884-5522 with any questions.

Sincerely,

A handwritten signature in black ink, appearing to read "Mary Myers", with a stylized flourish at the end.

Mary Myers
Mayor

**VERIFICATION FORM FOR COMMUNITY PUBLIC WATER SYSTEMS
CLAIMING NO LEAD SERVICE LINES**

The owner or operator of all community public water systems must identify and map areas of their distribution system that are known or are likely to contain lead service lines. Systems must submit a copy of the applicable map to the Ohio Department of Health and the Ohio Department of Job and Family Services. Systems must also submit a report to the director containing at least both of the following: (1) The applicable map with narrative, and (2) A list of sampling locations used to collect samples as required by Ohio Revised Code (ORC) Section 6109.121 and any rules adopted thereunder, including contact information for the owner and occupant of each sampling site.

Should a water system determine no lead service lines exist in their distribution system, they must provide information stating they reviewed, at the minimum, historical permit records and local ordinances, distribution maintenance records and information pertaining to installation dates or materials for all services lines. This information must be verified below.

I HEREBY CERTIFY THAT THE FOLLOWING METHOD(S) WERE USED TO DETERMINE NO LEAD SERVICE LINES EXIST IN THIS WATER SYSTEM'S DISTRIBUTION SYSTEM, AS REQUIRED BY ORC 6109.121(F):

LEAD SERVICE LINE VERIFICATION
<p>This PWS states they have no lead service lines and has reviewed the following information (select one or more of the following):</p> <ul style="list-style-type: none"><input type="checkbox"/> Historical permit records and/or local ordinances<input checked="" type="checkbox"/> Distribution maintenance records to the best of my knowledge<input type="checkbox"/> Information pertaining to installation dates for all service lines (i.e. after 1986 when lead services lines were banned)<input type="checkbox"/> Service line material of all service lines is known (i.e. all service lines are known to be PVC)



Mary Myers, Mayor 3/7/2017
Signature of Responsible Person Date
MARY MYERS MAYOR
Printed Name and Title of Responsible Person

PWS NAME: Verona Village of
PWS ID: OH6807212
COUNTY: Preble

For Ohio EPA use only:
Date Verification Rec'd: _____

THE VILLAGE OF VERONA WATER DISTRIBUTION SYSTEM

LEAD MAPPING PROJECT
PWS NAME: VERONA, VILLAGE OF
PWS ID#: 0H6801212

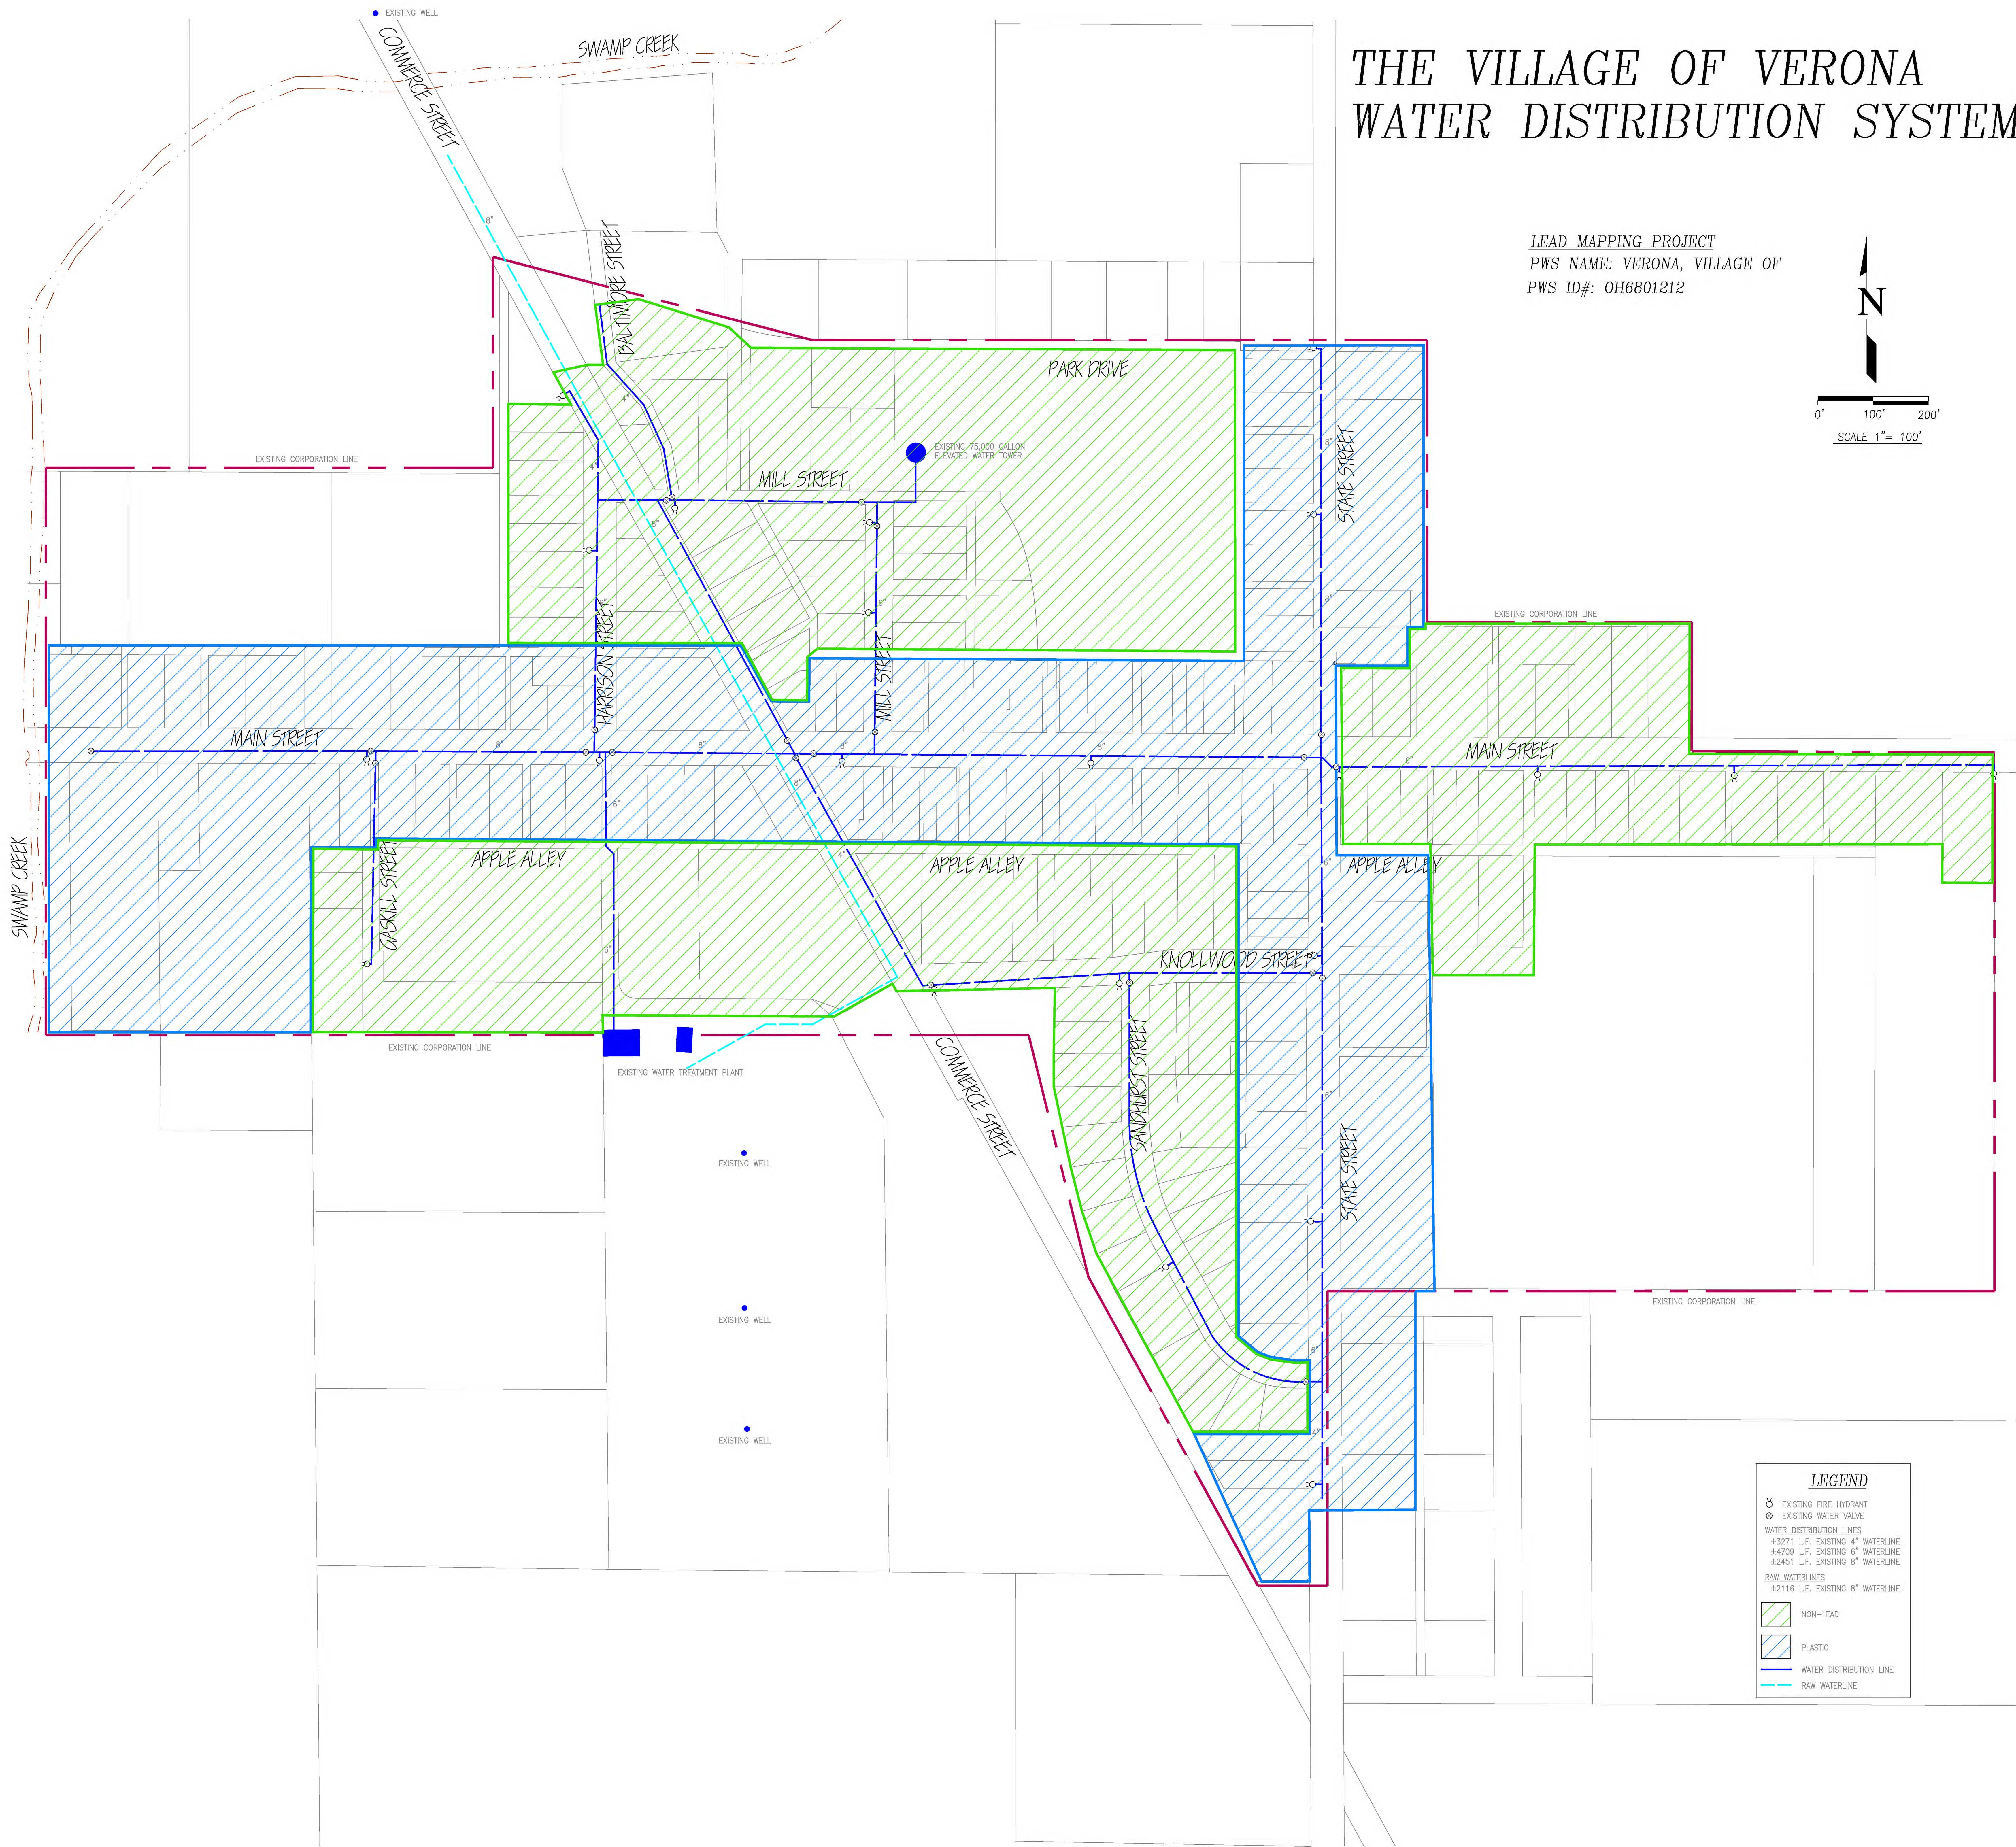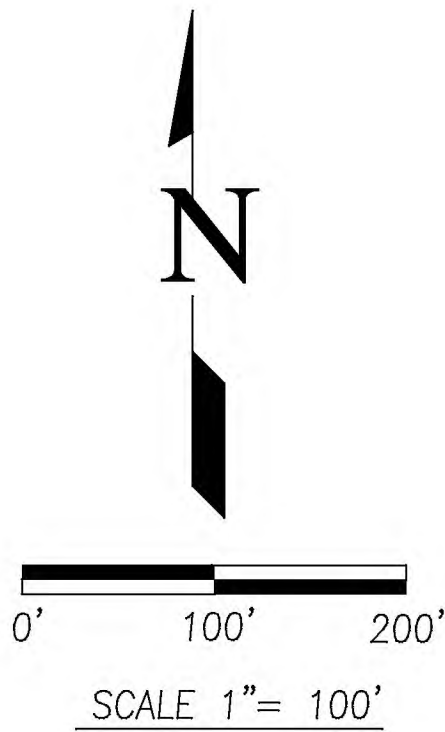

LEGEND

⊗ EXISTING FIRE HYDRANT
⊙ EXISTING WATER VALVE
— WATER DISTRIBUTION LINES
 #3271 L.F. EXISTING 4" WATERLINE
 #4709 L.F. EXISTING 6" WATERLINE
 #2451 L.F. EXISTING 8" WATERLINE
— RAW WATERLINES
 #2116 L.F. EXISTING 8" WATERLINE

NON-LEAD
PLASTIC
WATER DISTRIBUTION LINE
RAW WATERLINE

VILLAGE OF VERONA
138 Mill Street P.O. Box 676
Verona, OH 45378
(937)884-5522 Phone
(937)884-5521 Fax
"A Friendly Community"
www.verona@bizwoh.rr.com

February 16, 2017

Ohio EPA

Our water plant was not in operation until 1962. In 2000, the Village built our new state of the art water plant.

In 2011, the Village installed new 8" water line and taps on South State St. In 2014, the Village installed new water lines and taps on E. Main St. In 2016, we installed new water lines and taps on West Main St. & North State St.

To my knowledge, all Village properties were built prior to 1998 and are connected with galvanized or copper plumbing. To my knowledge, there are no lead water lines in the Village.

Please call me at 884-5522 with any questions.

Sincerely,

A handwritten signature in black ink, appearing to read "Mary Myers", with a stylized flourish at the end.

Mary Myers
Mayor