

*Crouse Mobile Home Park  
and Sales, Inc.*

4141 HAMILTON EATON ROAD  
HAMILTON, OHIO 45011  
(513) 726-4831

March 8, 2017


Well pickup piping is stainless steel and all water mains are PVC on this property.

Based on color codes and dates of manufacturer referenced to the map there are many homes listed as possible copper water lines. Most of these homes have PVC/PEX for their service lines.

Based on my knowledge and experience all homes in this park that contain and use copper water lines have flared connections throughout and contain no solder connections. It was the practice of manufactured housing to use this system of water lines. Any lot not color coded refers to an empty lot and will have a new home beyond 2014 installed.

Disclaimer:


Because it is practically impossible to determine the lead content of an installed fixture, fitting or pipe, it should be assumed that the manufacturer or installation date is the primary indicator of the lead content. Therefore, the characteristics of buildings and piping solder or fixtures would be buildings in Ohio built prior to 1998 or that use plumbing material or solder manufactured before 1998 may have materials with greater than 8% lead and are at a higher risk of contributing lead to the drinking water than materials manufactured after 1998. In addition, building built and plumbing materials manufactured after 2014 were required to have less than 0.25% lead by weight and have the lowest risk for contributing lead to the drinking water. It should be noted however that, although prohibited, some use of leaded solder or leaded components may have occurred after the prohibitions became effective.

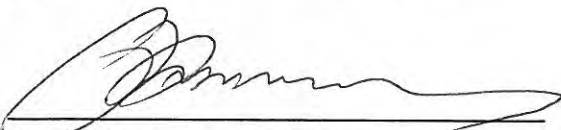

Brian Bremer, President



- WATER MAINS (ALL LINES ARE PVC)
  - HOMES < 1998 POSSIBLE COPPER LINES
  - HOMES > 1998 < 2014 ALL LINES ARE PVC/PEX
  - HOMES > 2014 ALL LINES ARE PVC/PEX
- NO COLOR MARK IS EMPTY LOT (WILL INSTALL NEW HOME)

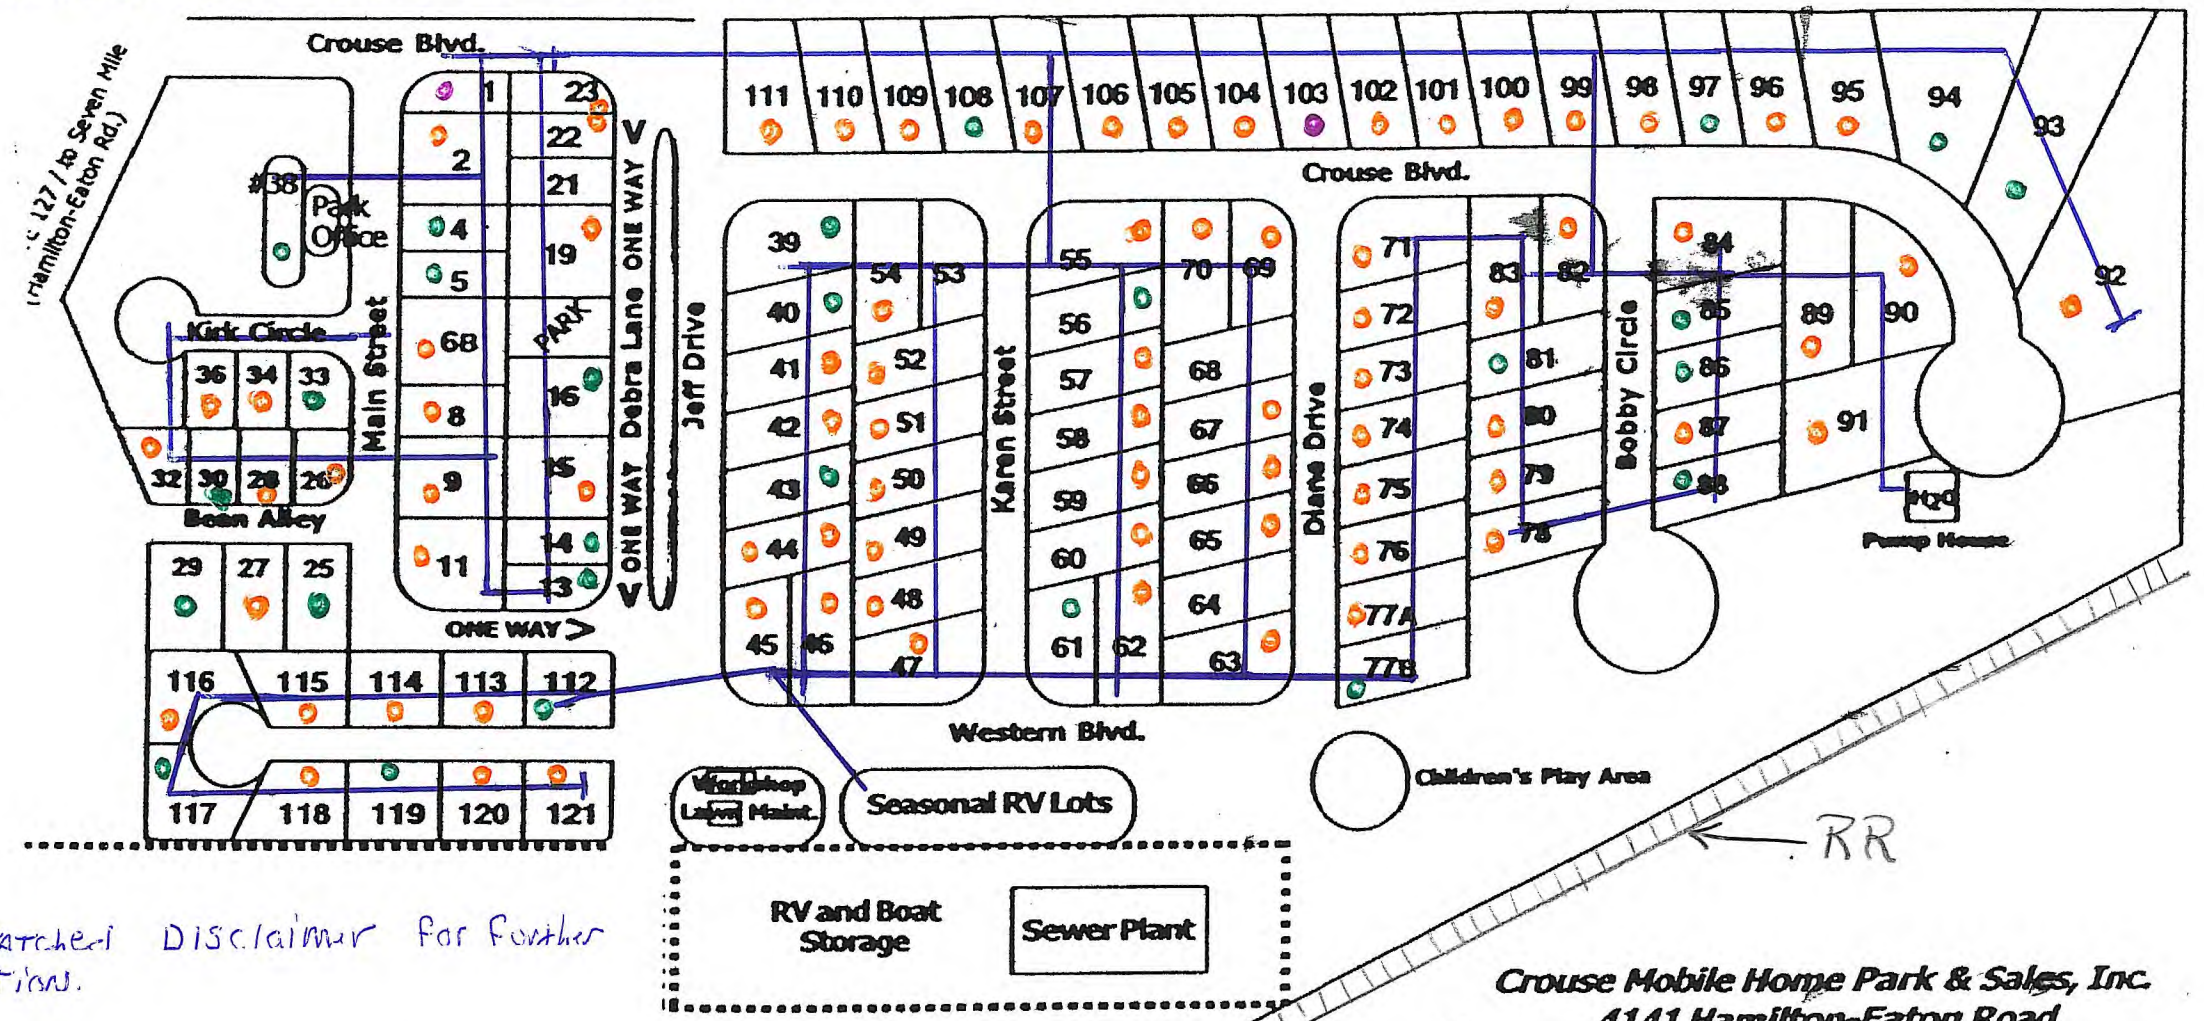

\* See Attached Disclaimer for Further Information.

\* There are no Known Lead Containing Service Lines in This Community

**Crouse Mobile Home Park & Sales, Inc.**  
 4141 Hamilton-Eaton Road  
 PWS 0902912 STU 952021  
 FACILITY ID DSI




**VERIFICATION FORM FOR COMMUNITY PUBLIC WATER SYSTEMS  
CLAIMING NO LEAD SERVICE LINES**

The owner or operator of all community public water systems must identify and map areas of their distribution system that are known or are likely to contain lead service lines. Systems must submit a copy of the applicable map to the Ohio Department of Health and the Ohio Department of Job and Family Services. Systems must also submit a report to the director containing at least both of the following: (1) The applicable map with narrative, and (2) A list of sampling locations used to collect samples as required by Ohio Revised Code (ORC) Section 6109.121 and any rules adopted thereunder, including contact information for the owner and occupant of each sampling site.

Should a water system determine no lead service lines exist in their distribution system, they must provide information stating they reviewed, at the minimum, historical permit records and local ordinances, distribution maintenance records and information pertaining to installation dates or materials for all services lines. This information must be verified below.

I HEREBY CERTIFY THAT THE FOLLOWING METHOD(S) WERE USED TO DETERMINE NO LEAD SERVICE LINES EXIST IN THIS WATER SYSTEM'S DISTRIBUTION SYSTEM, AS REQUIRED BY ORC 6109.121(F):

<b>LEAD SERVICE LINE VERIFICATION</b>
<p><b>This PWS states they have no lead service lines and has reviewed the following information (select one or more of the following):</b></p> <ul style="list-style-type: none"><li><input type="checkbox"/> Historical permit records and/or local ordinances</li><li><input checked="" type="checkbox"/> Distribution maintenance records (i.e. meter replacement, waterline break repairs)</li><li><input type="checkbox"/> Information pertaining to installation dates for all service lines (i.e. after 1986 when lead services lines were banned)</li><li><input type="checkbox"/> Service line material of all service lines is known (i.e. all service lines are known to be PVC)</li></ul>

  
\_\_\_\_\_  
Signature of Responsible Person                      Date 3-8-17

Brian Brimer                      President  
\_\_\_\_\_  
Printed Name and Title of Responsible Person

**PWS NAME:** Crouse MHP  
**PWS ID:** OH 0902912  
**COUNTY:** Butler

<p><b><u>For Ohio EPA use only:</u></b></p> <p>Date Verification Rec'd: _____</p>
---