

Lead + Copper Piping + Faucet Map for
 Copley Middle School - NORTH - 7795012
 Copley Middle School - South 7793012

EAST



Copley-Fairlawn Middle School

1531 South Cleveland-Massillon Road, Copley, Ohio 44321 • 330-664-4875 • FAX 330-664-4912


FEB: 28, 2017

RECEIVED

MAR 07 2017

OHIO EPA NEDO

"Home of the Indians"

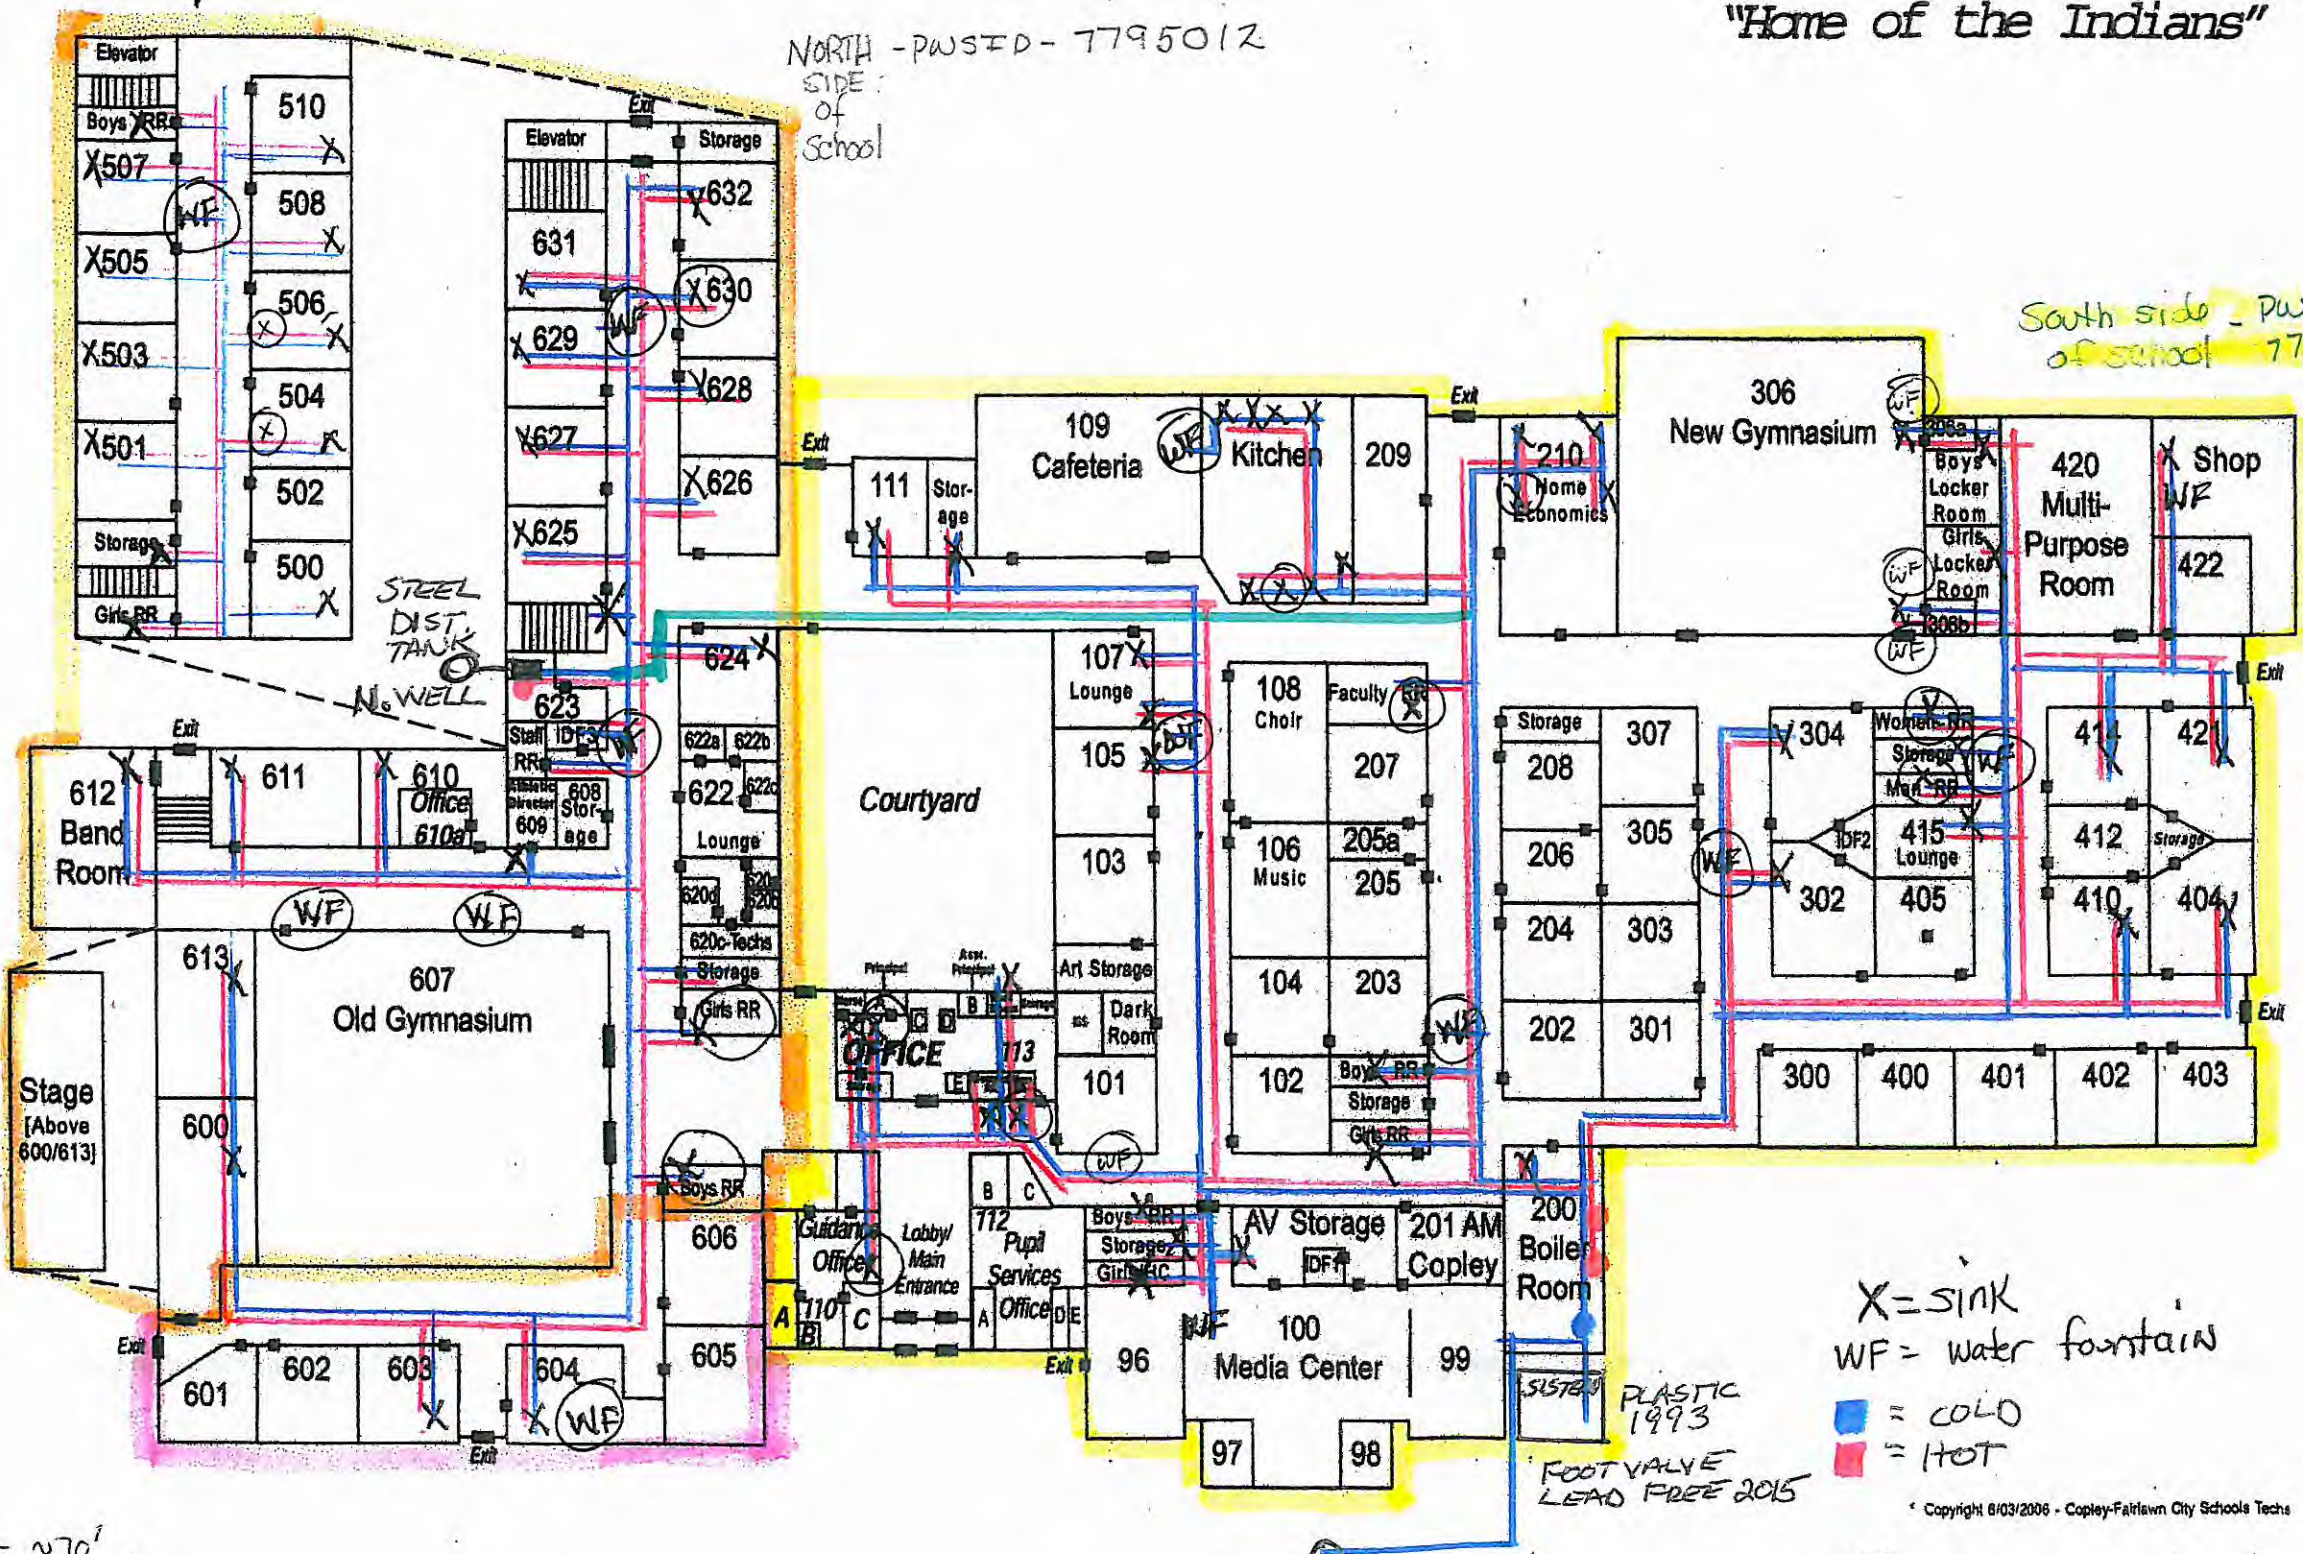

- = CONSTRUCTION 1929
- = CONSTRUCTION 1950S
- = CONSTRUCTION 1993
LOW LEAD COPPER PIPE
- = EMERGENCY MAIN
DISTRIBUTION LINE
TO CONNECT SOUTH
AND NORTH SIDES
COLD WATER
SCHD. 80 PVC

* ALL FIXTURES HAVE
 BEEN INSTALLED DURING
 THE POST 1986 TIME
 FRAME

- = POST 1986 COPPER
DIST. LINES
- = PRE 1986 GALV.
STEEL DISTRIBUTION LINES

- = PRE 1986 COPPER/
GALVANIZED STEEL
DIST. LINES

Doc. # 584849

Entity: Copley-Fairlawn MidSchool
 Doc Type: REPORT
 Doc Subtype: DDAW
 Program: DDAW
 County: SUMMIT
 Secondary ID: 247775012

- X = SINK
- WF = water fountain
- = COLD
- = HOT

- (WF) = Pb+Cu sampling site
- (X) = Pb+Cu sampling site

NORTH - PWSID - 7795012
 SIDE of School

South side - PWSID
 of school 7793012

STEEL
 DIST.
 TANK
 No WELL

PLASTIC
 1993
 FOOT VALVE
 LEAD FREE 2015

1" = ~70'

Route 21

WEST

Route 21

Copyright 8/03/2006 - Copley-Fairlawn City Schools Techs