


1" copper pipe from well

Kids Academy of Copley  
OH 44122

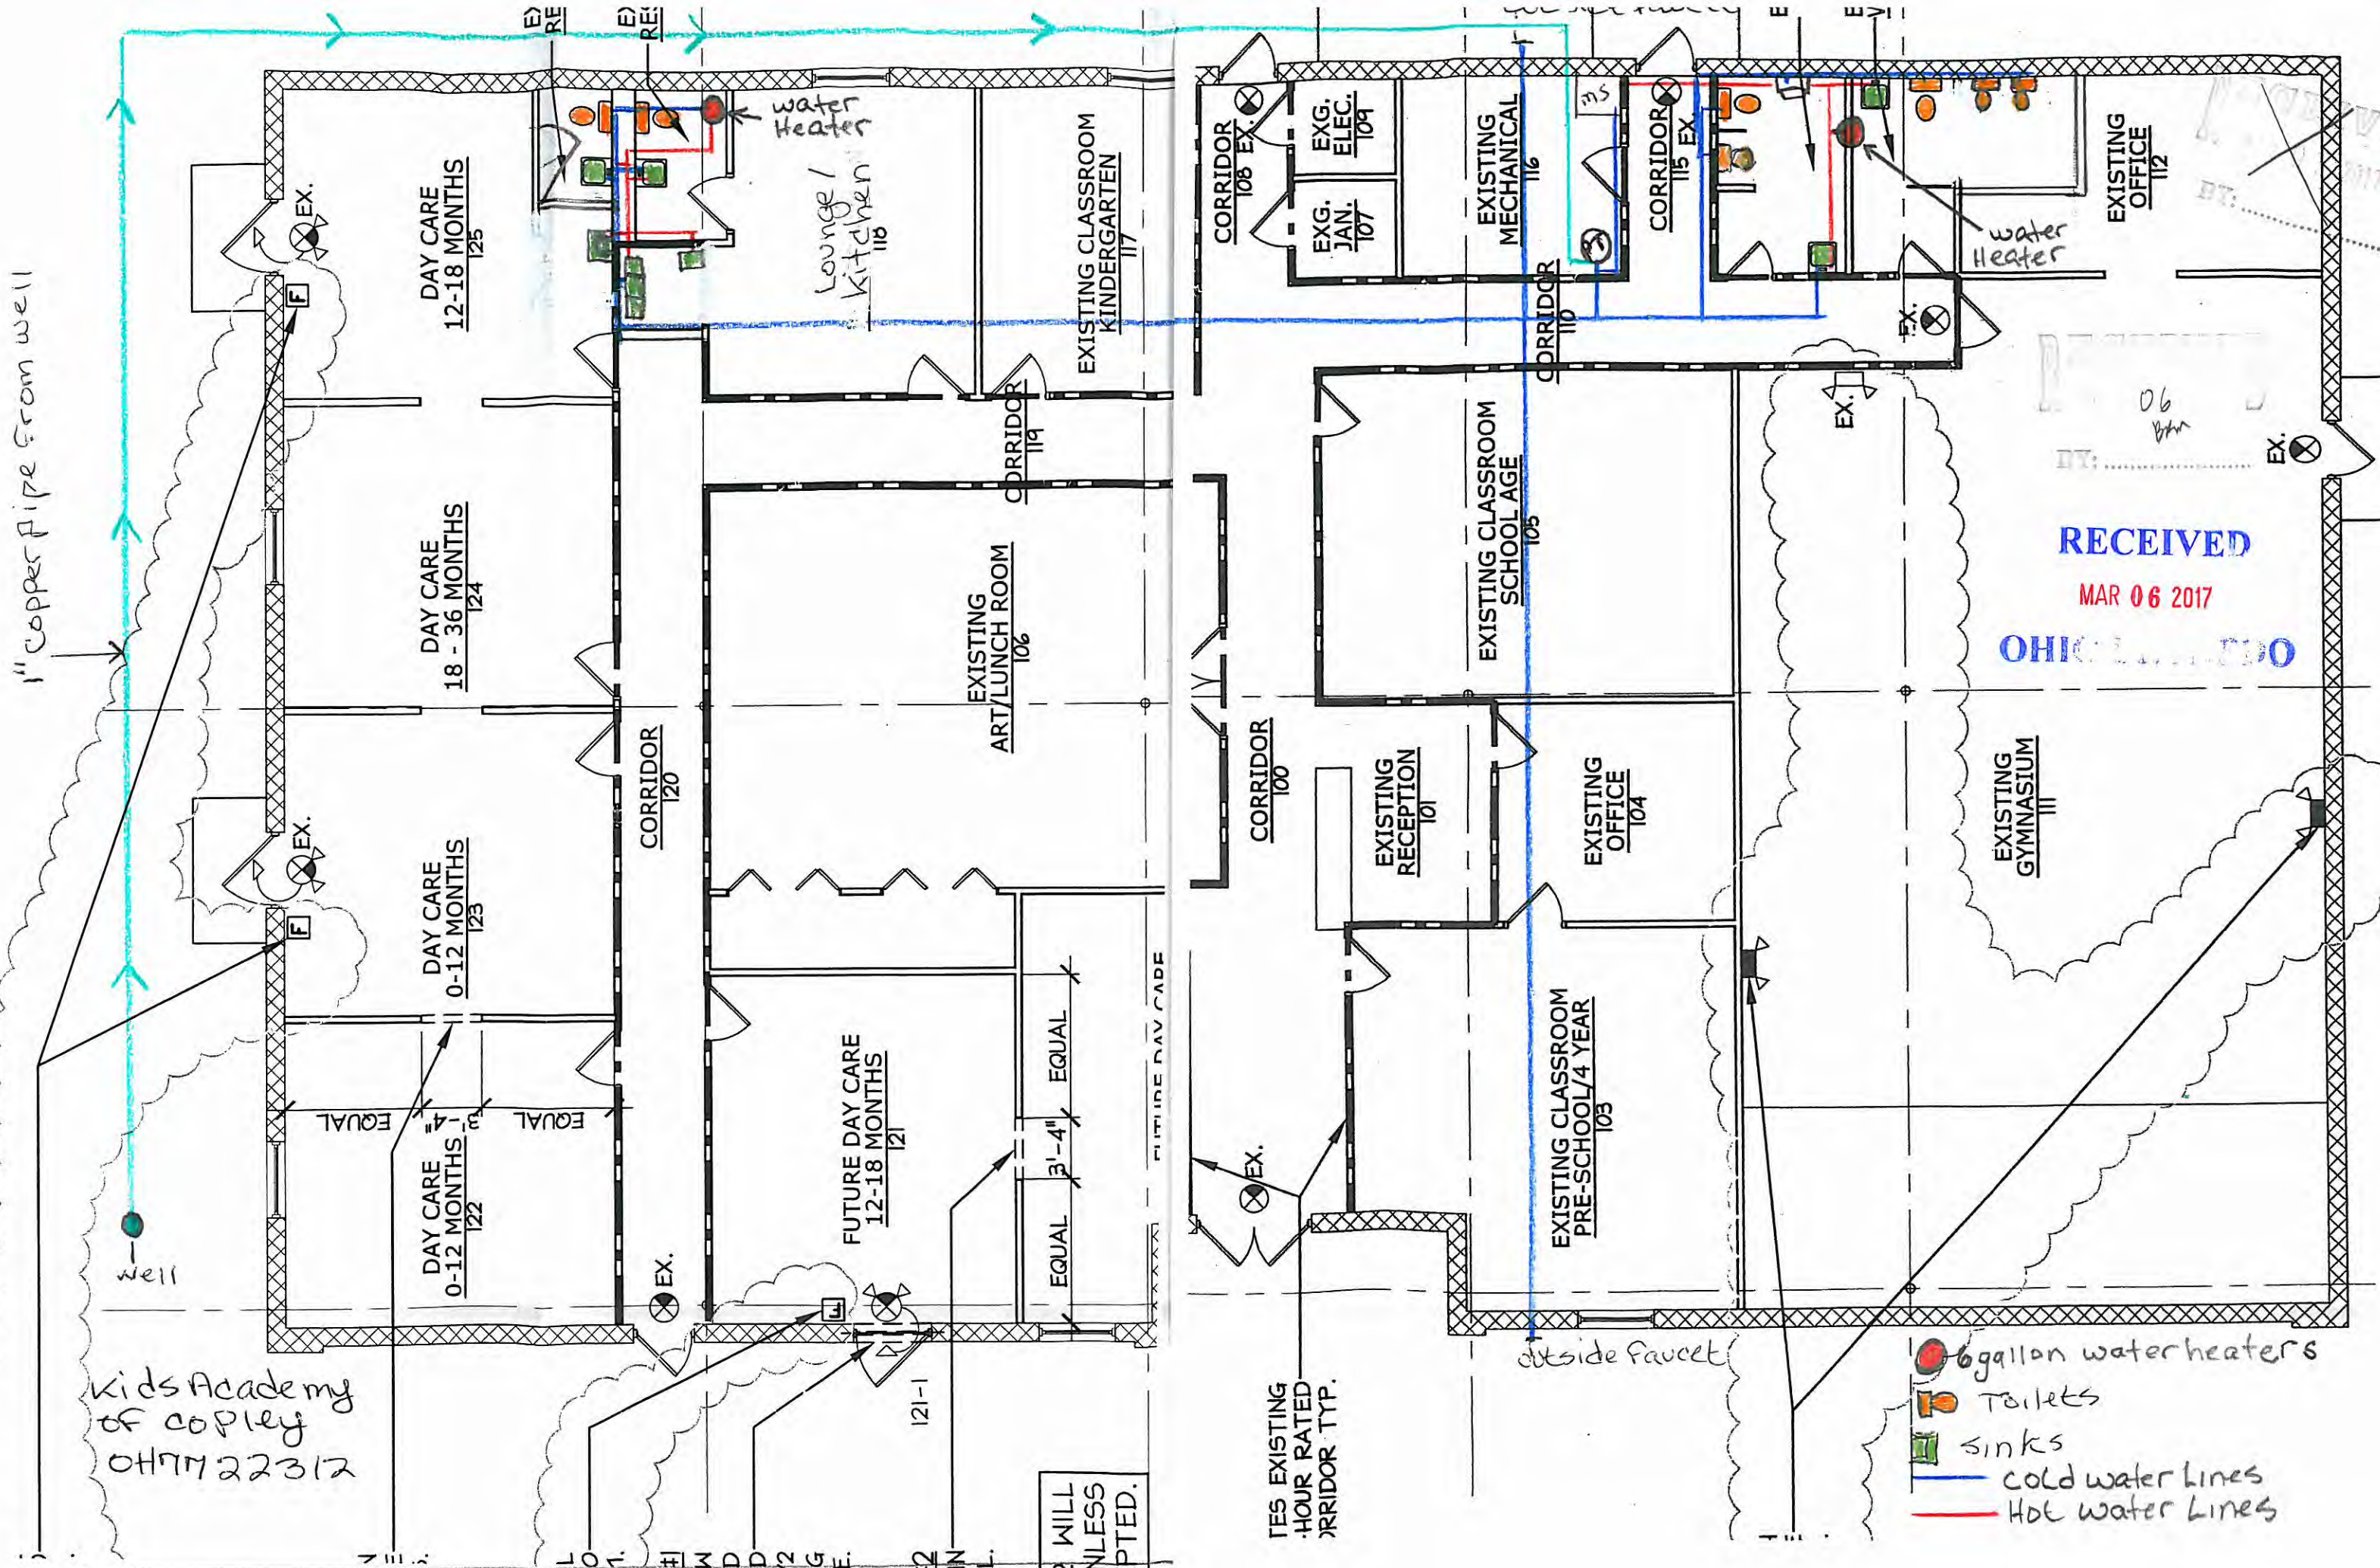

DAY CARE 12-18 MONTHS 125

DAY CARE 18 - 36 MONTHS 124

DAY CARE 0-12 MONTHS 123

DAY CARE 0-12 MONTHS 122

FUTURE DAY CARE 12-18 MONTHS 121

EXISTING ART/LUNCH ROOM 106

EXISTING CLASSROOM KINDERGARTEN 117

EXISTING CLASSROOM SCHOOLAGE 105

EXISTING CLASSROOM PRE-SCHOOL/4 YEAR 103

EXISTING RECEPTION 101

EXISTING OFFICE 104

EXISTING OFFICE 112

EXISTING GYMNASIUM 111

Lounge / Kitchen 118  
Water Heater

Water Heater

RECEIVED  
MAR 06 2017  
OHIO DEPT. OF PUBLIC SAFETY

- 6-gallon water heaters
- Toilets
- Sinks
- Cold water lines
- Hot water lines

RESISTANT EXISTING  
CORRIDOR TYP.

WILL BE  
LESS  
NOTED.

outside faucet

FUTURE DAY CARE

EQUAL

EQUAL

EQUAL

3'-4"

EQUAL

121-1

EX.

EX.

EX.

EX.

CORRIDOR 108 EX.

EXG. JAN. 107

EXG. ELEC. 109

EXISTING MECHANICAL 116

CORRIDOR 115 EX.

CORRIDOR 110

EX.

EX.

EX.

06  
Bhr

BT: .....