

MAR 09 2017

OHIO EPA NEDO

ALL AROUND CHILDRENS DAYCARE PWS OH2836512 drinking water distribution mains consist of COPPER WITH LEAD SOLDER OLDER 2014. The service lines, hardware and meters are a combination of Brass, including corporation stops. No lead service lines are known at the time of this writing. To avoid any questions, we are sampling from only the oldest homes, to assure that lead and copper analytical results are a true representation of the worst case scenario, to provide assurance and integrity, that the health and welfare of our most precious commodities, our consumers is not compromised.

Because it is practically impossible to determine lead content of an installed fixture, fitting or pipe, it should be assumed that the DATE THE BUILDING WAS BUILT is the primary indicator of the lead content. Therefore, the characteristics would be buildings and piping solder or fixtures built prior to 1998 or that use plumbing material or solder manufactured before 1998 may have materials with greater than 8% lead and are at a higher risk of contributing lead to the drinking water than materials manufactured after 1998. In addition, buildings built and plumbing materials manufactured after 2014 were required to have less than 0.25% lead by weight and have the lowest risk for contributing lead to the drinking water. It should be noted however that, although prohibited, some use of leaded solder or leaded components may have occurred after the prohibitions became effective.

Eugene F. Davis

Chief Operator

Efdavis2 & Associates LLC

Entity: All Around Daycare
Doc Type: REPORT
Doc Subtype: REPORT
Program: DDAW
County: Crawford
Secondary ID: OH 2836512




Google Earth




PWS 2836512

ALL AROUND CHILDRENS DAYCARE
18225- SO. MADISON ROAD

ALL LINES

 COPPER W LEAD SOLDER
< 1983

 WATER METER

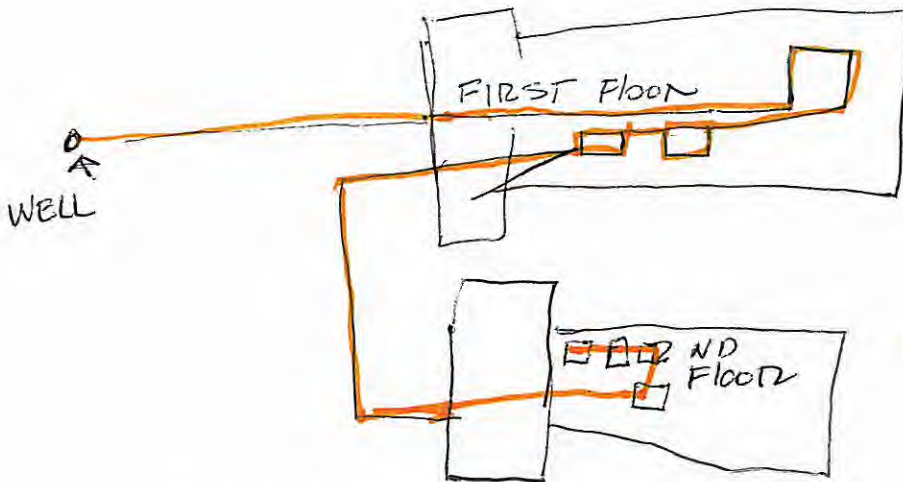

~~SMP 001, 002, 003, 004~~
~~005~~

RECEIVED

FEB 28 2017

OHIO EPA NEDO

Entity: All Around Children Daycare
 Doc Type: Report
 Doc Subtype: _____
 Program: DDAHL
 County: Crawford
 Secondary ID: OH 2836512
list in color