

RECEIVED

MAR 09 2017

OHIO EPA NEDO

UNIVERSAL POLYMER PWS 2837012 drinking water distribution mains consist of COPPER WITH LEAD SOLDER OLDER 2014. The service lines, hardware and meters are a combination of Brass, including corporation stops. No lead service lines are known at the time of this writing.

Because it is practically impossible to determine lead content of an installed fixture, fitting or pipe, it should be assumed that the DATE THE BUILDING WAS BUILT is the primary indicator of the lead content. Therefore, the characteristics would be buildings and piping solder or fixtures built prior to 1998 or that use plumbing material or solder manufactured before 1998 may have materials with greater than 8% lead and are at a higher risk of contributing lead to the drinking water than materials manufactured after 1998. In addition, buildings built and plumbing materials manufactured after 2014 were required to have less than 0.25% lead by weight and have the lowest risk for contributing lead to the drinking water. It should be noted however that, although prohibited, some use of leaded solder or leaded components may have occurred after the prohibitions became effective.

Eugene F. Davis

Chief Operator

Efdavis2 & Associates LLC

Entity: Universal Polymer
Doc Type: REPORT
Doc Subtype:
Program: DPAGW
County: Cuyahoga
Secondary ID: OH 2837012




Google Earth

feet 400
meters 100



UNIVERSAL Polymer & RUBBER
PWS OH 2837012
FAC. ID 2854350

ALL LINES
CU PB SOLDER
L 83

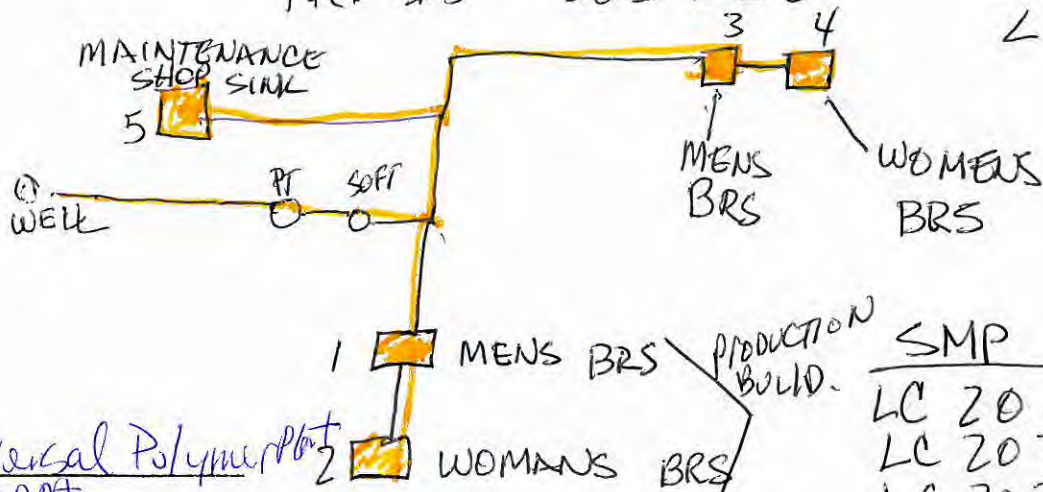

SMP	
LC	201
LC	202
LC	203
LC	204
LC	205

Entity: Universal Polymer
Doc Type: Report
Doc Subtype:
Program: DDAGW
County: Cuyahoga
Secondary ID: OH 2837012

RECEIVED

FEB 28 2017

OHIO EPA NEDO

EPAC in color