


RE: Westbrook Country Club
Report
Drinking Water Program
Richland County
PWS ID: OH7036112

WestBrook Country Club

1st Floor

Westbrook Country Club
1098 Springmill Road
Mansfield, Oh. 44906

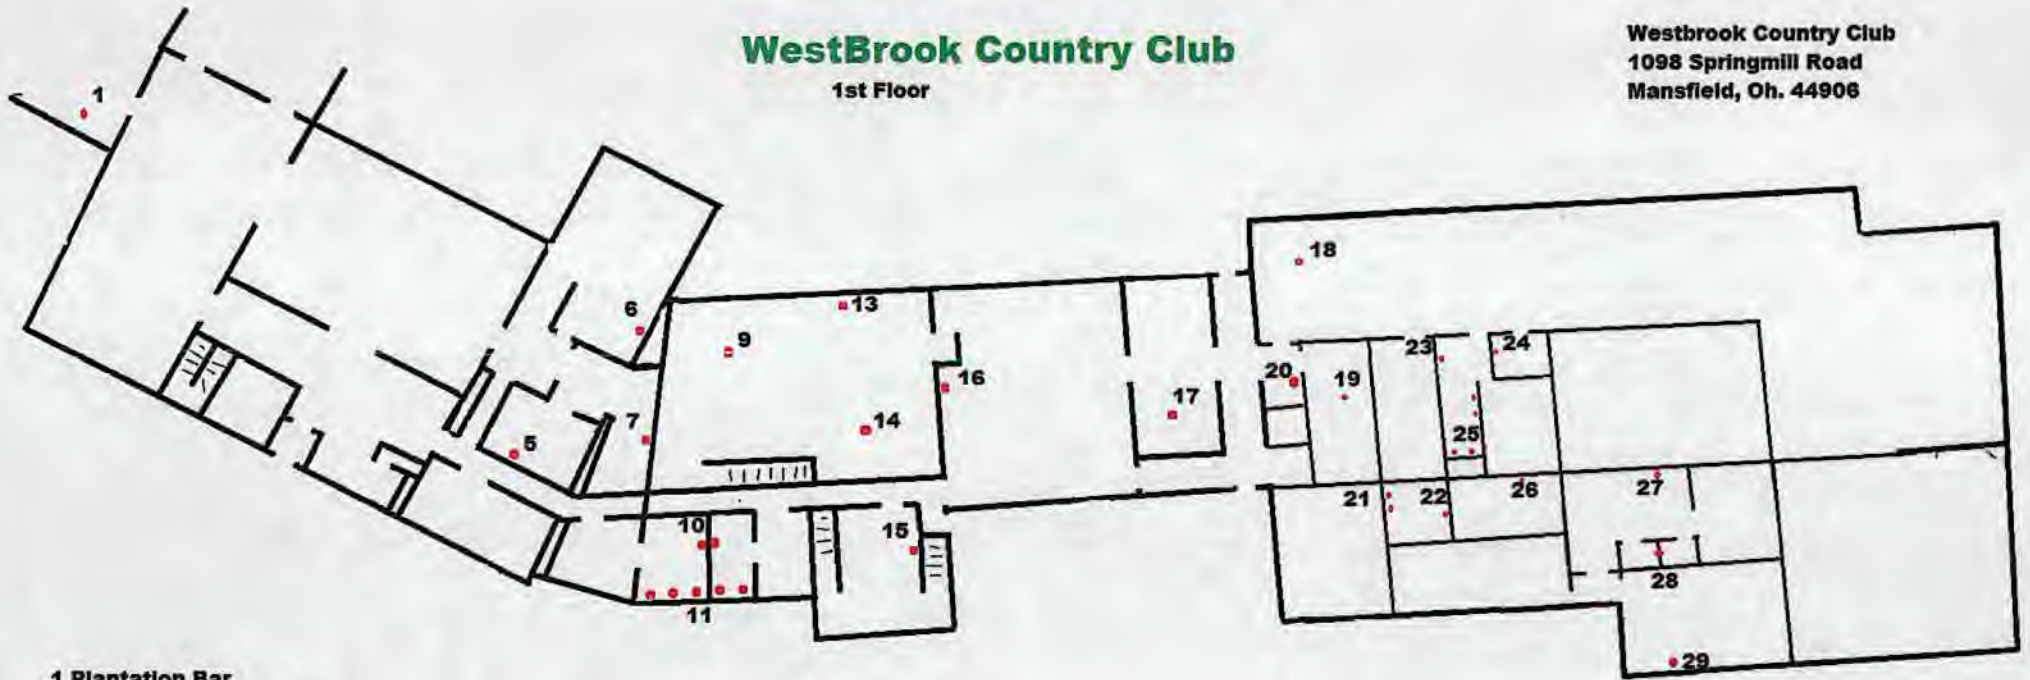

- 1 Plantation Bar
- 5 1st Floor Server coffee
- 6 1st Floor Lounge Bar
- 7 1st Floor Server Sink
- 9 1st Floor Dish washer
- 10 Mens & Womans Restroom sinks
- 11 Mens & womans Restroom Toilets & Urinals
- 13 1st Floor Kitchen Sink (cold side)
- 14 1st Floor Kitchen Sink (hot side)
- 15 1st Floor Ice Machine
- 16 1st Floor Grill Room Sink
- 17 1st Floor Grill Bar Sink
- 18 1st Floor Ross Room Bar
- 19 1st Floor Boys Locker Room sink
- 20 1st Floor Rossroom Coffee
- 21 1st Floor Ladies Locker Room Toilets
- 22 1st Floor Ladies Locker Room Sink
- 23 1st Floor Mens Lockerroom Sink
- 24 1st Floor Shoe shione Sink
- 25 1st Floor Mens lockerroom Toilets & urinals
- 26 1st Floor Mens & Ladies Locckerroom Showers
- 27 1st Floor Ladies Lockerroom Sinks
- 28 1st Floor Ladies Lockerroom Toilets
- 29 1st Floor Girls Lockerroom Sinks
- 30 Pool House toilets & Sinks PECS pipe installed 2014

Red = Copper pipe lead solder

All copper pipe is original construction 1942

Blue = Plastic Pipe

Green = Galvanized Pipe

All Galvanized pipe is original construction 1942



RECEIVED

MAR 15 2017

DDAGW - NWDO

WestBrook Country Club

2nd Floor

Westbrook Country Club
1098 Springmill Road
Mansfield, Oh. 44906



- 2 2nd Floor Office 1
- 3 2nd Floor Office 2 & 3
- 4 2nd Floor Office 4 & 5
- 6a 2nd floor room 6

Red = Copper pipe lead solder

All copper pipe is original construction 1942

Blue = Plastic Pipe

Green = Galvanized Pipe

All Galvanized pipe is original construction 1942