

RE: McDonalds Restaurant - Hanley  
Report  
Lead Mapping  
Drinking Water Program  
Richland County  
PWS ID: OH7046312

Craig Roberts

Operator Cert. # WS1-1013698-89

RECEIVED

MAR 20 2017

OHIO E.P.A.  
N.W.D.O.

Here is the map for McDonalds Bellville and Hanley Road. Some of the hot water has soldered joints but was in long before the decision was made to reduce lead solder. We have had no lead show up in the water for either McDonalds. We take five samples from all the sinks in the resauarnt and have no lead show up.

“ building in Ohio built prior to 1998 or that use plumbing material or solder manufactured before 1998 may have materials with greater than 8% lead and are at a higher risk of contributing lead to the drinking water than materials manufactured after 1998. In addition, buildings built and plumbing materials manufactured after 2014 were required to have less than 0.25% lead by weight and have the lowest risk for contributing lead to the drinking water. It should be noted however that, although prohibited, some use of leaded solder or leaded components may have occurred after the prohibitions became effective.”


Craig Roberts

PWSID 7046312  
 25 HANLEY Rd MAPSFIELD OH  
 LINES: PLAS, CU  
 HOT WATER HAS LEADED  
 SOLDER  
 SOLDERED JOINT CONTAIN  
 LEAD  
 FIXTURES MIGHT CONTAIN  
 LEAD

# HANLEY Rd Mc DONALD'S

HANLEY Plumbing  
 1980

- KITCHEN SINK
- LADIES Rest Room
- MENS Rest Room
- SALAD SINK
- CREW SINK

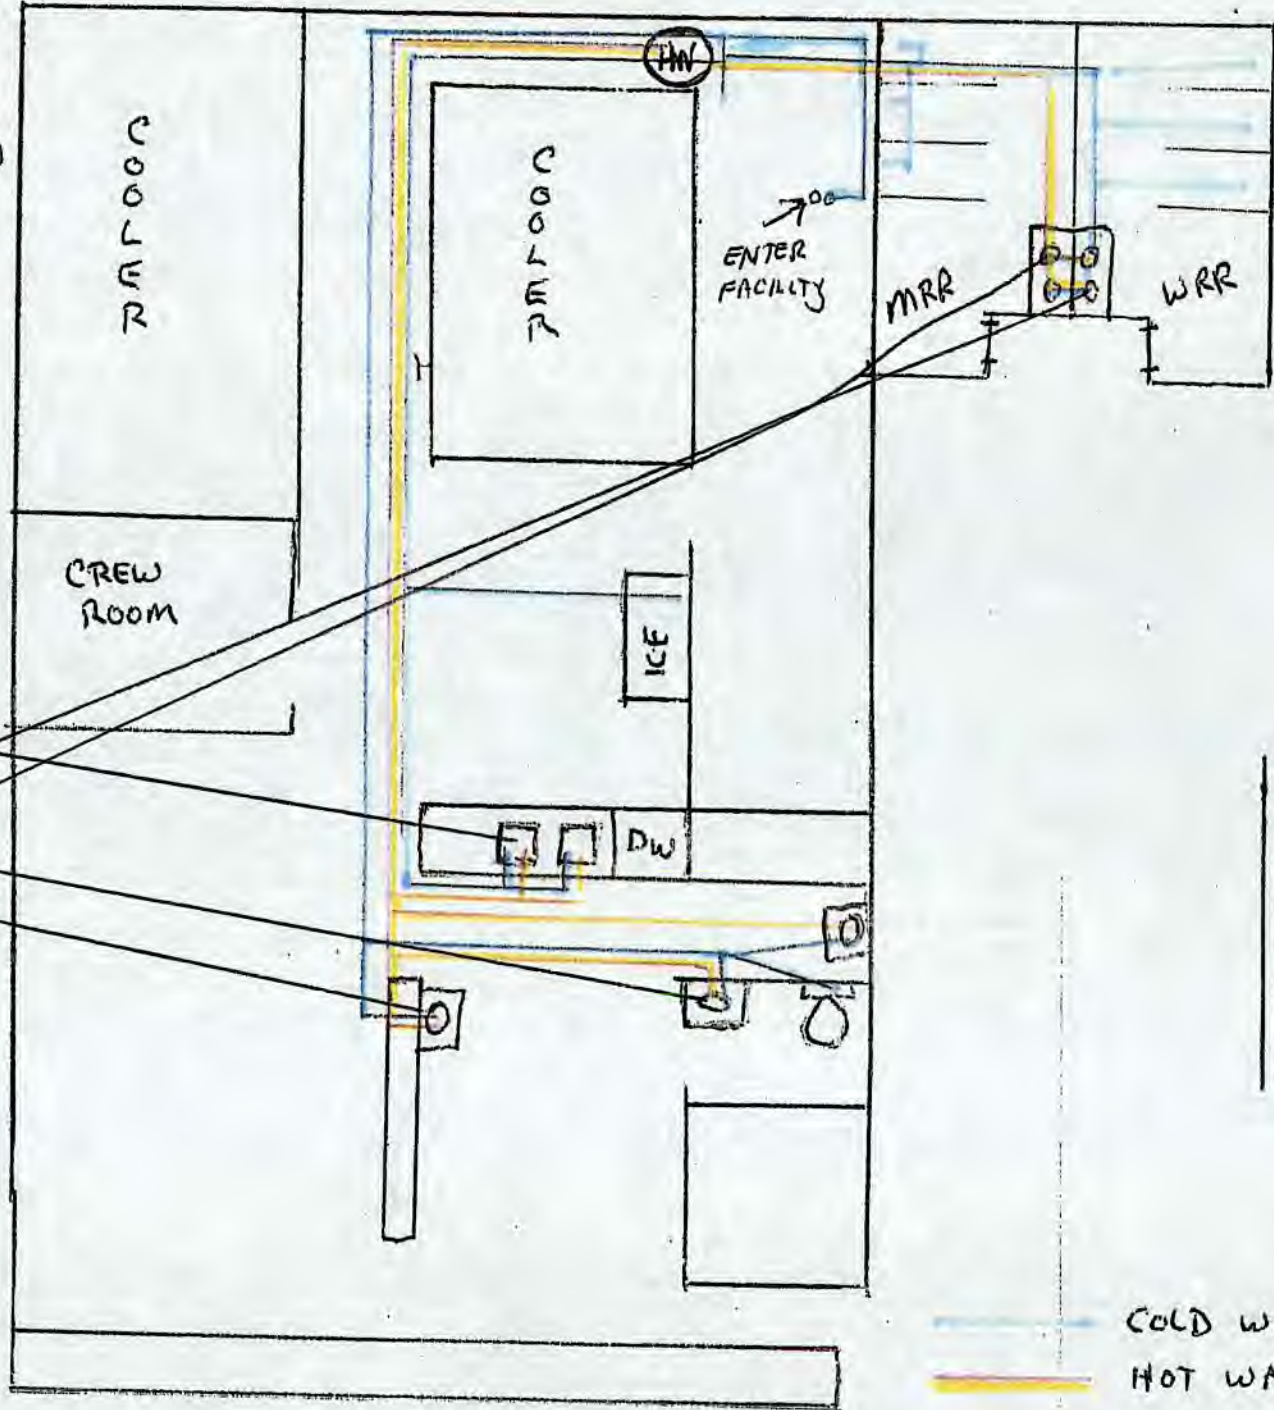

— COLD WATER  
 — HOT WATER