Lead Mapping – Pine Kirk Care Center
PWS 4504612

AREA LOCATION MAP

3/9/17

President
3/9/17

A = Pine Kirk Care Center
205 E Main St
Kirkersville OH 43033

740-927-3209

Bldg. built prior to 1998 - see att. Original building constructed in 1910, + Additions in 1966 + 1975, Presumed to be LEAD FREE ALL - service entrance points, hot + cold, service lines + solder, fixtures

PINE KIRK CARE CENTER EVACUATION PLAN
GROUND FLOOR

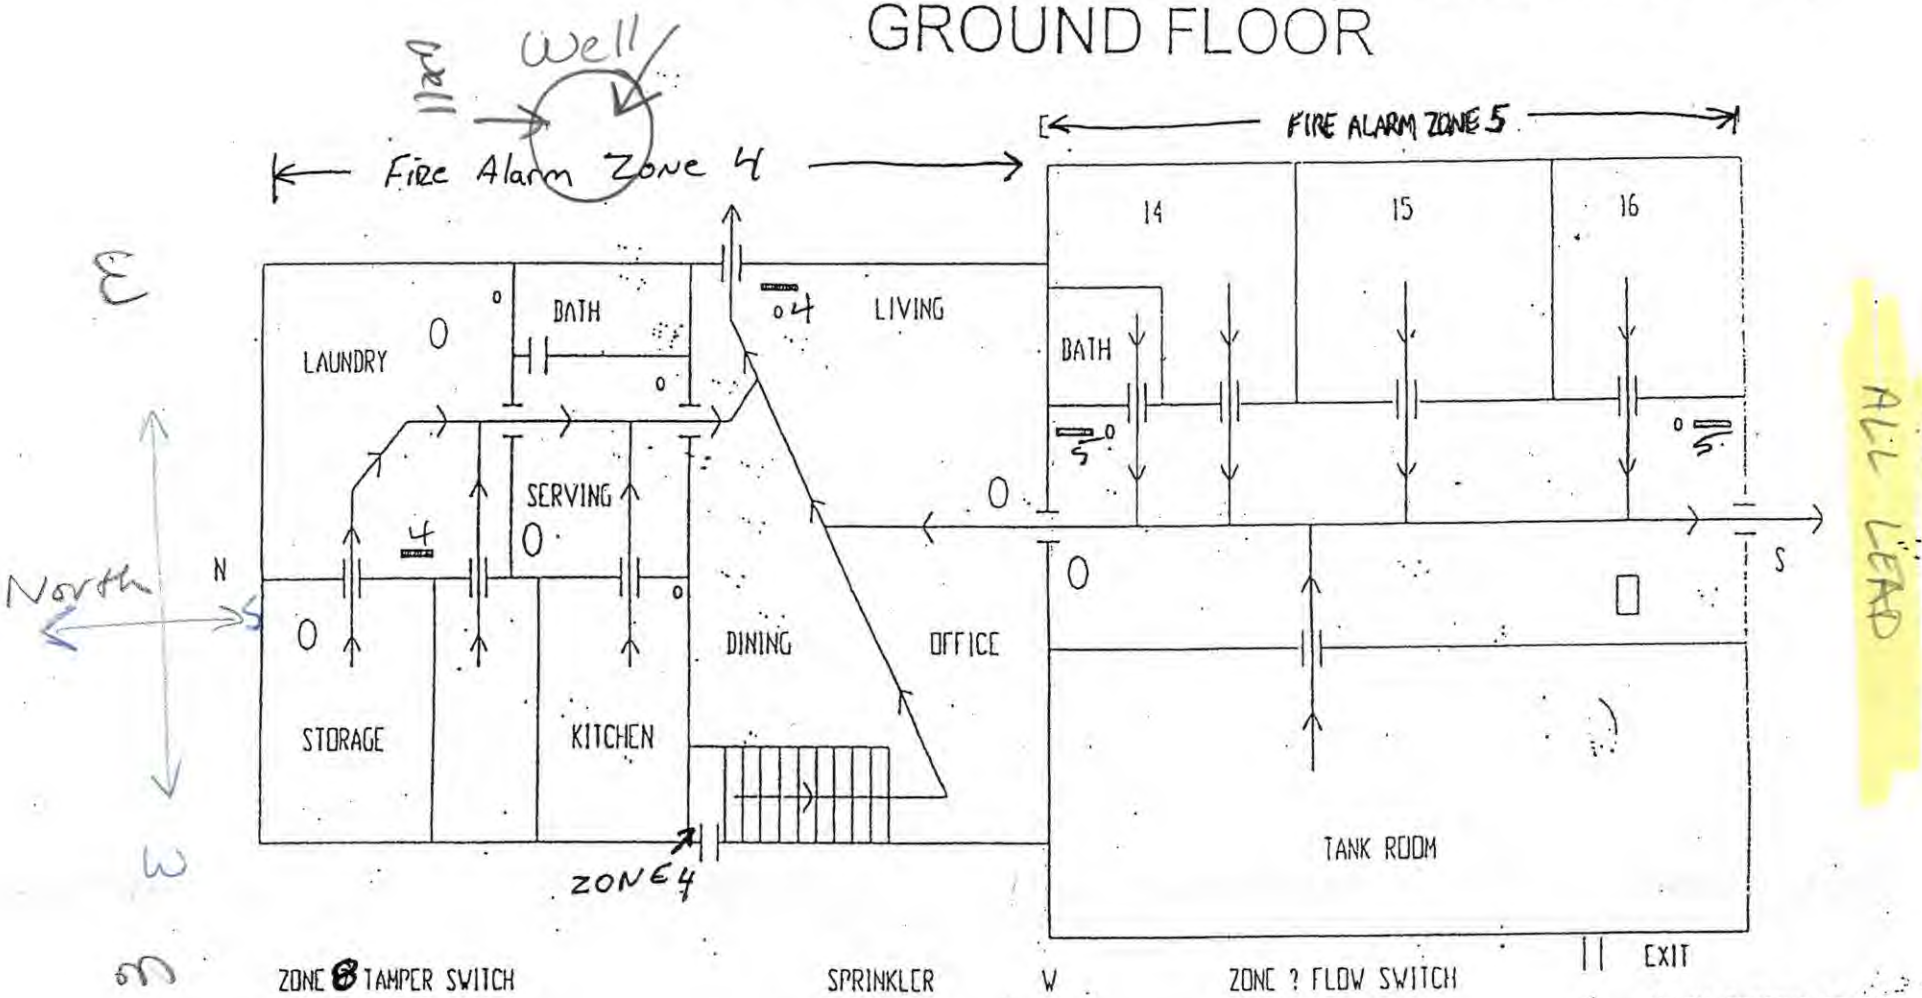

PRESUMED to be ALL LEAD

ZONE 7 - Kitchen Hood Suppression

PINE KIRK CARE CENTER EVACUATION PLAN
FIRST FLOOR

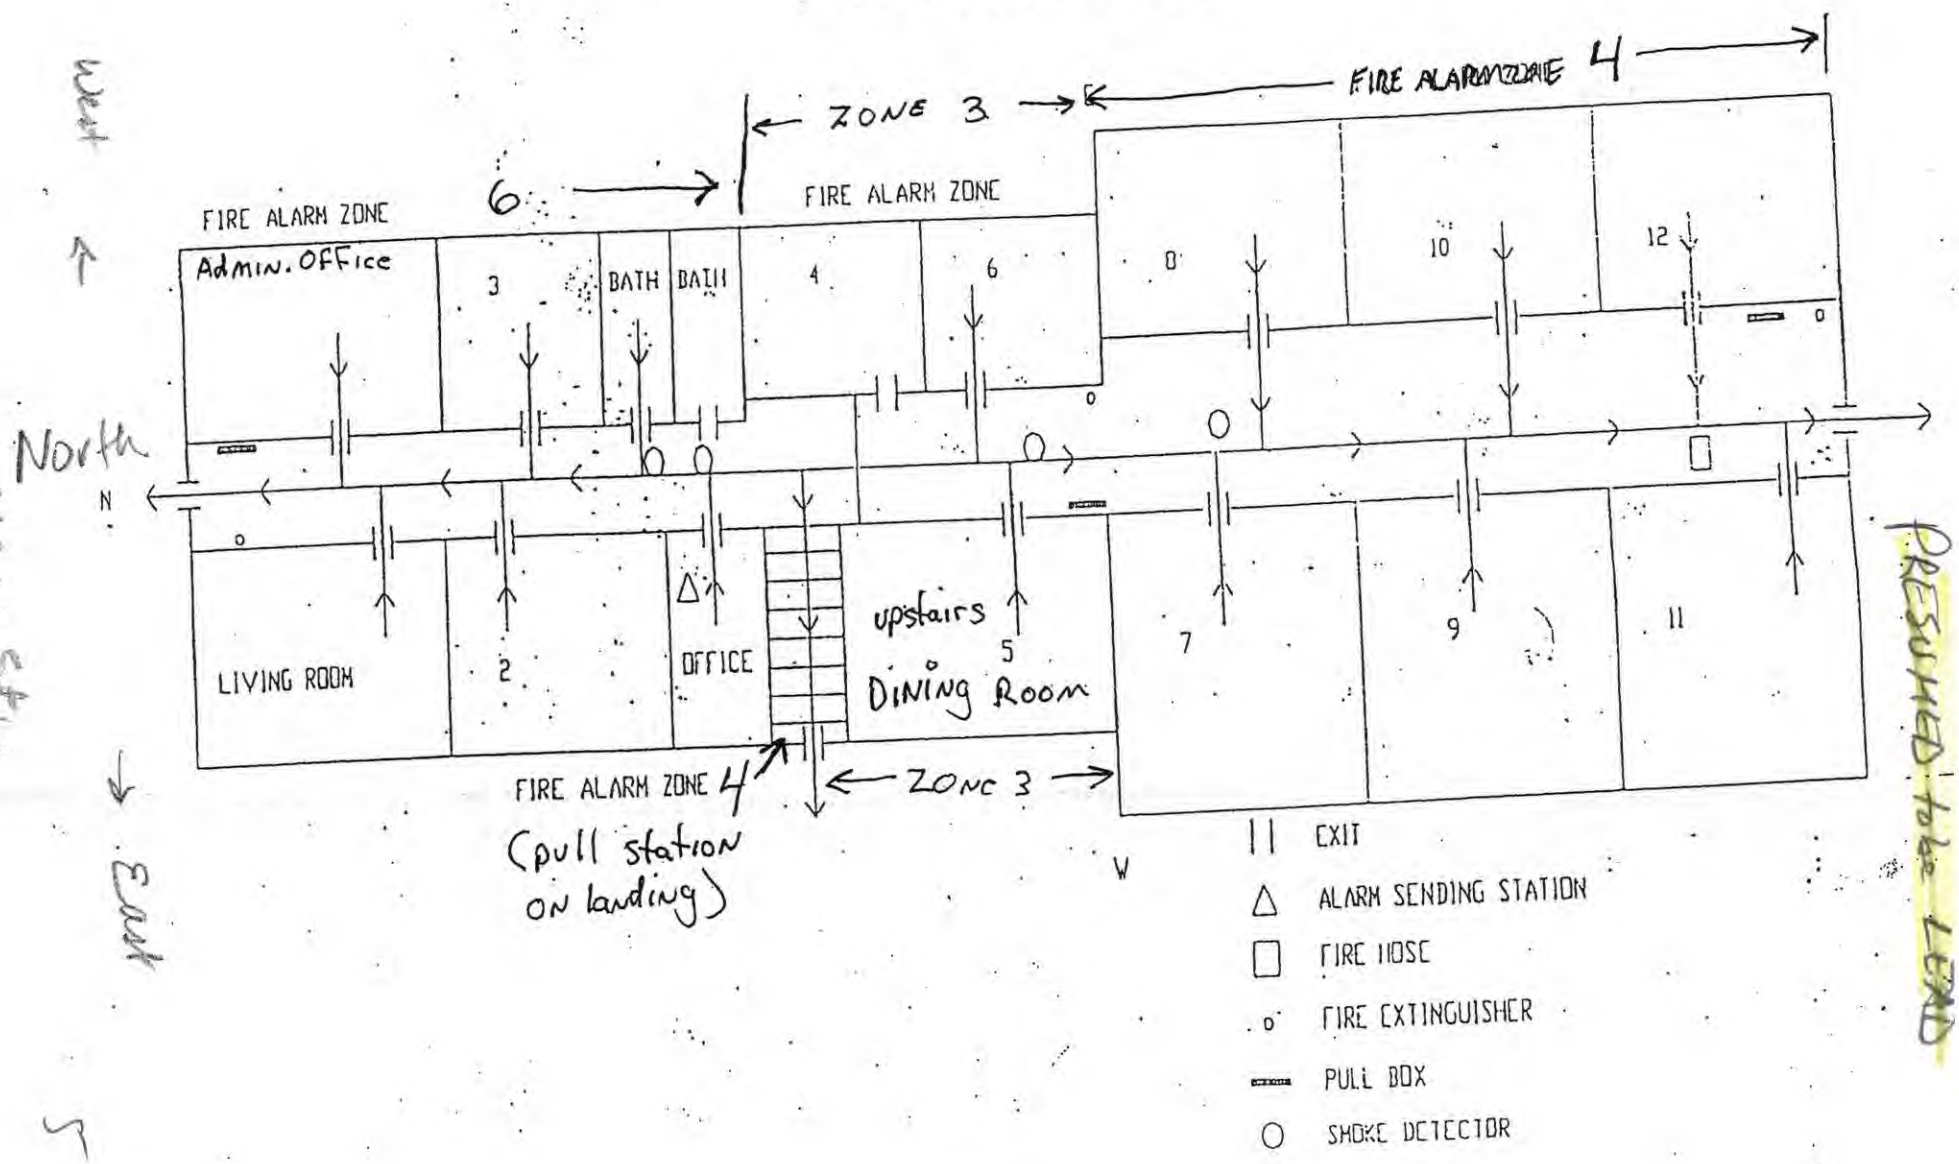

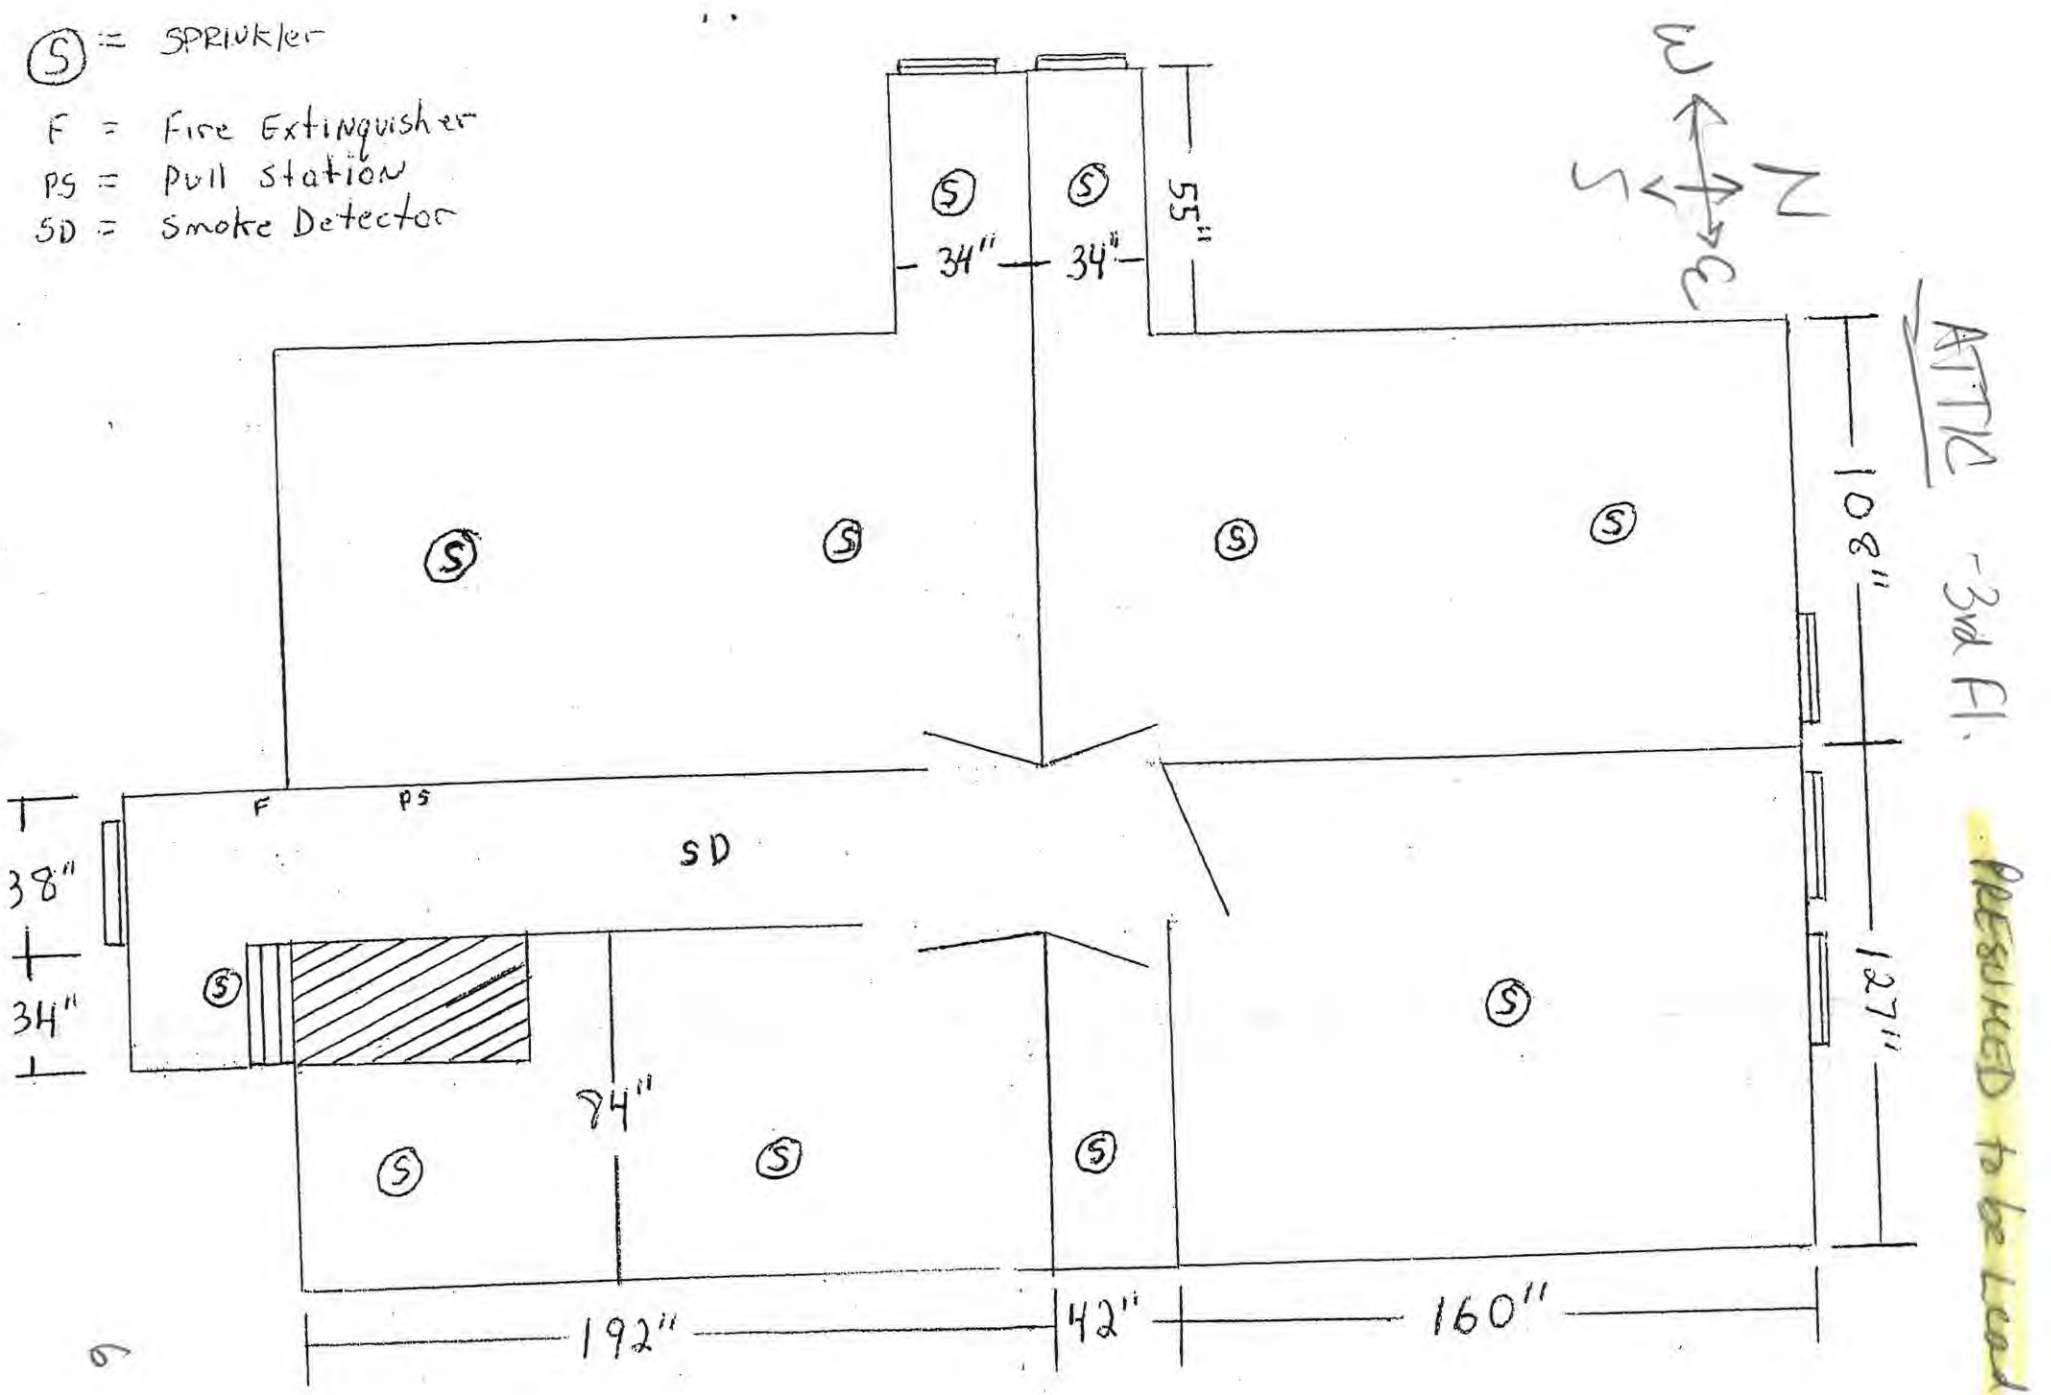
S = SPRINKLER
F = Fire Extinguisher
PS = Pull Station
SD = Smoke Detector
W
S
N
E
34"
34"
55"
108"
127"
F
PS
SD
38"
34"
84"
192"
42"
160"
ATTIC - 3rd Fl.
PRESUMED to be Load

PRESUMED to be LEAD