


Miss Pats Day Care III

8521 Herrick Drive, Chesterland Ohio 44026

440-729-8255/440-729-6540

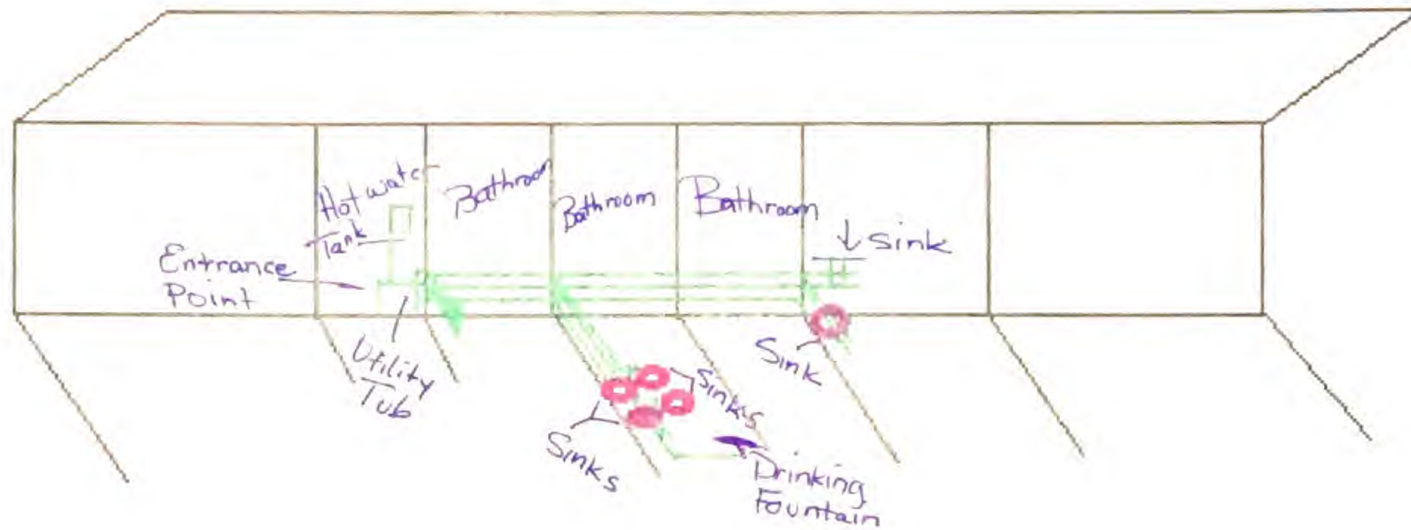

○ Sampling Locations

* Complete renovation done 1998.
All new piping installed at time
of renovation

PWS ID: OH2572212