

RE: Waterfall Estates
Report
Lead Mapping
Drinking Water Program
Richland County
PWS ID: OH7002112

RECEIVED

MAR 30 2017

DDAGW - NWDO

VERIFICATION FORM FOR COMMUNITY PUBLIC WATER SYSTEMS CLAIMING NO LEAD SERVICE LINES

The owner or operator of all community public water systems must identify and map areas of their distribution system that are known or are likely to contain lead service lines. Systems must submit a copy of the applicable map to the Ohio Department of Health and the Ohio Department of Job and Family Services. Systems must also submit a report to the director containing at least both of the following: (1) The applicable map with narrative, and (2) A list of sampling locations used to collect samples as required by Ohio Revised Code (ORC) Section 6109.121 and any rules adopted thereunder, including contact information for the owner and occupant of each sampling site.

Should a water system determine no lead service lines exist in their distribution system, they must provide information stating they reviewed, at the minimum, historical permit records and local ordinances, distribution maintenance records, and information pertaining to installation dates or materials for all service lines. This information must be verified below.

I HEREBY CERTIFY THAT THE FOLLOWING METHOD(S) WERE USED TO DETERMINE NO LEAD SERVICE LINES EXIST IN THIS WATER SYSTEM'S DISTRIBUTION SYSTEM, AS REQUIRED BY ORC 6109.121(F):

LEAD SERVICE LINE VERIFICATION	
This PWS states they have no lead service lines and has reviewed the following information (select one or more of the following):	
<input type="checkbox"/>	Historical permit records and/or local ordinances
<input type="checkbox"/>	Distribution maintenance records (i.e. meter replacement, water line break repairs)
<input type="checkbox"/>	Information pertaining to installation dates for all service lines (i.e. after 1986 when lead service lines were banned)
<input checked="" type="checkbox"/>	Service line material of all service lines is known (i.e. all service lines are known to be PVC)

[Signature] 3/23/2017
 Signature of Responsible Person Date


Dave A. Cooper, Tap Park Manager
 Printed Name and Title of Responsible Person

PWS NAME: Waterfall Park
 PWS ID: OH 7002112
 COUNTY: Richland

For Ohio EPA use only:
 Date Verification Rec'd: _____

MAR 30 2017

DDAGW - NWDO

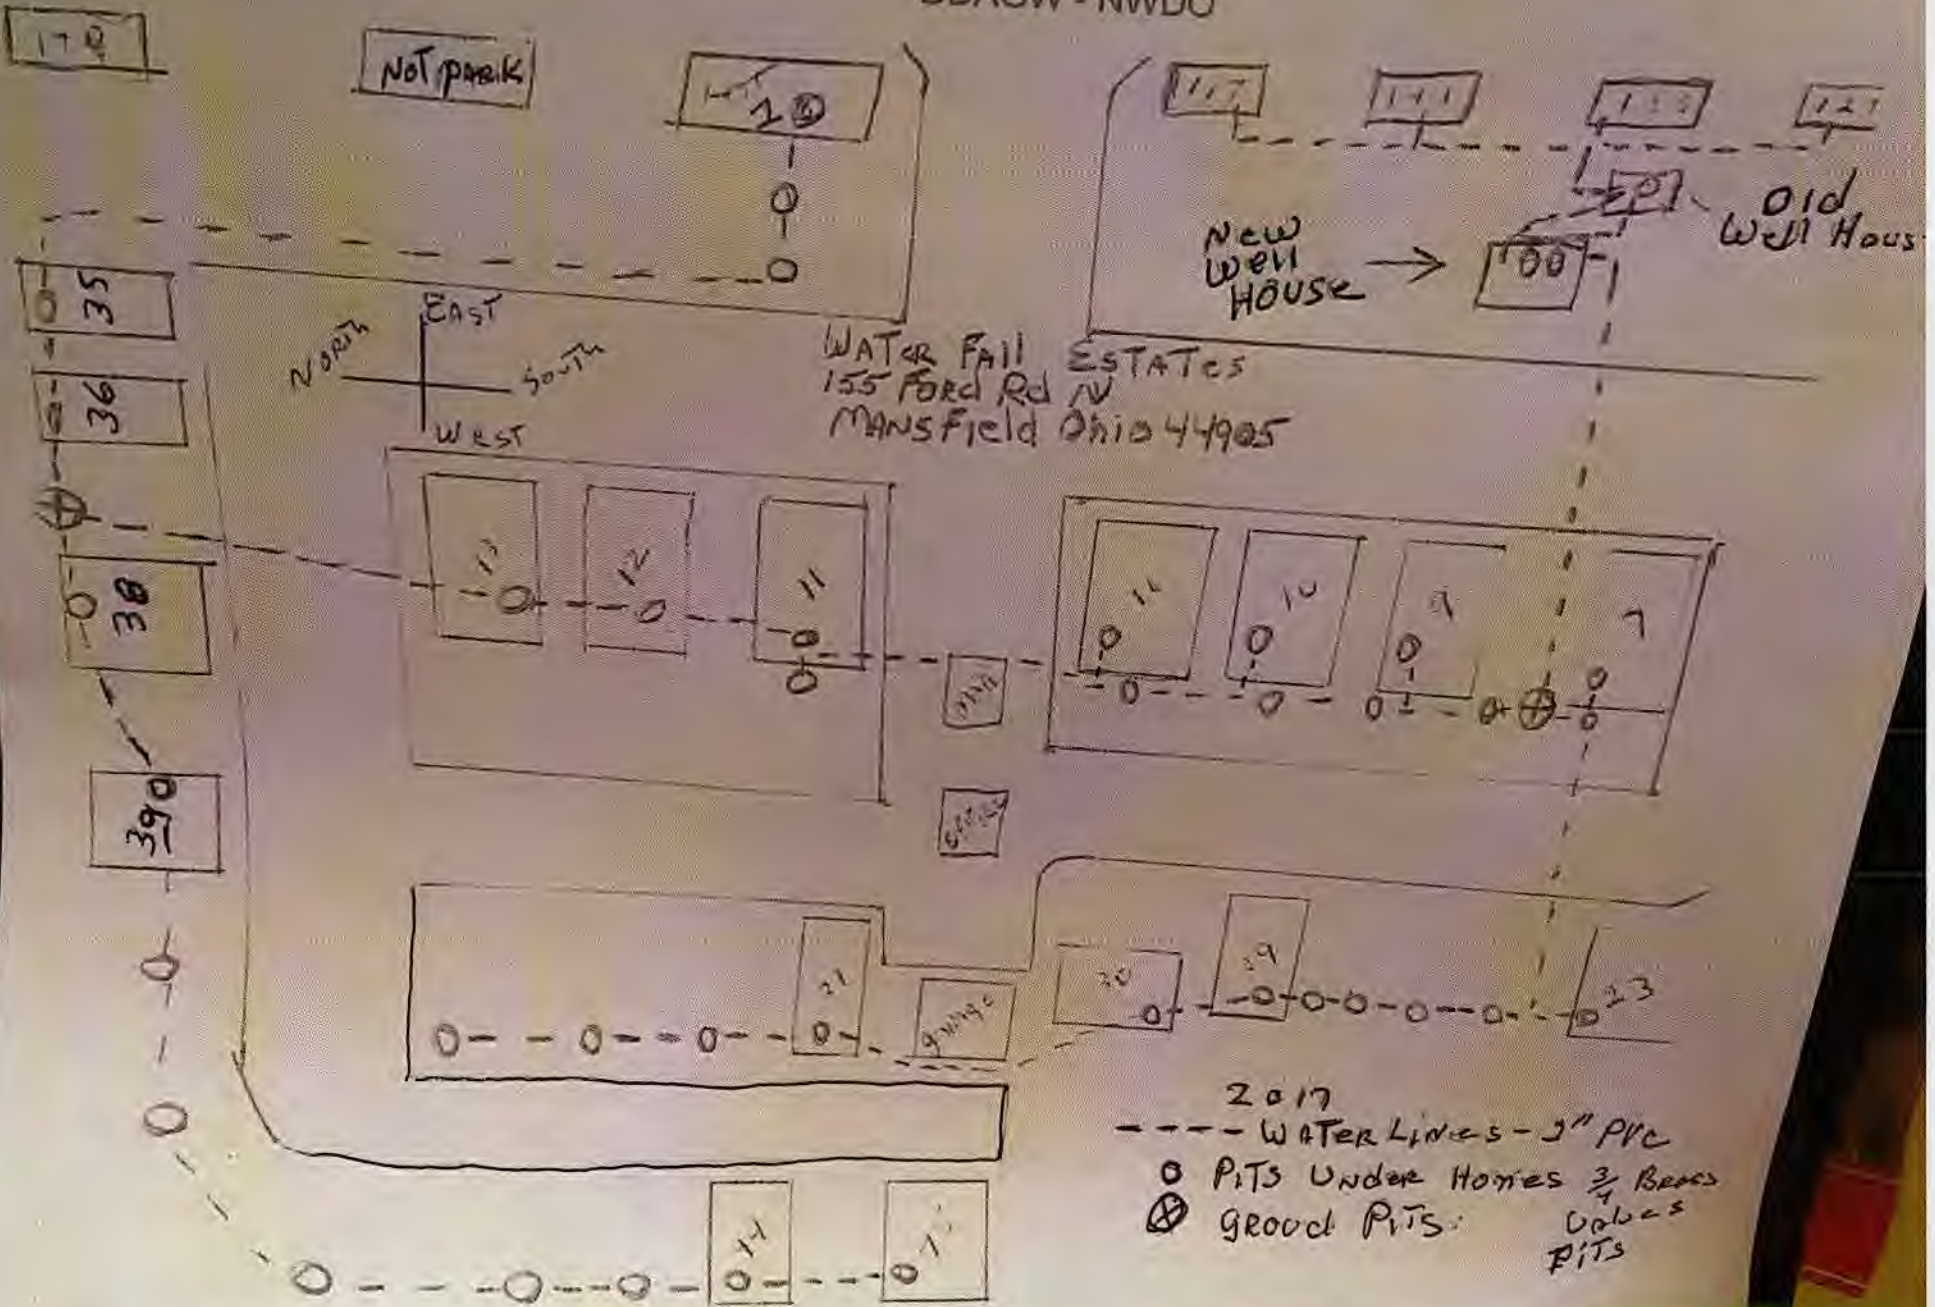

WATER FALL ESTATES
 155 FORD Rd IV
 MANSFIELD Ohio 44905

2017
 --- WATER Lines - 3" PVC
 ○ PITS Under Homes $\frac{3}{4}$ Bars
 ⊕ GROUND PITS: Valves
 PITS

En Tech - 419