

RE: Green Meadow MHP – Hancock Co
Report
Lead Mapping
Drinking Water Program
Hancock County
PWS ID: OH3200812

RECEIVED


APR 04 2017

DDAGW - NWDO

GREEN MEADOW MHP

CR 304 (OLD LINCOLN HWY)

N

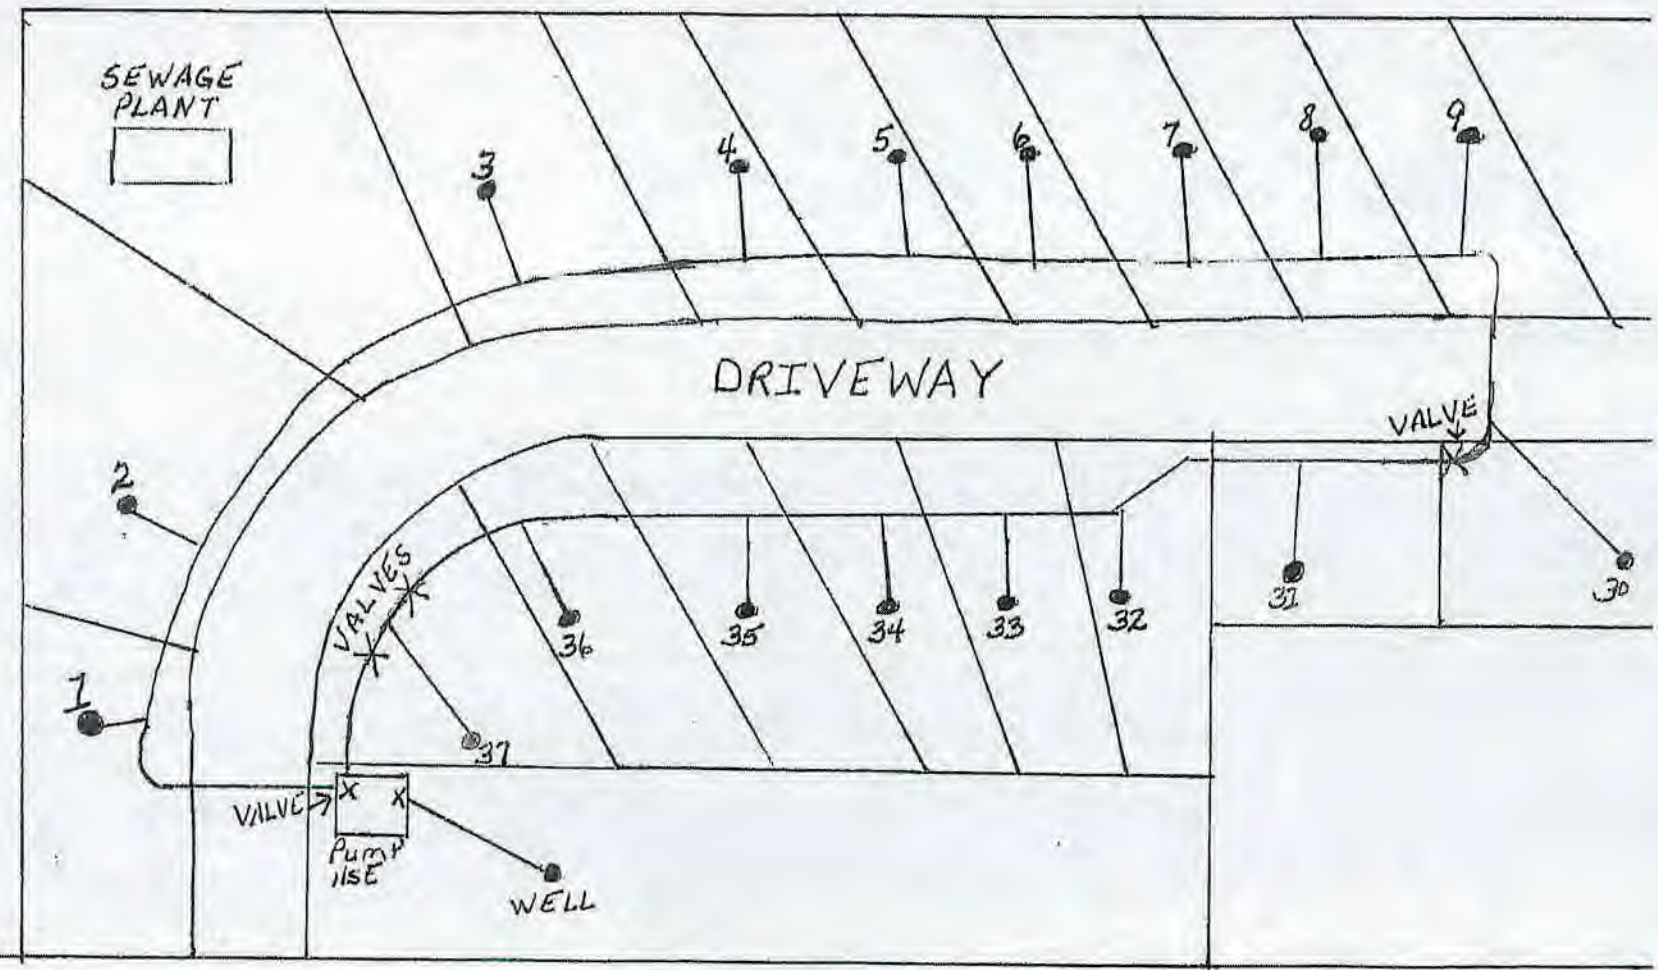

23135 SR 235 ADA OH 45810

Buildings in Ohio built prior to 1998 or that use plumbing material or solder manufactured before 1998 may have materials with greater than 8% lead and are at a higher risk of contributing lead to the drinking water than materials manufactured after 1998. In addition, buildings built and plumbing materials manufactured after 2014 were required to have less than 0.25% lead by weight and have the lowest risk for contributing lead to the drinking water. It should be noted however that, although prohibited, some use of leaded solder or leaded components may have occurred after the prohibitions became effective.