


RE: Poplar Village MHP  
Report  
Lead Mapping  
Drinking Water Program  
Seneca County  
PWS ID: OH7401212

RECEIVED

APR 10 2017

DDAGW - NWDO

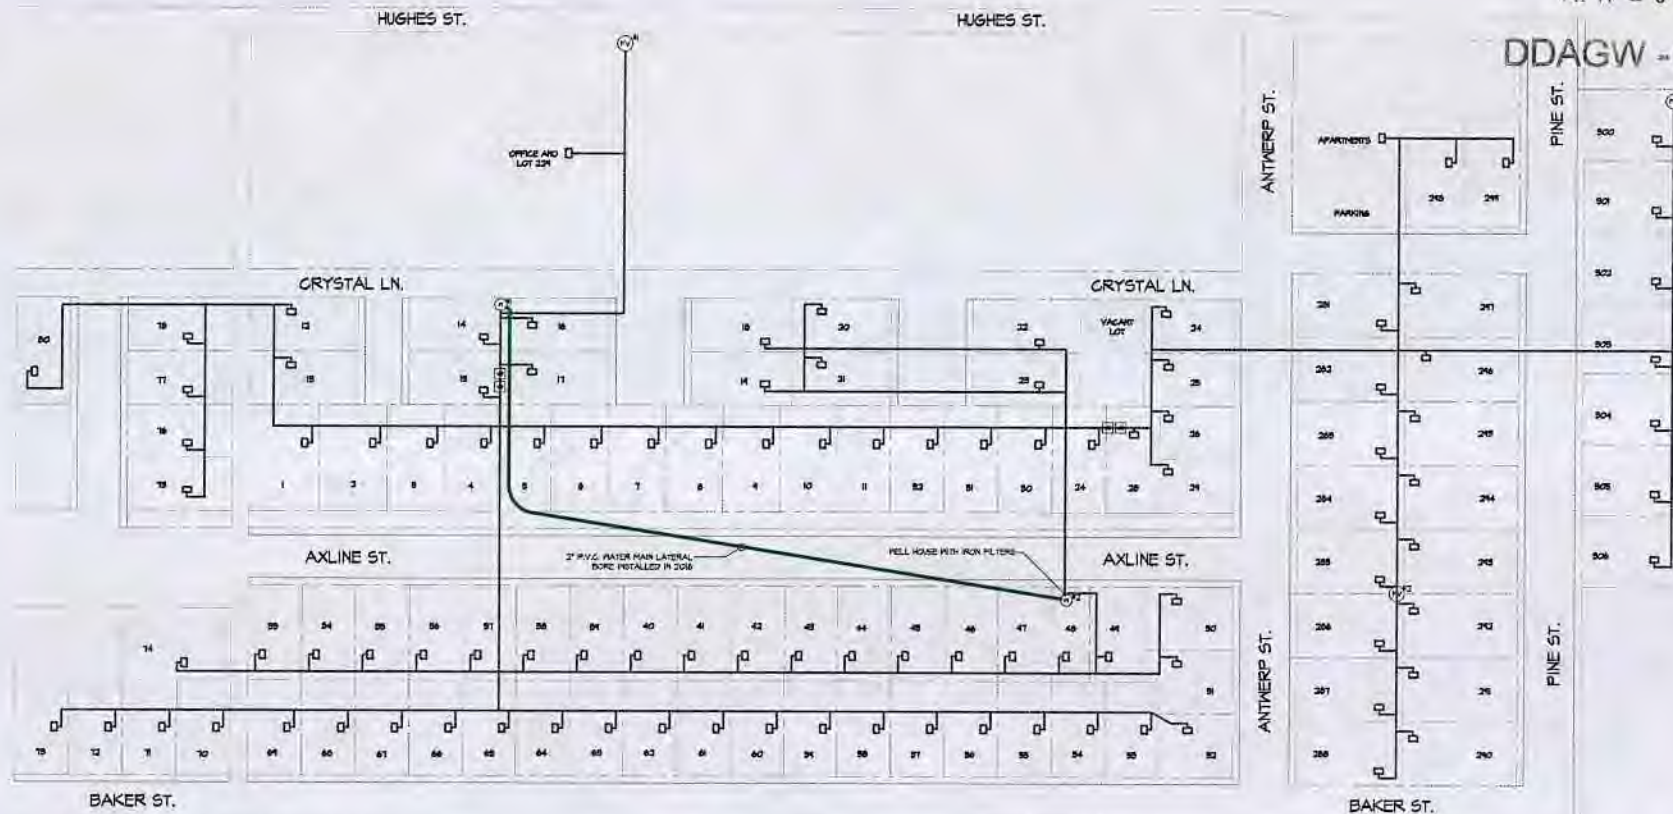

LEGEND

DESCRIPTION	SYMBOL	DESCRIPTION	SYMBOL
WELL	(N)	WATER MAIN (NO INFORMATION)	—
FLUSHING VALVE	(FV)	WATER MAIN (P.V.C.) ADDITION - 2016	—
VALVE BOX	(VB)		

NARRATIVE

- 1) MOBILE HOME COMMUNITY WITH AN OFFICE (1), AND APARTMENTS (3).
- 2) ORIGINAL DEVELOPMENT BEGAN BETWEEN 1965 AND 1968.
- 3) WATER DISTRIBUTION SYSTEM CONSISTS OF P.V.C., GALVANIZED PIPE, AND COPPER.
- 4) OF UNKNOWN AGES AND INSTALLATION DATES EXCEPT AS NOTED.
- 5) SERVICE CONNECTIONS ARE GALVANIZED WITH THREADED AND COMPRESSION FITTINGS AND COPPER PIPING WHICH UTILIZED COMPRESSION FITTINGS.

NOTE: Buildings in Ohio built prior to 1998 or that use plumbing material or solder manufactured before 1998 may have materials with greater than 8% lead and are at a higher risk of contributing lead to the drinking water than materials manufactured after 1998. In addition, buildings built and plumbing materials manufactured after 2014 were required to have less than 0.25% lead by weight and have the lowest risk for contributing lead to the drinking water. It should be noted however that, although prohibited, some use of leaded solder or leaded components may have occurred after the prohibitions became effective.

NOTE: WATERLINE LAYOUT AND DISTRIBUTION INFORMATION IS BASED OFF OF HISTORICAL DATA PROVIDED BY THE EPA.

APPROXIMATE DATE OF DRAWING: 1976



EPA 5105 Appendix

DRINKING WATER LEAD AND COPPER MONITORING REPORT

Submit with Form 5105-5000 Page \_\_\_\_\_ of \_\_\_\_\_ Pages

PWS Name Polar Village MHP	Facility	Analysis Laboratory Name James S. Healy Lab	Monitoring Contaminant(s) 4107
-------------------------------	----------	--	-----------------------------------

List complete responsibility by Laboratory Sample Number

Date of Sample	Time Sample Taken	Laboratory Sample Number	Address at Sample Site Example: 220 S Main St Threat City, OH 43084	Tap Type and Location Example: 1st Floor K.P. Tap	Minimum Flow Rate (L/min or GPM)	Initial Plumbing Material Type Example: Galv. or Copper	Number of Samples Per Tap or Site	Tap Location (Left/Right)	Lead (ppb)	Copper (ppb)


Form 5105-5000 (Rev. 4/16)

April 6, 2017

**Poplar Village Mobile Home Park**  
12400 West Axline Street, Fostoria, OH 44830  
Tel: (419) 436-7262

E.P.A. Lead Pipe Infrastructure Mapping

