

RE: Cedar Creek Estates
Report
Lead Mapping
Drinking Water Program
Ottawa County
PWS ID: OH6204112

Cedar Creek Estates
24475 W. Reservation Line Rd
Curtice, OH 43412
Allen Park Motor Court
PWS 6704112

Dear Ohio EPA,


I, Joseph St Clair, am submitting a disclaimer with the lead map for Cedar Creek Estates/ Allen Park Motor Court PWS 6704112. Disclaimer for lead mapping:

"Buildings in Ohio built prior to 1998 of that use plumbing material or solder manufactured before 1998 may have materials with greater than 8% lead and are at a higher risk of contributing lead to the drinking water than materials manufactured after 1998. In addition, building built and plumbing material manufactured after 2014 were required to have less than 0.25% lead by weight and have the lowest risk for contributing lead to the drinking water. It should be noted however that, although prohibited, some use of leaded solder or leaded components may have occurred after the prohibitions became effective."

This is an attachment to the lead mapping.

Thanks,

Joseph St. Clair

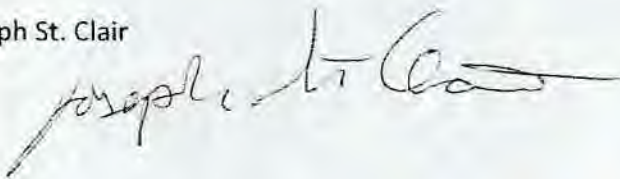

RECEIVED
APR 13 2017
DDAGW - NWDO


**VERIFICATION FORM FOR COMMUNITY PUBLIC WATER SYSTEMS
CLAIMING NO LEAD SERVICE LINES**

The owner or operator of all community public water systems must identify and map areas of their distribution system that are known or are likely to contain lead service lines. Systems must submit a copy of the applicable map to the Ohio Department of Health and the Ohio Department of Job and Family Services. Systems must also submit a report to the director containing at least both of the following: (1) The applicable map with narrative, and (2) A list of sampling locations used to collect samples as required by Ohio Revised Code (ORC) Section 6109.121 and any rules adopted thereunder, including contact information for the owner and occupant of each sampling site.

Should a water system determine no lead service lines exist in their distribution system, they must provide information stating they reviewed, at the minimum, historical permit records and local ordinances, distribution maintenance records and information pertaining to installation dates or materials for all services lines. This information must be verified below.

I HEREBY CERTIFY THAT THE FOLLOWING METHOD(S) WERE USED TO DETERMINE NO LEAD SERVICE LINES EXIST IN THIS WATER SYSTEM'S DISTRIBUTION SYSTEM, AS REQUIRED BY ORC 6109.121(F):

LEAD SERVICE LINE VERIFICATION
<p>This PWS states they have no lead service lines and has reviewed the following information (select one or more of the following):</p> <ul style="list-style-type: none"> <input type="checkbox"/> Historical permit records and/or local ordinances <input type="checkbox"/> Distribution maintenance records (i.e. meter replacement, waterline break repairs) <input type="checkbox"/> Information pertaining to installation dates for all service lines (i.e. after 1986 when lead services lines were banned) <input checked="" type="checkbox"/> Service line material of all service lines is known (i.e. all service lines are known to be <u>PVC</u>)


 Signature of Responsible Person _____ Date 3/31/17
Joe St. Clair O.R.
 Printed Name and Title of Responsible Person

PWS NAME: Cedar Creek H/S
 PWS ID: OH 6204112
 COUNTY: Ottawa

<p>For Ohio EPA use only:</p> <p>Date Verification Rec'd: _____</p>

RECEIVED
APR 13 2017
DDAGW - NWDO

Allen Park MotorCourt / Cedar Creek Estates
 PWS 6704112 24475 W. Reservation Line Rd
 Coaticum OH 43412




RECEIVED

APR 13 2017

DDAGW - NWDO

1" PVC TO EACH
 UNIT OFF 2" LINE.

(See attached letter)

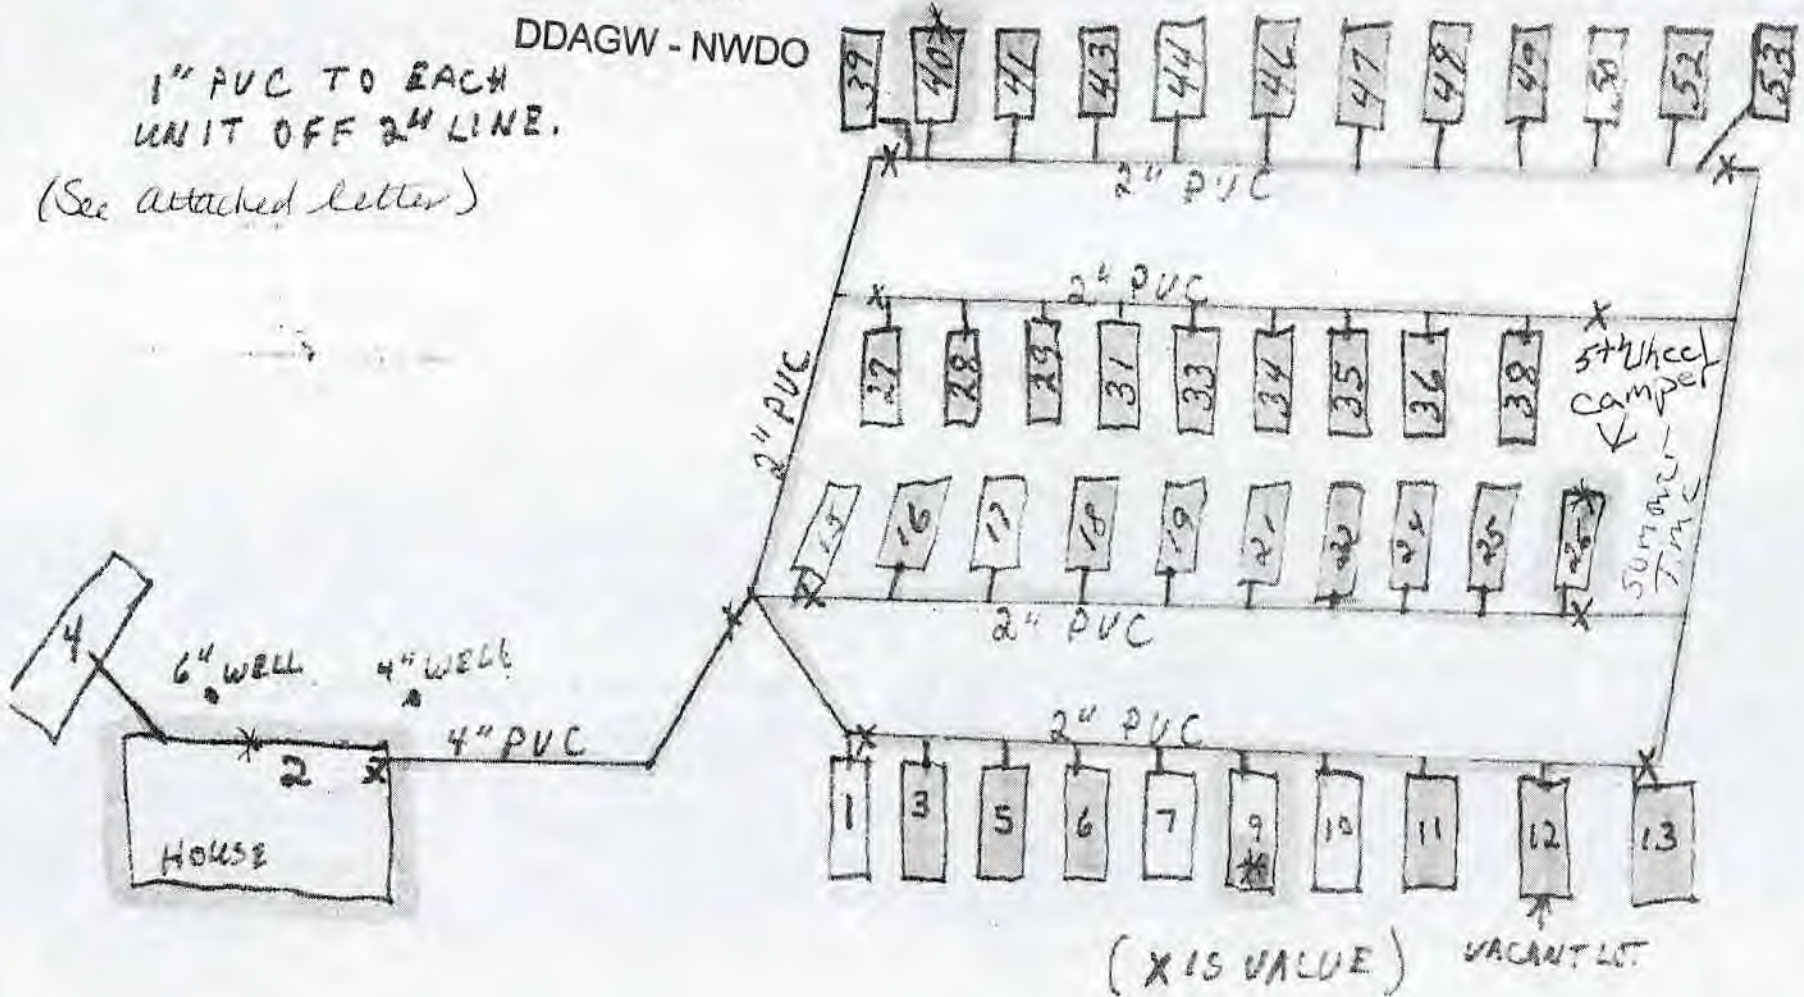

no lead
 empty lots
 sample sites
 possible lead
 occupied

Allen Park Mobile Court receives its drinking water from two wells located next to LC 201 on the lead and copper map. Once water is chlorinated and softened it then is ready for distribution. The distribution line starts as a four inch PVC pipe that is 3 foot plus underground. This pipe travels to the 4-line grid then reduces to a two inch PVC pipe where it connects to the grid. The lines then reduce to one inch PVC when it travels to the surface of the ground.

Locations LC 202, LC 203, LC 204, and LC 205 are all trailers that have a non-solder copper lines that start at shut off valve (ground level) and proceed to bottom of the trailers. Copper lines are connected with brass fittings with copper line being flared on both ends. The copper lines at this point are converted to PEX piping to supply water to the kitchen area, bathroom area as well as the hot water tank.

Location LC 201 is the only trailer with copper lines with solder. This location has a full basement unlike the four mentioned above. The water works is located in the northeast corner of this basement. All piping through this trailer are copper lines with solder.

RECEIVED

MAR 08 2017

DDAGW - NWDO


RECEIVED

MAR 08 2017

DDAGW - NWDO

Allen Park Motor Court / Cedar Creek Estates
PWS# 6204112 24475 W. Reservation Line Rd
Ottawa Co. Custice OH 43412

1" PVC TO EACH UNIT OFF 2" LINE.

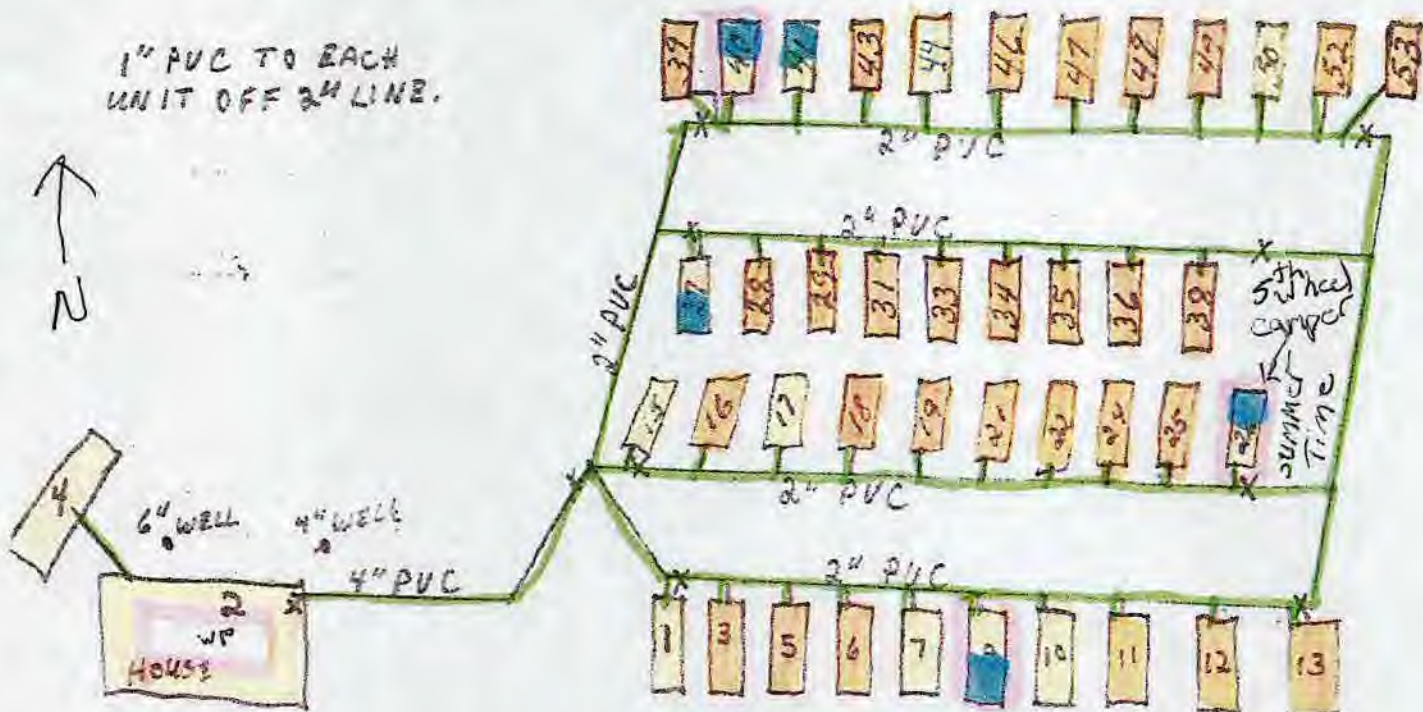

(X IS VALVE)

Mobile homes look to be late 60's early 70's

No Lead

EMPTY LOTS

sample site

Possible Lead

occupied