


RE: Oakwood MHP
Report
Lead Mapping
Drinking Water Program
Williams County
PWS ID: OH8601212

RECEIVED

APR 14 2017

DDAGW - NWDO

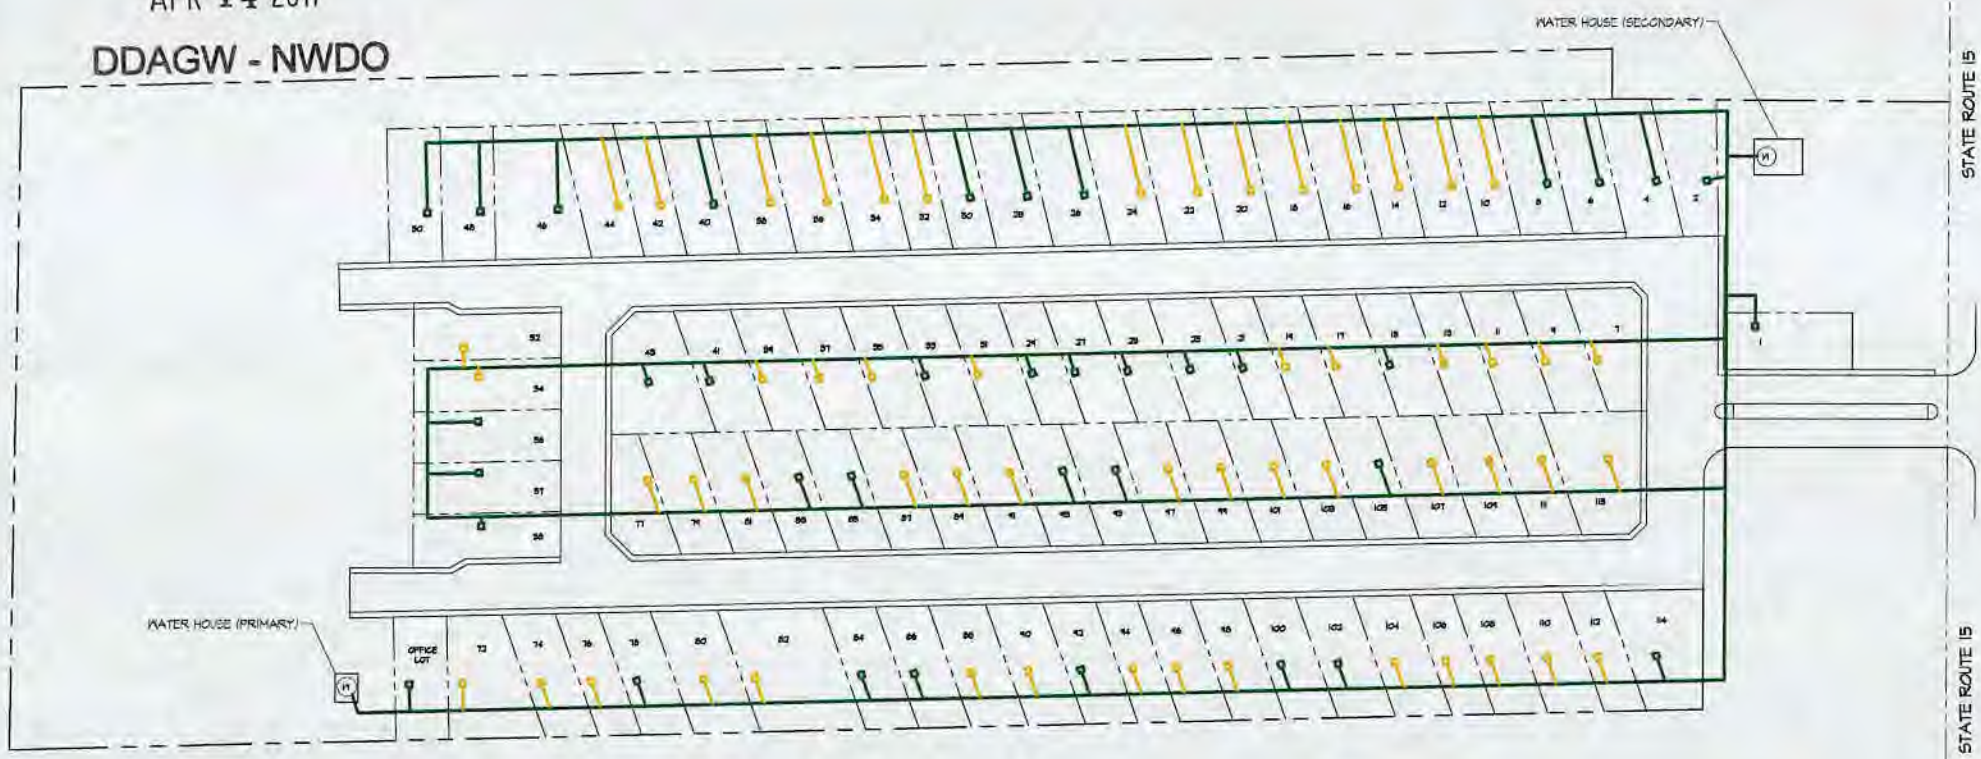

LEGEND

DESCRIPTION	SYMBOL	DESCRIPTION	SYMBOL
WELL	(1)	WATER MAIN (2" P.V.C.)	—
		SERVICE CONNECTION (BLACK P.V.C. PIPE)	—
		SERVICE CONNECTION (COPPER WITH COMPRESSED FITTINGS)	—

NOTE: WATERLINE LAYOUT AND DISTRIBUTION INFORMATION IS BASED OFF OF DISTRIBUTION MAINTENANCE RECORDS (WATERLINE BREAK RECORDS)



NARRATIVE

- 1) MOBILE HOME COMMUNITY WITH AN OFFICE (1), AND WATER HOUSING FACILITIES (2).
- 2) WATER DISTRIBUTION SYSTEM CONSISTS OF P.V.C PIPE.
- 4) OF UNKNOWN AGES AND INSTALLATION DATES.
- 5) SERVICE CONNECTIONS ARE A MIX OF BLACK P.V.C AND COPPER WITH COMPRESSION FITTINGS.

NOTE: Buildings in Ohio built prior to 1998 or that use plumbing material or solder manufactured before 1998 may have materials with greater than 8% lead and are at a higher risk of contributing lead to the drinking water than materials manufactured after 1998. In addition, buildings built and plumbing materials manufactured after 2014 were required to have less than 0.25% lead by weight and have the lowest risk for contributing lead to the drinking water. It should be noted however that, although prohibited, some use of leaded solder or leaded components may have occurred after the prohibitions became effective.

Oakwood Mobile Home Park
06-695 State Route 15, Bryan, OH 43506
Tel: (419) 636-2714

April 6, 2017
E.P.A. Lead Pipe Infrastructure Mapping

