

RE: Napoleon City
Report
Lead Mapping
Drinking Water Program
Henry County
PWS ID: OH3500811



CITY OF NAPOLEON Water Treatment Plant

527 Welsted Street • P.O. Box 151 • Napoleon, OH 43545
Ph. (419) 592-8811 • Fax (419) 592-8595

April 17, 2017

Musa Khaleq
Ohio EPA NWDO
347 North Dunbridge Rd.
Bowling Green, Ohio 43402

Re: Lead Disclaimer For city Of Napoleon

Dear Mr. Khaleq:

The following disclaimer was omitted. Please except for our mapping obligation.

"Buildings in Ohio built prior to 1998 or that use plumbing material or solder manufactured before 1998 may have materials with greater than 8% lead and are at higher risk of contributing lead to the drinking water than materials manufactured after 1998. In addition, building built and plumbing material manufactured after 2014 were required to have less than 0.25% lead by weight and have the lowest risk for contributing lead to the drinking water. It should be noted however that, although prohibited, some use of leaded solder or leaded componets may have occurred after the prohibitions became effective.


If you have any questions regarding this matter, please feel free to contact me at 419-592-8811

Sincerely,


Scott Hoover

Water Treatment Plant Superintendent

DDAGW - NWDO

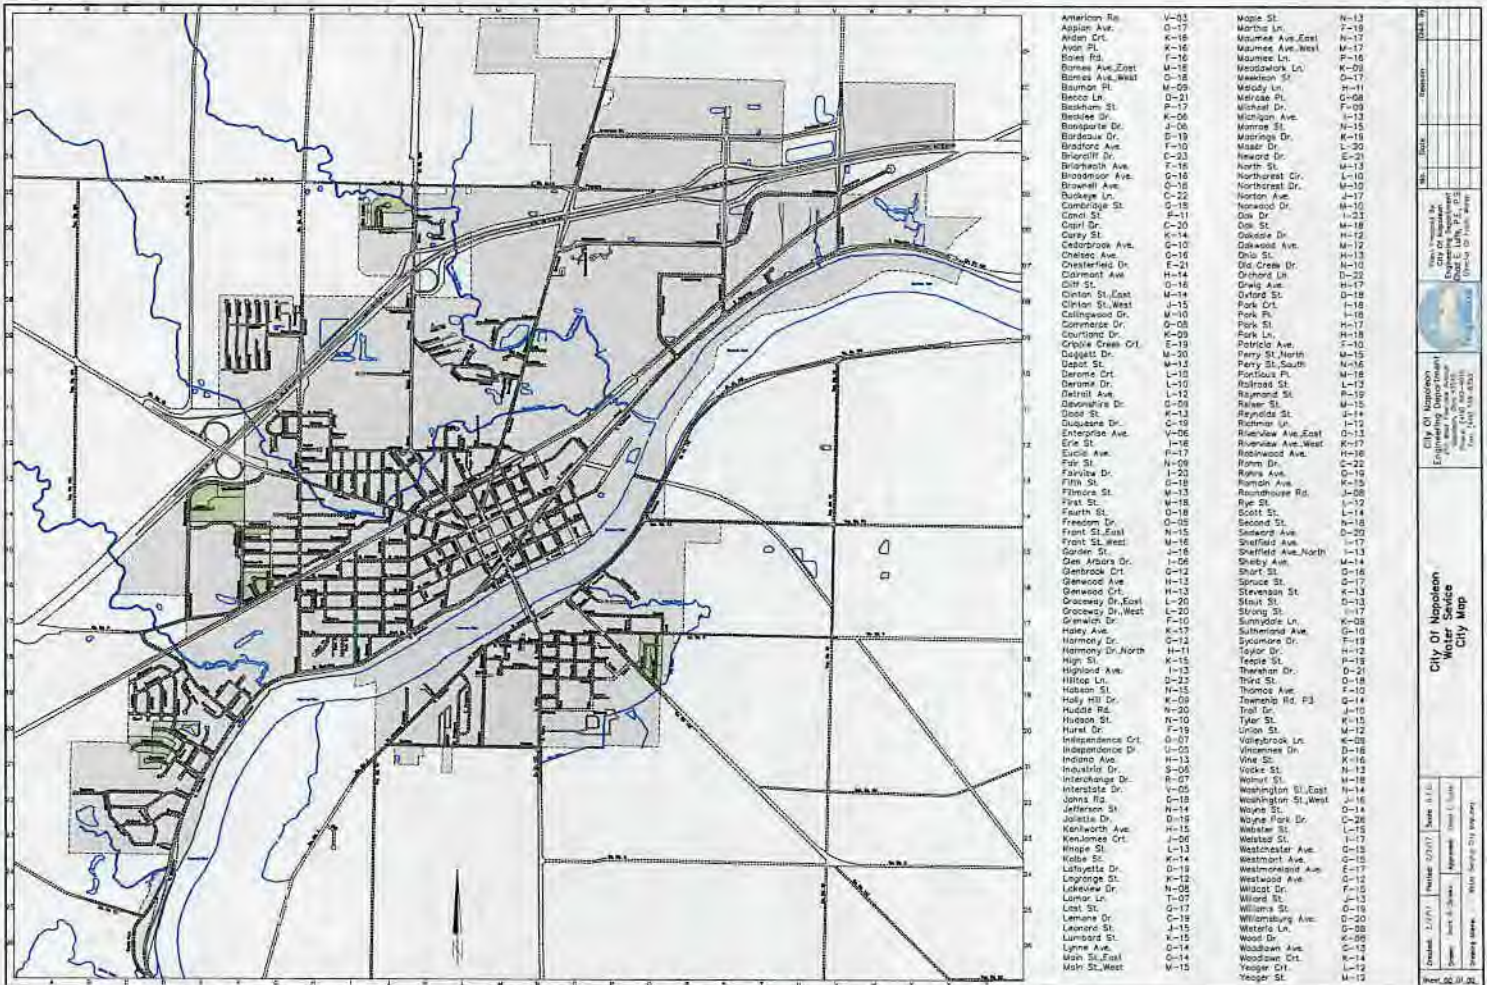

RECEIVED
MAY 1 2017
CITY OF NAPOLEON

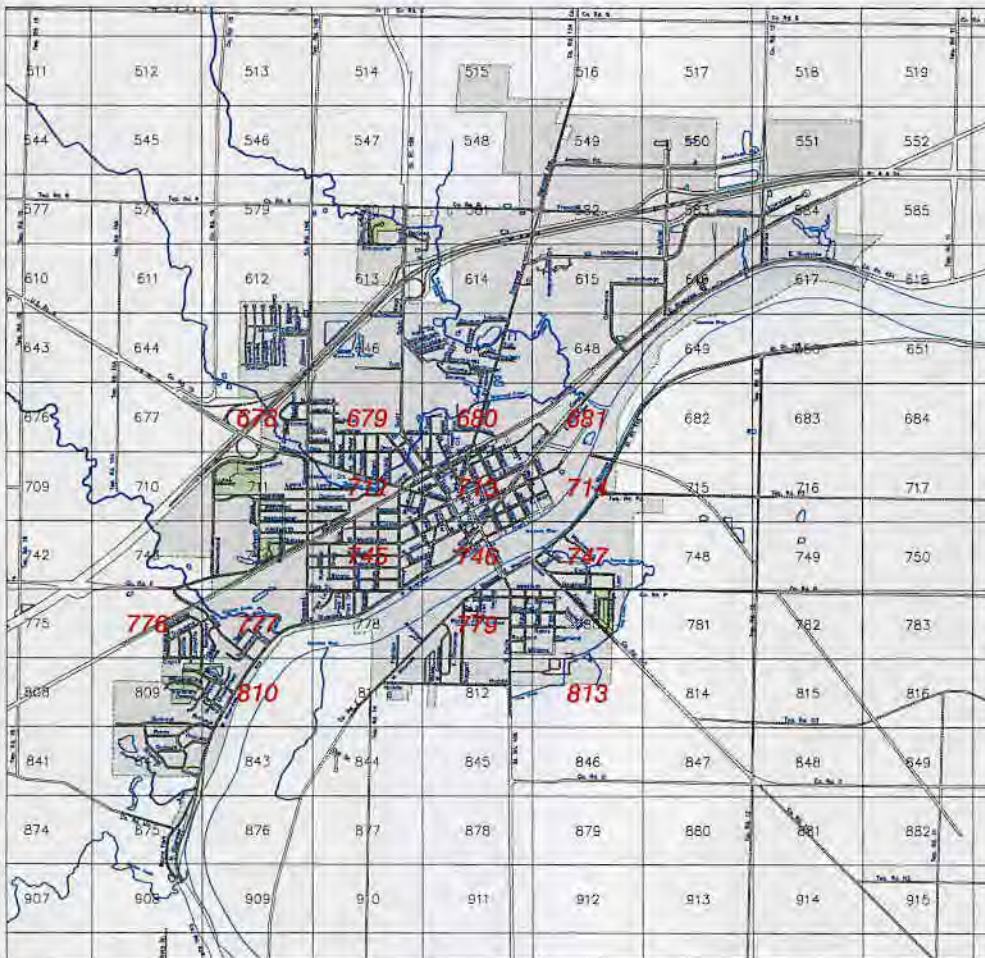

City Of Napoleon Water Service Replacement Map

Plotted 01/20/2017

Please Note

Property Lines, Right Of Ways, Alleys, Streets, Sidewalks,
Building Footprints, And Lines On This Map Are Approximate
And Should Not Be Used For Dimensioning Or Determination
Of Property Boundaries Or Setbacks.

See Sheet #646

See Sheet #678




See Sheet #680

See Sheet #712

Sheet #679



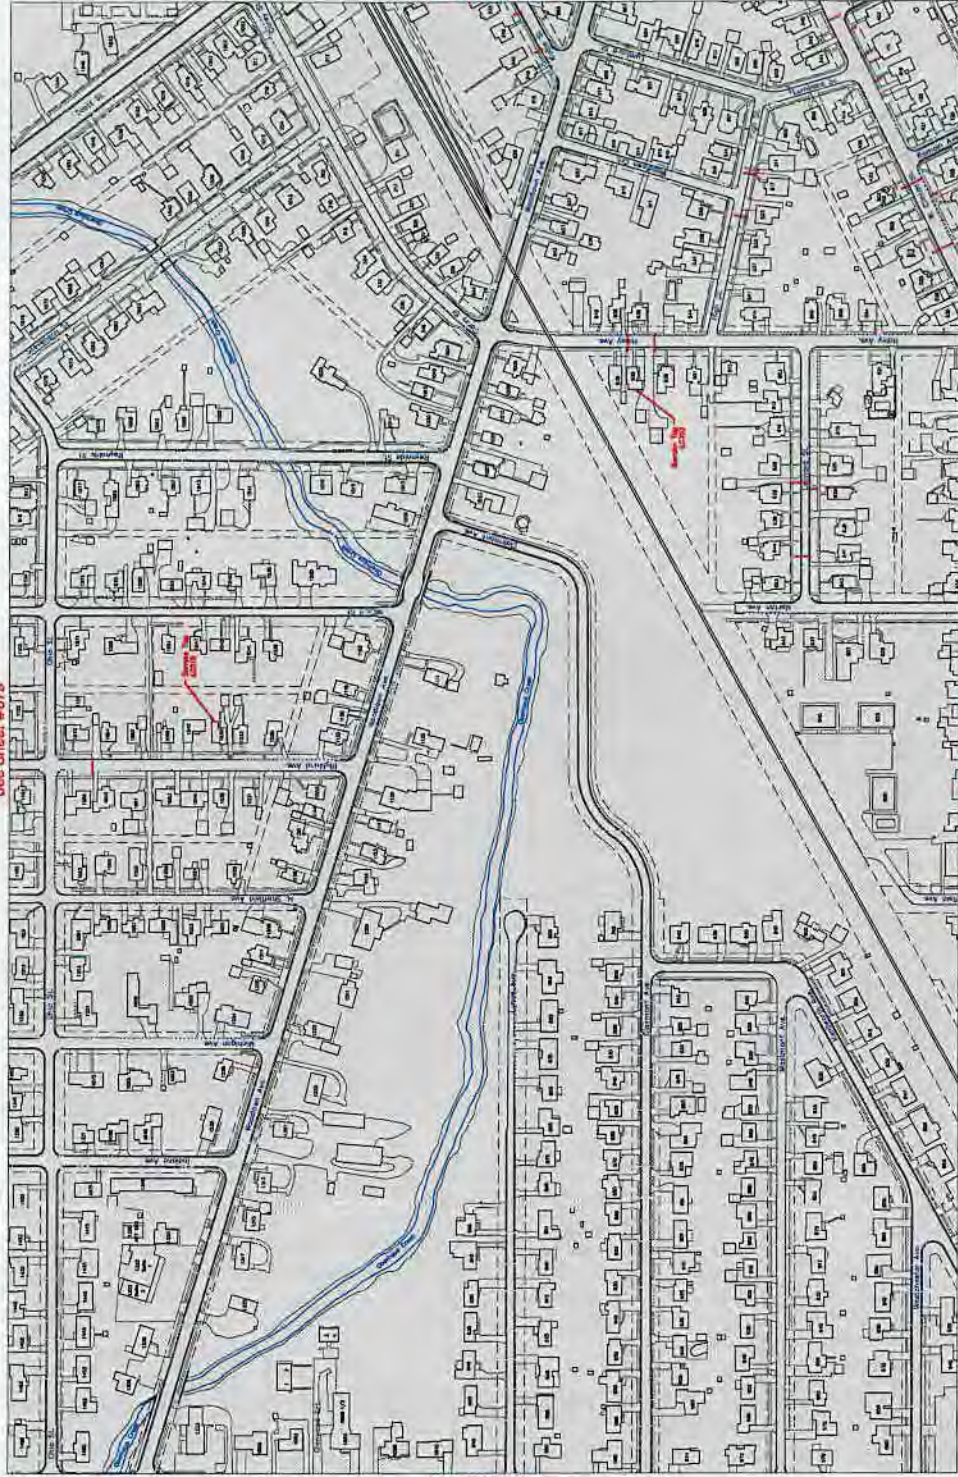

See Sheet #679

See Sheet #711

See Sheet #713

See Sheet #745

Sheet #712

See Sheet #712




See Sheet #740

See Sheet #680

Sheet #713

See Sheet #714

See Sheet #681

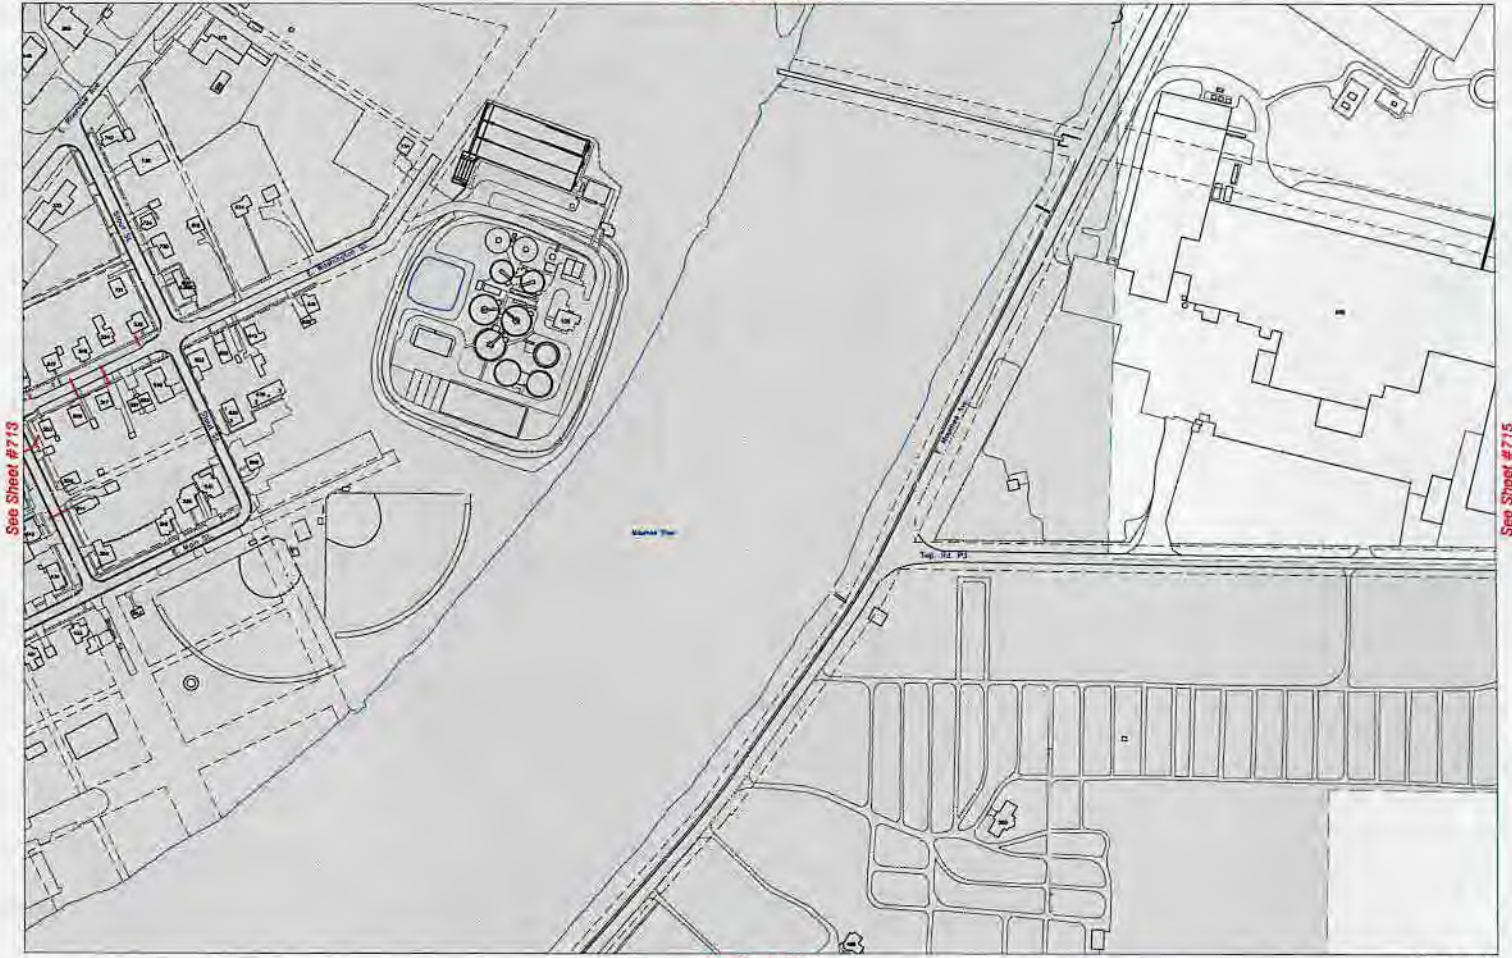

See Sheet #747

Sheet #714

See Sheet #713

See Sheet #715



See Sheet #744

See Sheet #712

See Sheet #778


See Sheet #746

Sheet #745

See Sheet #714

See Sheet #746

See Sheet #748

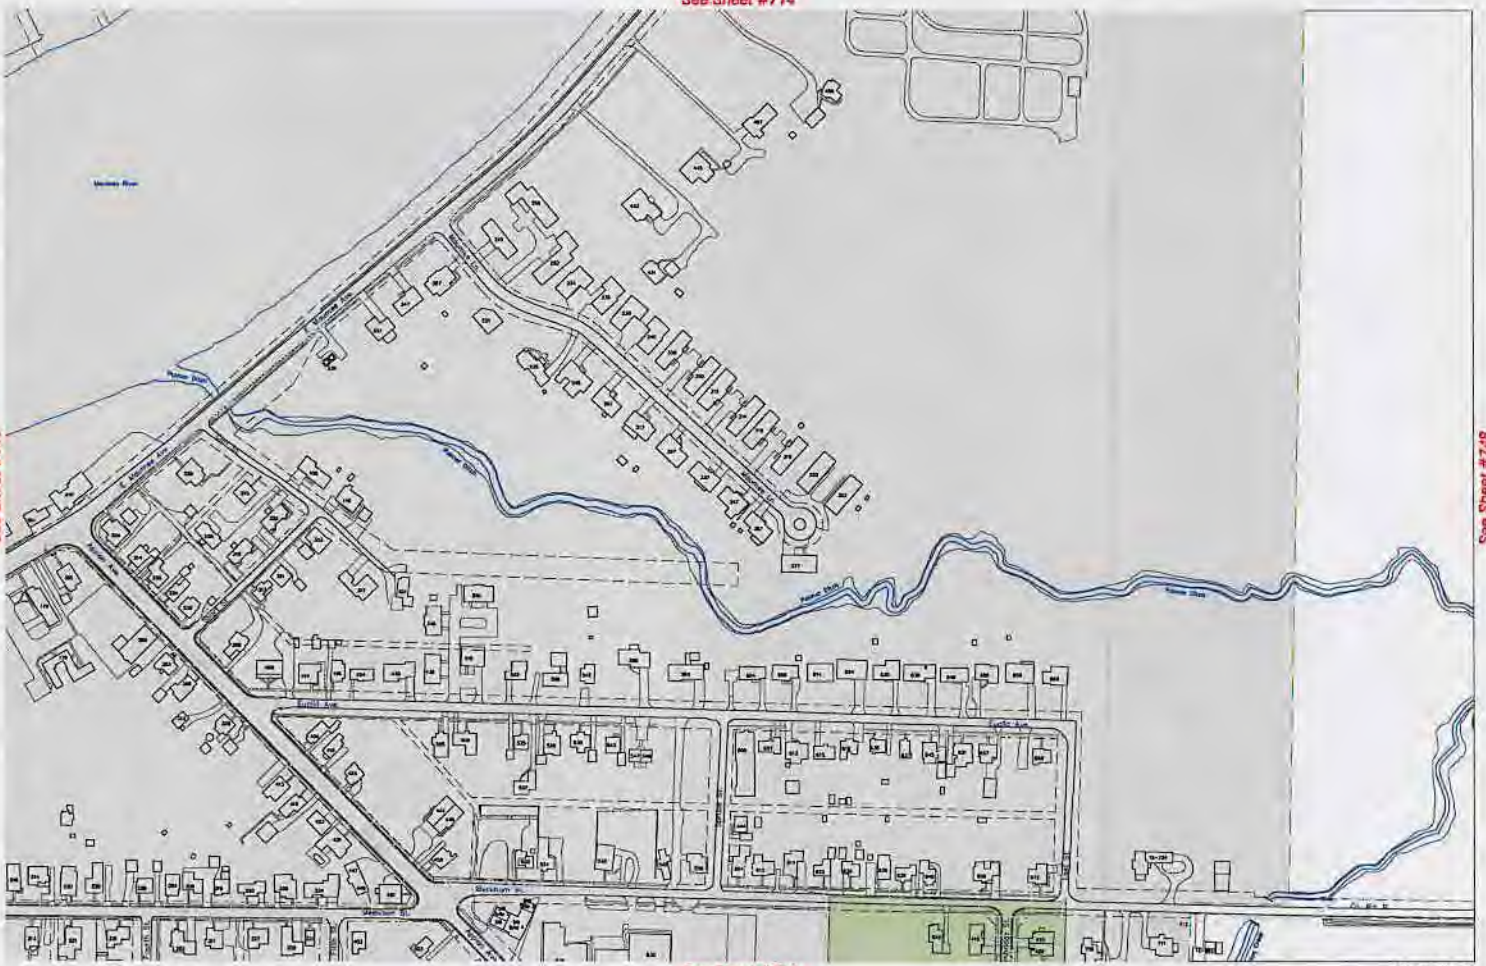

See Sheet #780

Sheet #747

See Sheet #775


See Sheet #809

See Sheet #743



See Sheet #777

Sheet #776

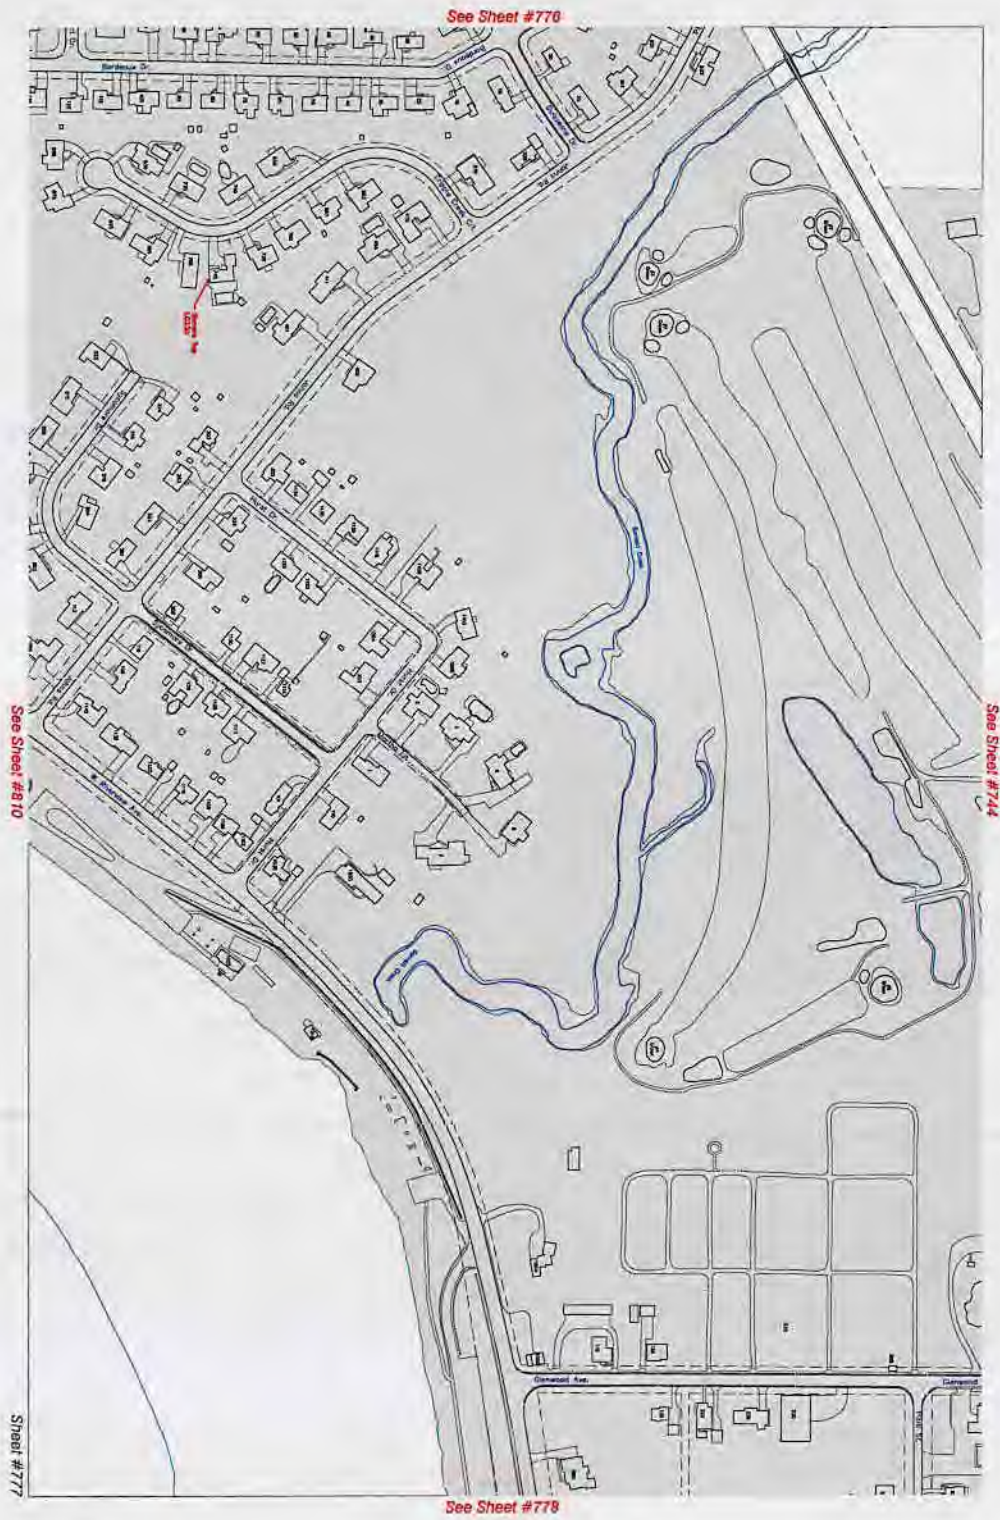








See Sheet #777



See Sheet #800

See Sheet #811

See Sheet #843

Sheet #810

