

RE: West Unity Village  
Report  
Lead Mapping  
Drinking Water Program  
Williams County  
PWS ID: OH8601812

*Village Administrator*  
JOSHUA FRITSCH

*Fiscal Officer*  
KIM GRIME

*Deputy Clerk*  
KATIE BALTOSSER

*Chief of Police*  
J.R. JONES



*Mayor*  
PEGGY L. BERNATH

*Council Members*  
KEVIN GRAY, *Pres.*  
KIRK THOMPSON  
TERRI LEBOWSKY  
DONAVON LEU  
STEPHEN MARVIN  
DAVID SHORT

*"Northwestern Ohio Community  
Of Pride and Unity"*

224 W. JACKSON STREET - P. O. BOX 207 • WEST UNITY, OHIO 43570-0207  
Village Office: 419-924-2215 - Police Dept: 419-924-2271

Musa,

The please add this to the Village's paperwork in regards to the lead and copper requirements.

**"Buildings in Ohio built prior to 1998 or that use plumbing material or solder manufactured before 1998 may have materials with greater than 8% lead and are at a higher risk of contributing lead to the drinking water than materials manufactured after 1998. In addition, building built and plumbing material manufactured after 2014 were required to have less than 0.25% lead by weight and have the lowest risk for contributing lead to the drinking water. It should be noted however that, although prohibited, some use of leaded solder or leaded components may have occurred after the prohibitions became effective."**

Thank you,

Randy Mahlman- Water wastewater supervisor Village of West Unity

**RECEIVED**

**APR 19 2017**

**DDAGW - NWDO**


**VERIFICATION FORM FOR COMMUNITY PUBLIC WATER SYSTEMS  
CLAIMING NO LEAD SERVICE LINES**

The owner or operator of all community public water systems must identify and map areas of their distribution system that are known or are likely to contain lead service lines. Systems must submit a copy of the applicable map to the Ohio Department of Health and the Ohio Department of Job and Family Services. Systems must also submit a report to the director containing at least both of the following: (1) The applicable map with narrative, and (2) A list of sampling locations used to collect samples as required by Ohio Revised Code (ORC) Section 6109.121 and any rules adopted thereunder, including contact information for the owner and occupant of each sampling site.

Should a water system determine no lead service lines exist in their distribution system, they must provide information stating they reviewed, at the minimum, historical permit records and local ordinances, distribution maintenance records and information pertaining to installation dates or materials for all services lines. This information must be verified below.

I HEREBY CERTIFY THAT THE FOLLOWING METHOD(S) WERE USED TO DETERMINE NO LEAD SERVICE LINES EXIST IN THIS WATER SYSTEM'S DISTRIBUTION SYSTEM, AS REQUIRED BY ORC 6109.121(F):

LEAD SERVICE LINE VERIFICATION
<p><b>This PWS states they have no lead service lines and has reviewed the following information (select one or more of the following):</b></p> <ul style="list-style-type: none"><li><input type="checkbox"/> Historical permit records and/or local ordinances</li><li><input checked="" type="checkbox"/> Distribution maintenance records (i.e. meter replacement, waterline break repairs)</li><li><input type="checkbox"/> Information pertaining to installation dates for all service lines (i.e. after 1986 when lead services lines were banned)</li><li><input type="checkbox"/> Service line material of all service lines is known (i.e. all service lines are known to be PVC)</li></ul>

      2/28/17  
Signature of Responsible Person      Date

Randy Mahlman water-wastewater supervisor  
Printed Name and Title of Responsible Person

PWS NAME: West Unity  
PWS ID: OH 8601812  
COUNTY: Williams

<p><b><u>For Ohio EPA use only:</u></b></p> <p>Date Verification Rec'd: _____</p>
---

Lead Mapping Verification Form Revised 2/14/17

**RECEIVED**

FEB 28 2017


DDAGW - NWDO

South Section of West Unity

RECEIVED

JAN 31 2017

DDAGW - NWDO

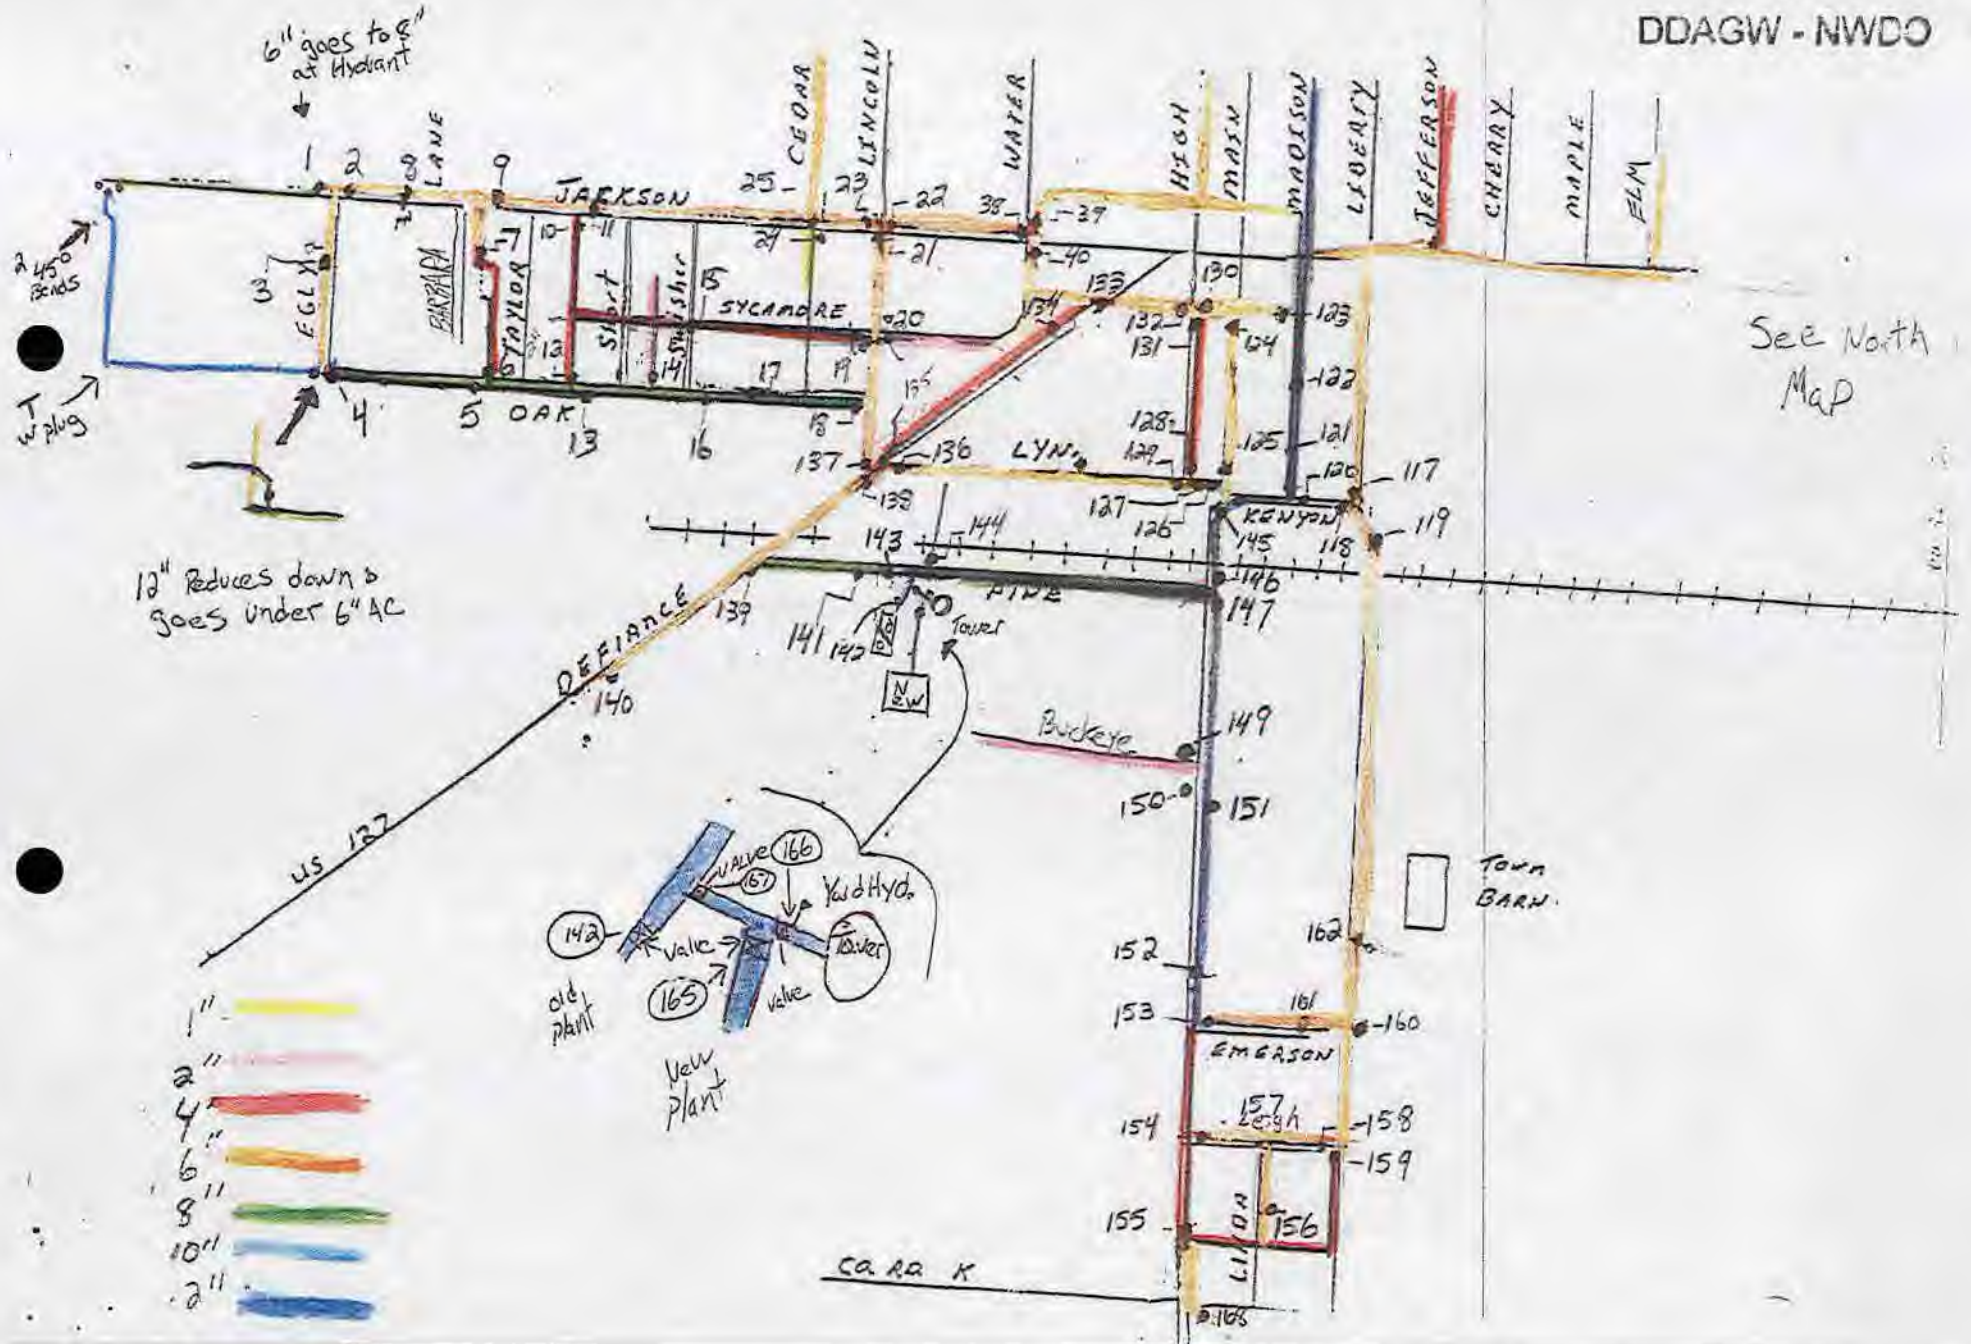


See North Map

12" Reduces down & goes under 6" AC

6" goes to hydrant

- 1"
- 2"
- 4"
- 6"
- 8"
- 10"
- 24"

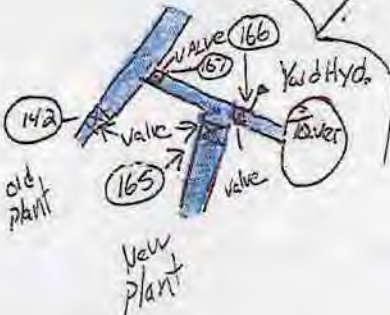

Town Barn

CO. RD. K

North Section of West Unity

RECEIVED

JAN 31 2017

DDAGW - NWDO

