

RE: Oakwood Village  
Report  
Lead Mapping  
Drinking Water Program  
Paulding County  
PWS ID: OH6300312



*Village of Oakwood*

P.O. Box 457  
228 North First Street  
OAKWOOD Paulding Co., OHIO 45873  
(419) 594-3352  
(419) 594-2322 FAX

RECEIVED

APR 20 2017

DDAGW - NWDO

Mayor  
Brian Ripke


Fiscal Officer  
Susan Barron

1. Why no lead lines and copper service lines? Over the years they have been changed out due to the sulfur would eat away at the lines causing them to leak. This is the same with our water mains which are all AC with no lead joints and plastic. All the galvanized lines were removed also due to the corrosive properties of sulfur. The reason we know is in the past 12 years of repairs we have never ran into any of the lead, copper, galvanized lines. All mains that we have exposed have been AC or Plastic.
2. Why were the lead and copper monitoring sites chosen? They are some of the oldest houses in town and most likely to contain some kind of lead if any.
3. The reason that all houses have plastic lines in them is when they used copper it would last from two to five years and they would have to replace it due to the sulfur that used to be in the water. So everyone changed the lines to plastic to remedy the problem sulfur eating the copper pipes. This was the same with faucets. They didn't last long. So they were replaced.
4. Buildings in Ohio built prior to 1998 or that use plumbing material or solder manufactured before 1998 may have materials with greater than 8% lead and are at a higher risk of contributing lead to the drinking water than materials manufactured after 1998. In addition, buildings built and plumbing materials manufactured after 2014 were required to have less than 0.25% lead by weight and have the lowest risk for contributing lead to the drinking water. It should be noted however that, although prohibited, some use of leaded solder or leaded components may have occurred after the prohibitions became effective.





All Main Lines: Plastic & AC with Gasket Joints  
 NO Lead Service Lines

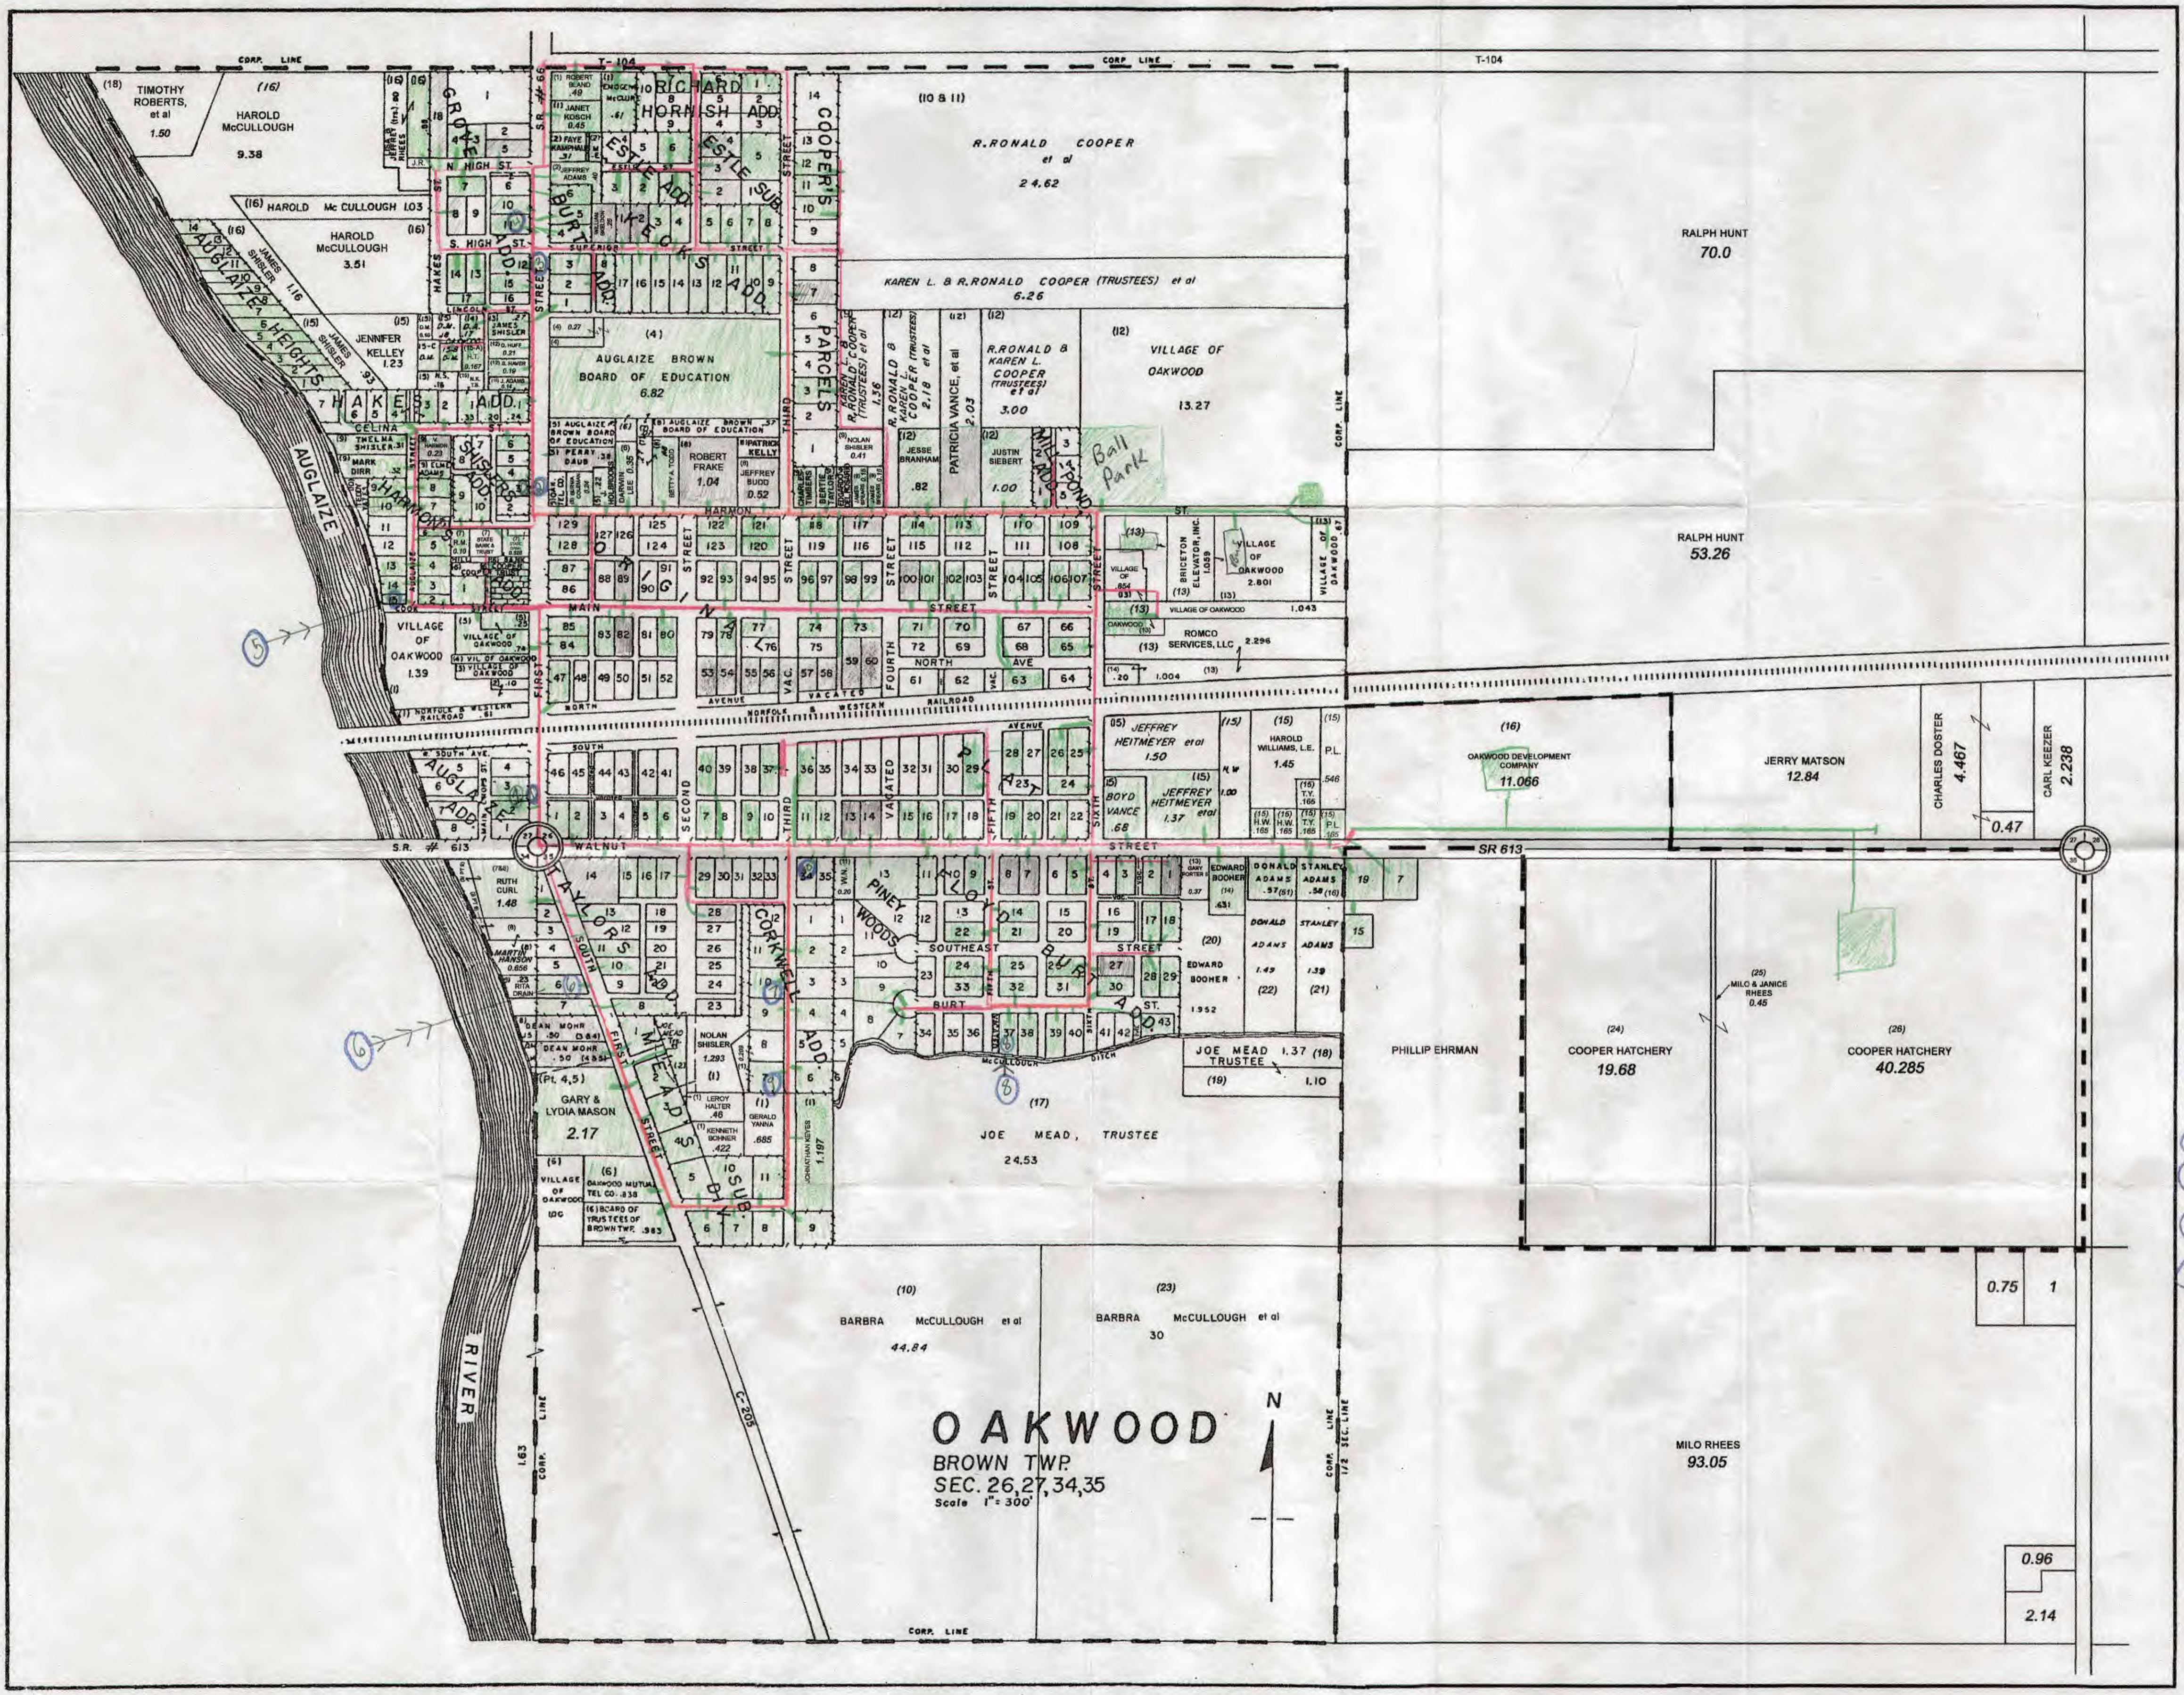

Legend  
 4"  
 6"  
 8"

Lead ■  
 NonLead ■  
 No Information ■

All Main Lines  
 AC with Gasket Joints  
 Plastic  
 No Lead Service Lines

Sampling Point

- ① 104 N First.
- ② 228 N First.
- ③ 318 N First st
- ④ 400 N First st
- ⑤ 201 Auglaize
- ⑥ 108 S First st
- ⑦ 108 S Third st
- ⑧ 501 Burt st
- ⑨ 114 S Third st
- ⑩ 303 Walnut S

RECEIVED  
 MAR 07 2017  
 OHIO E.P.A.  
 N.W.D.O.