


RE: Montpelier Village  
Report  
Lead Mapping  
Drinking Water Program  
Williams County  
PWS ID: OH8600912

RECEIVED  
APR 20 2017  
DDACW - NWDO

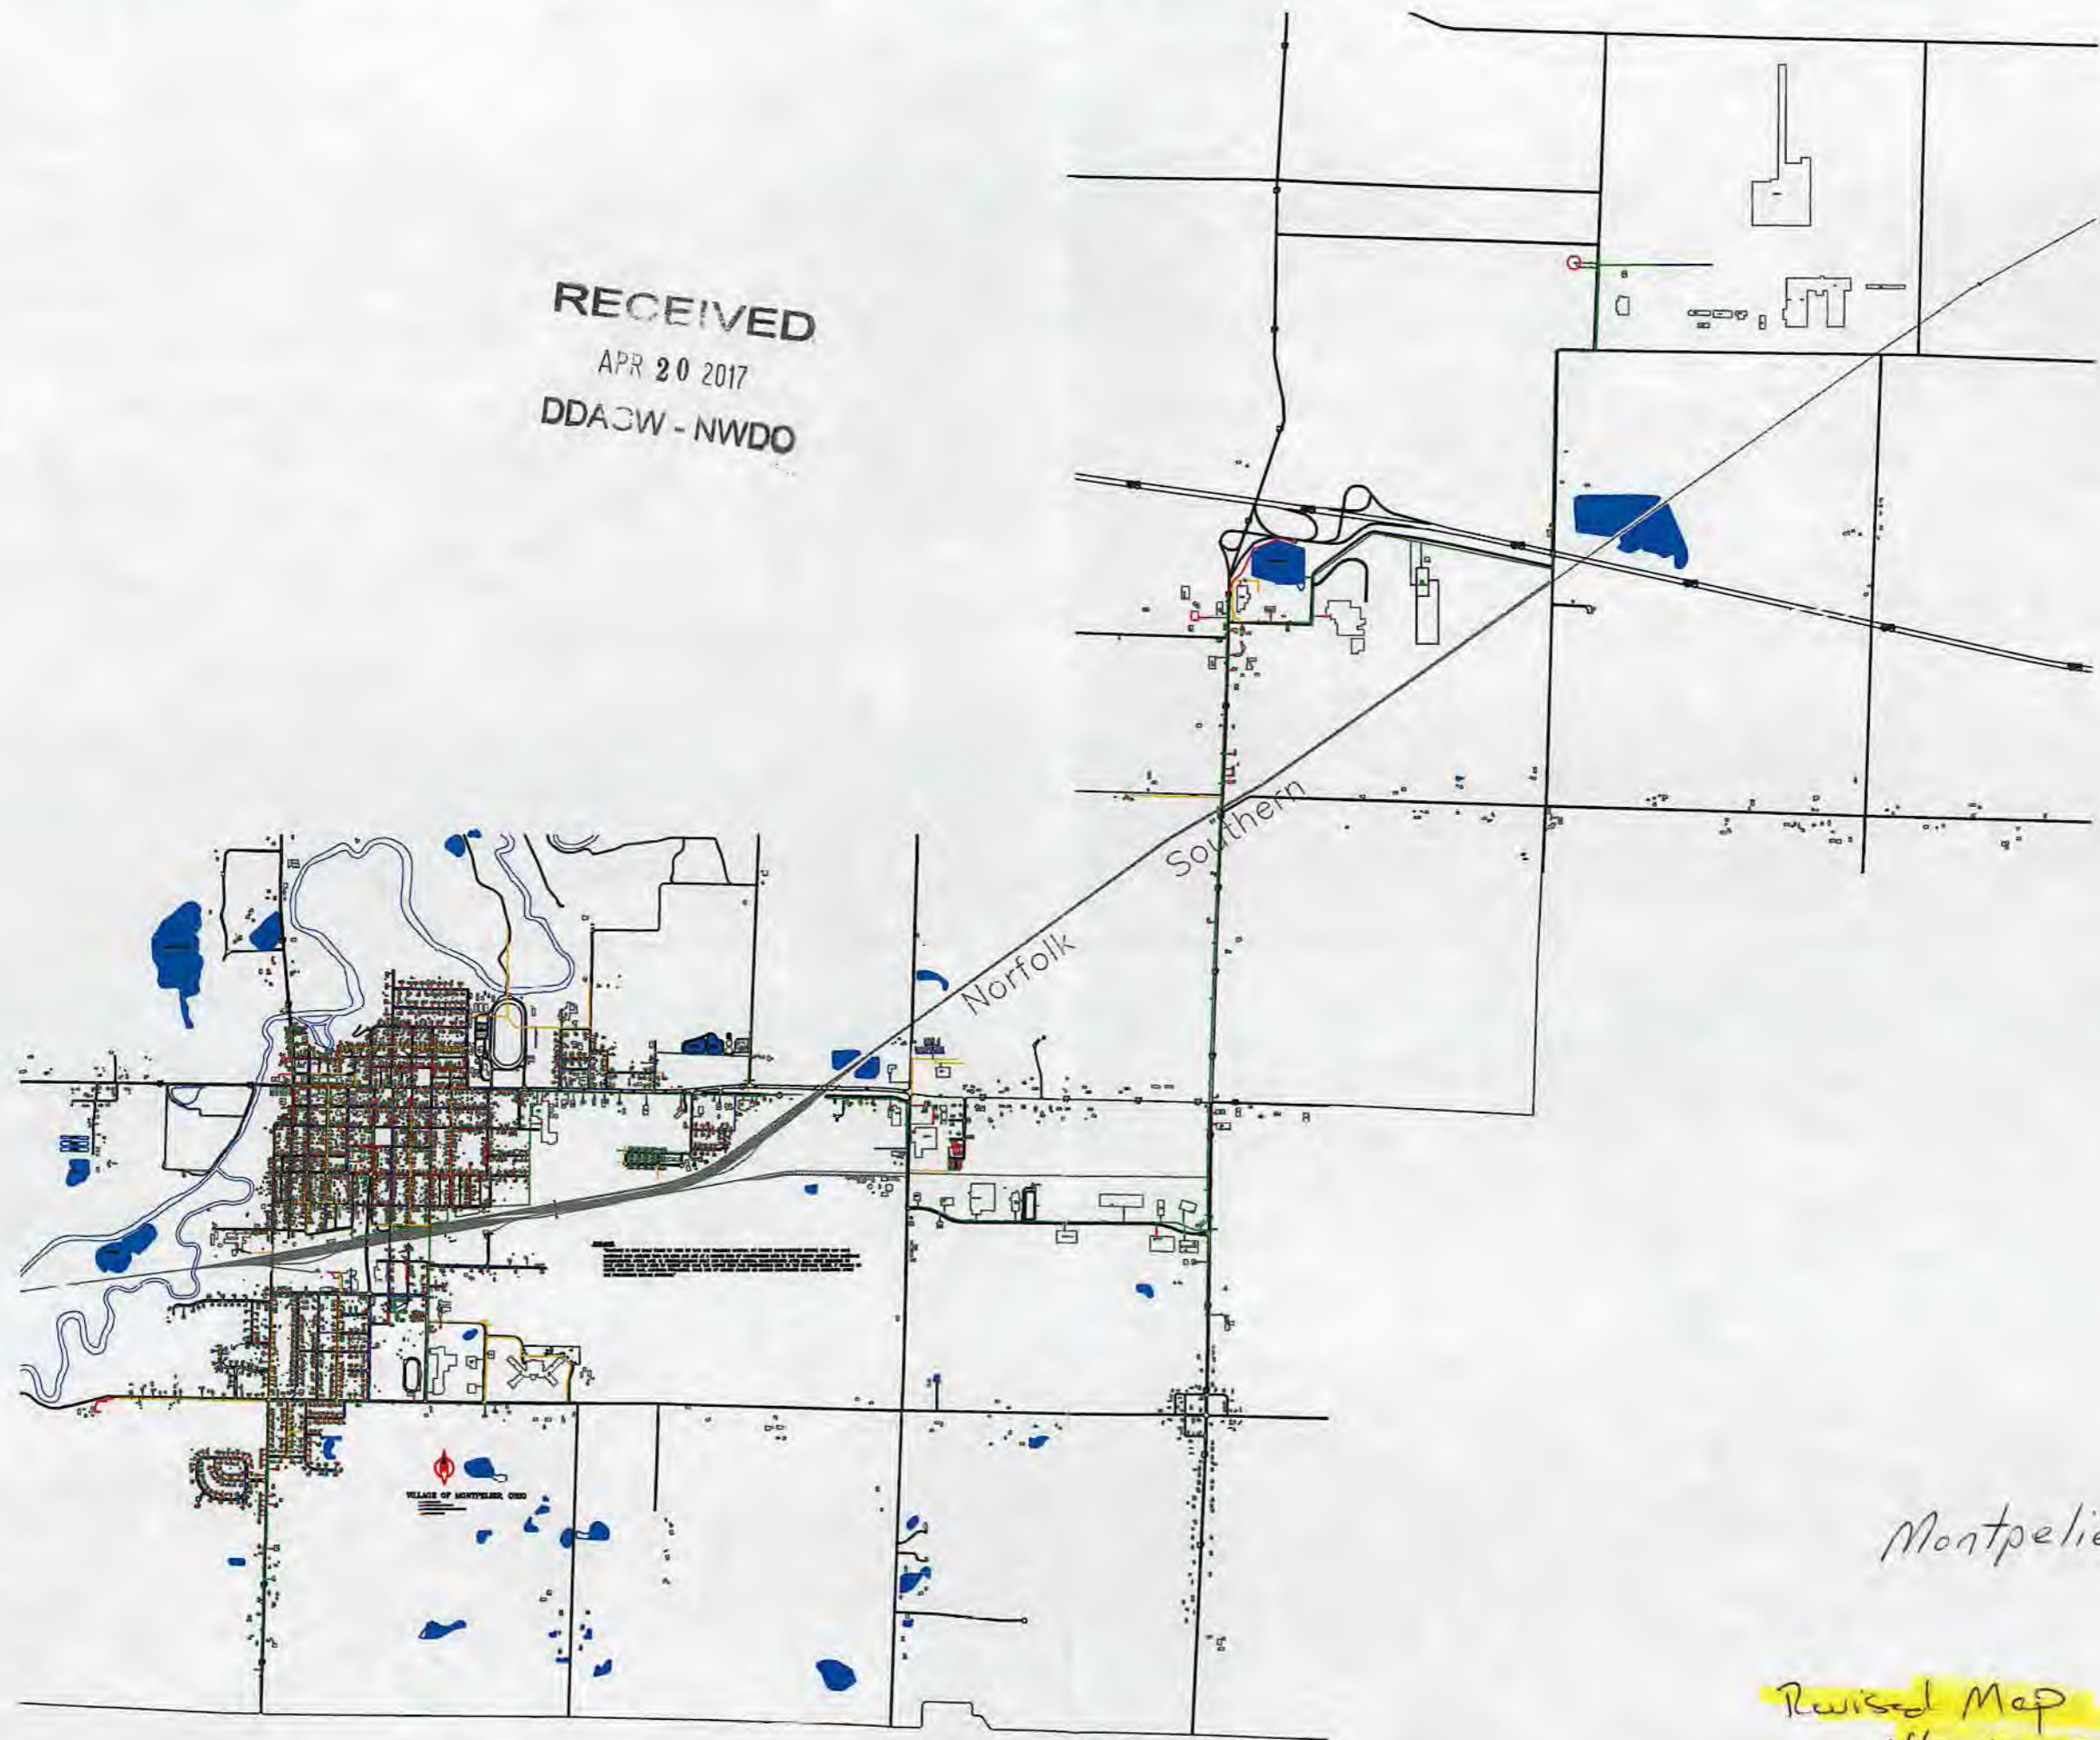

Montpelier Village

Revised Map  
4/20/2017