
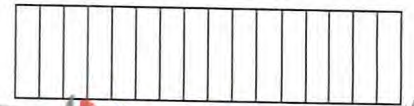


2nd FLOOR

Stairs to playground
←

Stairs to playground
←

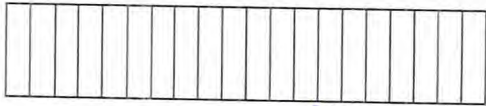

HOT + COLD FROM 1ST FLOOR

Furnace

w/c
LAVE

LAVE

w/c

Refuge

Kitchen Sink

HAND SINK

School Age Room 2

Stairs to Lower Level

KITCHEN SINK

4-5yr Room 2

4-5 yr Room 1


School Age Room 1

Vacant Room

Vacant Room

Vacant Room

Vacant Room

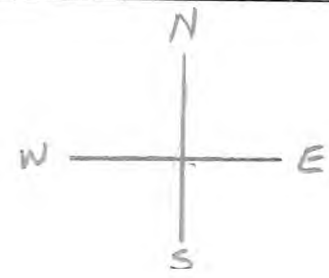




HOT WATER



COLD WATER

S. MAIN ST.

1ST FLOOR

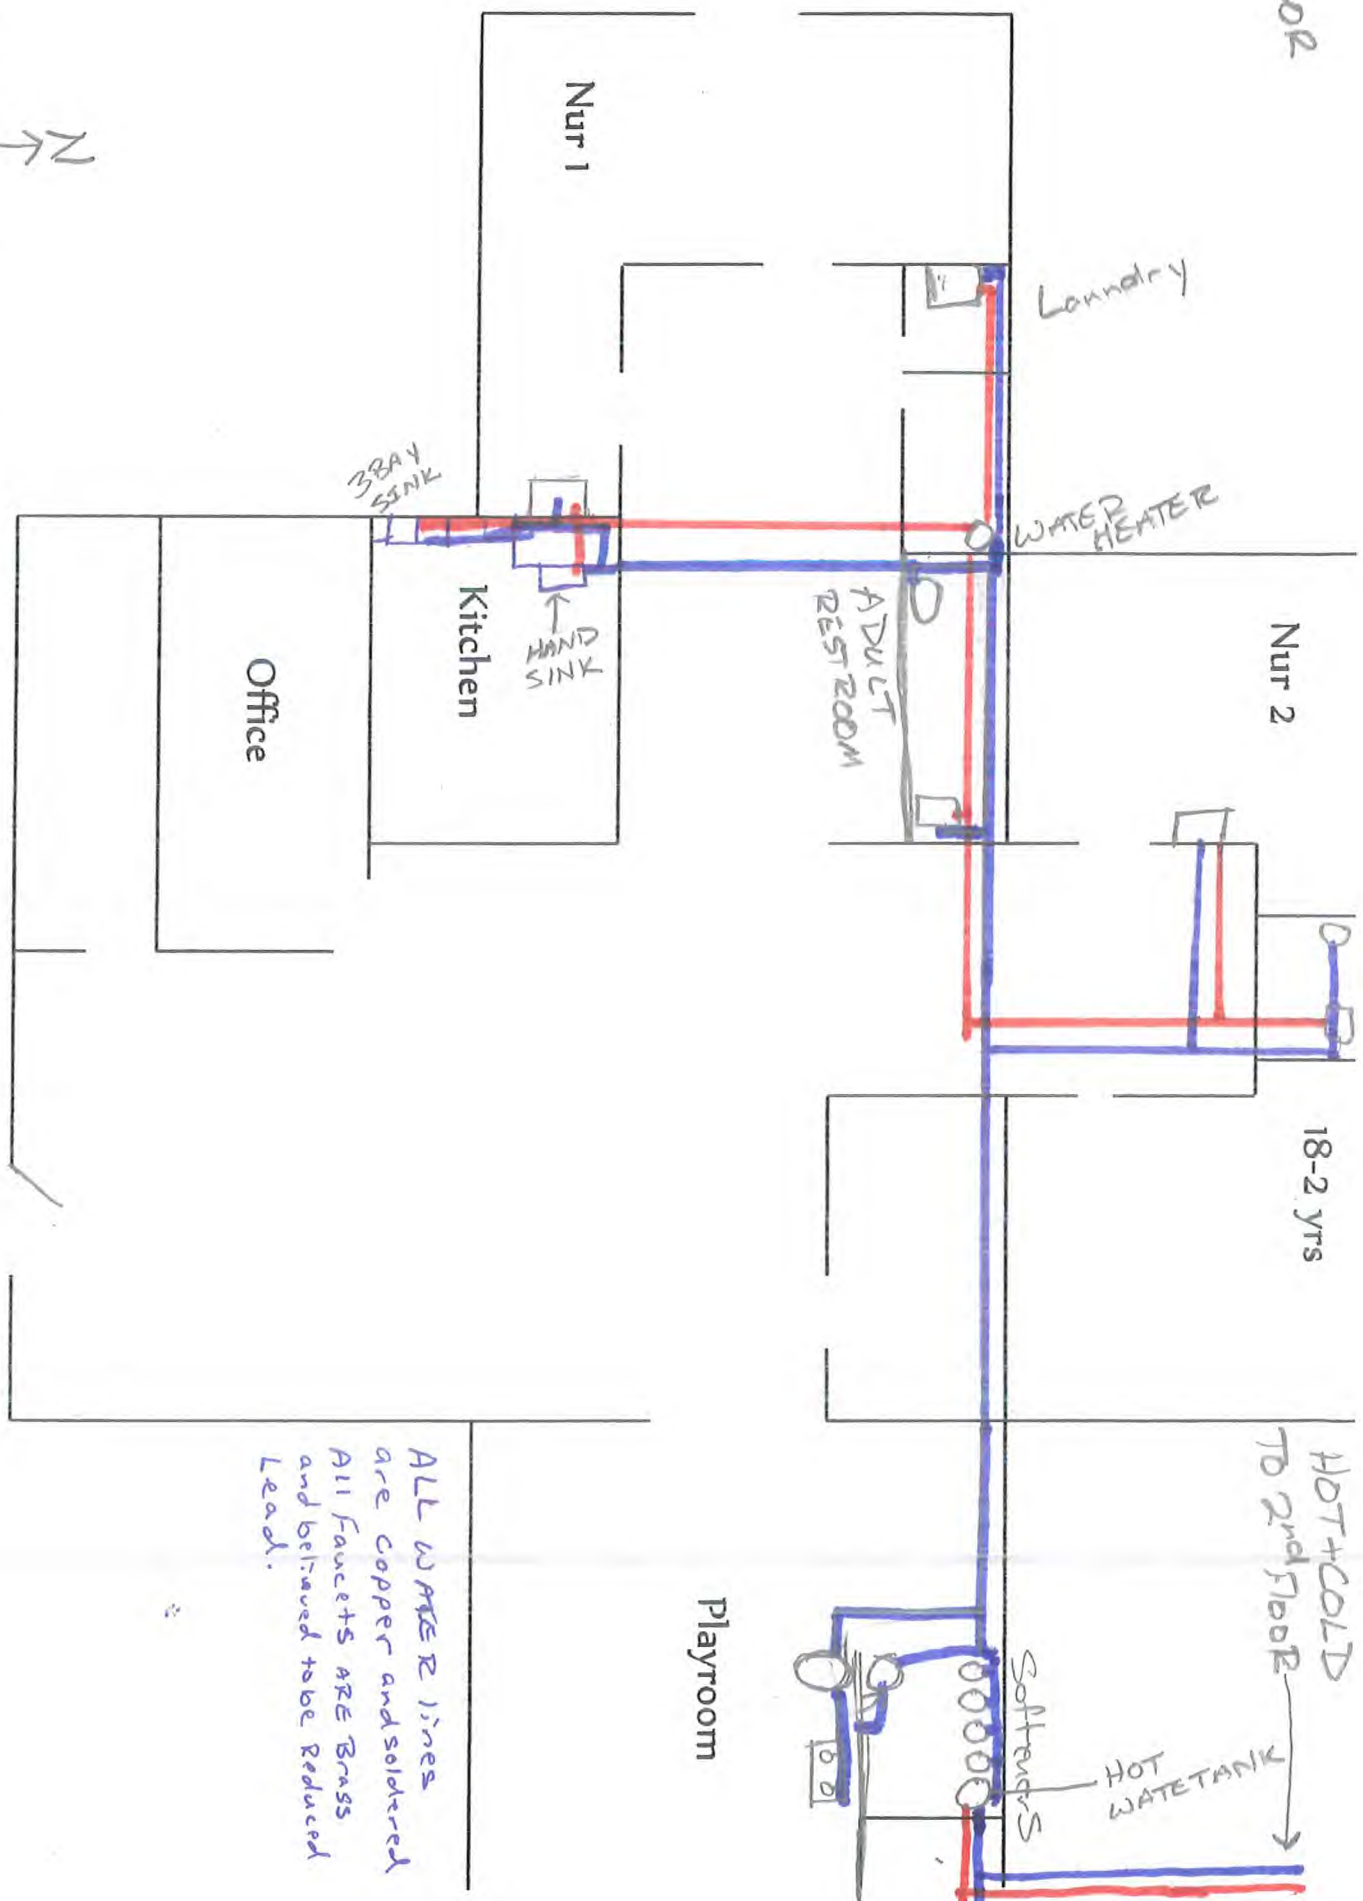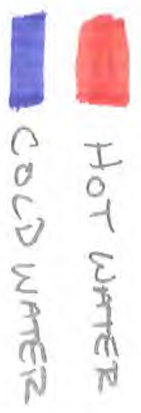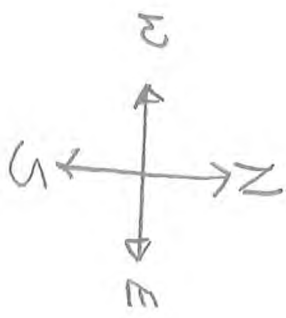

ALL WATER lines
are copper and soldered
All Facets are Brass
and believed to be Reduced
Lead.

Playroom

FRONT
ENTRANCE

1st Floor

