



Notre Dame Cathedral Latin School
Lead and Copper Report 2016
and Map




Ohio EPA

PWS ID #: 2841012

Operator of Record: Anthony M Bozeglav

Certification # : WS1-1009829-94

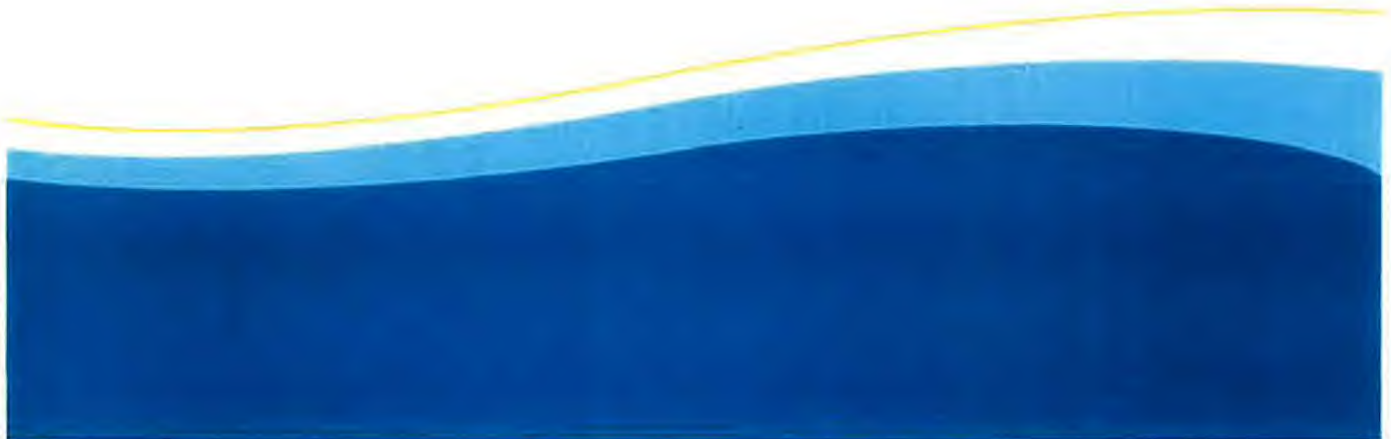


R/E PWS ID # OH2841012
 "Lead + Copper Sample Site Map"

FIRST FLOOR
NOTRE DAME-CATHEDRAL LATIN SCHOOL
 (IRN 053371)

13000 AUBURN RD CHARDON, OH 44024

School office 440 286 6226
 Principal 330 285 2945
 Dir of Maintenance 440 669 3029

Service Lines

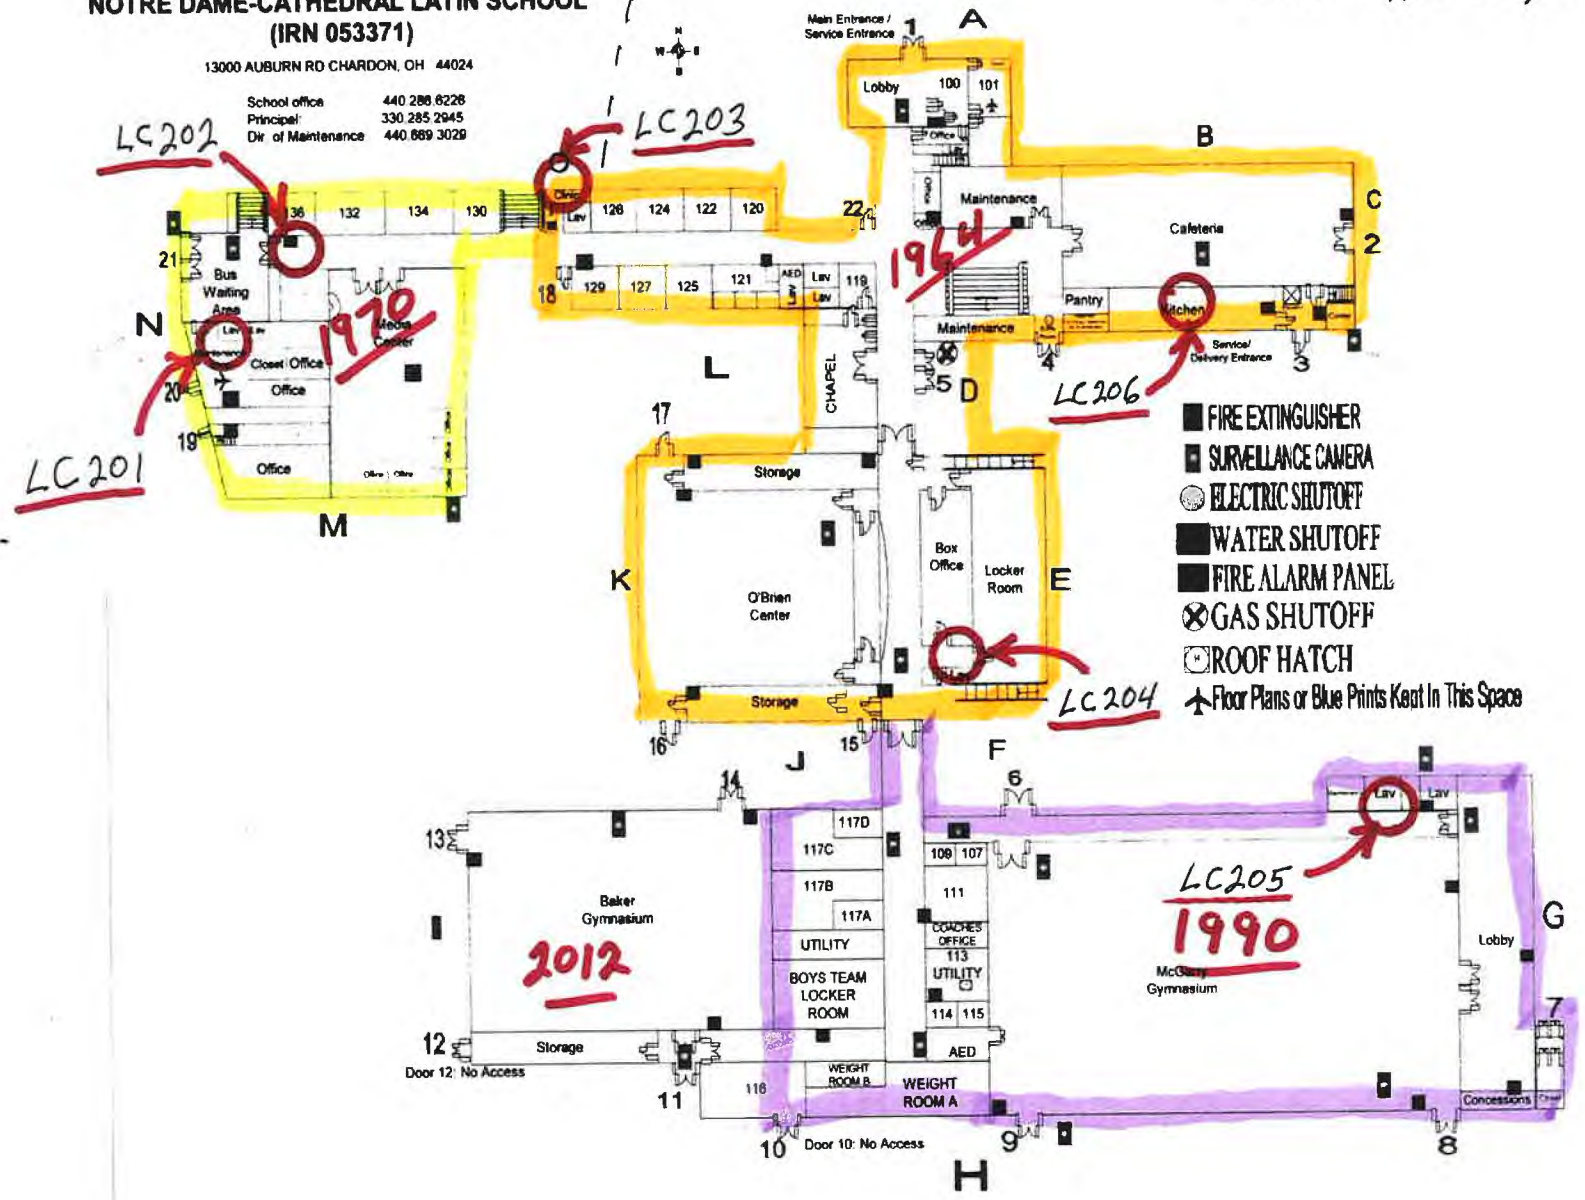

Floor Plans

Note: ALL Teir 2
 No lead service lines


R/E PWS ID# OH2841012
 "Lead + Copper Sample site map"

SECOND FLOOR

**NOTRE DAME-CATHEDRAL LATIN SCHOOL
 (IRN 053371)**

13000 AUBURN RD CHARDON, OH 44024

School office: 440.286.6226
 Principal: 330.285.2945
 Dir. of Maintenance: 440.669.3028

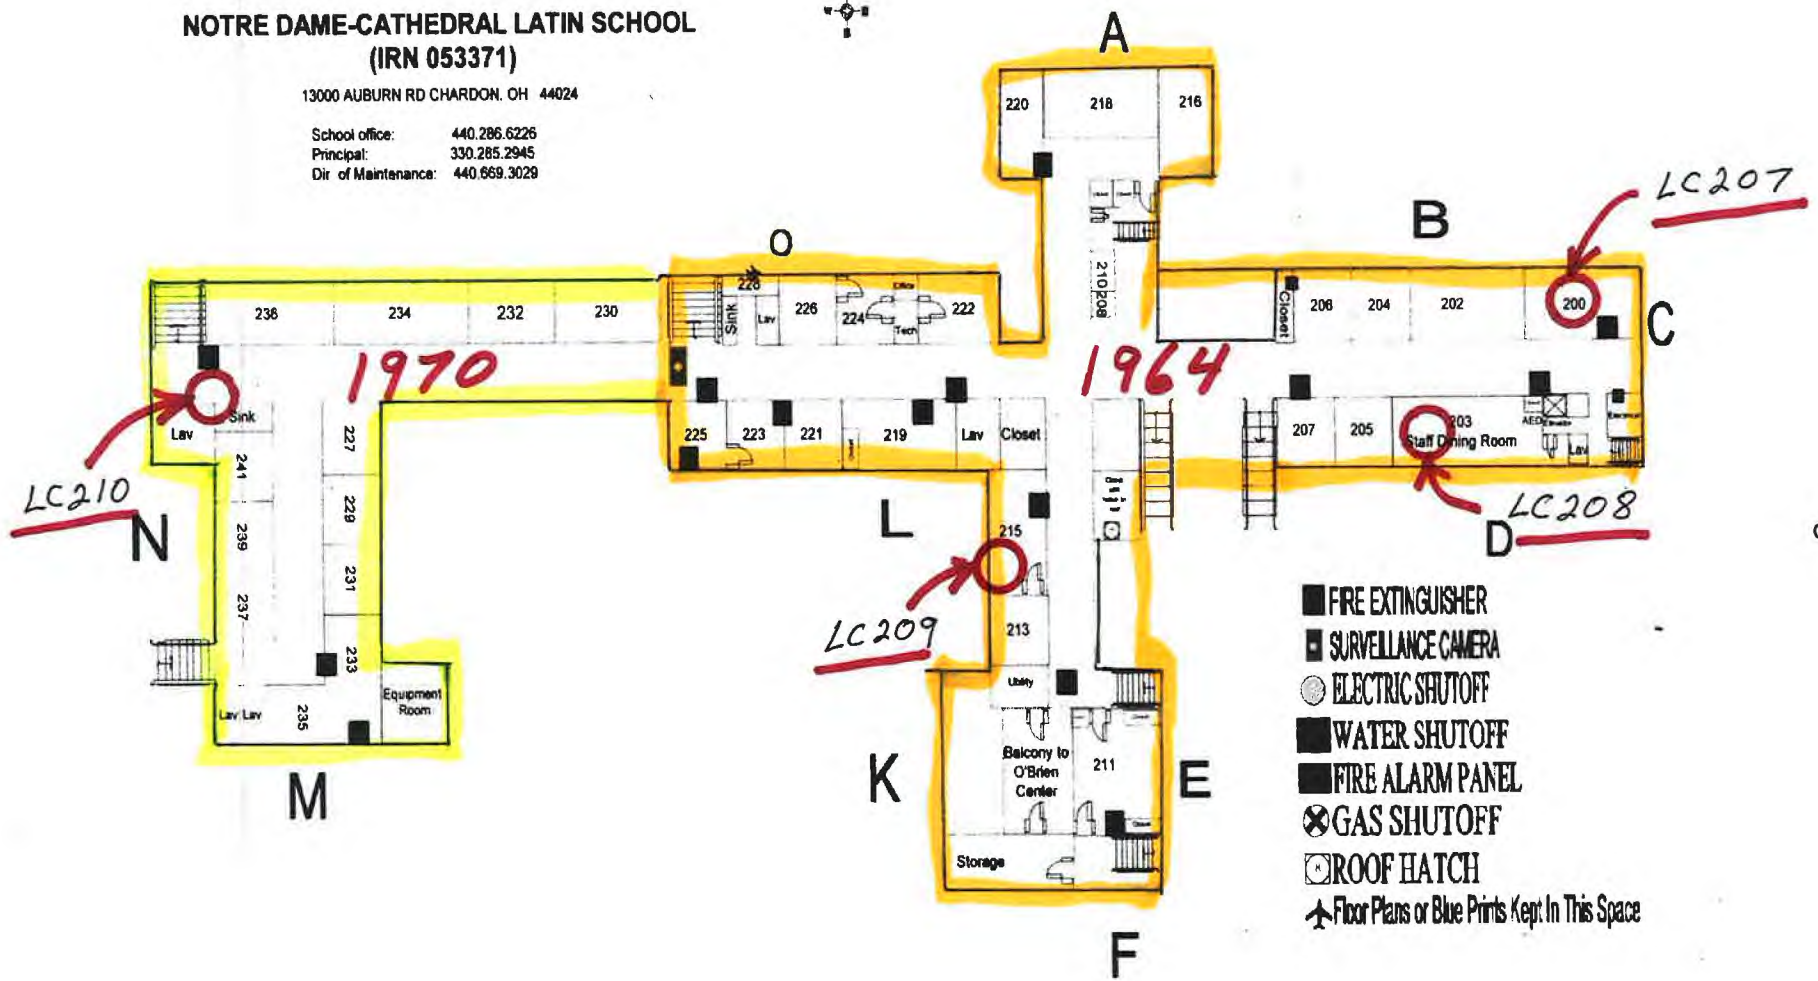

*Note: All Teir 2
 No Lead service lines*