


SUBJECT SITE: Ghent Square
PWS ID: OH7746912
843 N.Cleveland Massillon Rd.

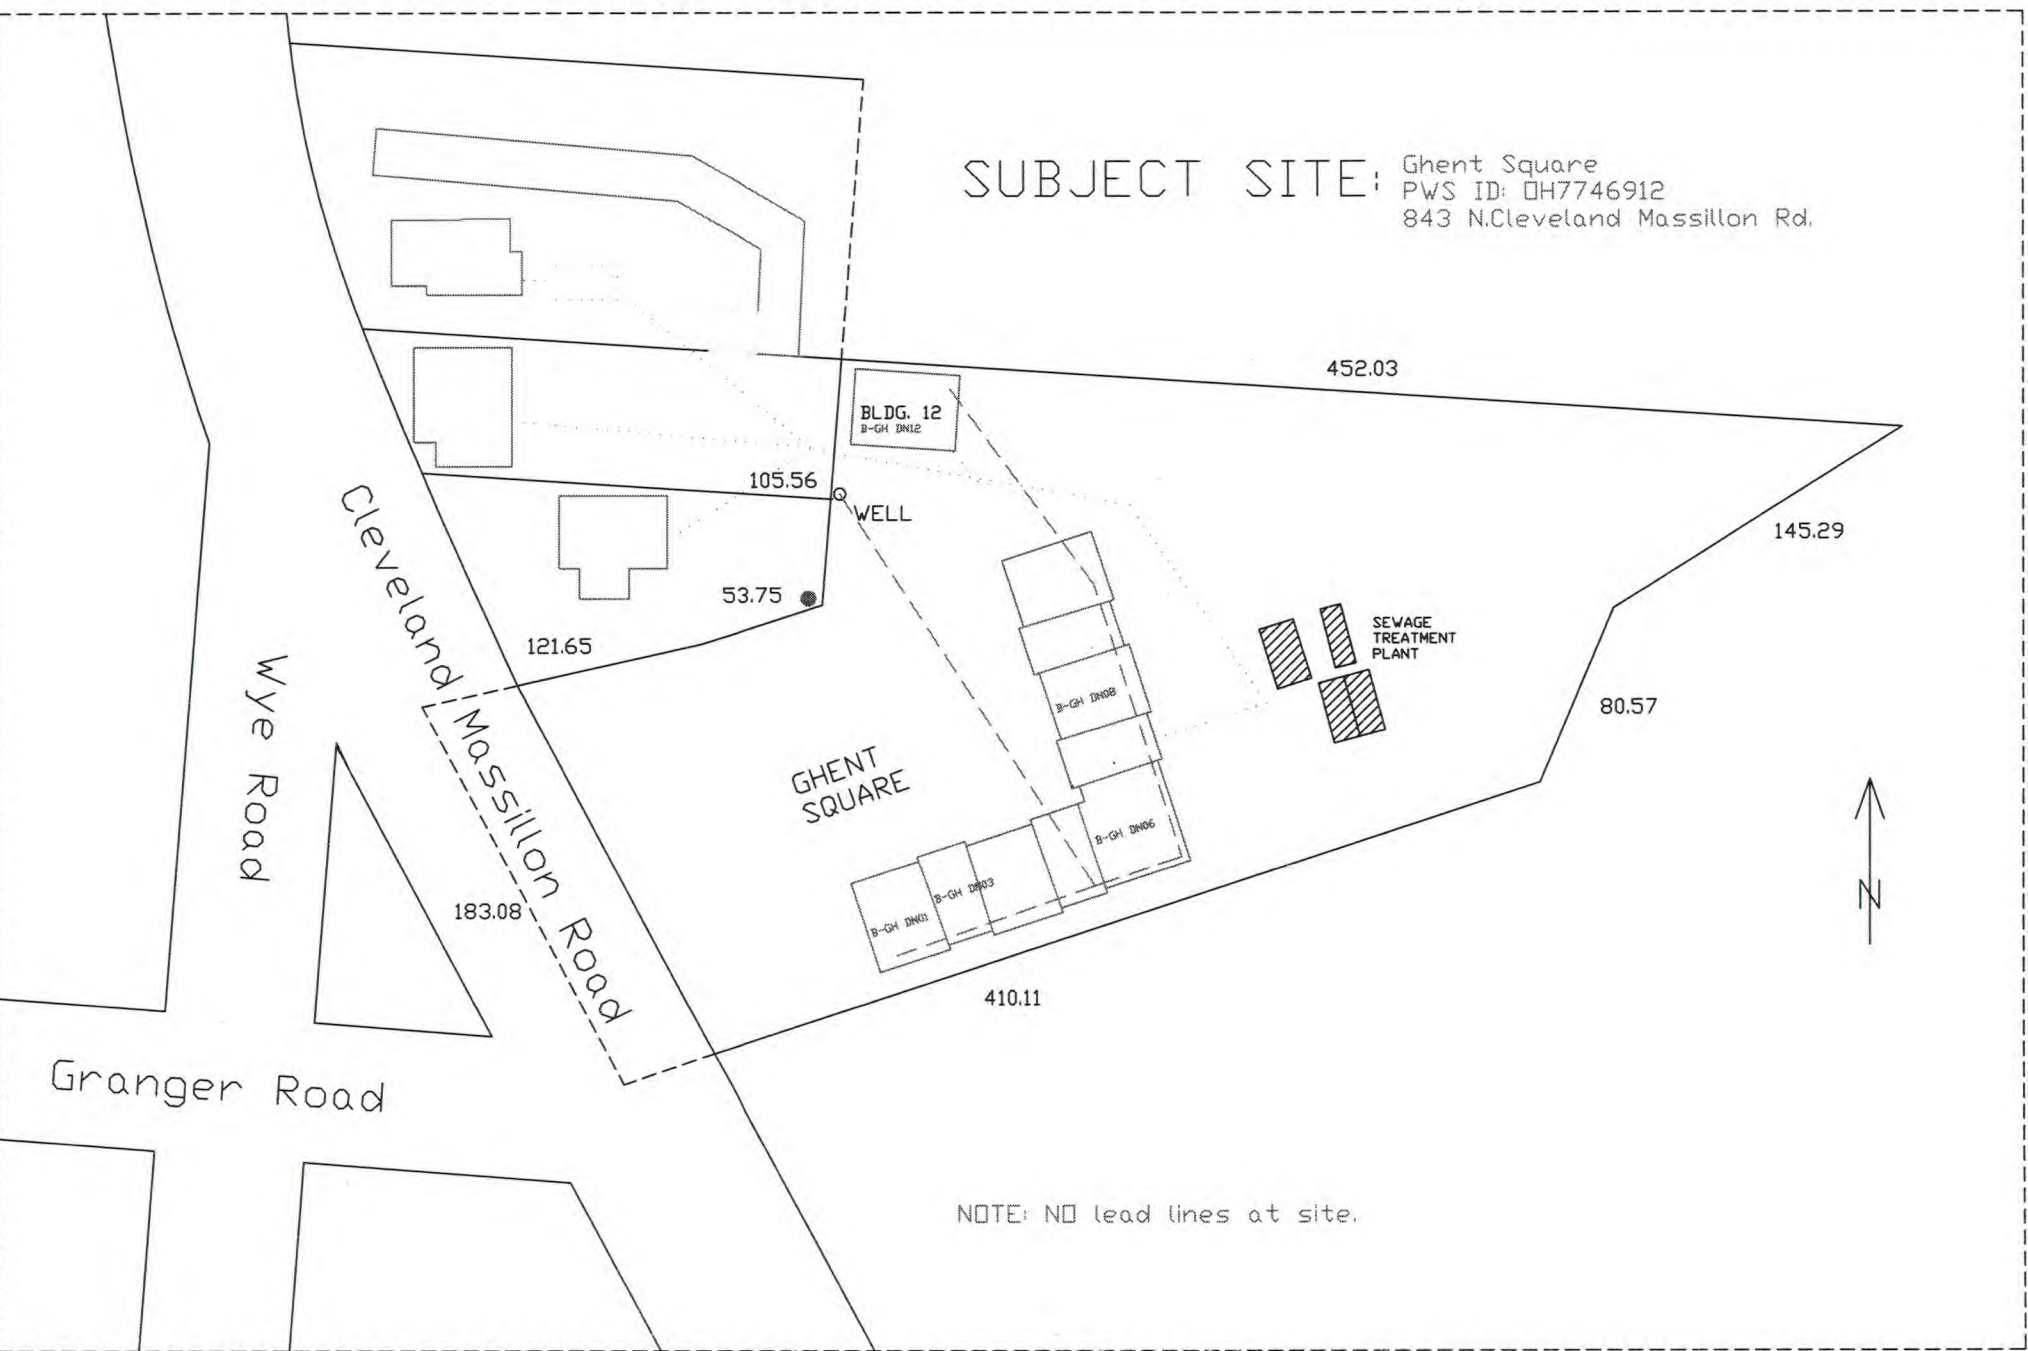

NOTE: NO lead lines at site.