

High Point Villas

3780 S VIONA DR
AKRON, OH 44319

FRONT VIEW

301	302	303	304	305	306	307	308
201	202	203	204	205	206	207	208
101	102	103	104	105	106	107	108

TOP VIEW

301	302	303	304	305	306	307	308


TOP VIEW 2ND FLOOR

201	202	203	204	205	206	207	208
-----	-----	-----	-----	-----	-----	-----	-----

TOP VIEW Bottom FLOOR

101	102	103	104	Mechanical Room & LAUNDRY	106	107	108
-----	-----	-----	-----	---------------------------	-----	-----	-----

TYPICAL LAYOUT for All units

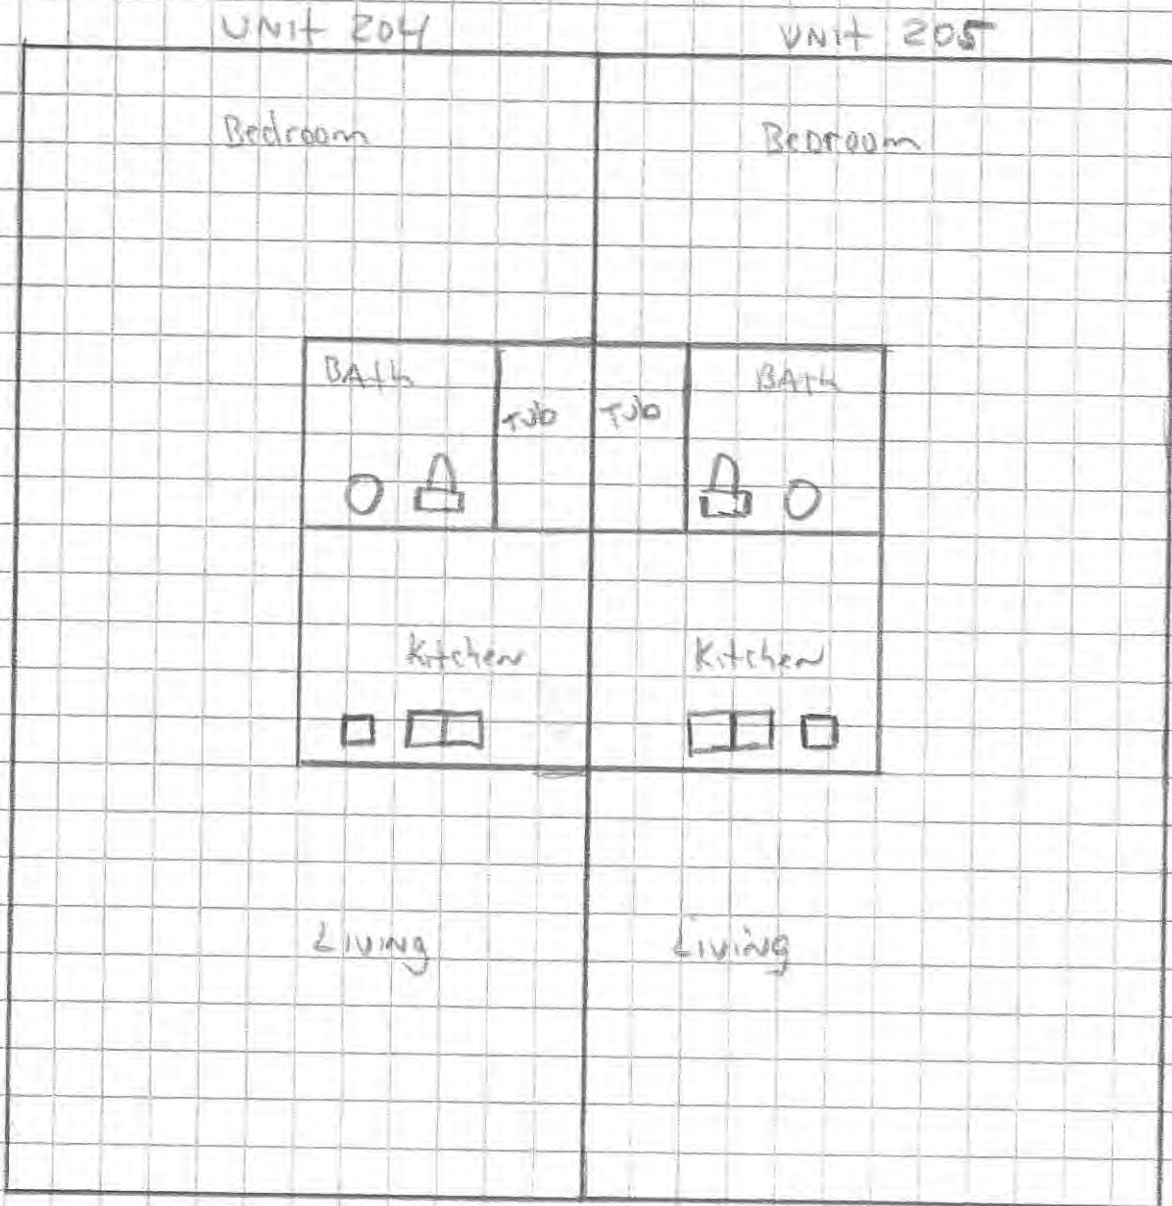

☐☐ = Kitchen Sink

☐ = Dishwasher


☐ = Toilet

○ = BATH SINK

All LINES Copper / NO KNOWN LEAD
Fixtures Are Bronze or plastic

Mechanical Room & LAUNDRY

Unit 105

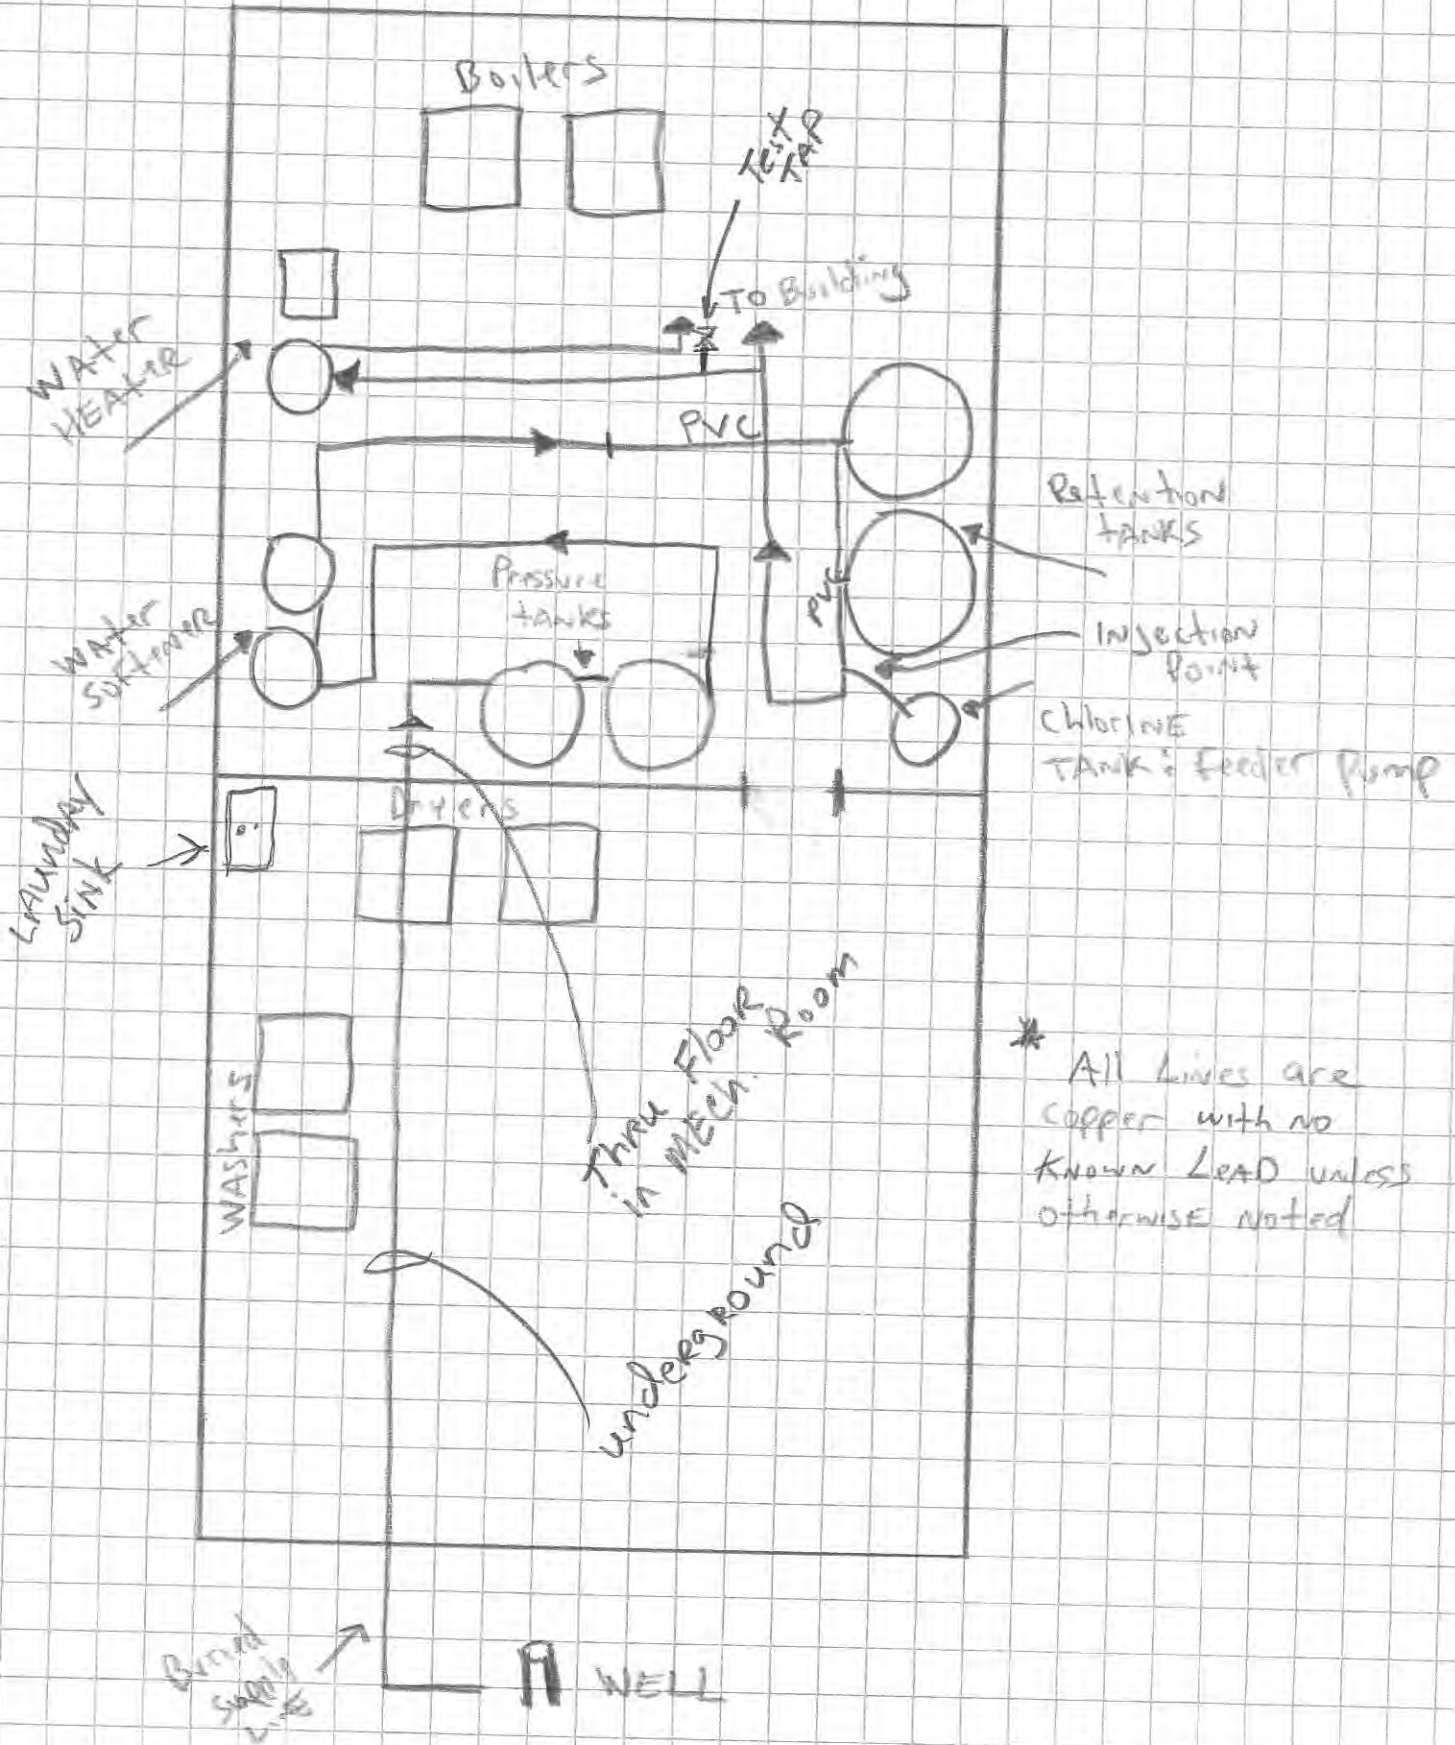

High Point Villa Apartments
Lead Mapping Narrative

Polyethylene tubing from the well into mechanical room then turns to copper tubing, at retention tanks material is PVC. Then after retention tanks goes back to copper tubing.

Jeff Nathaniel
Portage Lakes Investments
High Point Villas
330-715-3532

VERIFICATION FORM FOR COMMUNITY PUBLIC WATER SYSTEMS CLAIMING NO LEAD SERVICE LINES

Systems must also submit a report to the director containing at least both of the following: (1) The applicable map with narrative, and (2) A list of sampling locations used to collect samples as required by Ohio Revised Code (ORC) Section 6109.121 and any rules adopted thereunder, including contact information for the owner and occupant of each sampling site.

Should a water system determine no lead service lines exist in their distribution system, they must provide information stating they reviewed, at the minimum, historical permit records and local ordinances, distribution maintenance records and information pertaining to installation dates or materials for all services lines. This information must be verified below.

I HEREBY CERTIFY THAT THE FOLLOWING METHOD(S) WERE USED TO DETERMINE NO LEAD SERVICE LINES EXIST IN THIS WATER SYSTEM'S DISTRIBUTION SYSTEM, AS REQUIRED BY ORC 6109.121(F):

LEAD SERVICE LINE VERIFICATION
<p>This PWS states they have no lead service lines and has reviewed the following information (select one or more of the following):</p> <ul style="list-style-type: none"> <input type="checkbox"/> Historical permit records and/or local ordinances <input type="checkbox"/> Distribution maintenance records (i.e. meter replacement, waterline break repairs) <input checked="" type="checkbox"/> Information pertaining to installation dates for all service lines (i.e. after 1986 when lead services lines were banned) <input type="checkbox"/> Service line material of all service lines is known (i.e. all service lines are known to be PVC)

Jeff Nathaniel 3-2-17
 Signature of Responsible Person Date
JEFF NATHANIEL, OWNER
 Printed Name and Title of Responsible Person

PWS NAME: High Point Villa Apartments
PWS ID: OH 7709012
COUNTY: Summit

<p>For Ohio EPA use only:</p> <p>Date Verification Rec'd: _____</p>
--