

4

From: Green Meadows Health and Wellness center
7770 Columbus Rd. N. E.
Louisville, Ohio 44641
OH7605212
STU7658308

To: OEPA , ODH, and ODJFS

RE: Lead copper

Green Meadows Health and Wellness Center is a nursing home located on Columbus rd. in Louisville, Ohio. The water supply is provided by two wells located in the parking of the nearby Facility (Molly Stark Hospital) *Note: the Molly Stark facility is currently closed and is no longer provided with water from our system.* There are no known sources of lead. All previous testing for lead & copper have tested below Maximum Contaminate Levels. Our supply lines consist of Black pipe and or cast iron ductile supply pipe

If more information is needed please contact me at 330-875-1456 ext. 236 or email at rbarrett@greenmeadowscarecenter.com

See enclosed site map and a list of our sampling locations.

Thank you


Randy L. Barrett

Entity: Green Meadows Health & Wellness
Doc Type: Report
Doc Subtype: _____
Program: DPAGW
County: Stark
Secondary ID: OH7605212
EDOC in color

RECEIVED

MAR 02 2017

OHIO EPA NEDO

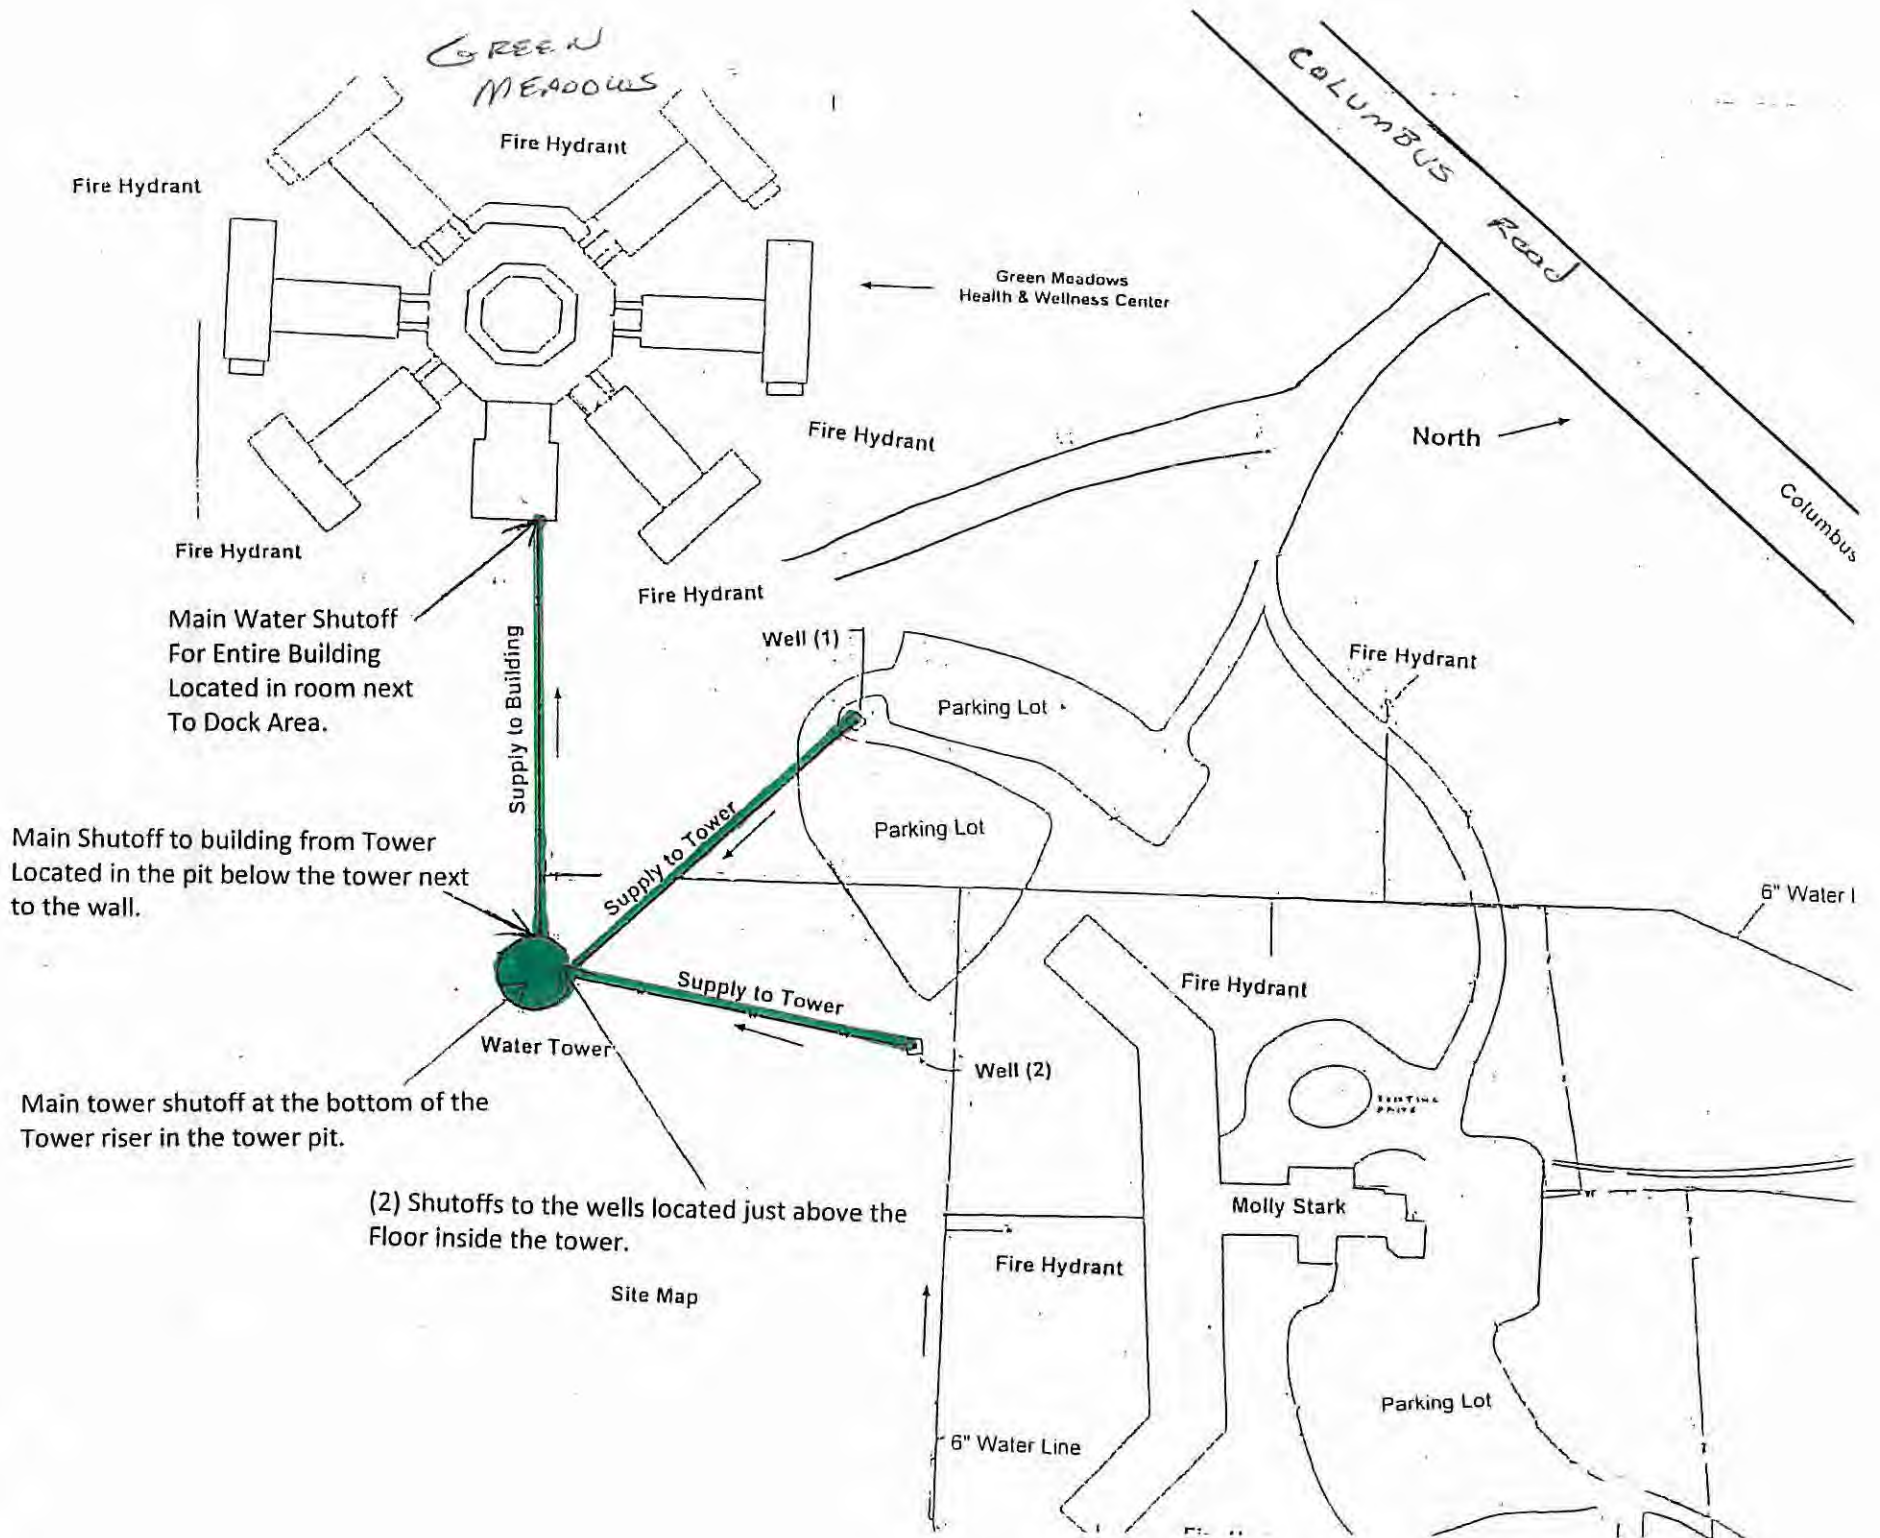

Fire Hydrant

GREEN MEADOWS

Fire Hydrant

Green Meadows Health & Wellness Center

Fire Hydrant

North

COLUMBUS Road

Columbus

Fire Hydrant

Main Water Shutoff For Entire Building Located in room next To Dock Area.

Fire Hydrant

Well (1)

Parking Lot

Fire Hydrant

Main Shutoff to building from Tower Located in the pit below the tower next to the wall.

Supply to Building

Supply to Tower

Parking Lot

6" Water Line

Water Tower

Supply to Tower

Fire Hydrant

Main tower shutoff at the bottom of the Tower riser in the tower pit.

Well (2)

(2) Shutoffs to the wells located just above the Floor inside the tower.


Site Map

Molly Stark

Fire Hydrant

Parking Lot

6" Water Line

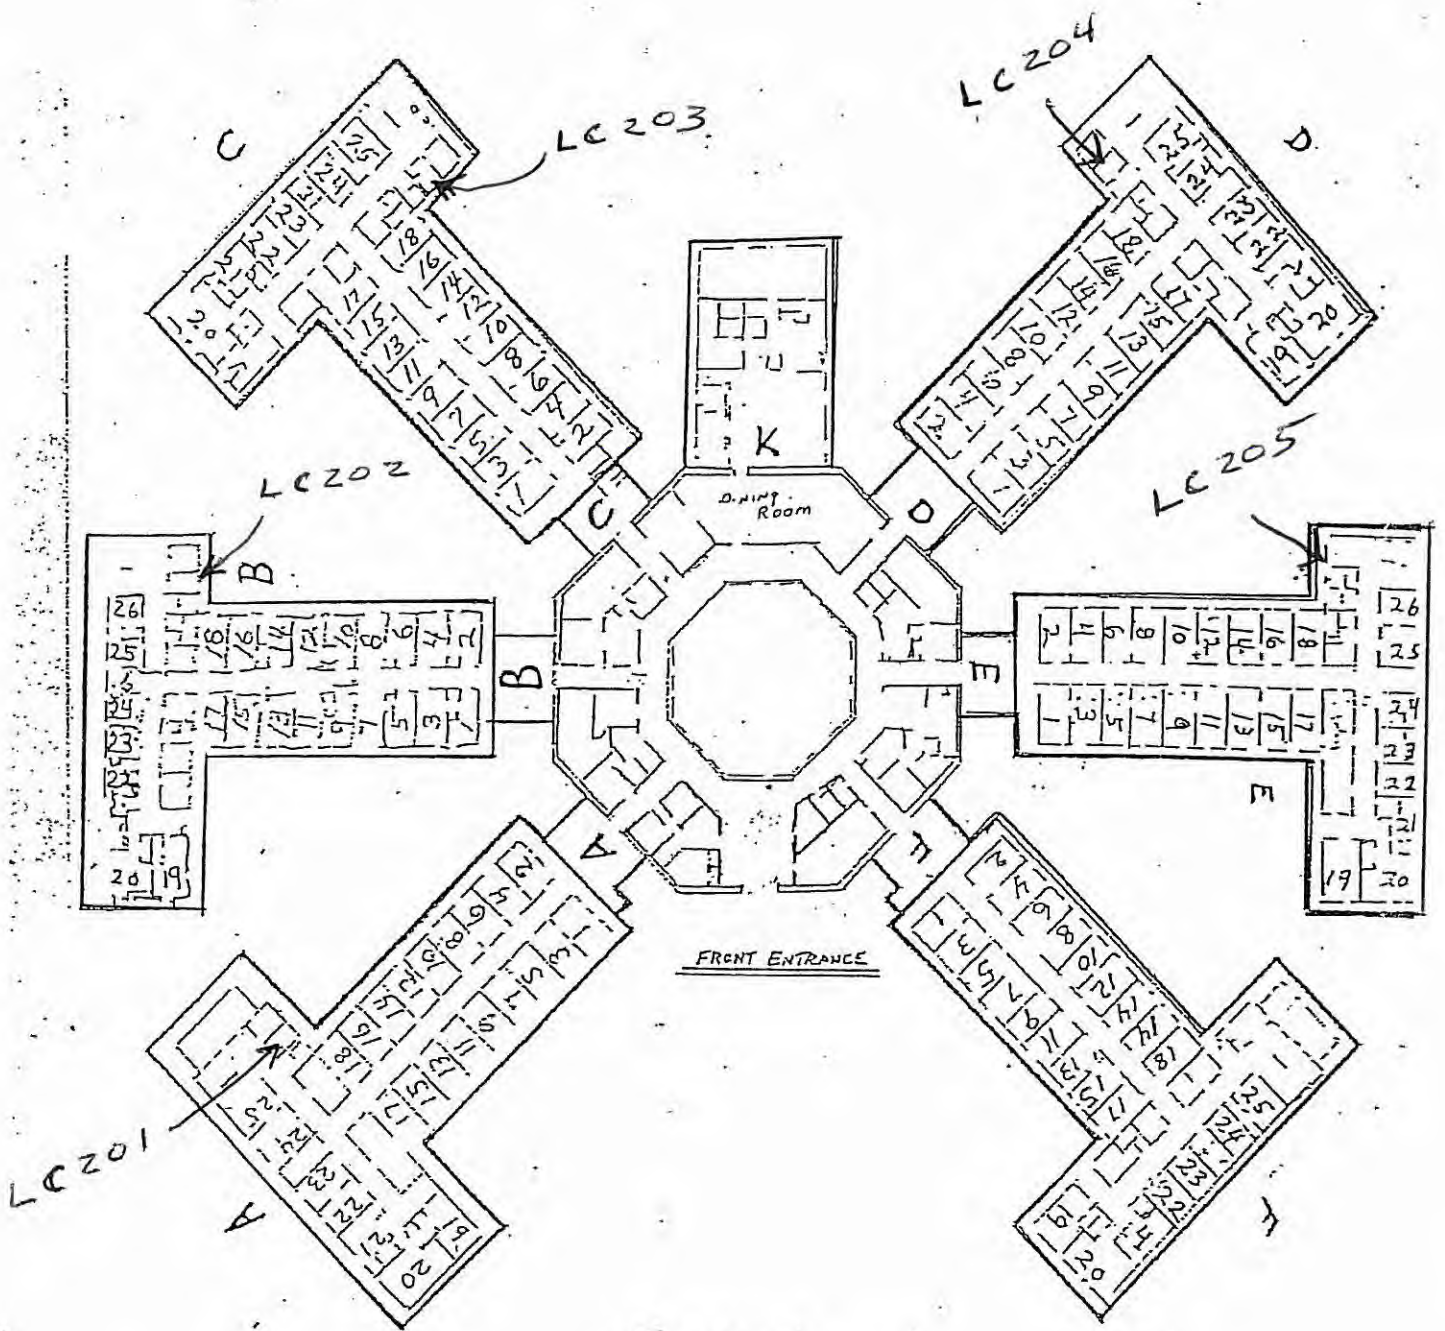

GREEN
MEADOWS