


PRIVATE DRIVE
E DRIVE

KOHLER ROAD



Entity: Eastwood MFG
 Doc Type: ASSET
 Doc Subtype: DRG
 Program: WAVE
 County: WYOMING
 Secondary ID: 016516316

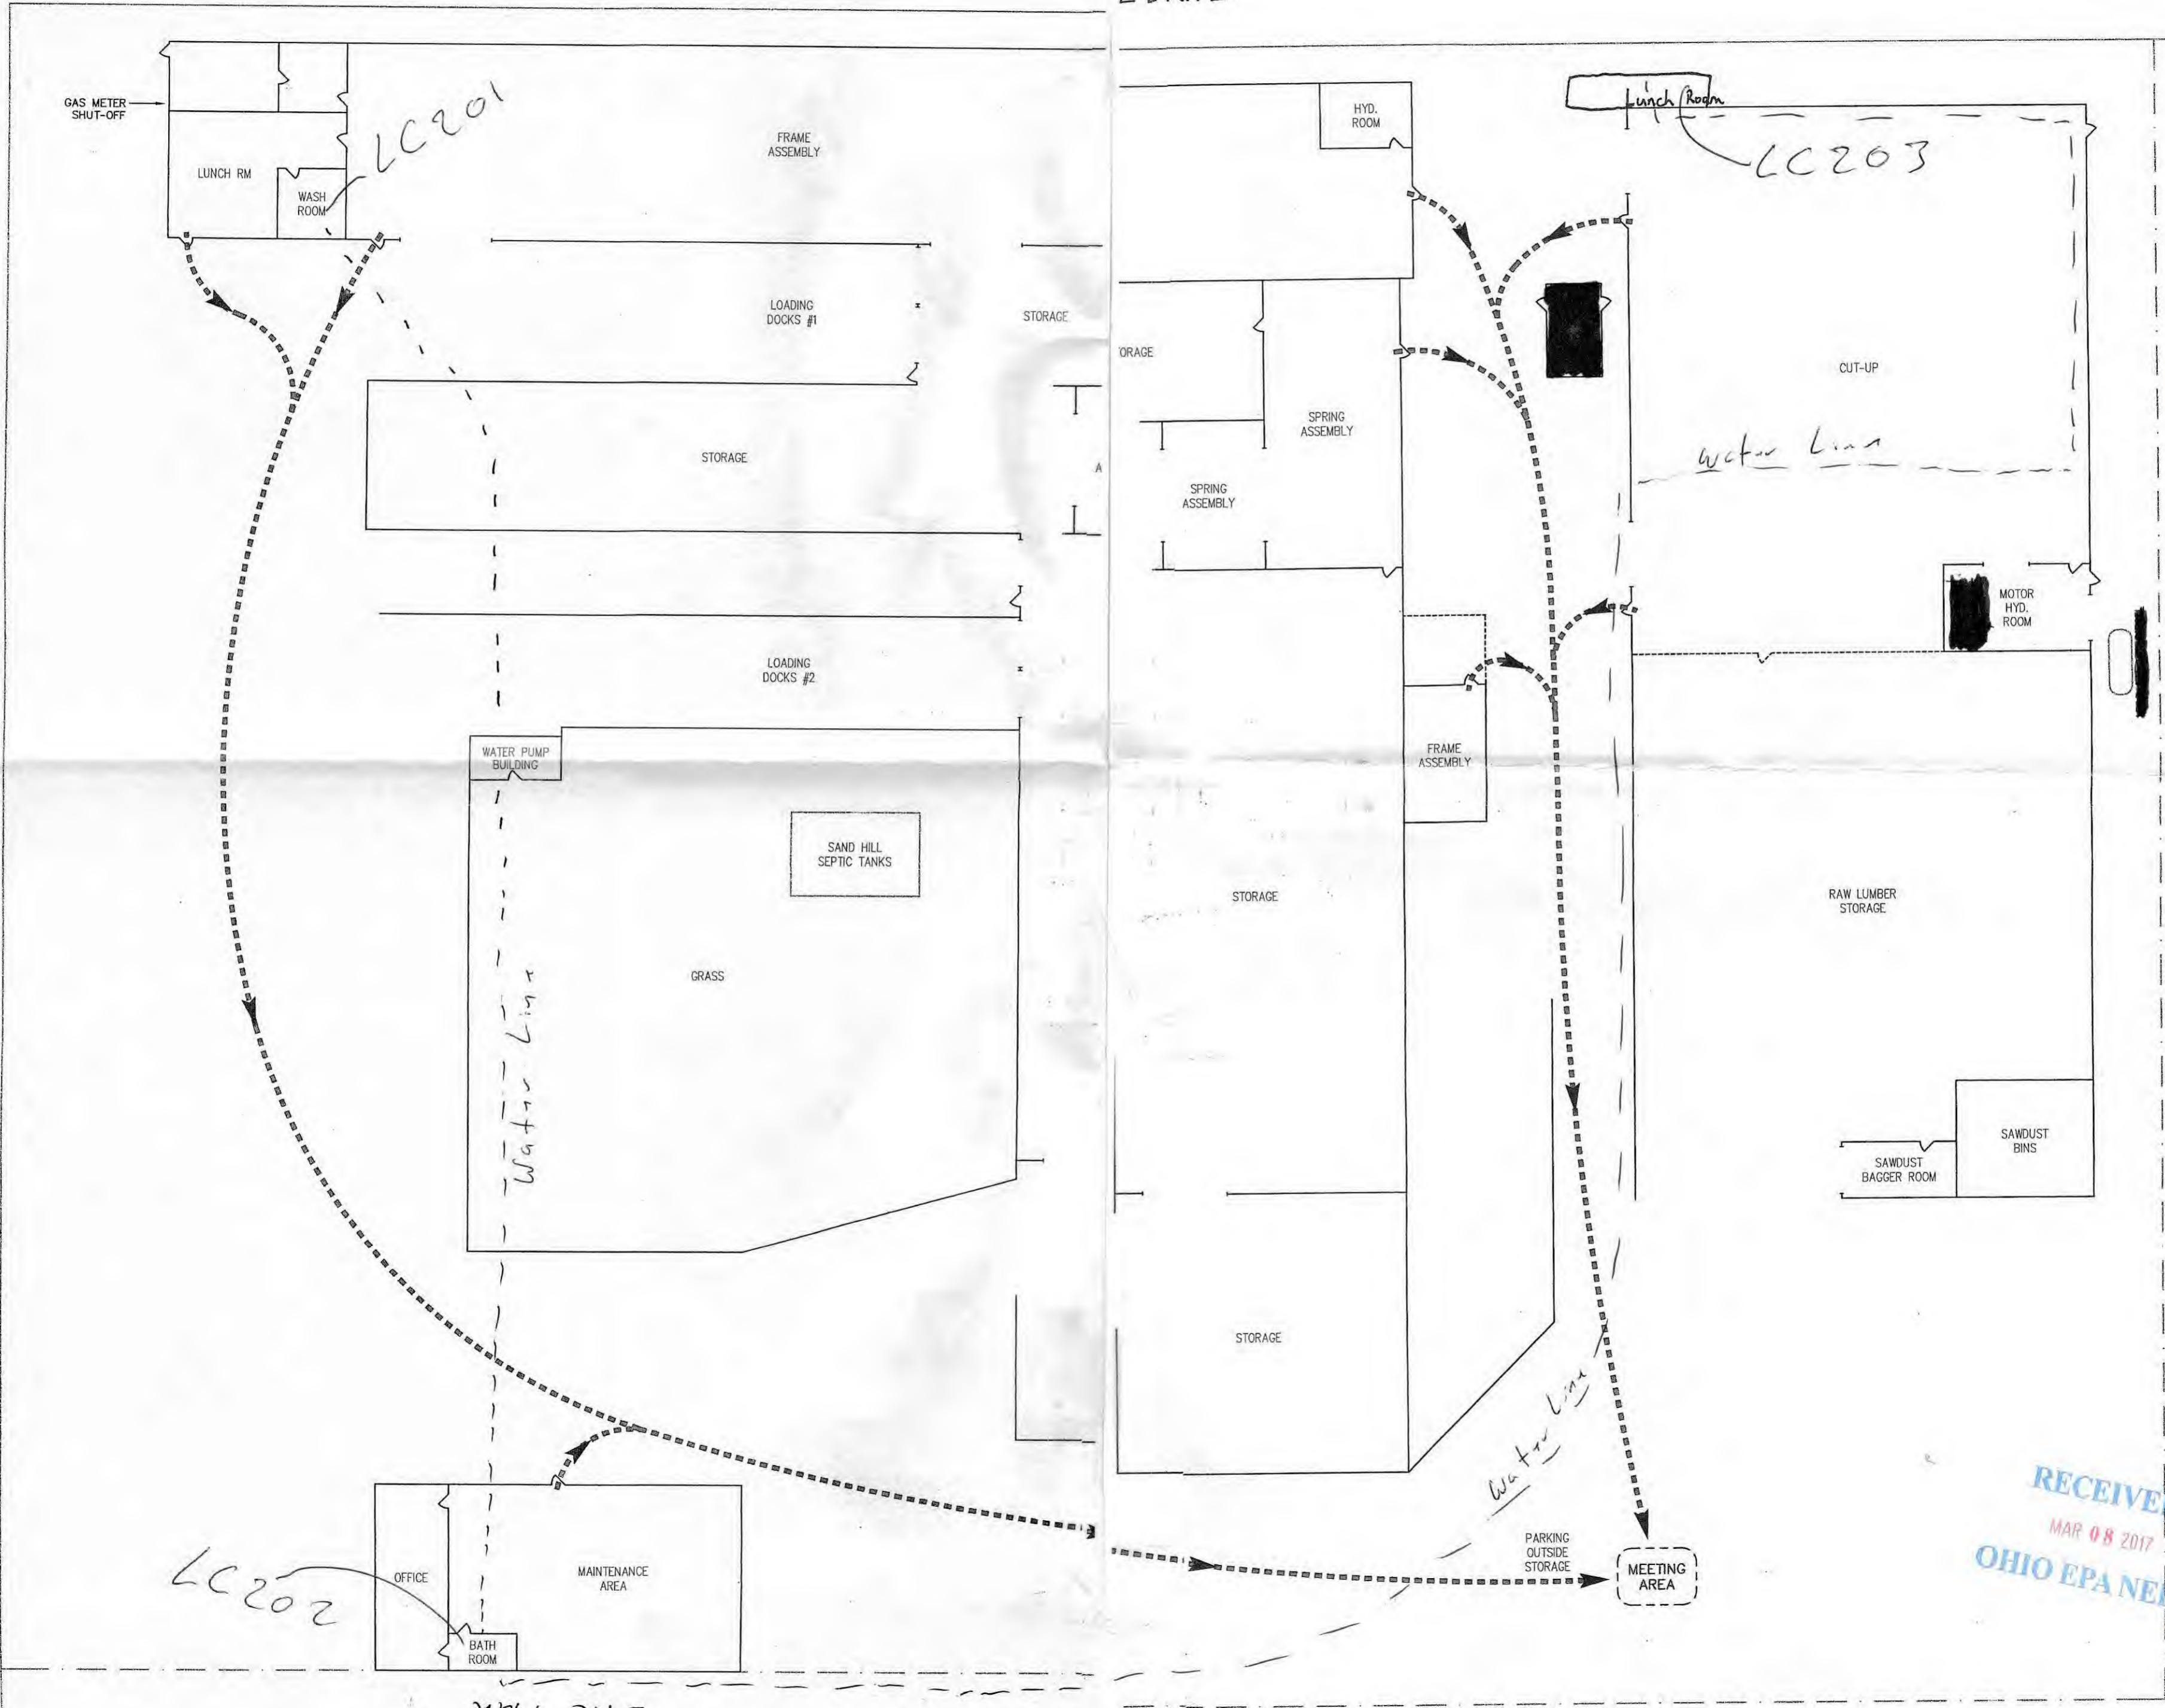

RECEIVED
 MAR 08 2017
 OHIO EPA NEDO

LC202

Site Plan