


Bath Elementary School – Revere Local School District  
1246 N Cleveland Massillon Rd. Akron, Ohio 44333 (330)-523-3802


1952 Addition 1<sup>st</sup> Floor A-wing – East – Built Prior to 1998- PROBABLE  
1967 Addition 1<sup>st</sup> Floor B-wing – West – Built Prior to 1998- PROBABLE

East – Cleveland-Massillon Road

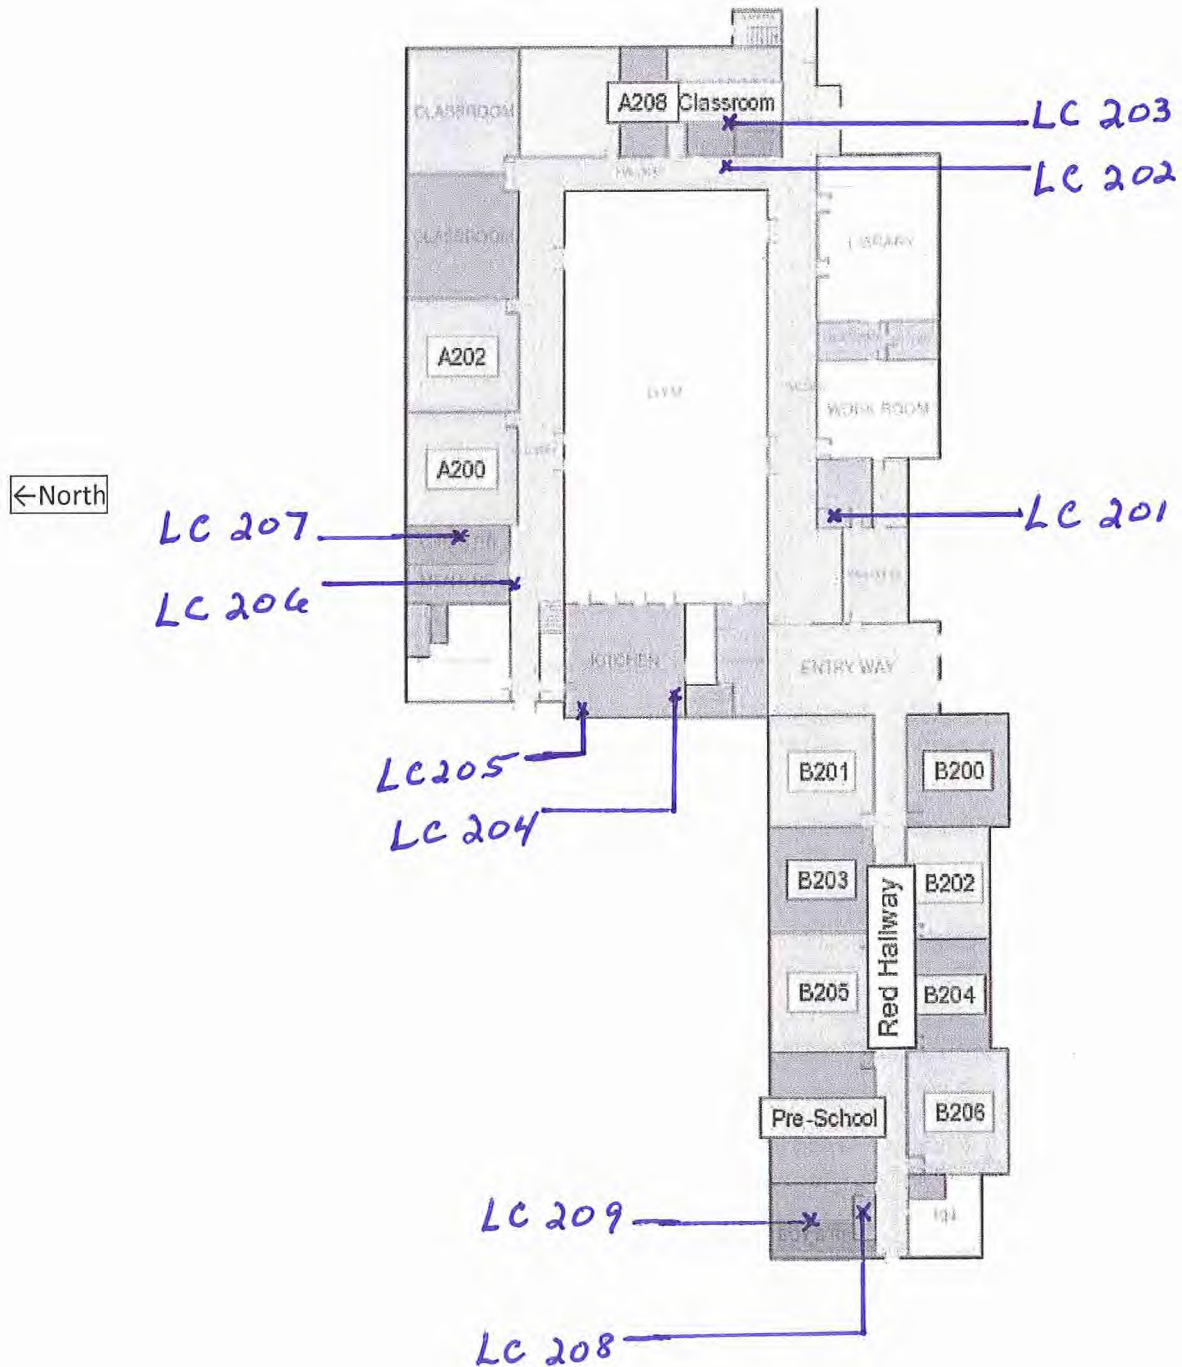


Bath Elementary School – Revere Local School District  
1246 N Cleveland Massillon Rd. Akron, Ohio 44333 (330)-523-3802

1952 Addition Basement Floor A-wing – Built Prior to 1998- PROBABLE  
1923 Original Building: includes Boiler-Mechanical-Storage Rooms -Built Prior to 1998 PROBABLE

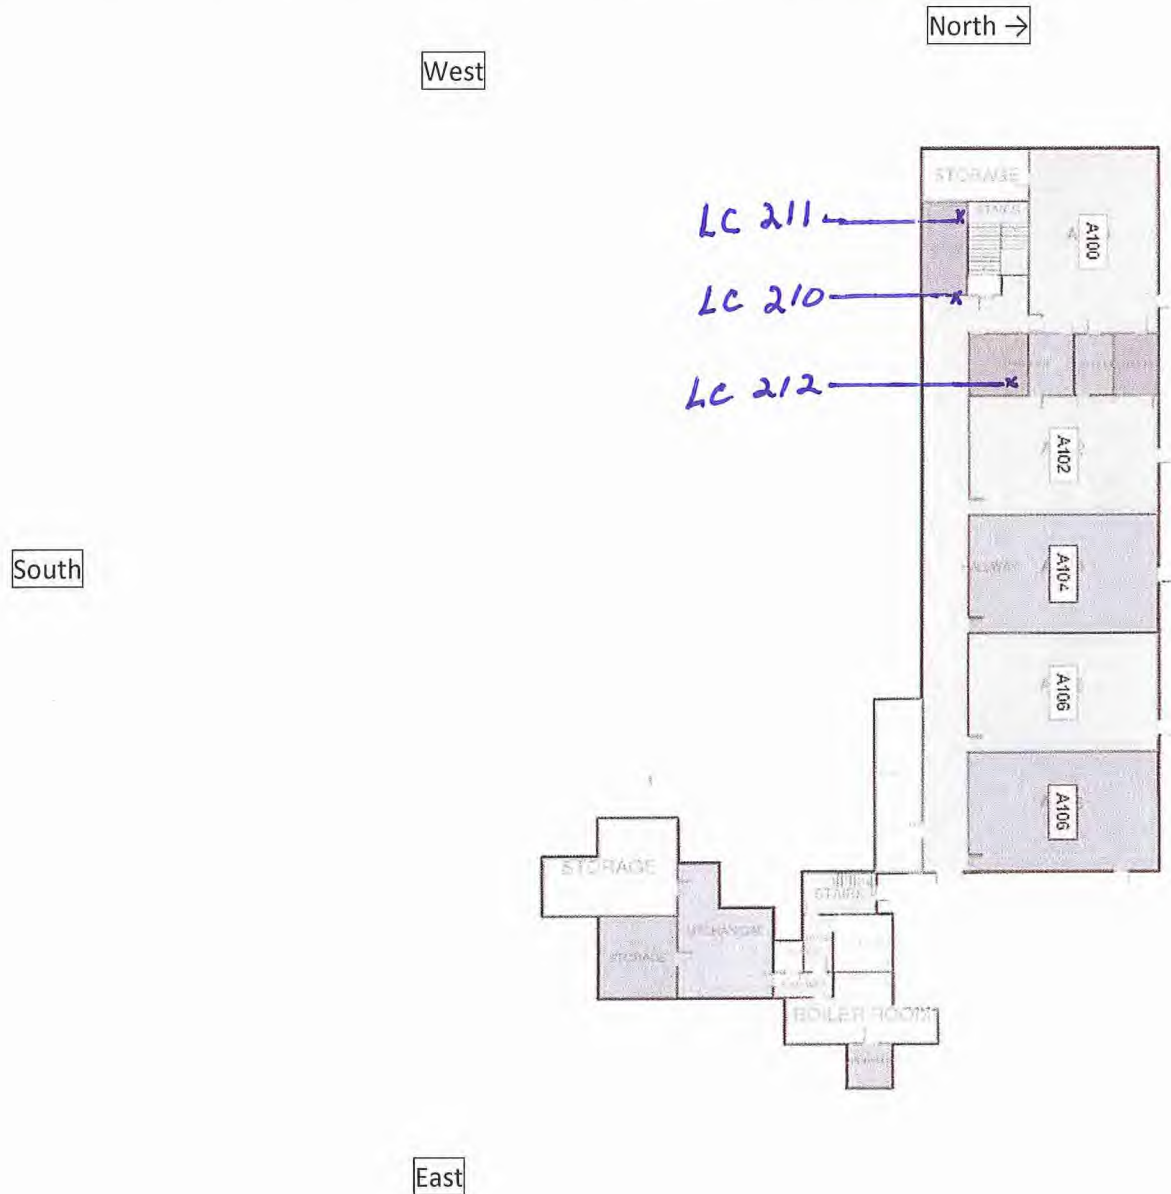

←North

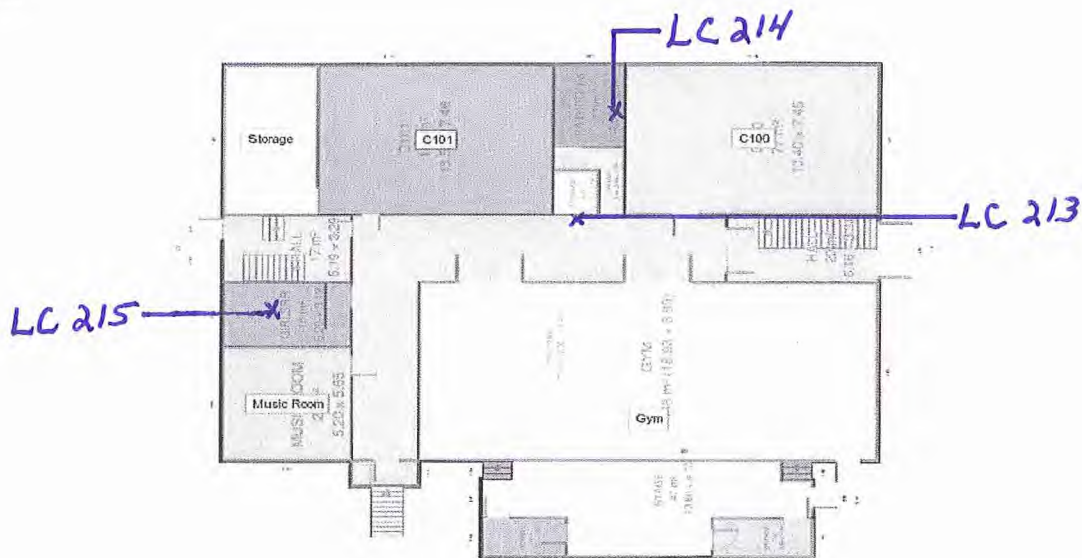


Bath Elementary School – Revere Local School District  
1246 N Cleveland Massillon Rd. Akron, Ohio 44333 (330)-523-3802

1923 Original Building - Built Prior to 1998 **PROBABLE**

West

←North

East

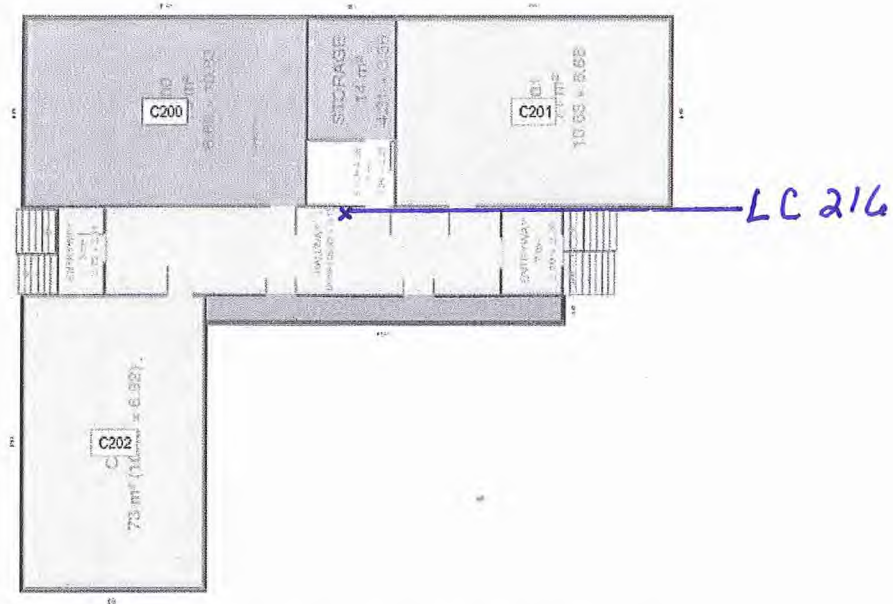


Bath Elementary School – Revere Local School District  
1246 N Cleveland Massillon Rd. Akron, Ohio 44333 (330)-523-3802

1923 Original Building - Built Prior to 1998 **PROBABLE**

West

←North

East

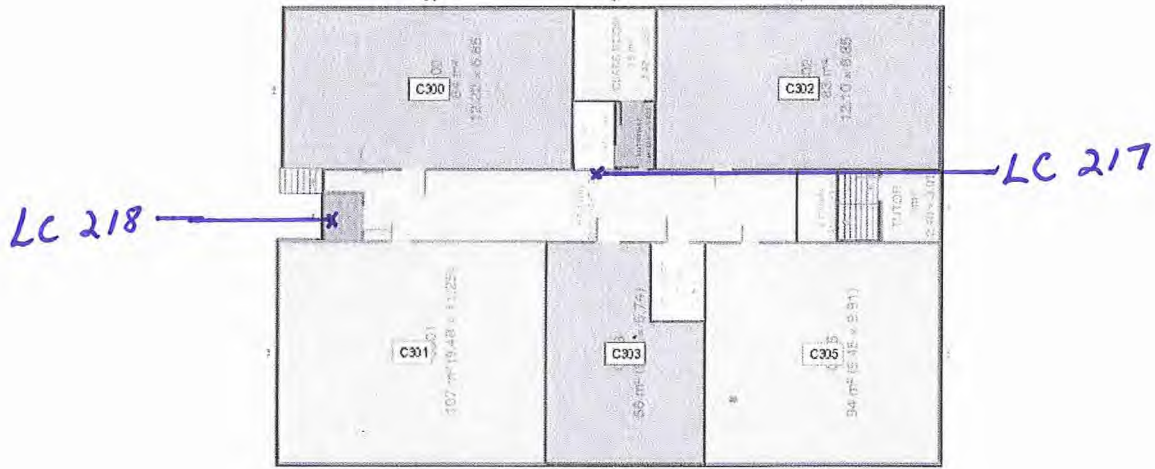

Bath Elementary School – Revere Local School District  
1246 N Cleveland Massillon Rd. Akron, Ohio 44333 (330)-523-3802

1923 Original Building - Built Prior to 1998 **PROBABLE**

West