


SOUTHEAST HIGH SCHOOL

8245 TALLMADGE ROAD
RAVENNA, OHIO 44266

LEAD & COPPER TESTING SITES

PWSID: OH6753512

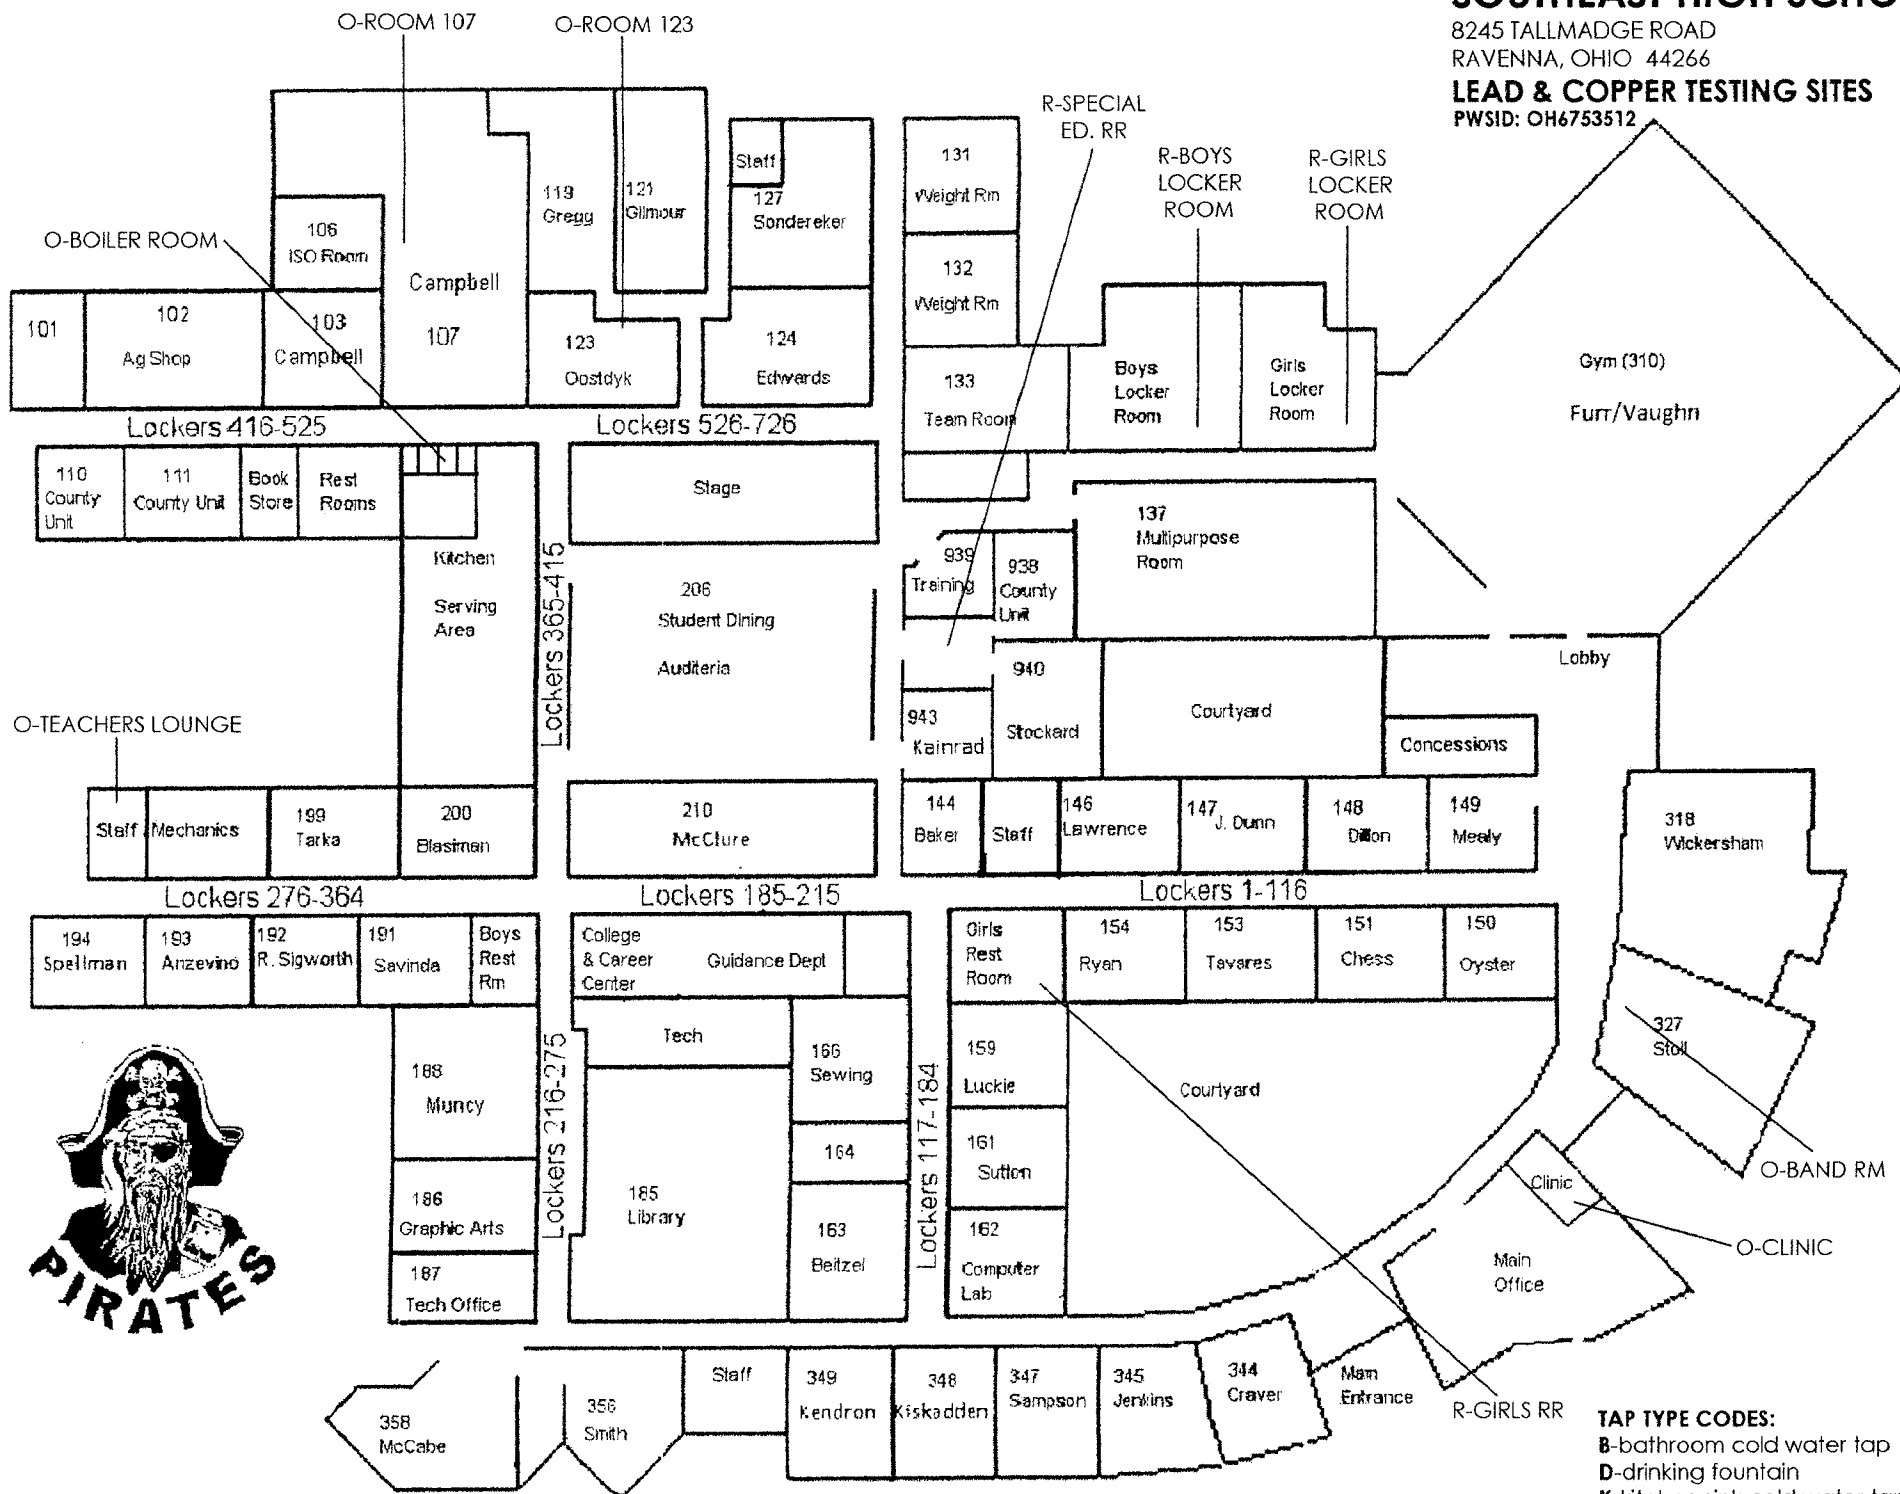

TAP TYPE CODES:
B-bathroom cold water tap
D-drinking fountain
K-kitchen sink cold water tap
R-restroom sink cold water tap
O-other