


**EDINBURG UNITED CHURCH/SCHOOL**

4081 ROCKSPRING ROAD  
RAVENNA, OHIO 44266

LEAD & COPPER TESTING SITES PWSID: OH6777212

2ND FLOOR  
MEN'S RR SINK

2ND FLOOR  
WOMEN'S RR SINK

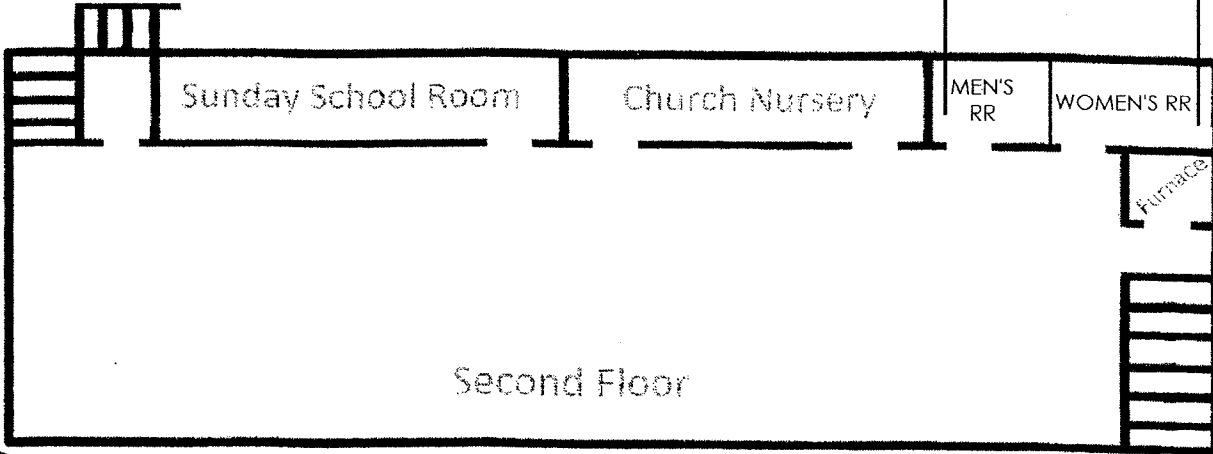

KITCHEN  
3-BAY SINK

KITCHEN  
2-BAY SINK

