


Baird Brothers Sawmill, Inc.

Water Lines

Finish Shop #3

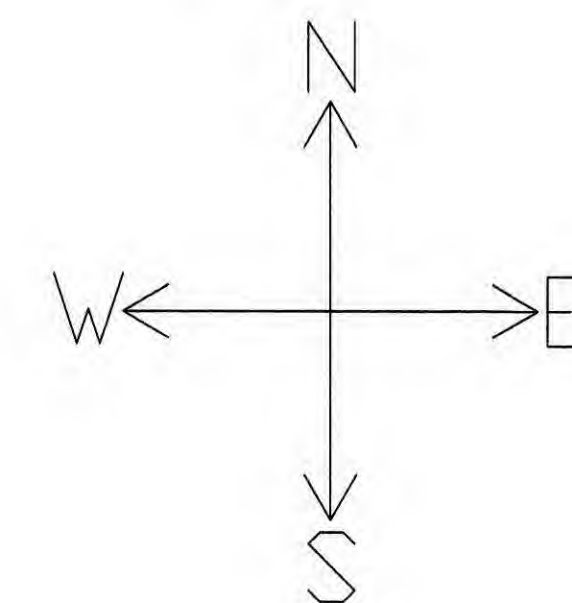

Legend

Fire Hydrant

Water Line

Sectional Control Valve



Fire Hose



Fuel Tank

Fire Lane



Chain Link Fence



Overhead Door



Storm Drain

PWS Locations

- Location 1: Employee RR East (Pre-Finish Shop)
- Location 2: Employee RR West (Rough Mill)
- Location 3: Mens Public RR (Showroom)
- Location 4: Women's Public RR (Showroom)
- Location 5: Upstairs Kitchen/Sink (2nd Floor Showroom)

RECEIVED

MAR 07 2017

OHIO EPA NEDO

Baird Brothers Sawmill Inc.


7060 Crory Rd.
Canfield, OH 44406

(330) 533-3122

www.bairdbrothers.com

SIZE	DATE	DRAWN BY:	REV
	3/1/17	JEC	
SCALE 1/128"=1'0"		DRAWING #:	SHEET
		Plant	

Baird Brothers Sawmill, Inc.

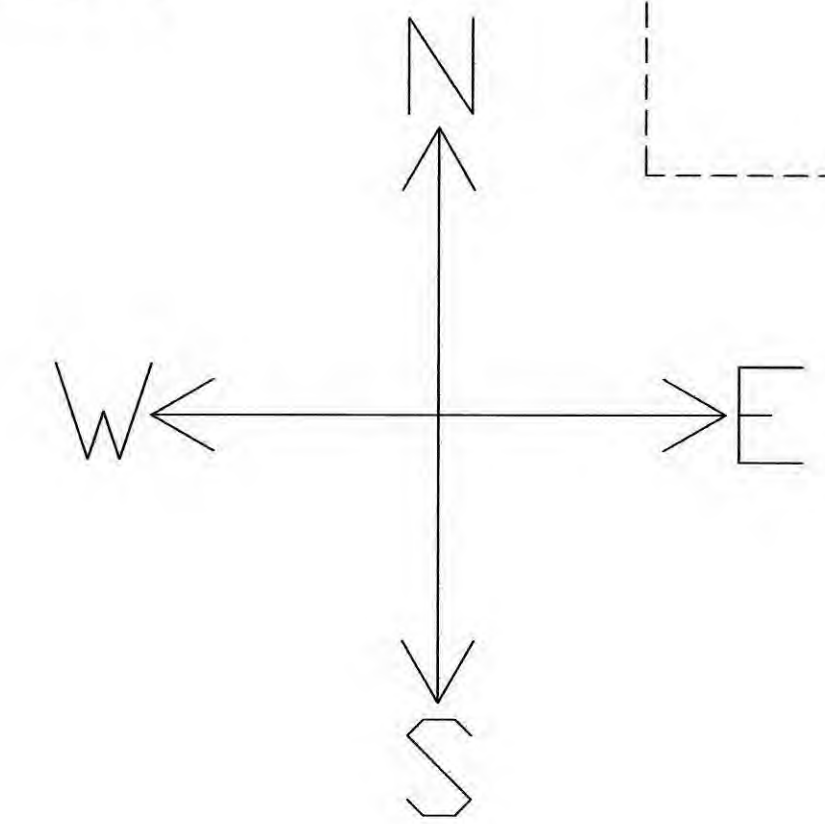

Legend

- Water Fountain
- Sink
- Water Well
- Urinal
- Toilet
- Water Line

PVC from Booster Pump
to Power Room

PVC

HOSE

PVC

Copper Underground Line
to Power Room

Showroom

Lunch
Room

Employee
Finish Mill RR

MEN

Public
Restrooms

MEN

WOMEN

Storage

Water Treatment Rm.

Storage

Storage

Storage


Will Call
Office

Copper Underground to
Pre-Finish/Door Shop

Baird Brothers Sawmill, Inc.


7060 Crory Rd. Canfield, OH 44406
Ph:(330) 533-3122 Fax:(330) 533-0781
www.bairdbros.com

SIZE	DATE	DRAWN BY:	REV
SCALE	3/1/17	JEC	
1/8"=1'	DRAWING # Plant Layout SHEET		

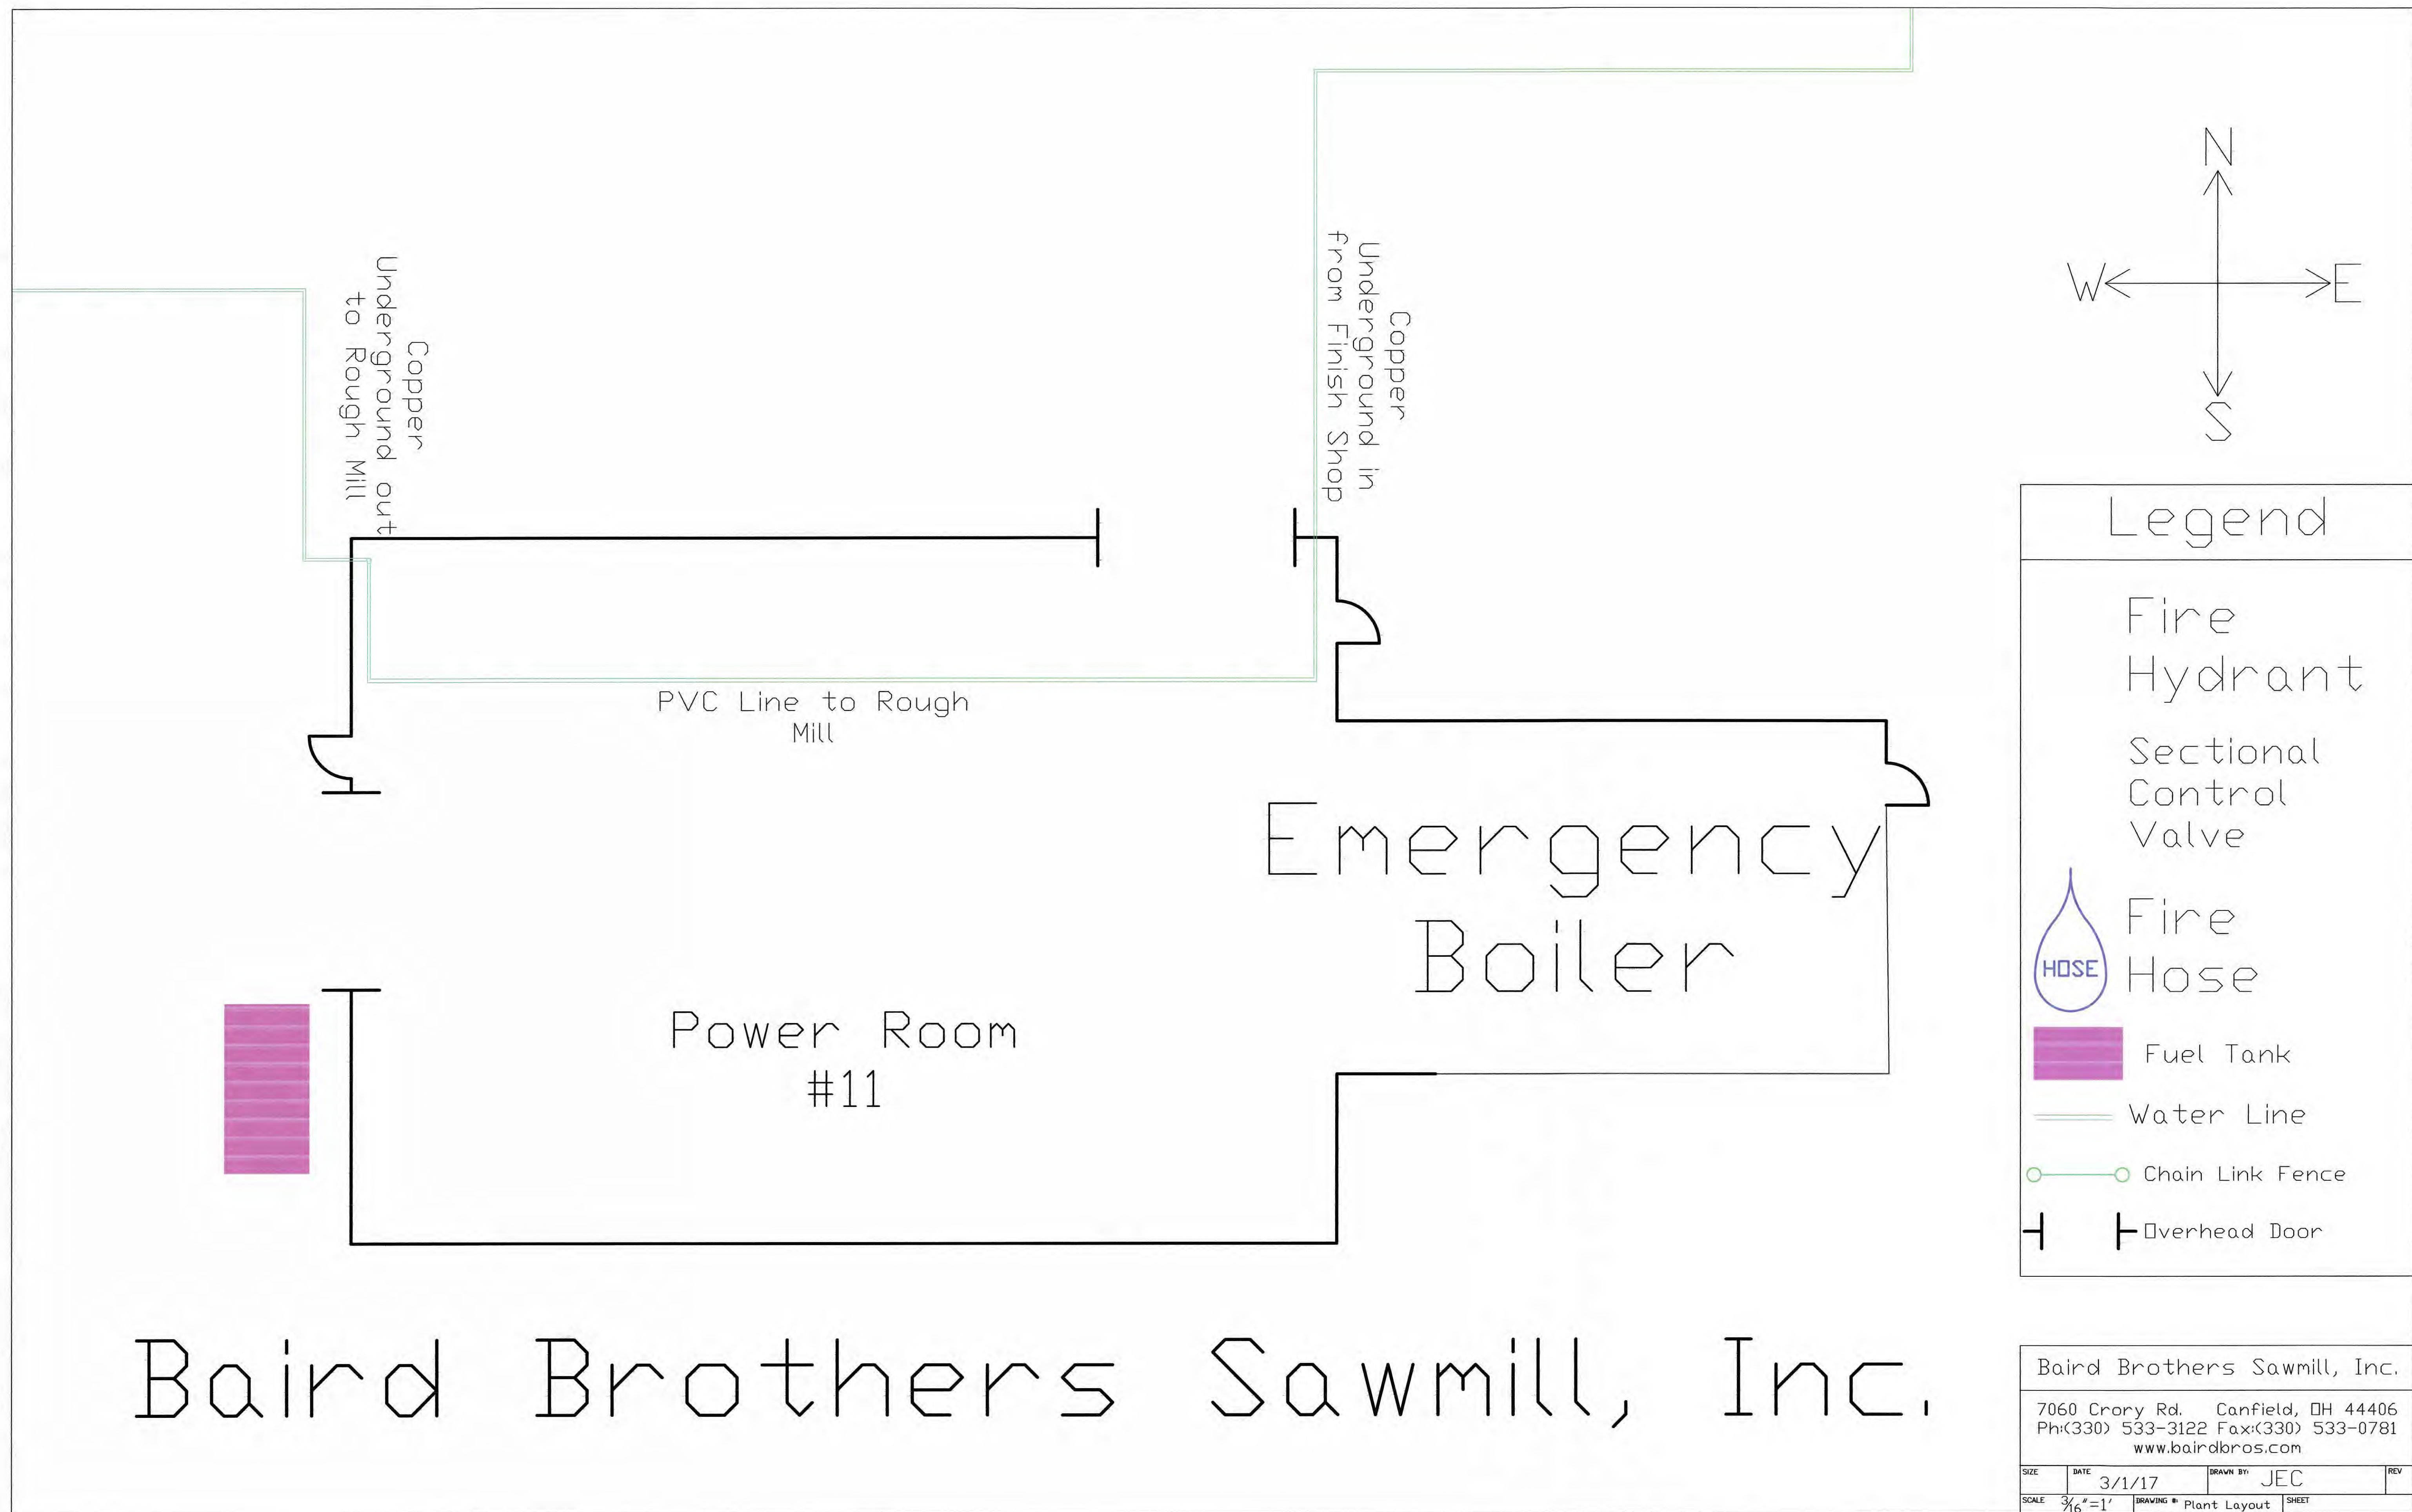

Baird Brothers Sawmill, Inc.

Copper in from
Power Room

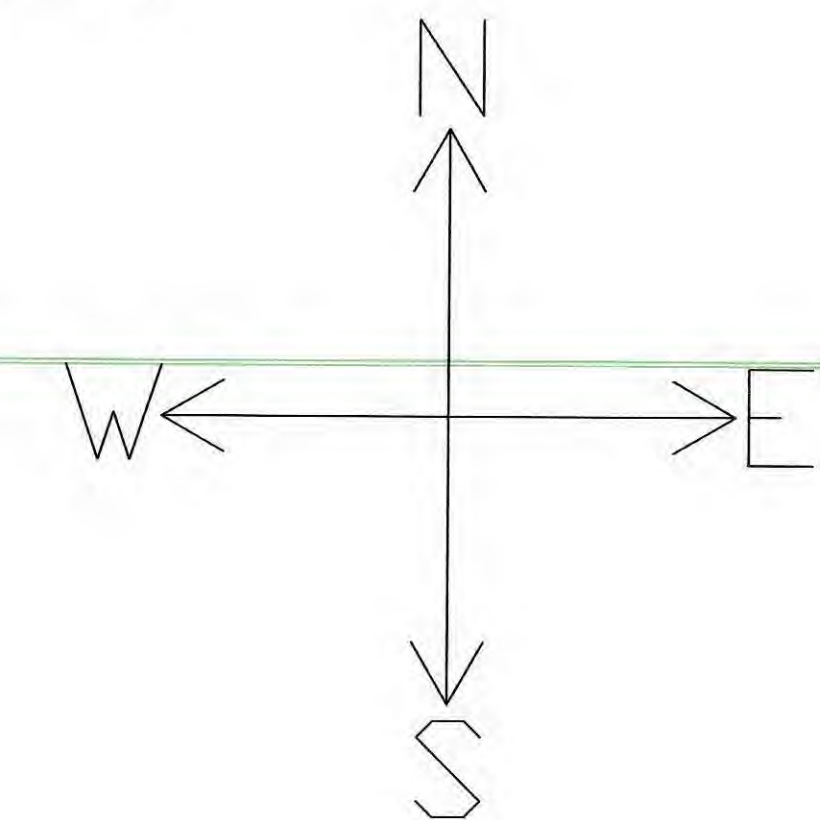


PVC



PVC to Rough Mill
Bathroom

Rough Mill

Copper in to
Employee Restroom
West

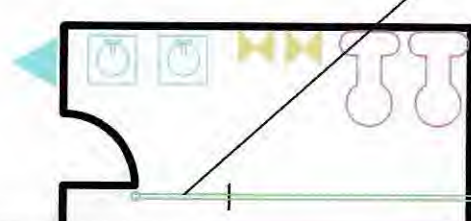

Legend

Fire
Hydrant


Sectional
Control
Valve




Fire
Hose



Fuel Tank

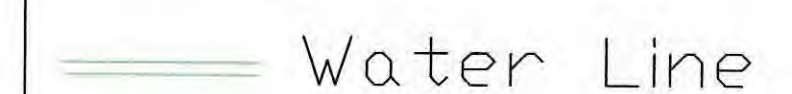

Water Line

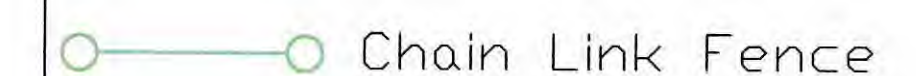

Chain Link Fence



Overhead Door

Baird Brothers Sawmill, Inc.

7060 Crory Rd. Canfield, OH 44406
Ph:(330) 533-3122 Fax:(330) 533-0781
www.bairdbros.com



SIZE	DATE	DRAWN BY	REV
	3/1/17	JEC	
SCALE	DRAWING #: Plant Layout SHEET		



PVC to Rough Mill
Bathroom

Rough Mill

Copper in to
Employee Restroom
West

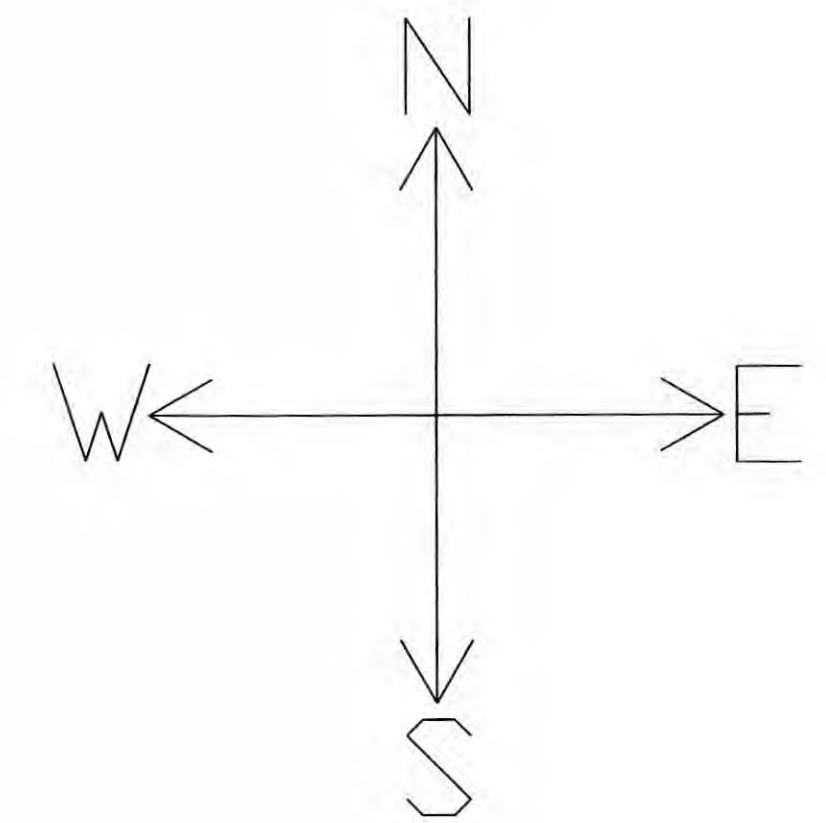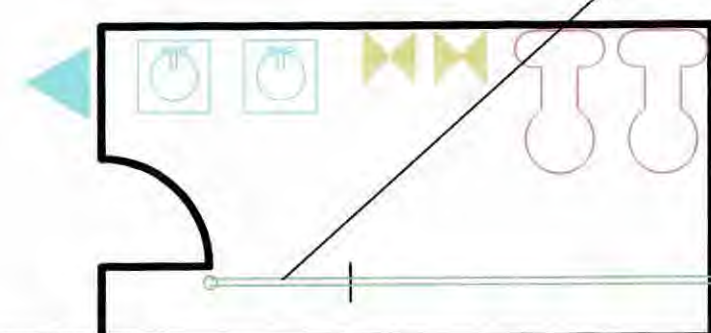

Legend

- Water Fountain
- Sink
- Water Well
- Urinal
- Toilet
- Water Line


Baird Brothers Sawmill, Inc.

Baird Brothers Sawmill, Inc.

7060 Crory Rd. Canfield, OH 44406
Ph:(330) 533-3122 Fax:(330) 533-0781
www.bairdbros.com

SIZE	DATE	DRAWN BY	REV
	3/1/17	JEC	
SCALE	3/16"=1'	DRAWING #	SHEET
		Plant Layout	

Baird Brothers Sawmill, Inc.

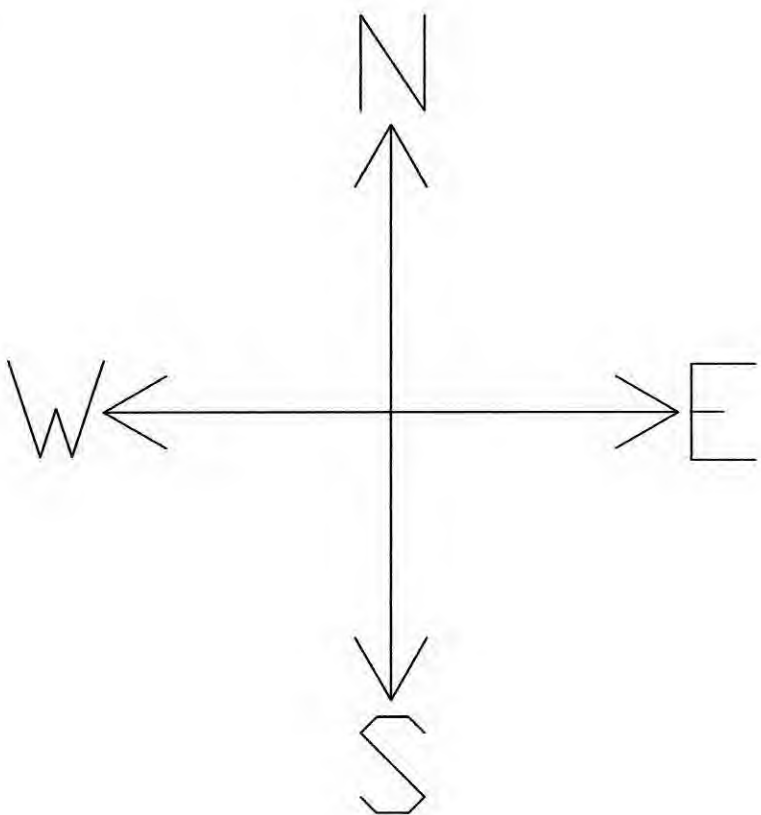

Legend

Fire Hydrant

Sectional Control Valve



Fire Hose



Fuel Tank



Water Line



Chain Link Fence



Overhead Door

Door
Shop
#15

Copper
Underground in
from Finish Shop




Copper to
Pre-Finish

Baird Brothers Sawmill, Inc.

7060 Crary Rd. Canfield, OH 44406
Ph:(330) 533-3122 Fax:(330) 533-0781
www.bairdbros.com

SIZE	DATE	DRAWN BY:	REV
	3/1/17	JEC	
SCALE	1/8"=1'	DRAWING #:	SHEET
		Plant Layout	

Dust
Collector

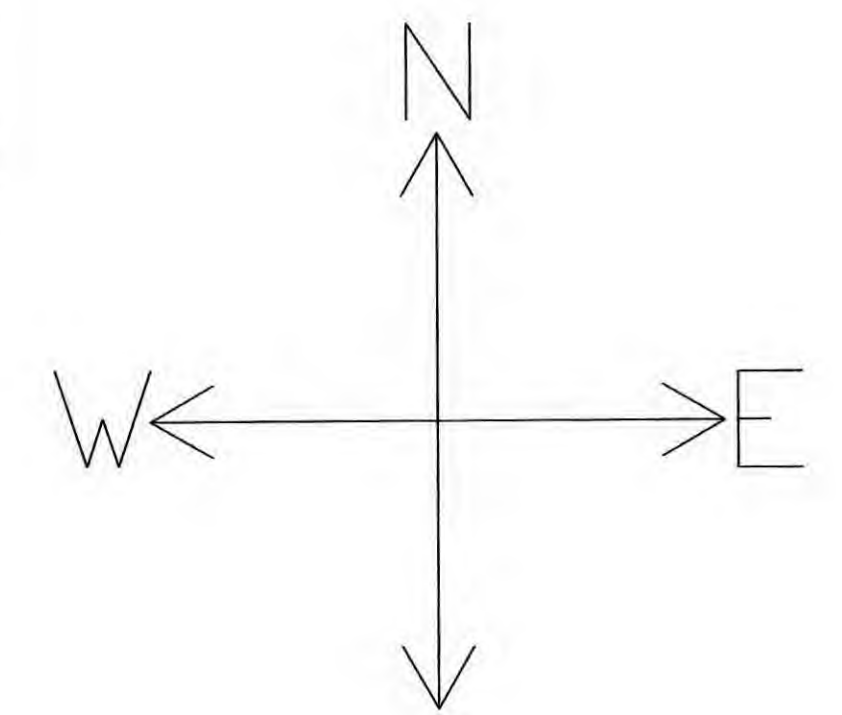

Copper from
Door Shop



- finish
7

Pre-Finish

PVC



Legend

- Water Fountain
- Sink
- Water Well
- Urinal
- Toilet
- Water Line

Employee
Restroom
East

Baird Brothers Sawmill, Inc.

Baird Brothers Sawmill, Inc.			
7060 Crory Rd. Canfield, OH 44406			
Ph: (330) 533-3122 Fax: (330) 533-0781			
www.bairdbros.com			
SIZE	DATE	DRAWN BY	REV
	3/1/17	JEC	
SCALE	1/8" = 1'	DRAWING #	SHEET
		Plant Layout	

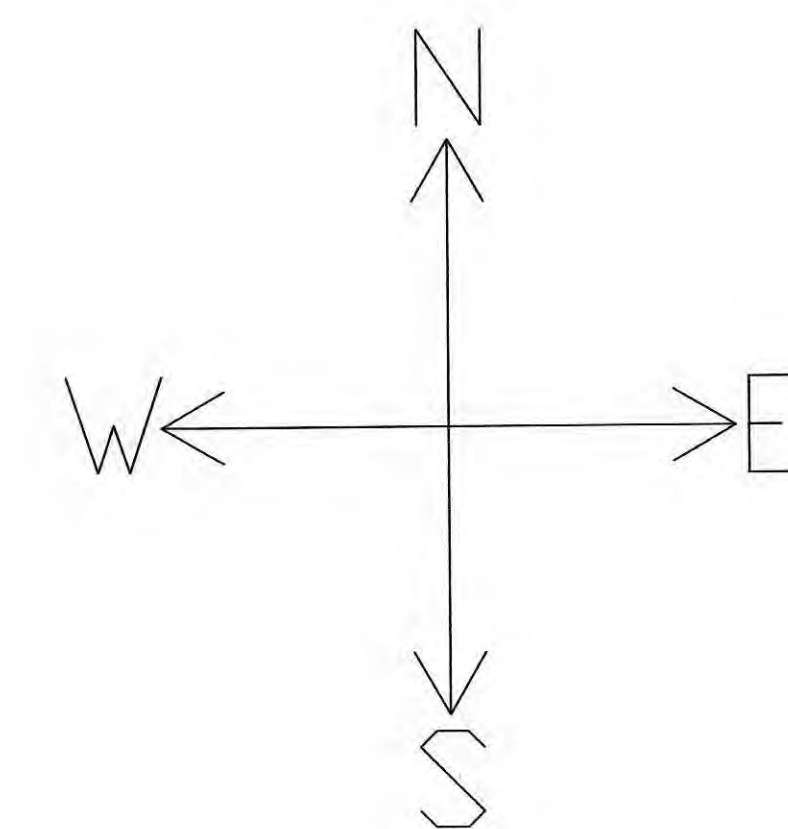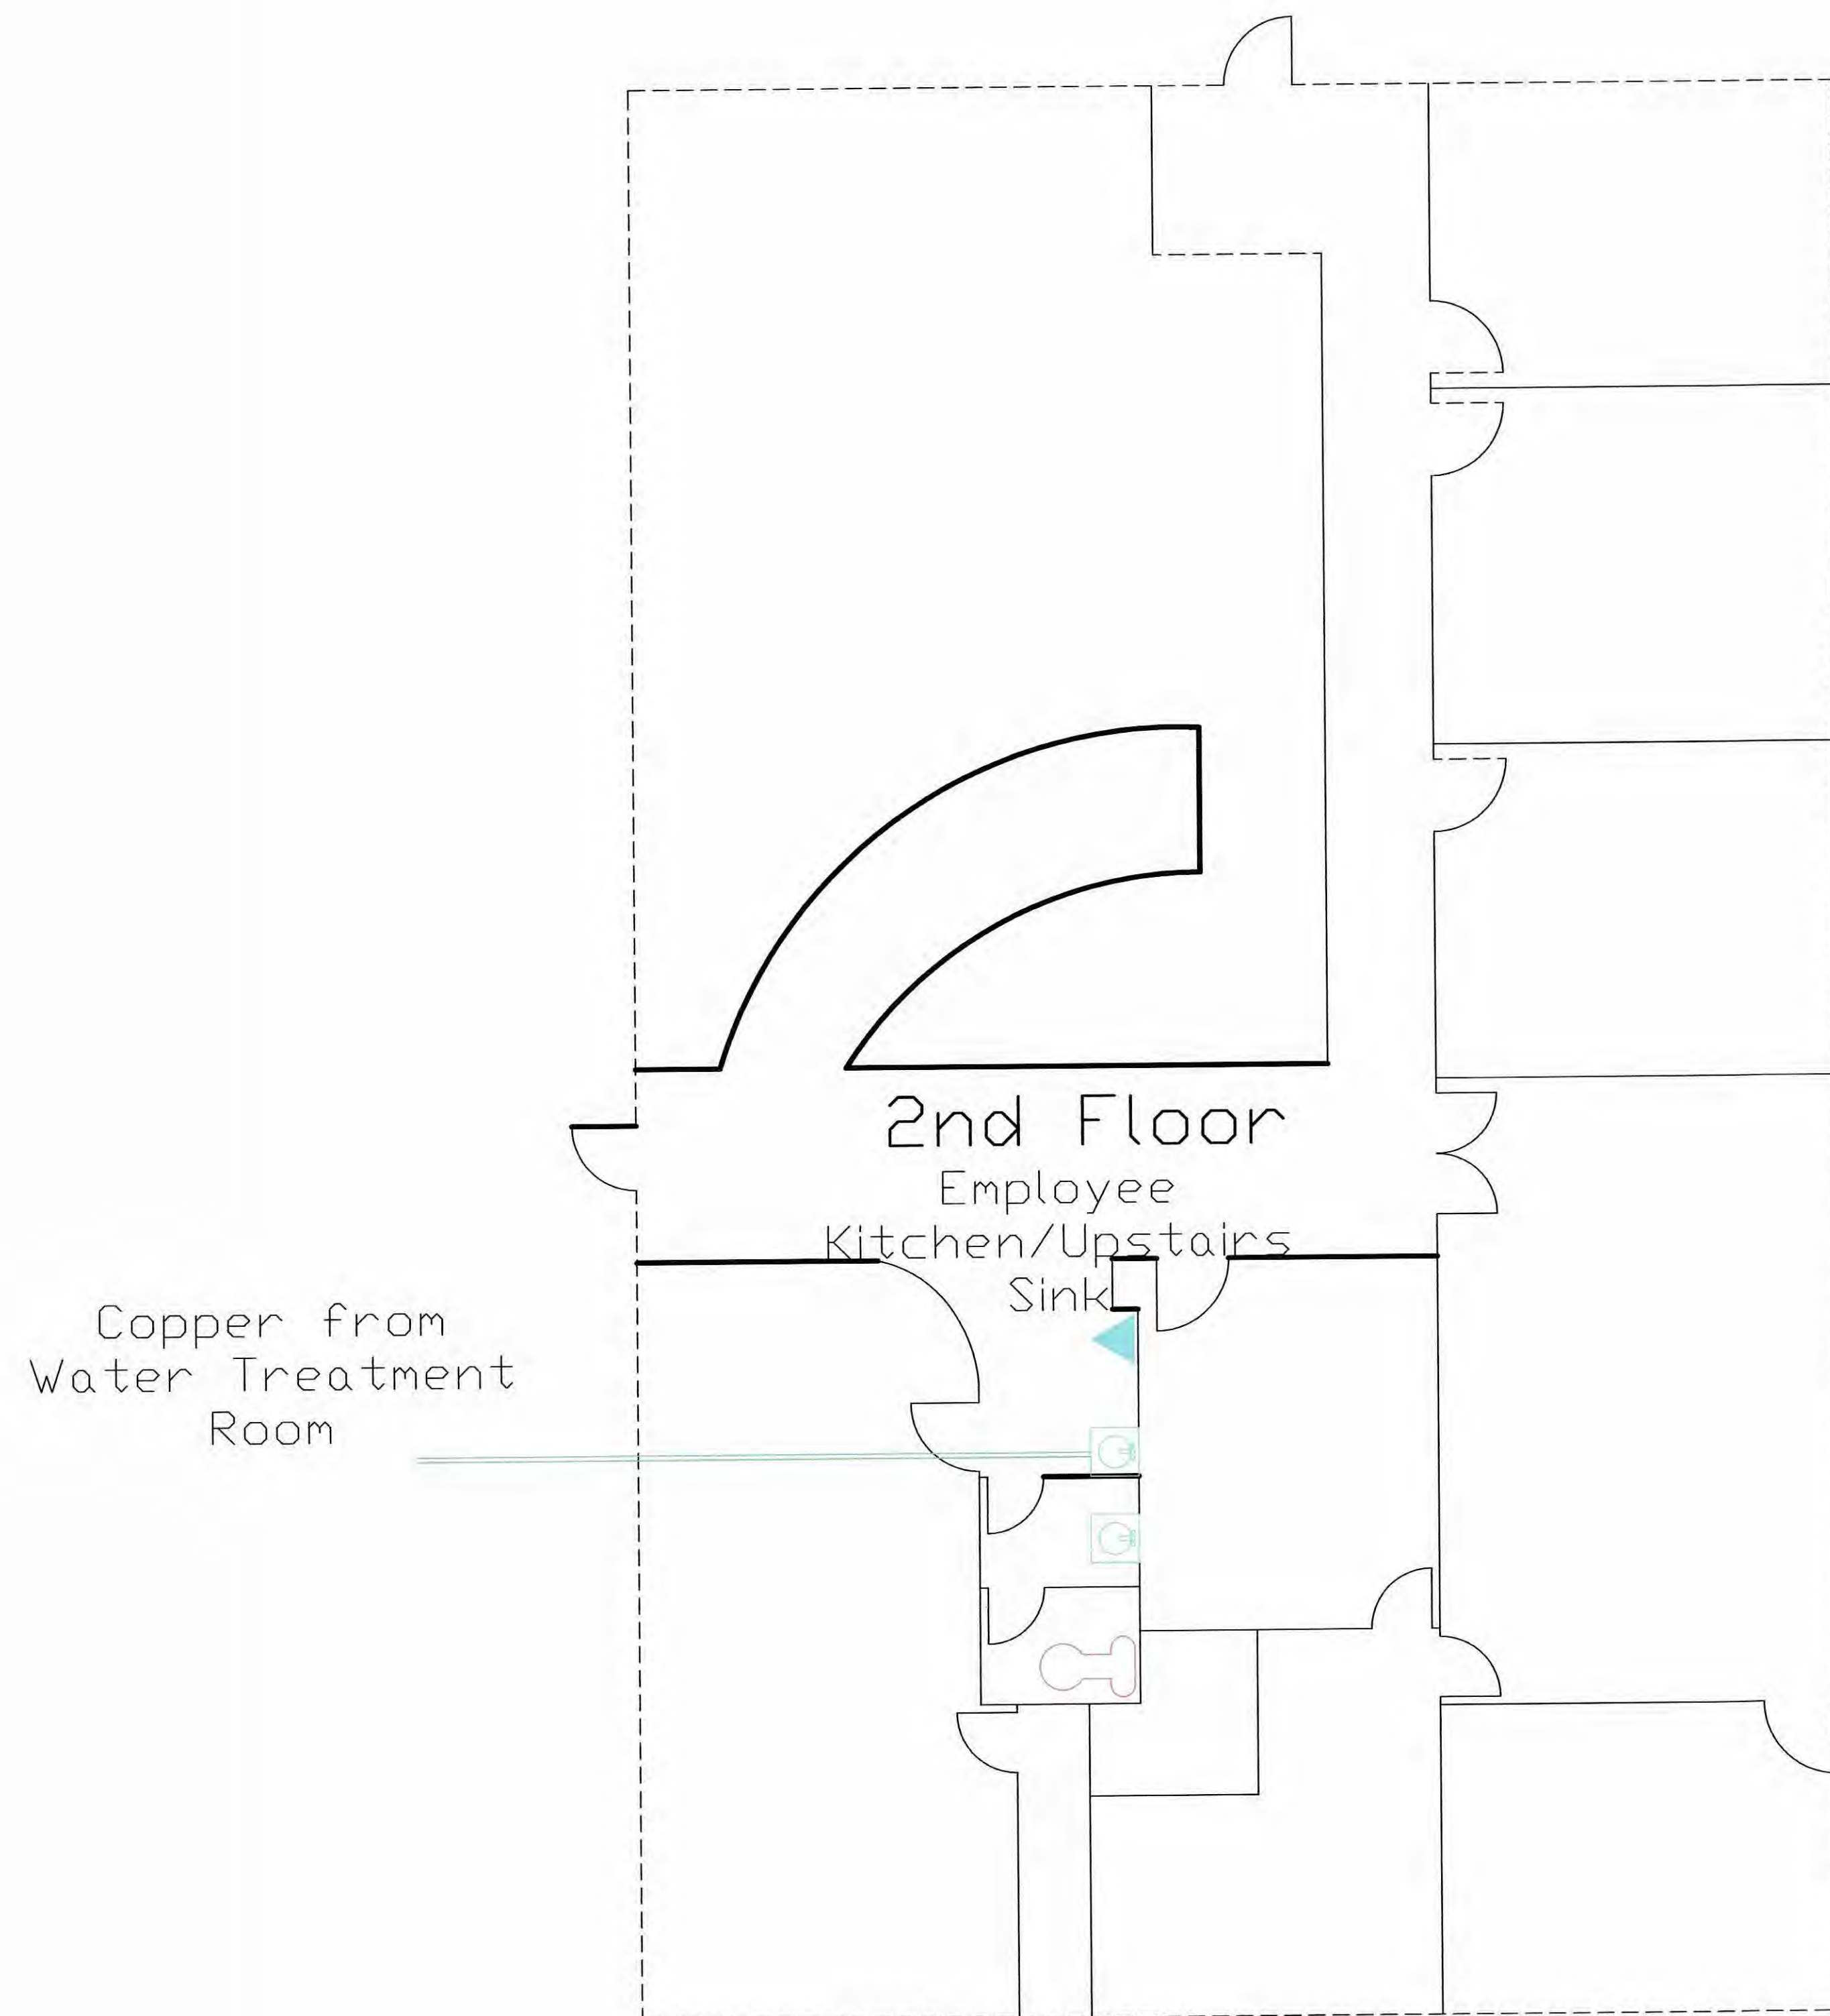

Legend

-  Water Fountain
-  Sink
-  Water Well
-  Urinal
-  Toilet
-  Water Line

Baird Brothers Sawmill, Inc.

Baird Brothers Sawmill, Inc.

7060 Crory Rd. Canfield, OH 44406
Ph: (330) 533-3122 Fax: (330) 533-0781
www.bairdbros.com

SIZE	DATE	DRAWN BY	REV
	3/1/17	JEC	
SCALE	DRAWING # Plant Layout SHEET		
1/8" = 1'			