


SUSPENDED CEILING @ R.O.C. SHOWN THIS WAY - ALL OTHER ROOMS OPEN TO STRUCTURE ABOVE

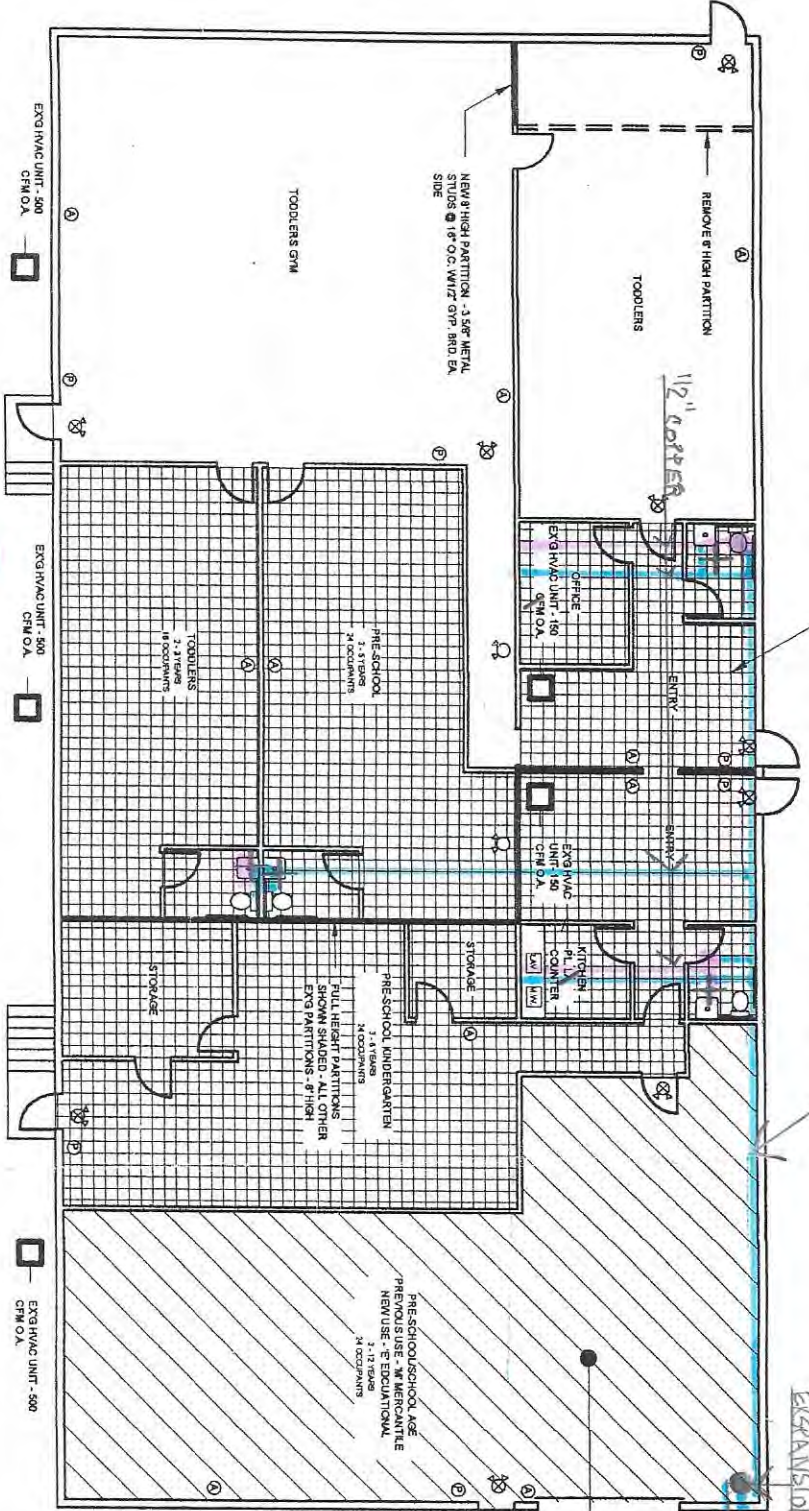

LEGEND

Water lines are copper
Lead free solder fittings

- Cold Water
- Hot Water
- + LAV Faucets
- = Kitchen sink Faucets

FLOOR PLAN

1/8" = 1'-0"



APPROVED

ROSS TWP. FIRE DPT.
CHIEF STEVE MILLER

DATE 6-24-13

SIGN *[Signature]*

- GENERAL NOTES**
- SCOPE OF WORK CONSISTS OF PARTIAL CHANG...
 - ALL CONSTRUCTION IS EXG UNL. \$\$\$ NOTED O...
 - APPLICABLE BUILDING CODE - OEC 2011
 - CONSTRUCTION CLASSIFICATION - II-B
 - EXG OCCUPANCY TYPE - 'E' EDU. A TIONAL & N...
 - NEW OCCUPANCY TYPE - UNSER. RATED 'E' EI...
 - BUILDING AREA = 7500 SF
 - ALLOWABLE BUILDING AREA = 14,500 SF
 - 2 1/2 YEARS OF AGE & U...
 - TOTAL = 130 - SEE PLAN
 - B-111 SF/100 = 2
 - TOTAL = 102
 - NEW MONITORED FIRE ALARM SYSTEM WILL B...

- = EMERGENCY/EXIT LIGHT
- = EMERGENCY BATTERY & 120 MIN. BATTERY B...
- = EMERGENCY OCCUPANCY HEADS. (1) EXTERIOR H...
- = EMERGENCY LIGHT V...
- = STORAGE/AUDIO ALAR...
- = ALARM SYSTEM PUL...

PART. CHANGE OF OCC. & INT. ALT.
ROSS EARLY LEARNING ACADEMY
2683 MORGAN LN. (S13) 702-7071
ROSS, OHIO 45013

DATE JUNE 18, 2013
All fixtures are 2005 or newer

WALFRED A. MATTSON
ARCHITECT
2859 BANNING RD.
CINCINNATI, OHIO 45239
513/385-5300

