

Lead and Copper Mapping

Lakeview Mobile Home Park
Cortland Ohio

OH7801712

April 2017

Lakeview Mobile Home Park operates a public water system that consists of two treatment units containing two Ground water wells. Plumbing in the treatment units are threaded galvanised or schedule 80 pvc, containing no copper or lead pipes and no soldered connections. Supply lines deliver water to approximately 100 privately owned mobile homes and one ancillary building. These supply lines are plastic and 30 years in age or less. There are no lead pipes in our water system. Buildings built prior to 1998 or that use plumbing material or solder manufactured before 1998 may have materials with greater than 8% lead and are at a higher risk of contributing lead to the drinking water than materials manufactured after 1998. In addition, buildings built and plumbing materials manufactured after 2014 were required to have less than 0.25% lead by weight and have the lowest risk for contributing lead to the drinking water. It should be noted however that, although prohibited, some use of leaded solder or leaded components may have occurred after the prohibitions became effective.

Jay Plymale

Joe Chicoski

RECEIVED
APR 13 2017

BY:

I HEREBY CERTIFY THAT THE FOLLOWING METHOD(S) WERE USED TO DETERMINE NO LEAD SERVICE LINES EXIST IN THIS WATER SYSTEM'S DISTRIBUTION SYSTEM, AS REQUIRED BY ORC 6109.121(F):

LEAD SERVICE LINE VERIFICATION

This PWS states they have no lead service lines and has reviewed the following information (select one or more of the following):


- Historical permit records and/or local ordinances
- Distribution maintenance records (i.e. meter replacement, waterline break repairs)
- Information pertaining to installation dates for all service lines (i.e. after 1986 when lead services lines were banned)
- Service line material of all service lines is known (i.e. all service lines are known to be PVC)

Entity: Lakeview MHP
Doc Type: REPORT
Doc Subtype: REPORT
Program: DRABW
County: TRUMBULL
Secondary ID: OH 7801712

LAKEVIEW
PWS NAME: MOBILE HOME
PARK
PWS ID:
OH 7801712
COUNTY: TRUMBULL

RECEIVED

MAR 07 2017

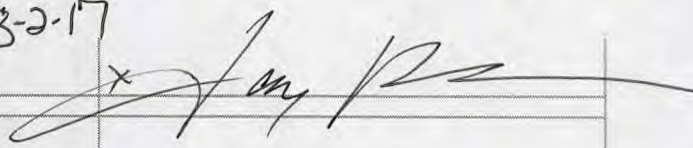Signature of Responsible Person	Date
	3-2-17
Printed Name and Title of Responsible Person	JAY PLYMALE, OWNER





For Ohio EPA use only:

Date Verification Rec'd:

Lead Mapping Verification Form Revised 2/14/17

N

TOO PARTS OF HOUSE

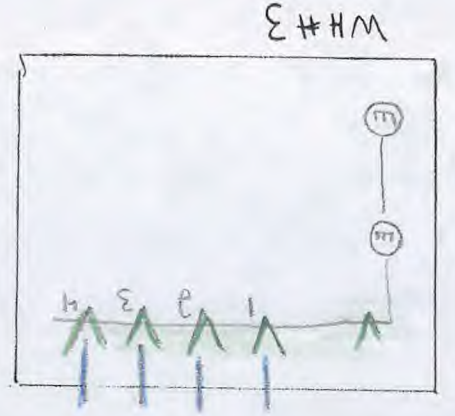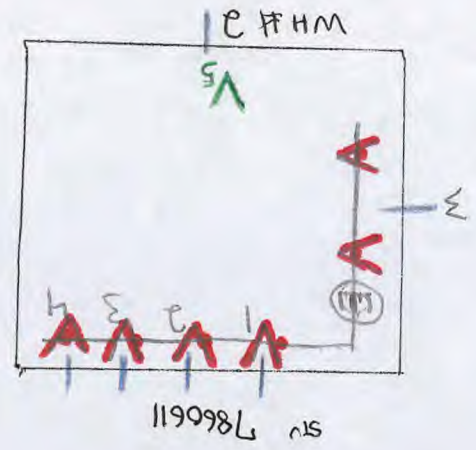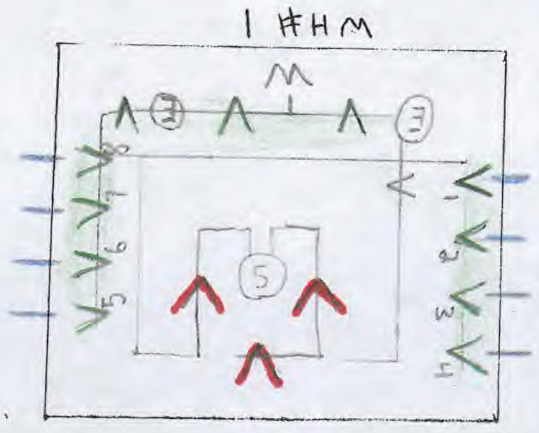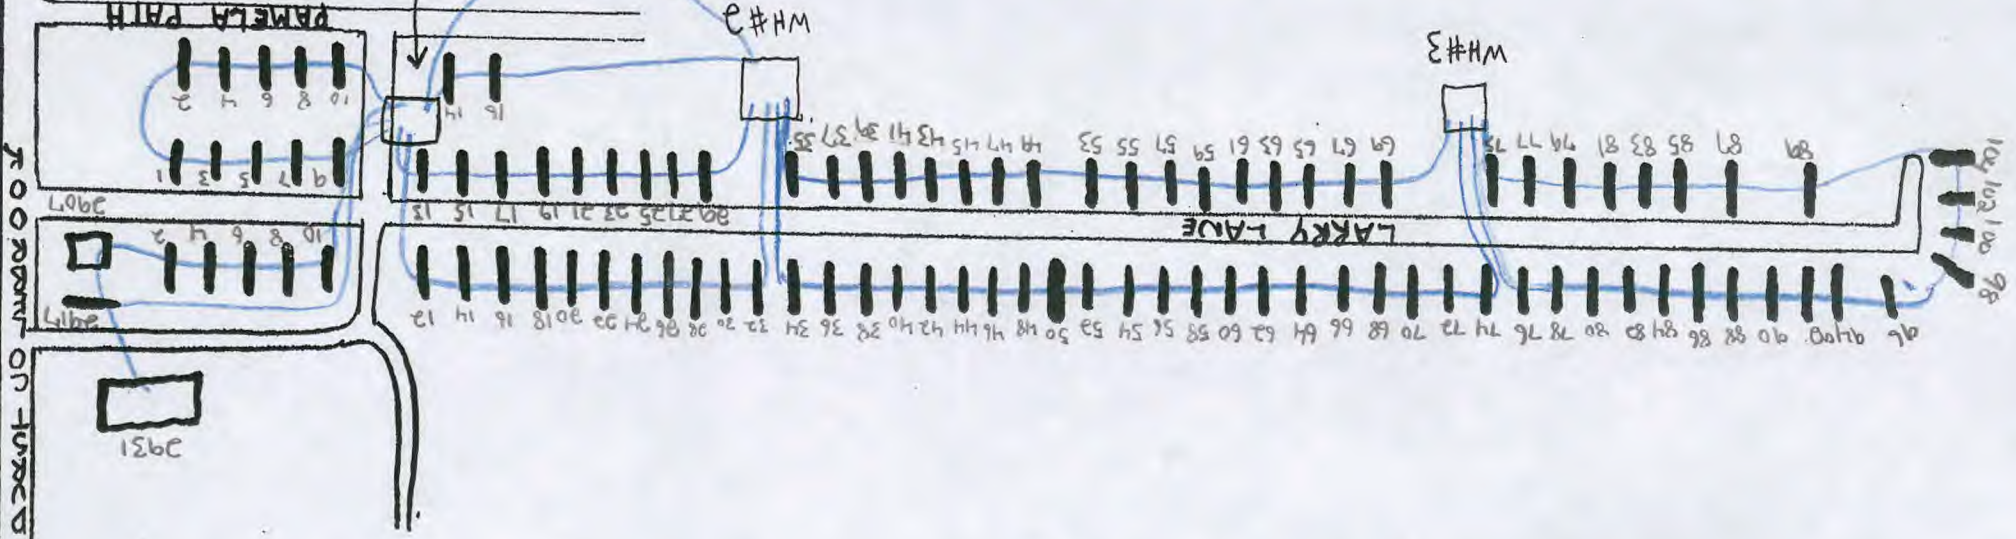

V = VALVE E = EXPANSION TANK W = WELL S = SOFTENER WH = WELLHOUSE = MOBILE

NO INFORMATION = —
 NON LEAD = —
 PLASTIC WATER LINE = —

* NO SOLDER ALL THREADED CONNECTIONS
 * PUBLIC SIDE NON LEAD * SUPPLY VALVES

OH 7801712

VALVES

SERVICE ADDRESS

W.H.1	W.H.2	W.H.3	
1	5	N/A	17 PP
2	5	N/A	12 + 14 PP
3	4	N/A	13LL → 27LL odd#
4	3	N/A	12LL → 32LL EVEN#
5	N/A	N/A	2-10LL EVEN LOOP
6	N/A	N/A	2907 DC, 2917 DC, 2931 DC
7	N/A	N/A	2-10 PP EVEN# LOOP
8	N/A	N/A	1-11 PP odd#
N/A	1	3	34LL → 74LL EVEN#
N/A	2	4	35 LL → 69 LL ODD#
N/A	NA	1+2	75LL → 104 LL

W.H. = WELL HOUSE

PP = PAMELA PATH

LL = LARRY LANE

DC = DURST COLEBROOK