

RECEIVED

APR 07 2017

OHIO EPA NEDO

**VERIFICATION FORM FOR COMMUNITY PUBLIC WATER SYSTEMS
CLAIMING NO LEAD SERVICE LINES**

The owner or operator of all community public water systems must identify and map areas of their distribution system that are known or are likely to contain lead service lines. Systems must submit a copy of the applicable map to the Ohio Department of Health and the Ohio Department of Job and Family Services. Systems must also submit a report to the director containing at least both of the following: (1) The applicable map with narrative, and (2) A list of sampling locations used to collect samples as required by Ohio Revised Code (ORC) Section 6109.121 and any rules adopted thereunder, including contact information for the owner and occupant of each sampling site.

Should a water system determine no lead service lines exist in their distribution system, they must provide information stating they reviewed, at the minimum, historical permit records and local ordinances, distribution maintenance records and information pertaining to installation dates or materials for all services lines. This information must be verified below.

I HEREBY CERTIFY THAT THE FOLLOWING METHOD(S) WERE USED TO DETERMINE NO LEAD SERVICE LINES EXIST IN THIS WATER SYSTEM'S DISTRIBUTION SYSTEM, AS REQUIRED BY ORC 6109.121(F):

LEAD SERVICE LINE VERIFICATION	
This PWS states they have no lead service lines and has reviewed the following information (select one or more of the following):	
<input type="checkbox"/>	Historical permit records and/or local ordinances
<input checked="" type="checkbox"/>	Distribution maintenance records (i.e. meter replacement, waterline break repairs)
<input type="checkbox"/>	Information pertaining to installation dates for all service lines (i.e. after 1986 when lead services lines were banned)
<input type="checkbox"/>	Service line material of all service lines is known (i.e. all service lines are known to be PVC)

David H Beary 4/5/2017

Signature of Responsible Person Date

DAVID H BEARY OPERATOR

Printed Name and Title of Responsible Person

TANGLEWOOD LAKE WATER DIV.

PWS NAME: _____

PWS ID: OH 2802512

COUNTY: GEauga

OH 2802512

For Ohio EPA use only:
Date Verification Rec'd: _____

January 20, 2017

Tanglewood Water Division
17400 Haskins Road
Chagrin Falls, OH 44023
OH 2802512 STU# 2854286

RE: Lead mapping

Brief background: Tanglewood Water Division serves Tanglewood Lake Association homes and a small shopping center with Giant Eagle grocery store and small businesses. We have a total of 572 home site connections split roughly evenly between individual homes and individual condos. Our system provided approximately 42,000,000 gallons of water to our community in 2016.

The land for Tanglewood was purchased 1966 with development in 1967 with home construction started in 1968.

In 2009 we started a complete change out of all old manual read meters to new AMR meters installed under contract in conjunction with our chosen contractor NORHIO. I was involved until it was finished in 2016 and all meters were installed in copper bridles that fit our standard sized meter. There were no lead service lines noted at that time as I would have had to approve extra charges by the contractor.

I have personally been in many of the houses including one of the ones built in 1968 and have not seen anything but copper pipe.

As plant operator I have supervised the repair of many 6" distribution line breaks and there are only three different types of main line materials, Ductile Iron, Transite, and the newest PVC. As part of our home owners agreement property owners are responsible for maintenance of the service line when it leaves our 6" main.


Please advise if you have any questions.

Very truly yours,

David Beary
Plant Operator

TANGLEWOOD WATER DIVISION WATER DISTRIBUTION SYSTEM


—○— MAIN LINE VALVES
 ○— HYDRANTS

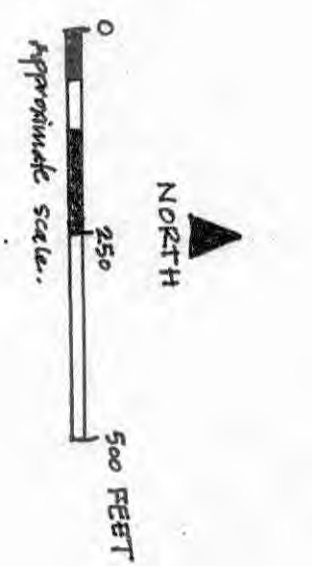

7-9-03
 3-15-04
 1-1-06 REVISED
 7-2-07 REVISED
 9-14-07 REVISED
 5-27-08 REVISED
 6-08-11 REVISED
 4-28-14 REVISED



4" C.I.

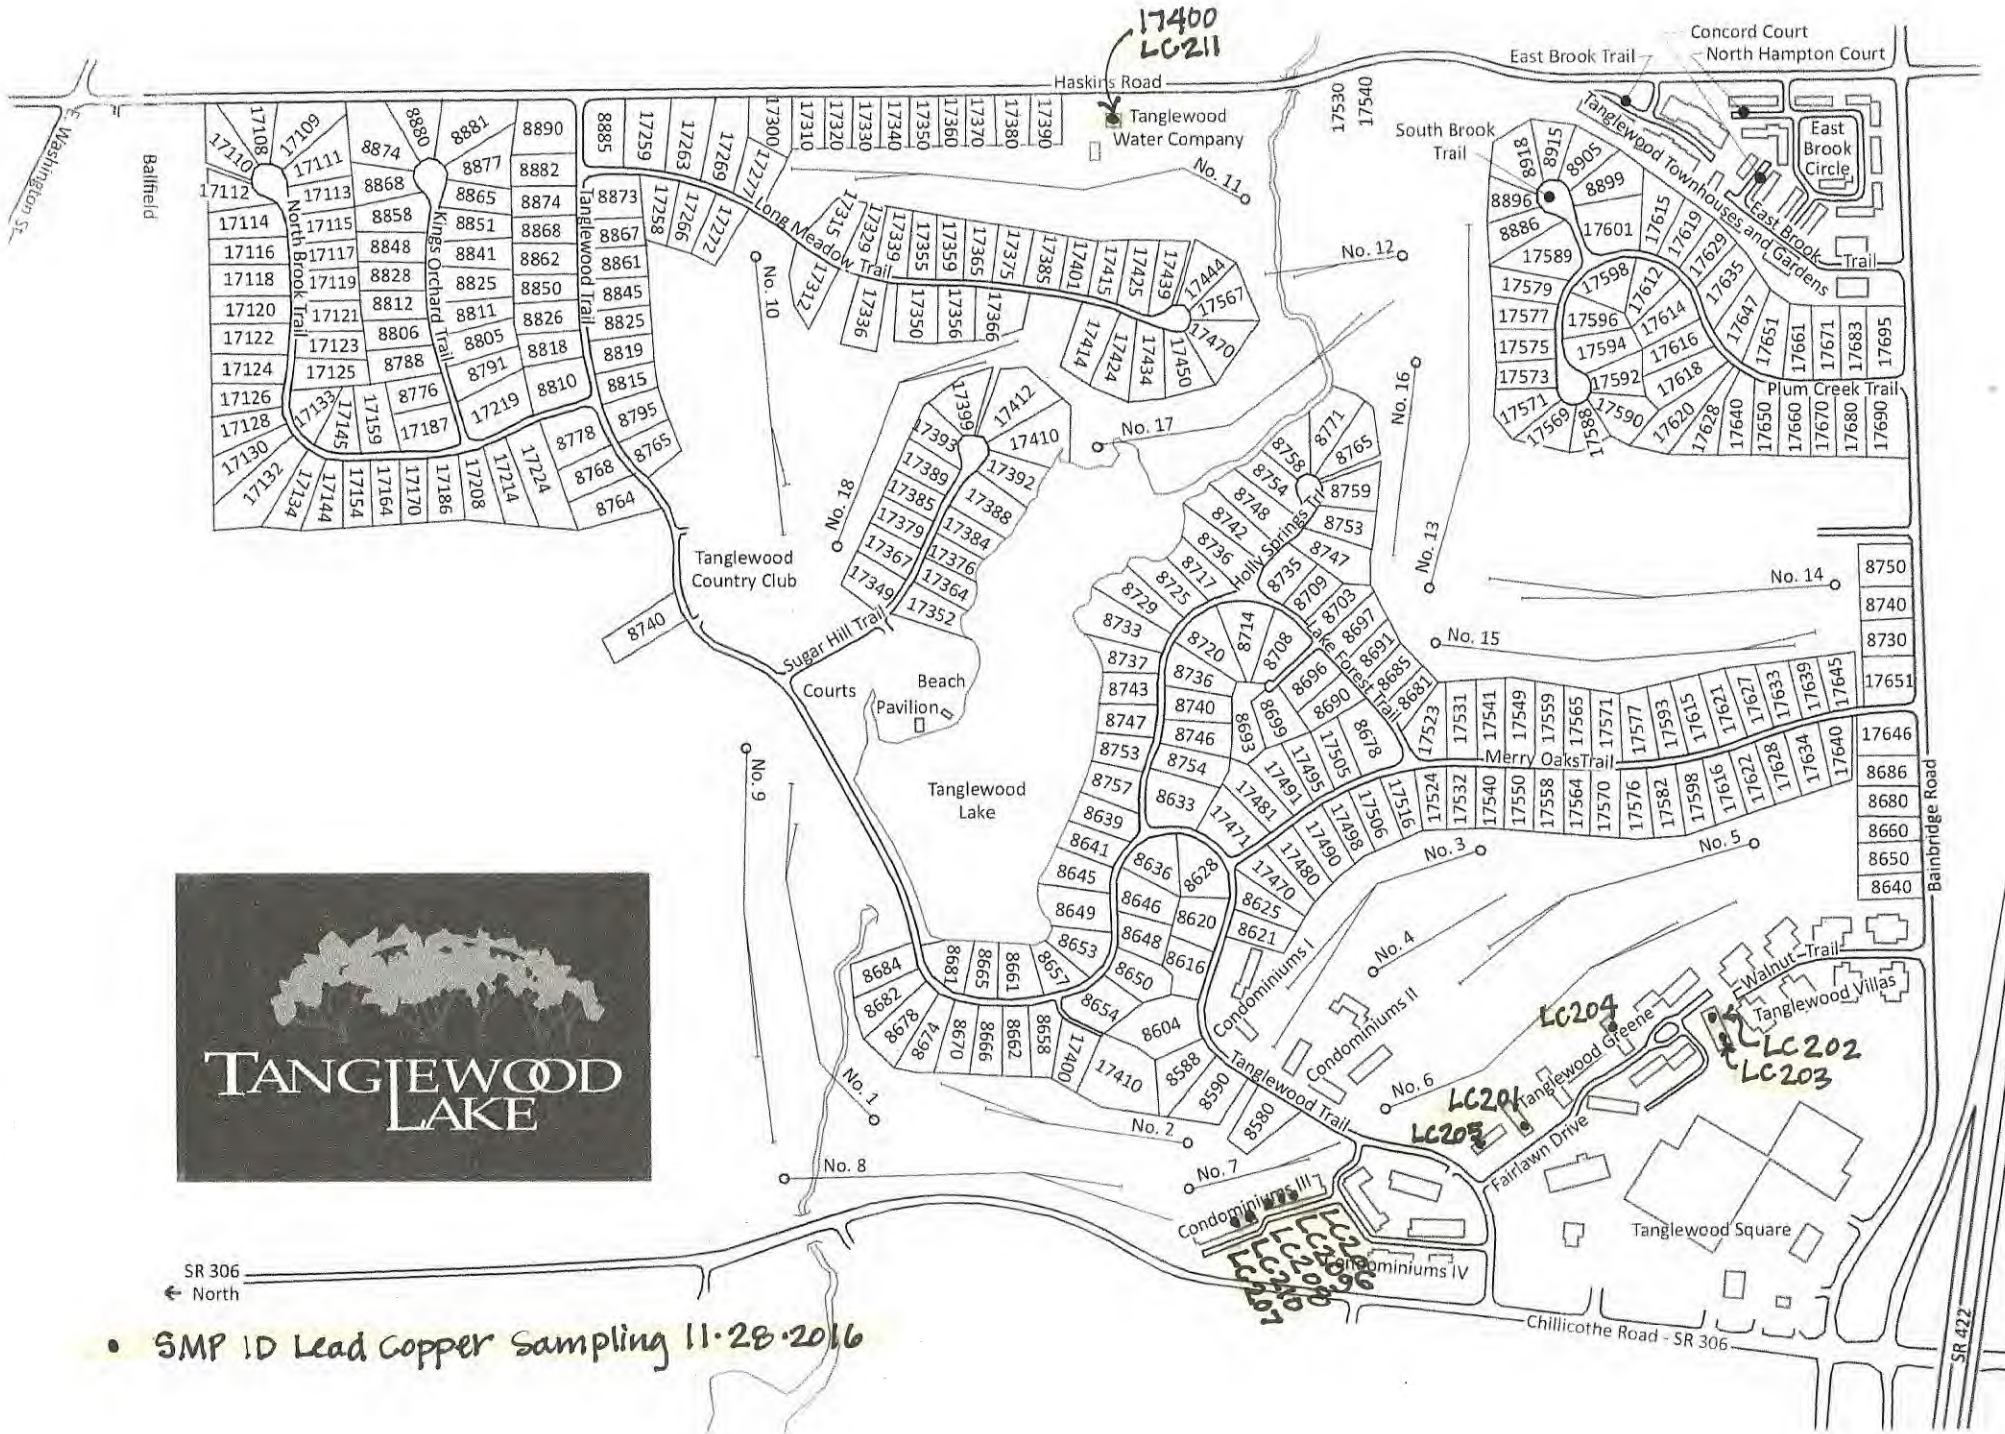

• SMP ID Lead Copper Sampling 11-28-2016

SR 306
← North

SR 472