

**VERIFICATION FORM FOR COMMUNITY PUBLIC WATER SYSTEMS  
CLAIMING NO LEAD SERVICE LINES**

The owner or operator of all community public water systems must identify and map areas of their distribution system that are known or are likely to contain lead service lines. Systems must submit a copy of the applicable map to the Ohio Department of Health and the Ohio Department of Job and Family Services. Systems must also submit a report to the director containing at least both of the following: (1) The applicable map with narrative, and (2) A list of sampling locations used to collect samples as required by Ohio Revised Code (ORC) Section 6109.121 and any rules adopted thereunder, including contact information for the owner and occupant of each sampling site.

Should a water system determine no lead service lines exist in their distribution system, they must provide information stating they reviewed, at the minimum, historical permit records and local ordinances, distribution maintenance records and information pertaining to installation dates or materials for all services lines. This information must be verified below.

I HEREBY CERTIFY THAT THE FOLLOWING METHOD(S) WERE USED TO DETERMINE NO LEAD SERVICE LINES EXIST IN THIS WATER SYSTEM'S DISTRIBUTION SYSTEM, AS REQUIRED BY ORC 6109.121(F):

LEAD SERVICE LINE VERIFICATION
<p><b>This PWS states they have no lead service lines and has reviewed the following information (select one or more of the following):</b></p> <ul style="list-style-type: none"><li><input type="checkbox"/> Historical permit records and/or local ordinances</li><li><input checked="" type="checkbox"/> Distribution maintenance records (i.e. meter replacement, waterline break repairs)</li><li><input type="checkbox"/> Information pertaining to installation dates for all service lines (i.e. after 1986 when lead services lines were banned)</li><li><input type="checkbox"/> Service line material of all service lines is known (i.e. all service lines are known to be PVC)</li></ul>

Eugene F. Davis                      7-MARCH-2017  
Signature of Responsible Person                      Date  
EUGENE F. DAVIS CHIEF OPERATOR  
Printed Name and Title of Responsible Person

PWS NAME: ALLSEASONS  
PWS ID: OH 6700812  
COUNTY: \_\_\_\_\_

<p><b>For Ohio EPA use only:</b></p> <p>Date Verification Rec'd: _____</p>
--

**RECEIVED**  
APR 10 2017  
**OHIO EPA NEDO**

RECEIVED

MAR 07 2017

OHIO EPA NEDO

KMW II (FORMELY NAMED ALL SEASONS) PWS OH6700812 pipe. The service lines, hardware and meters are a combination of Plastic, and Brass, including corporation stops. No lead service lines are known at the time of this writing, on the public the repair of distribution system is inconclusive,. The above-mentioned systems major renovation and or obsolescent programs have well been underway to remove old existing Mobiles home with brand new units conforming to new lead and copper rules. To avoid any questions, we are sampling from only the oldest homes, to assure that lead and copper analytical results are a true representation of the worst case scenario, to provide assurance and integrity, that the health and welfare of our most precious commodities, our consumers is not compromised.

Because it is practically impossible to determine lead content of an installed fixture, fitting or pipe, it should be assumed that the manufacture or installation date is the primary indicator of the lead content. Therefore, the characteristics would be buildings and piping solder or fixtures would be buildings in Ohio built prior to 1998 or that use plumbing material or solder manufactured before 1998 may have materials with greater than 8% lead and are at a higher risk of contributing lead to the drinking water than materials manufactured after 1998. In addition, buildings built and plumbing materials manufactured after 2014 were required to have less than 0.25% lead by weight and have the lowest risk for contributing lead to the drinking water. It should be noted however that, although prohibited, some use of leaded solder or leaded components may have occurred after the prohibitions became effective.

Eugene F. Davis

Chief Operator

Efdavis2 & Associates LLC

Entity: All Seasons MHP  
Doc Type: REPORT  
Doc Subtype: \_\_\_\_\_  
Program: DDAGW  
County: PORTLAND  
Secondary ID: 286700812

EAST LIVERPOOL ROAD-S.R.14

**SYMBOL LEGEND**

- ⊙ ELECTRICAL METERS
- ⊞ ELECTRIC TRANSFORMER
- ⊙ SANITARY MAN HOLE
- ✕ WATER SHUT-OFF VALVE
- ⬮ FIRE HYDRANT
- WATER SUPPLY LINE
- ▽ GAS METER
- ▬ GAS MAIN
- T TELEPHONE BOX
- C CABLE BOX


KMW II POUS 016700812

— PVC / PLASTIC  
MAINS / WATER TP.


— SERVICE < 2014

— SERVICE > 2014

LC 201	107
LC 202	153
LC 203	143
LC 204	170
LC 205	23

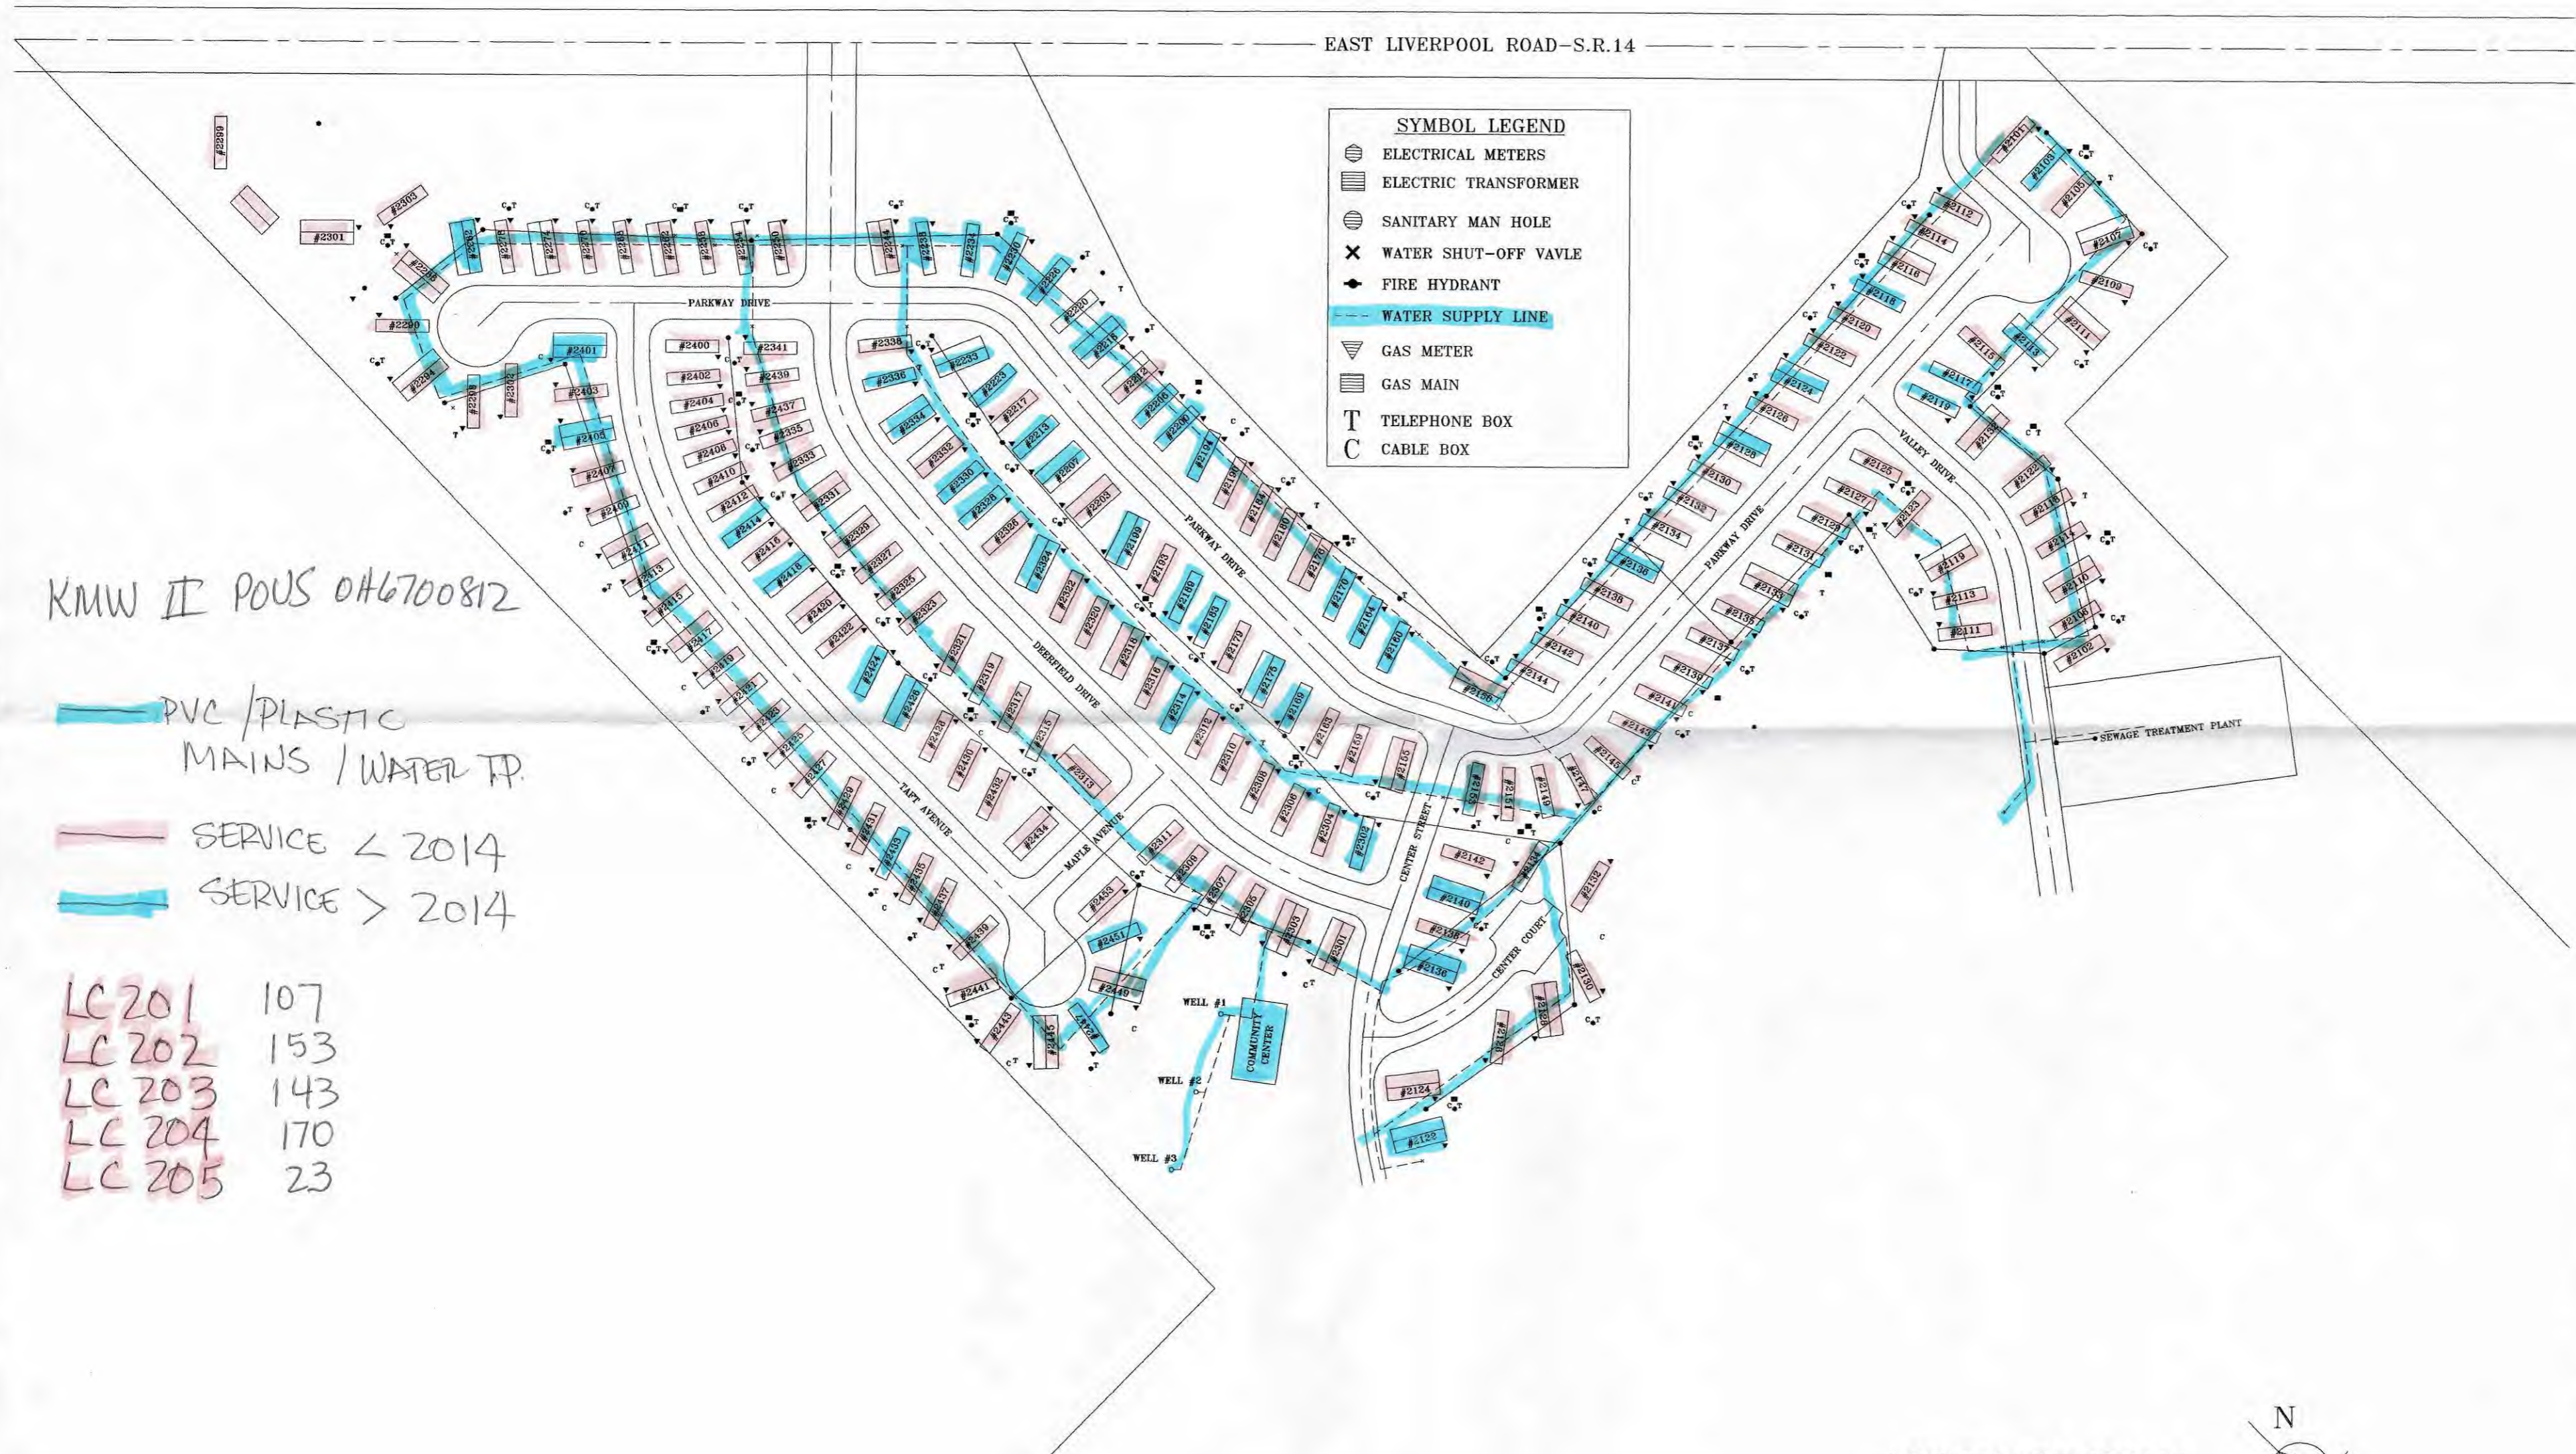

UTILITY LOCATIONS

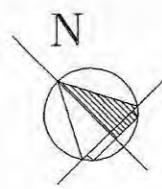

drawing

UTILITY LOCATIONS

project no. \_\_\_\_\_ date AUGUST, 2002 scale AS NOTED

DEERFIELD ESTATES

FOR : MODERN MANAGEMENT  
5108 STATE ROUTE #59  
RAVENNA, OHIO

project

**A1**

sheet no.

RECEIVED

MAR 07 2017

OHIO EPA NEDO