

Dean's Backflow Service Inc.
16387a Twp Road 454
Loudonville, Ohio
(419) 651-0142

This is for Holmes County Jail:

The county home service line was replaced when the new jail was constructed. The County Home is changing internal plumbing to pex and there is three lines that are still galvanized.


“Buildings in Ohio built prior to 1998 or that use plumbing material or solder manufactured before 1998 may have materials with greater than 8% lead and are at a higher risk of contributing lead to the drinking water than materials manufactured after 1998. In addition, buildings built and plumbing materials manufactured after 2014 were required to have less than 0.25% lead by weight and have the lowest risk for contributing lead to the drinking water. It should be noted however that, although prohibited, some use of leaded solder or leaded components may have occurred after the prohibitions became effective.”

Thank You!
Kevin Dean, Operator


RECEIVED
MAR 31 2011
BY:

ALL COPPER



Entity: Holmes County Jail
Doc Type: Repair
Doc Subtype: _____
Program: DDAUN
County: Holmes
Secondary ID: 063800512
eDoc in color

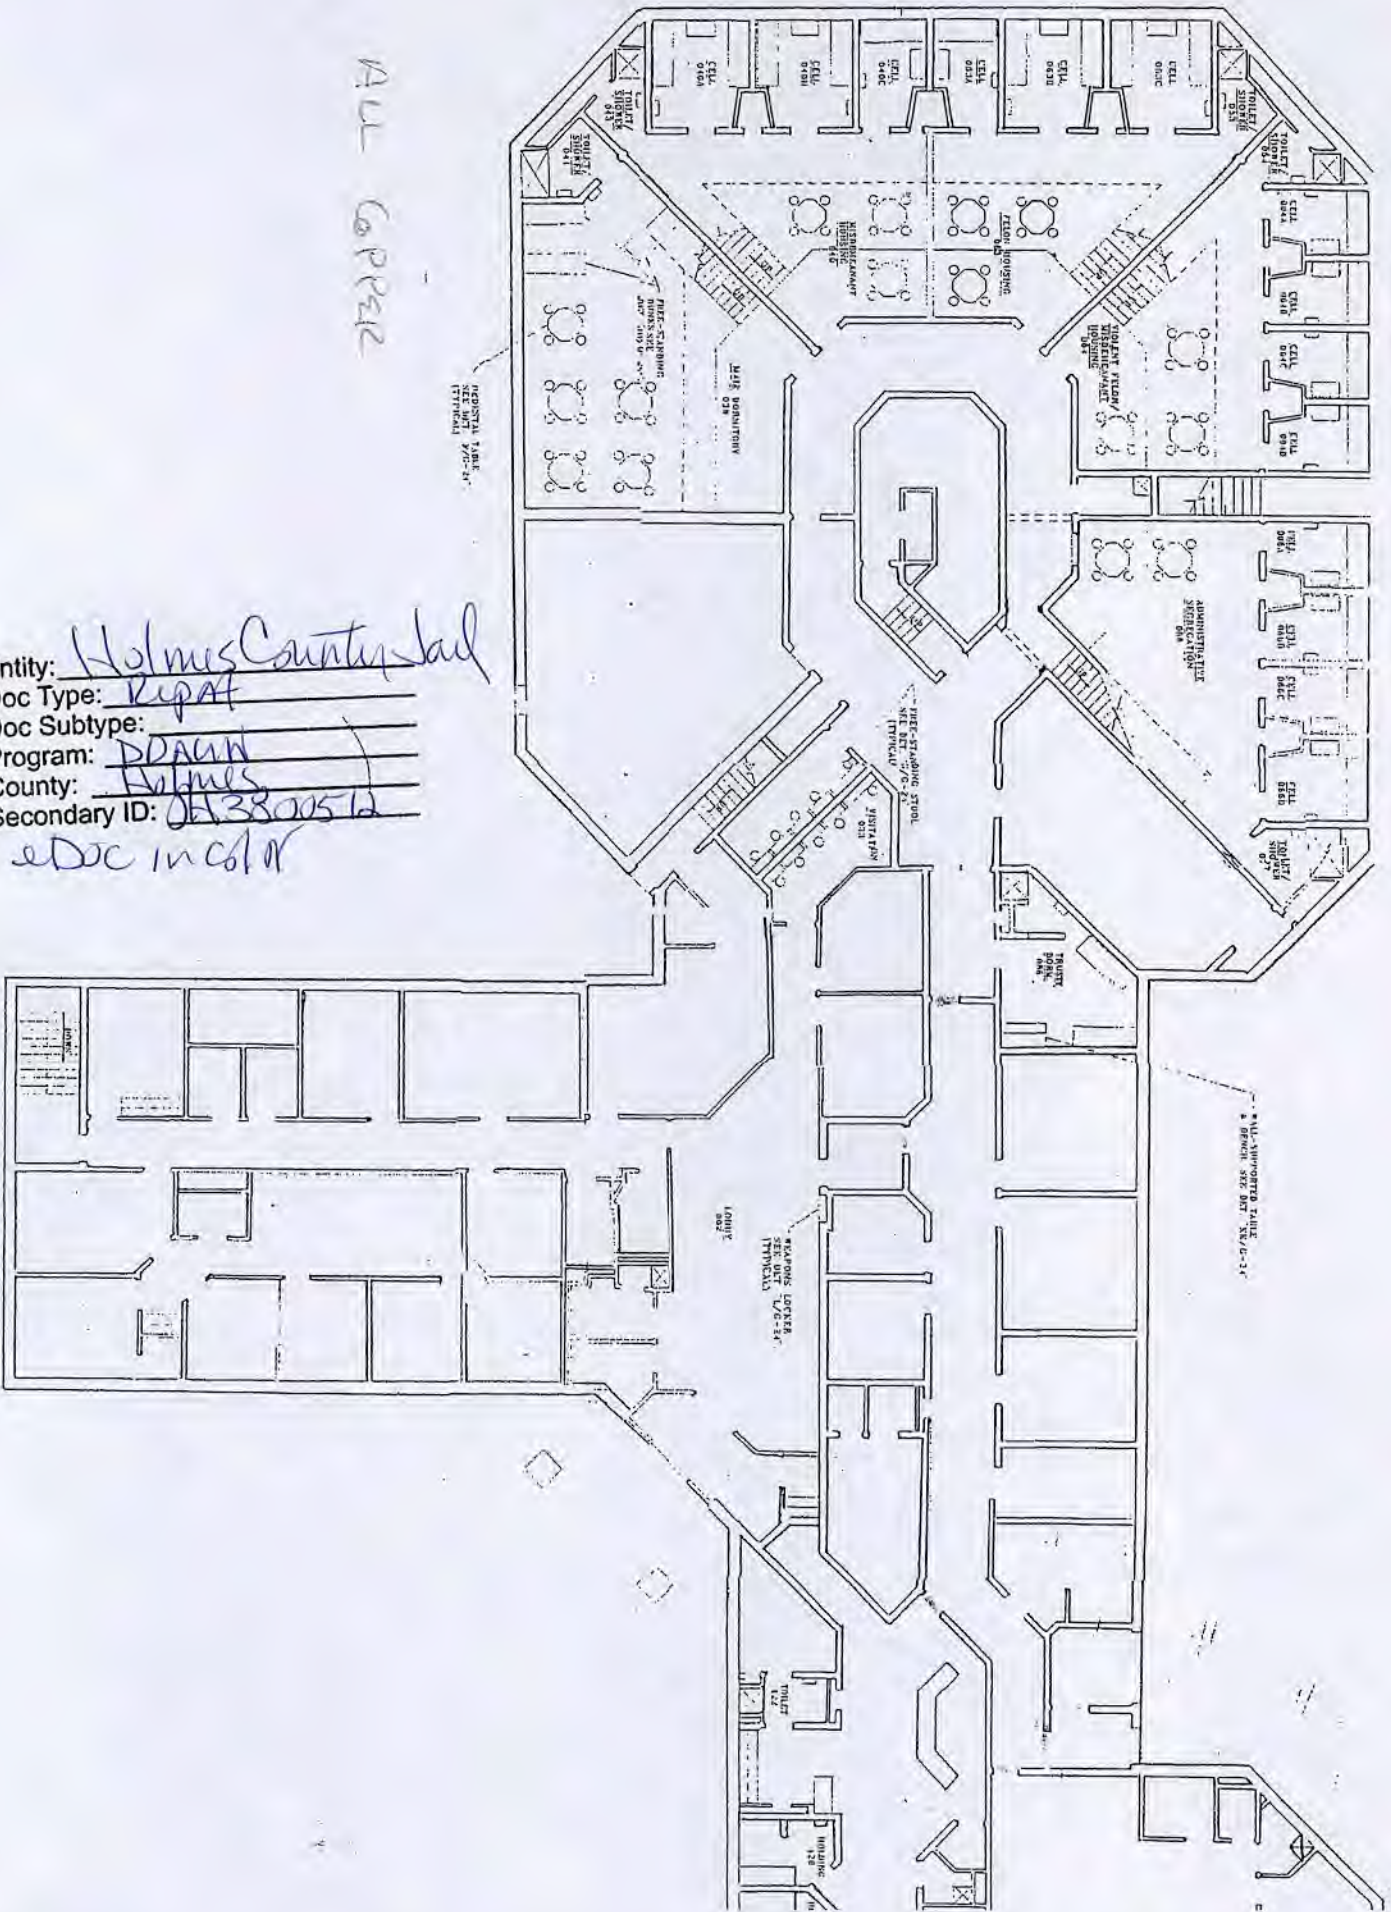


LOWER LEVEL FLOOR PLAN

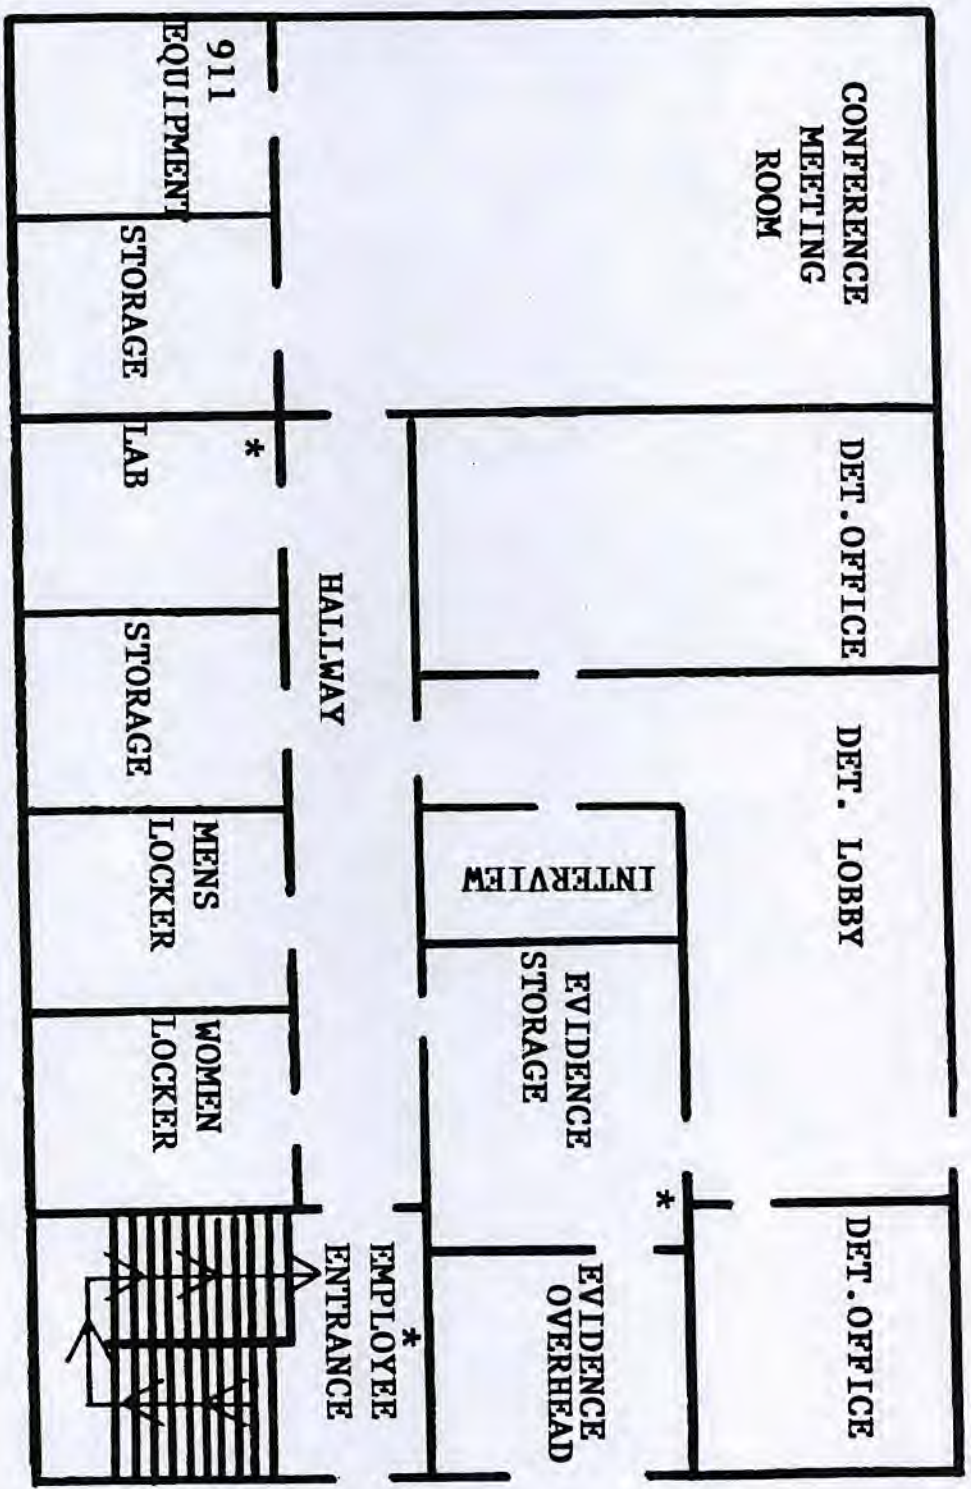

* FIRE EXTINGUISHER LOCATION

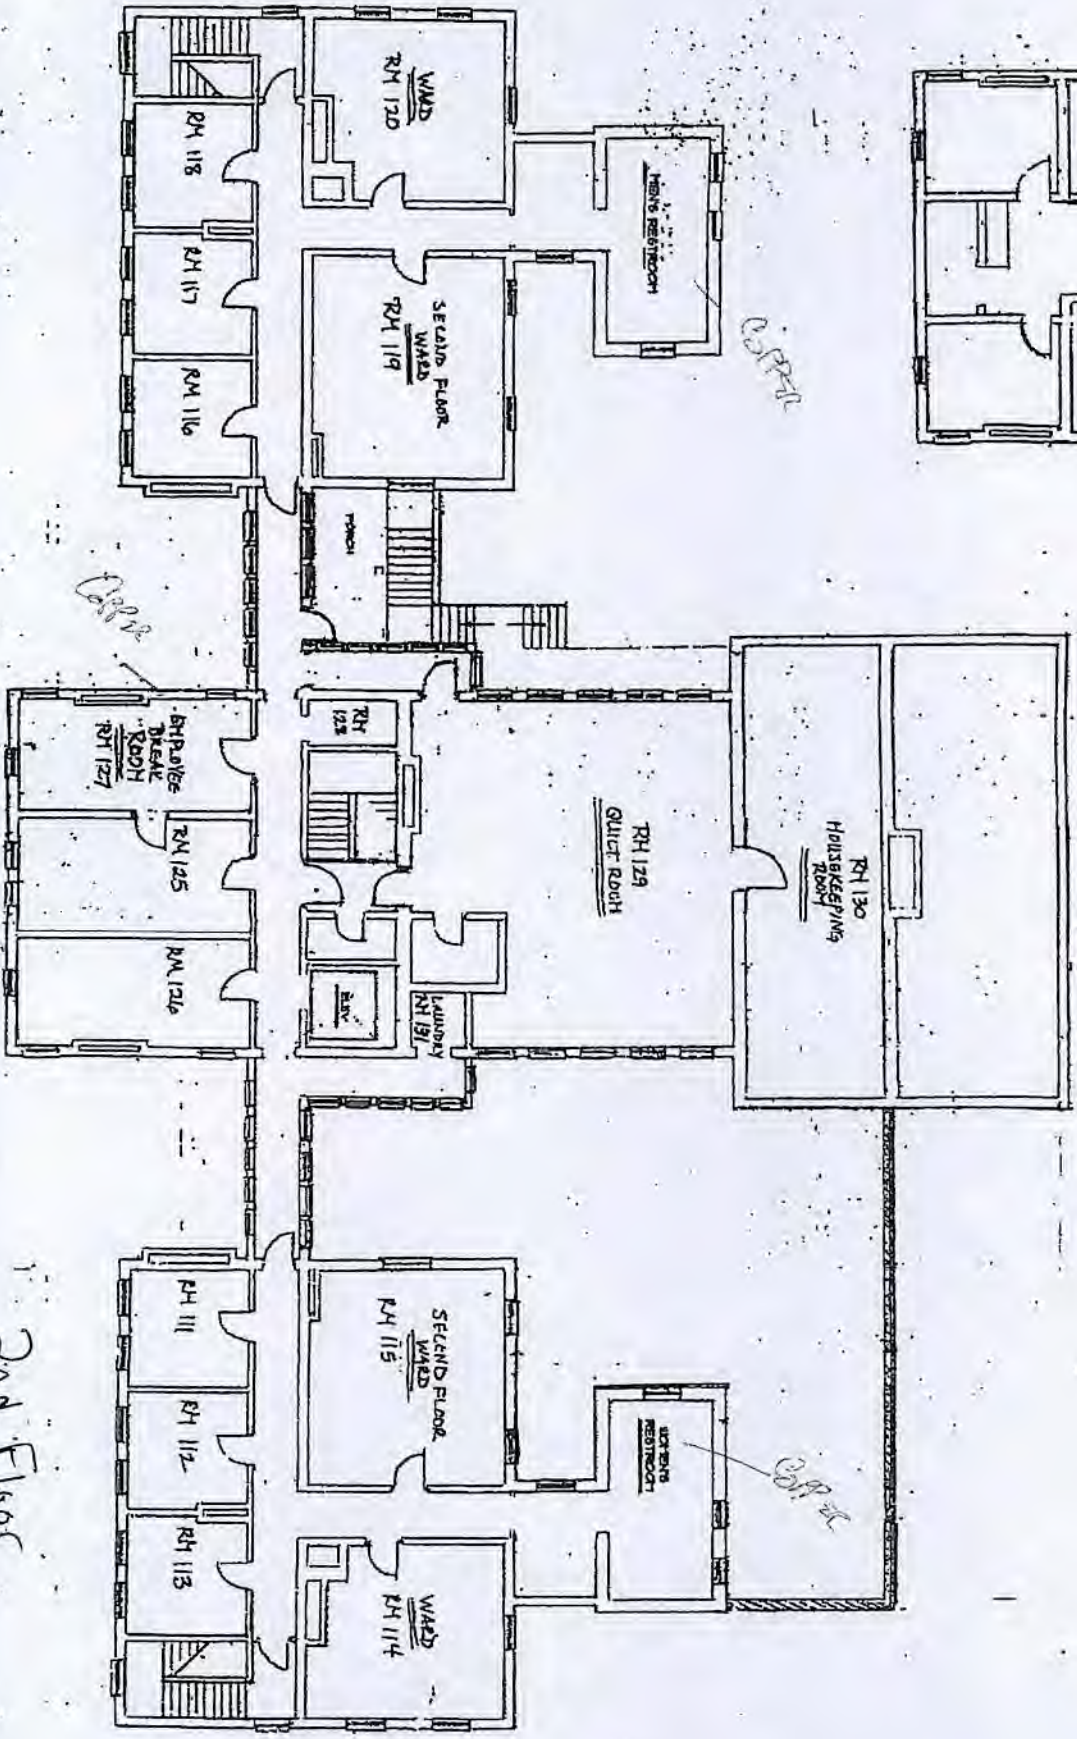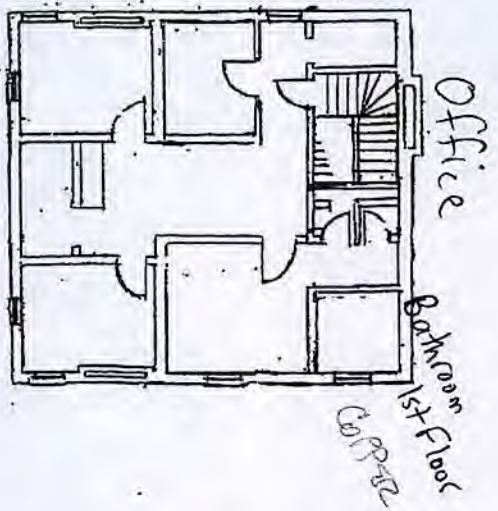

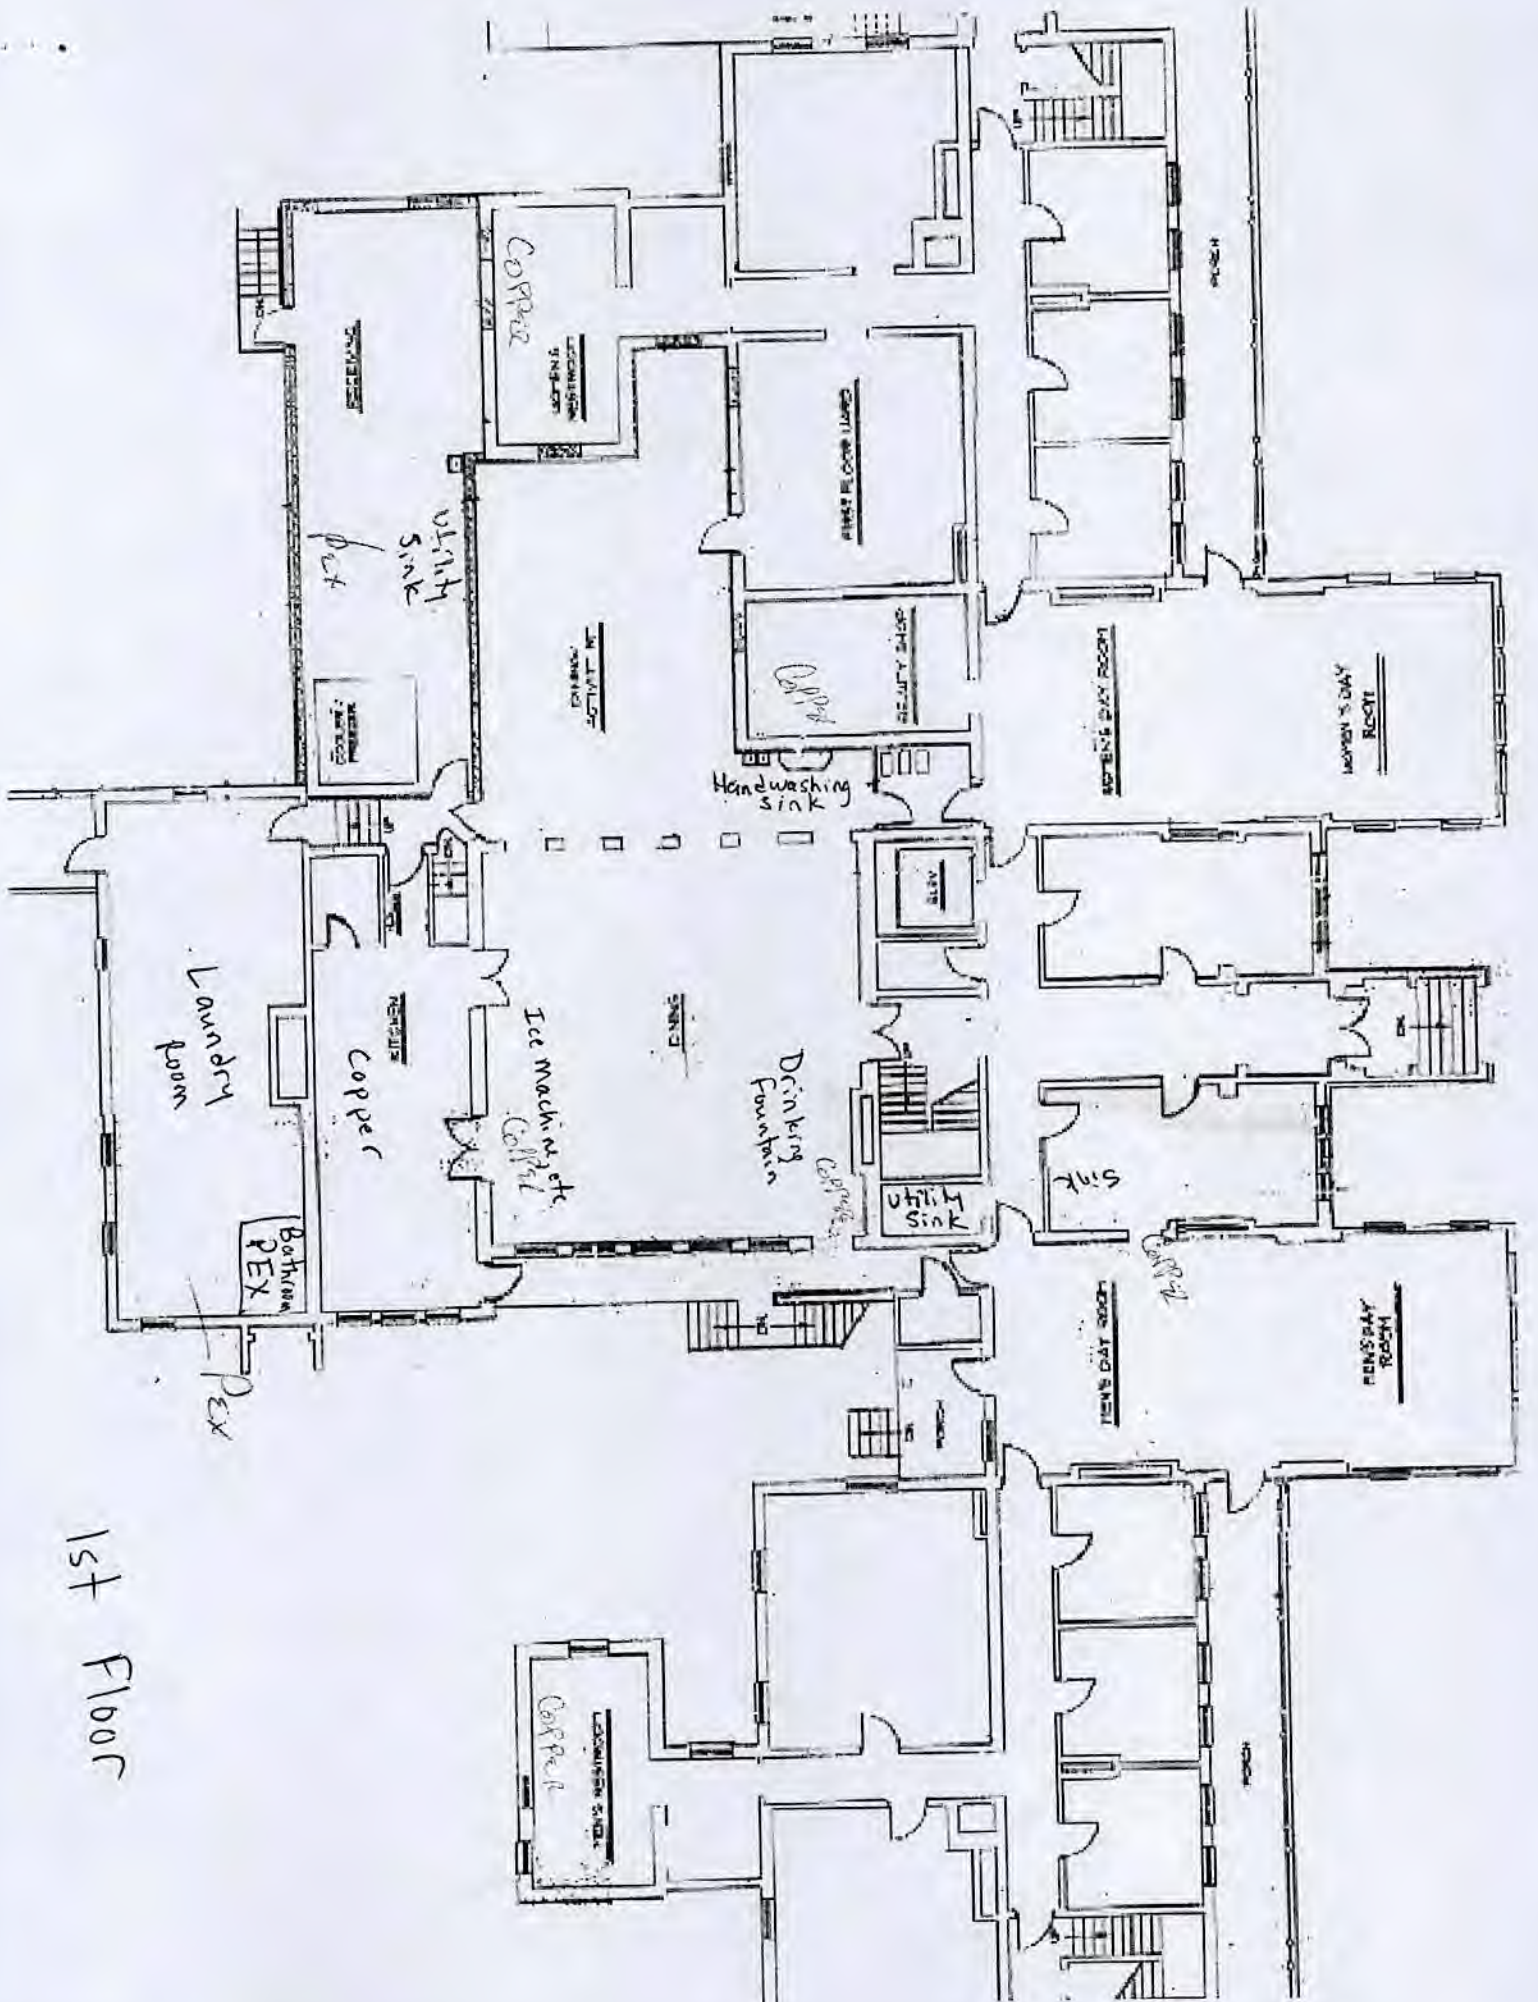

1st Floor