

Mr. Dependable Pump
 John M. Roth & Sons, Inc.
 6200 Manchester Rd. / New Franklin, OH 44216
 Ohio Private Water System License #0131 / EPA Class A /1
 330-882-4111 / f. 330-882-6778

July 27, 2017

Re: Top o' the Hill
 PWS# OH7603912

To Whom it May Concern;

Approximate date of service line replacement was about 12 years ago, and is PVC.

"Buildings in Ohio built prior to 1998 or that use plumbing material or solder manufactured before 1998 may have materials with greater than 8% lead and are at a higher risk of contributing lead to the drinking water than materials manufactured after 1998. In addition, buildings built and plumbing materials manufactured after 2014 were required to have less than 0.25% lead by weight and have the lowest risk for contributing lead to the drinking water. It should be noted however that, although prohibited, some use of leaded solder or leaded components may have occurred after the prohibitions became effective."

Sincerely,

William Roth, Sr.
 Owner
 330-819-9638

RECEIVED
 JUL 28 2017

Entity: _____
 Doc Type: Report
 Doc Subtype: Lead Mapping
 Program: _____
 County: _____
 Secondary ID: 0177603912

BY:

add to eDR 586842

**VERIFICATION FORM FOR COMMUNITY PUBLIC WATER SYSTEMS
CLAIMING NO LEAD SERVICE LINES**

The owner or operator of all community public water systems must identify and map areas of their distribution system that are known or are likely to contain lead service lines. Systems must submit a copy of the applicable map to the Ohio Department of Health and the Ohio Department of Job and Family Services. Systems must also submit a report to the director containing at least both of the following: (1) The applicable map with narrative, and (2) A list of sampling locations used to collect samples as required by Ohio Revised Code (ORC) Section 6109.121 and any rules adopted thereunder, including contact information for the owner and occupant of each sampling site.

Should a water system determine no lead service lines exist in their distribution system, they must provide information stating they reviewed, at the minimum, historical permit records and local ordinances, distribution maintenance records and information pertaining to installation dates or materials for all services lines. This information must be verified below.

I HEREBY CERTIFY THAT THE FOLLOWING METHOD(S) WERE USED TO DETERMINE NO LEAD SERVICE LINES EXIST IN THIS WATER SYSTEM'S DISTRIBUTION SYSTEM, AS REQUIRED BY ORC 6109.121(F):

LEAD SERVICE LINE VERIFICATION	
<p>This PWS states they have no lead service lines and has reviewed the following information (select one or more of the following):</p>	
<input type="checkbox"/>	Historical permit records and/or local ordinances
<input type="checkbox"/>	Distribution maintenance records (i.e. meter replacement, waterline break repairs)
<input type="checkbox"/>	Information pertaining to installation dates for all service lines (i.e. after 1986 when lead services lines were banned)
<input checked="" type="checkbox"/>	Service line material of all service lines is known (i.e. all service lines are known to be PVC)

William L. Roth Sr 7-27-17
 Signature of Responsible Person Date

William L. Roth Sr Class 4
 Printed Name and Title of Responsible Person

PWS NAME: Top O Hill
 PWS ID: OH 2603912-
 COUNTY: Stark

<p>For Ohio EPA use only:</p> <p>Date Verification Rec'd: _____</p>
--

RECEIVED
 JUL 28 2017
 BY: _____

Lead Mapping

Top of The Hill
Community
4287 Mandator Avenue, NW
North Lawrence, Ohio 44666

330 7155860 Jacob GRINN owner

OH 7603912
Facility ID 7658301

William L. Roth Sr
Operator

John M. Roth + Sons Inc
DBA Mr Dependable pump
6200 Manchester Rd
New Franklin Ohio 44216


330 8824111
FAX 330 8826778
Cell 330 819 9638
E. NAPI Mr Dependable pump @ SBC Global. Net

I Have included another Business Supplied
By This water, will need discuss
if Necessary

"FAT ABBEYS"
4291 Manchester Rd. NW
North Lawrence, Ohio 44666
330 837 4330

Water Supply Equipment
is located in Bar
but Also Feeds Top of
The Hill Trailer Park

N 1

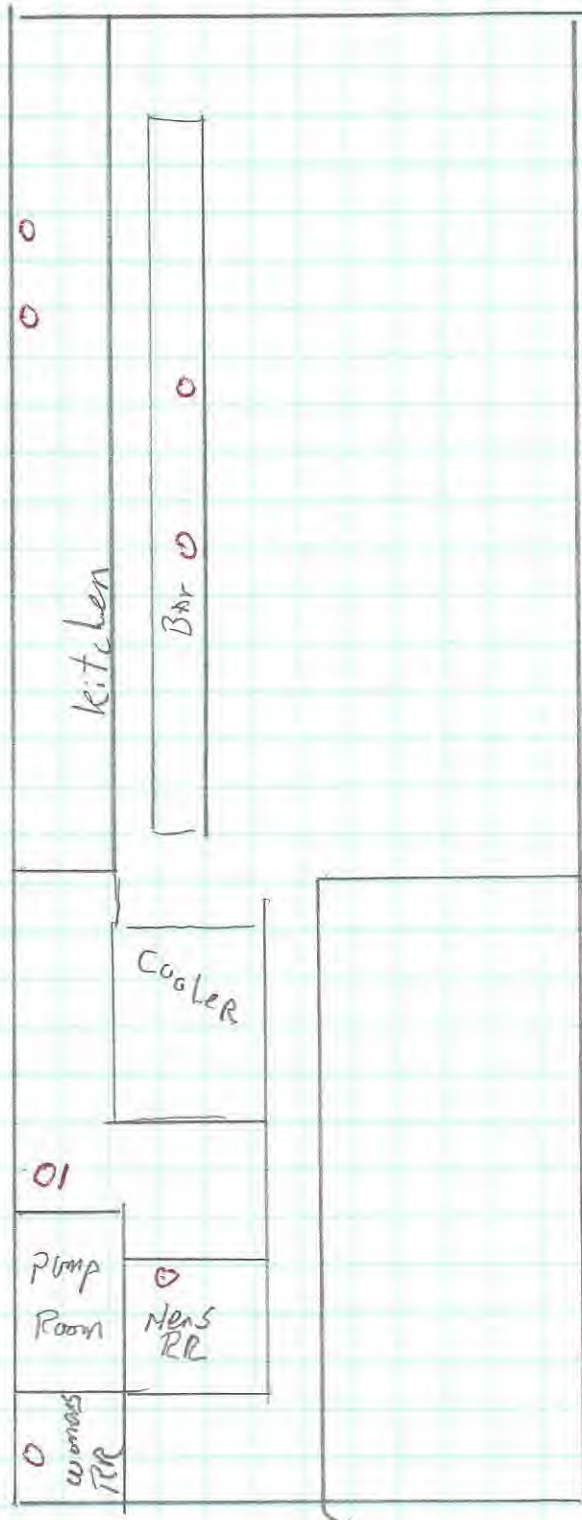

FPT Abbeys BAR
NOT INCLUDED UTIL!
Now.
0 Sink
01 Utility Sink.

Google Maps



Imagery ©2017 Google, Map data ©2017 Google 50 ft

Access To individual Homes Are completely at The Choice of owners
 No Normal Test Ports For Lead Testing, This is why I included
 Abby's Not Asked For

• 19 care taker