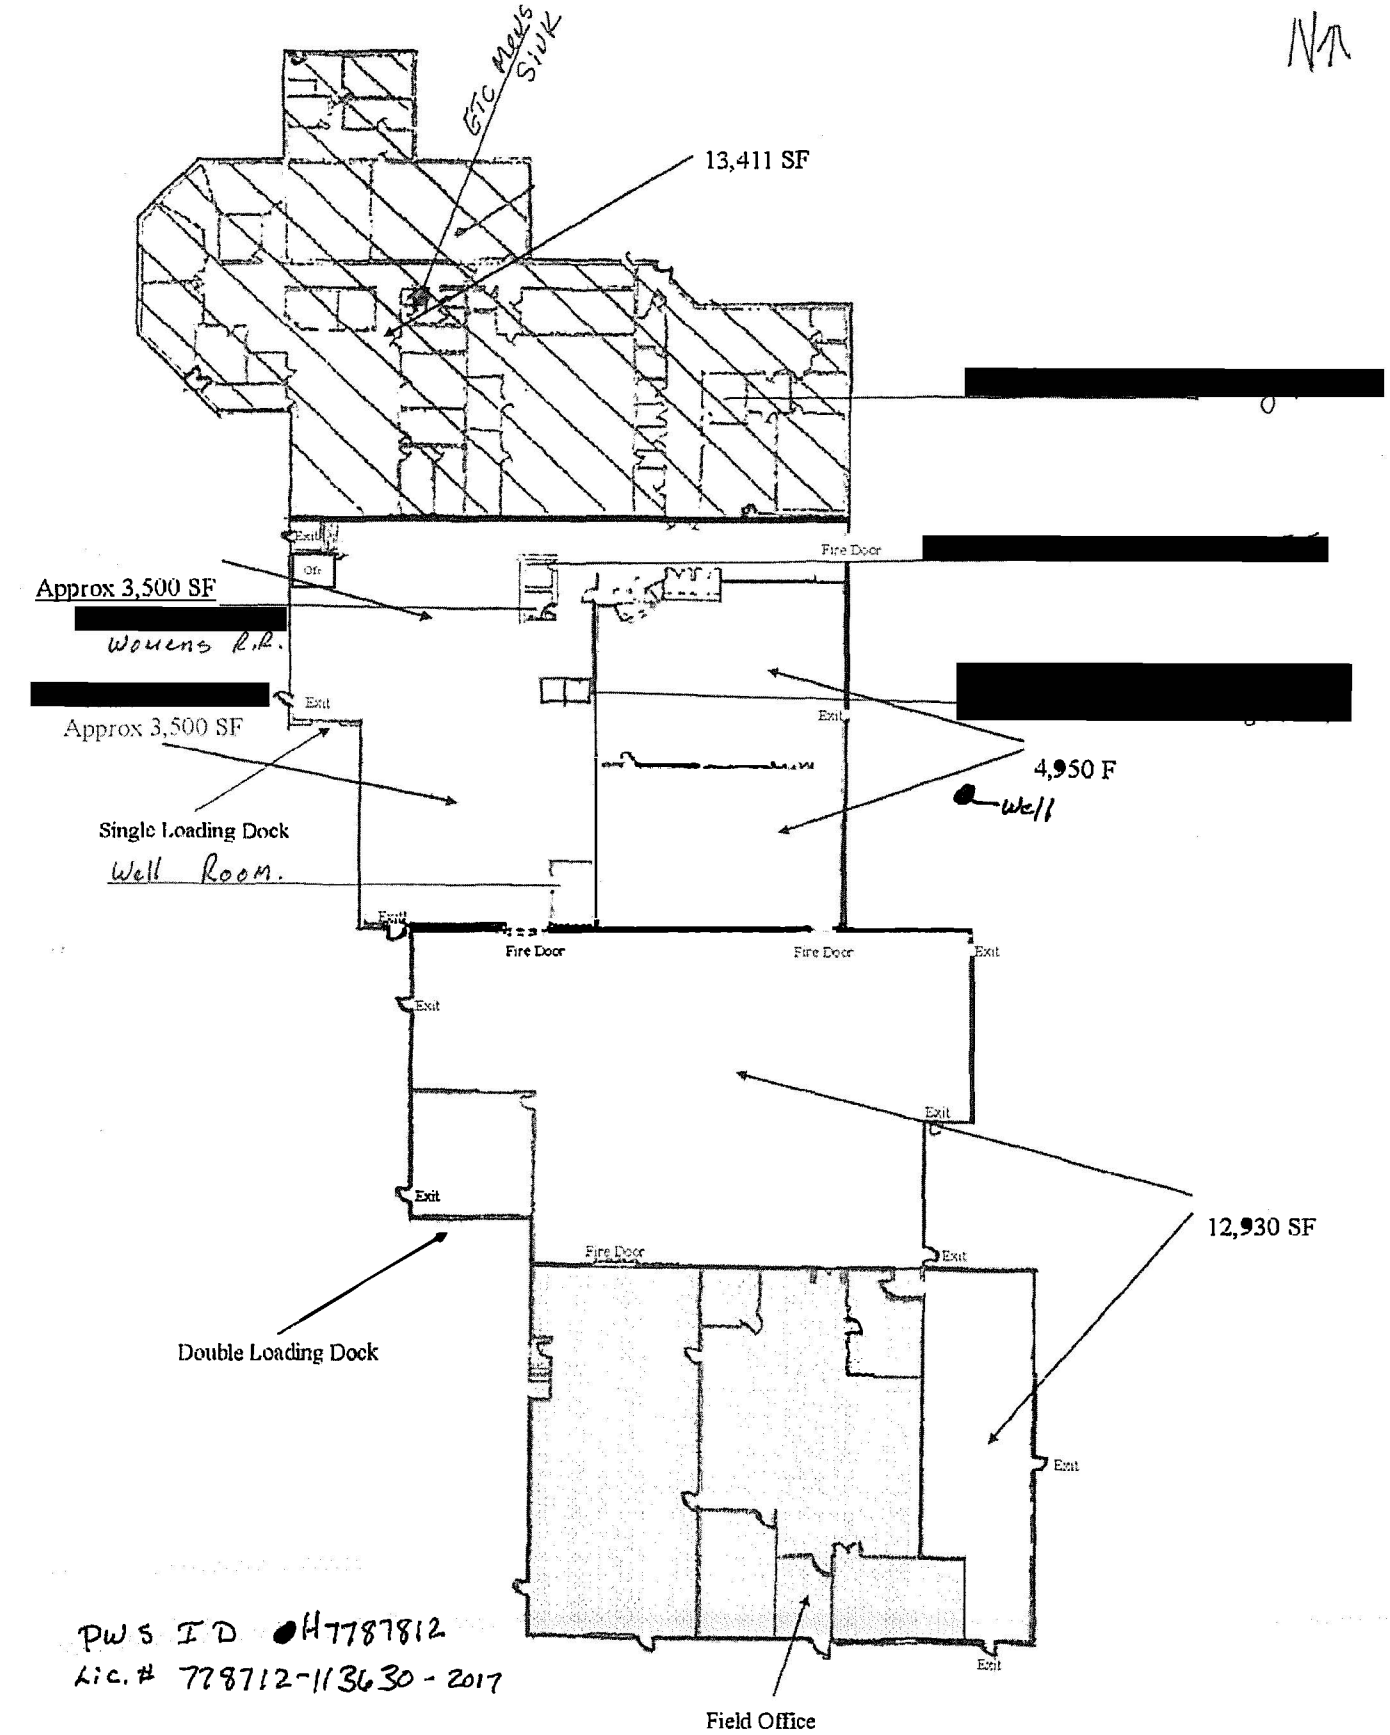
NA
GTC Mens Sink
13,411 SF
[redacted]
Exit
Off
Fire Door
[redacted]
Approx 3,500 SF
[redacted]
Womens R.R.
[redacted]
Exit
Exit
Approx 3,500 SF
4,950 F
Well
Single Loading Dock
Well Room.
Exit
Fire Door
Fire Door
Exit
Exit
Exit
Exit
12,930 SF
Fire Door
Exit
Double Loading Dock
Exit
Exit
PWS ID #H7787812
Lic. # 778712-113630-2017
Field Office
EASTERN Rd.
State Route 21