

ALL BUILDINGS
CONSTRUCTED BEFORE 1986

WATER LINE CONSTRUCTION:
NO INFORMATION GREY

STOCK EQUIPMENT COMPANY
16490 CHILLICOTHE ROAD
CHAGRIN FALLS, OH 44023
440-543-6000

UNLESS OTHERWISE SPECIFIED			REF. DWG. ---	NEXT ASSY. ---	S.O. NO. ---
DECIMAL DIMENSIONS	3/32	0.00	INFORMATION CONTAINED ON THIS DRAWING IS CONFIDENTIAL AND PROPRIETARY TO STOCK EQUIPMENT COMPANY AND MAY NOT BE REPRODUCED OR USED WITHOUT THE EXPRESS WRITTEN CONSENT OF STOCK EQUIPMENT COMPANY		
FRACTIONAL DIMENSIONS	1/16	0.0625	PART NO. _____		
ANGLE DIMENSIONS	1/16	0.0625	MATL. _____		
BURNOUT DIMENSIONS	1/16	0.0625	QTY. _____		
MAX. SURFACE ROUGHNESS FOR BURNOUT SURFACES	125	0.0007			
MAX. SURFACE ROUGHNESS FOR ALL OTHER SURFACES	63	0.00035			
DEFINITIONS AND BREAK ALL SHARP EDGES AND CORNERS (REQUIREMENTS FOLLOWING: PER ANSI Y14.5)					
REVISION	PREPARED BY	DATE	STOCK EQUIPMENT COMPANY		
1	CHACKIEWICZ	3-2-2017	16490 Chillicothe Road Chagrin Falls, Ohio 44023 www.stockequipment.com 440-543-6000		
CAD FILE: d46900.dwg			stock		
PREPARED BY: CHACKIEWICZ			SHEET 1 OF 2		
CHECKED BY: HILSCH			SHEET SIZE D		
DATE: 3-2-2017			D46900		
			REV 0		

8 7 6 5 4 3 2 1

D

D

C


C

B


B

A

A

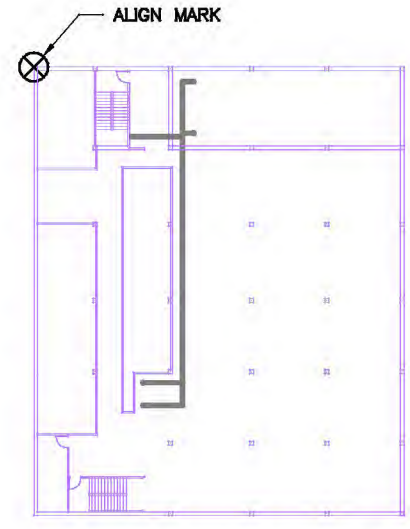

**FRONT BUILDING ALPHA
SECOND FLOOR**

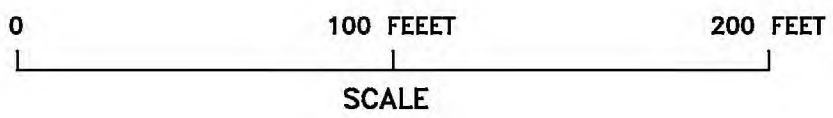

STOCK EQUIPMENT COMPANY
 16490 CHILLICOTHE ROAD
 CHAGRIN FALLS, OH 44023
 440-543-8000

UNLESS OTHERWISE SPECIFIED			REF. DWG. -----	NEXT ASSY. -----	S.O. NO. -----
DECIMAL DIMENSIONS	3/16	±.005	INFORMATION CONTAINED ON THIS DRAWING IS CONFIDENTIAL AND PROPRIETARY TO STOCK EQUIPMENT COMPANY AND MAY NOT BE REPRODUCED OR USED WITHOUT THE EXPRESS WRITTEN CONSENT OF STOCK EQUIPMENT COMPANY		
FRACTIONAL DIMENSIONS	1/16	±.001	PART NO.	PLUMBING MAPPING FOR INDIVIDUAL BUILDINGS	
ANGLE DIMENSIONS	1/16	±.005	MATL.	STOCK EQUIPMENT COMPANY	
BURNOUT DIMENSIONS	1/16	±.005	QTY. -----	CHAGRIN FALLS, OH 44023	
MAX. SURFACE ROUGHNESS	125	✓	SHEET SHEET SIZE D46900 REV		
TOP SURFACE SURFACES	125	✓	2 OF 2 D 0		
MAX. SURFACE ROUGHNESS FOR BURNOUT SURFACES	125	✓	stock		
DESIGNS AND BREAK ALL SHARP EDGES AND CORNERS (REMARKS TOLERANCE PER ANSI Y14.5)					
REVISION	PREPARED BY	DATE	Stock Equipment Company		
REMOVED PART IS INTERCHANGEABLE WITH ORIGINAL	d46900.dwg		16490 Chillicothe Road		
	PREPARED BY: CIECKIEWICZ		Chagrin Falls, Ohio 44023		
	CHECKED BY: HRUSCH		www.stockequipment.com		
	DATE: 3-2-2017		440-543-8000		

8 7 6 5 4 3 2 1