


North

SOUTH APPLE CREEK ROAD

SOUTH APPLE CREEK ROAD

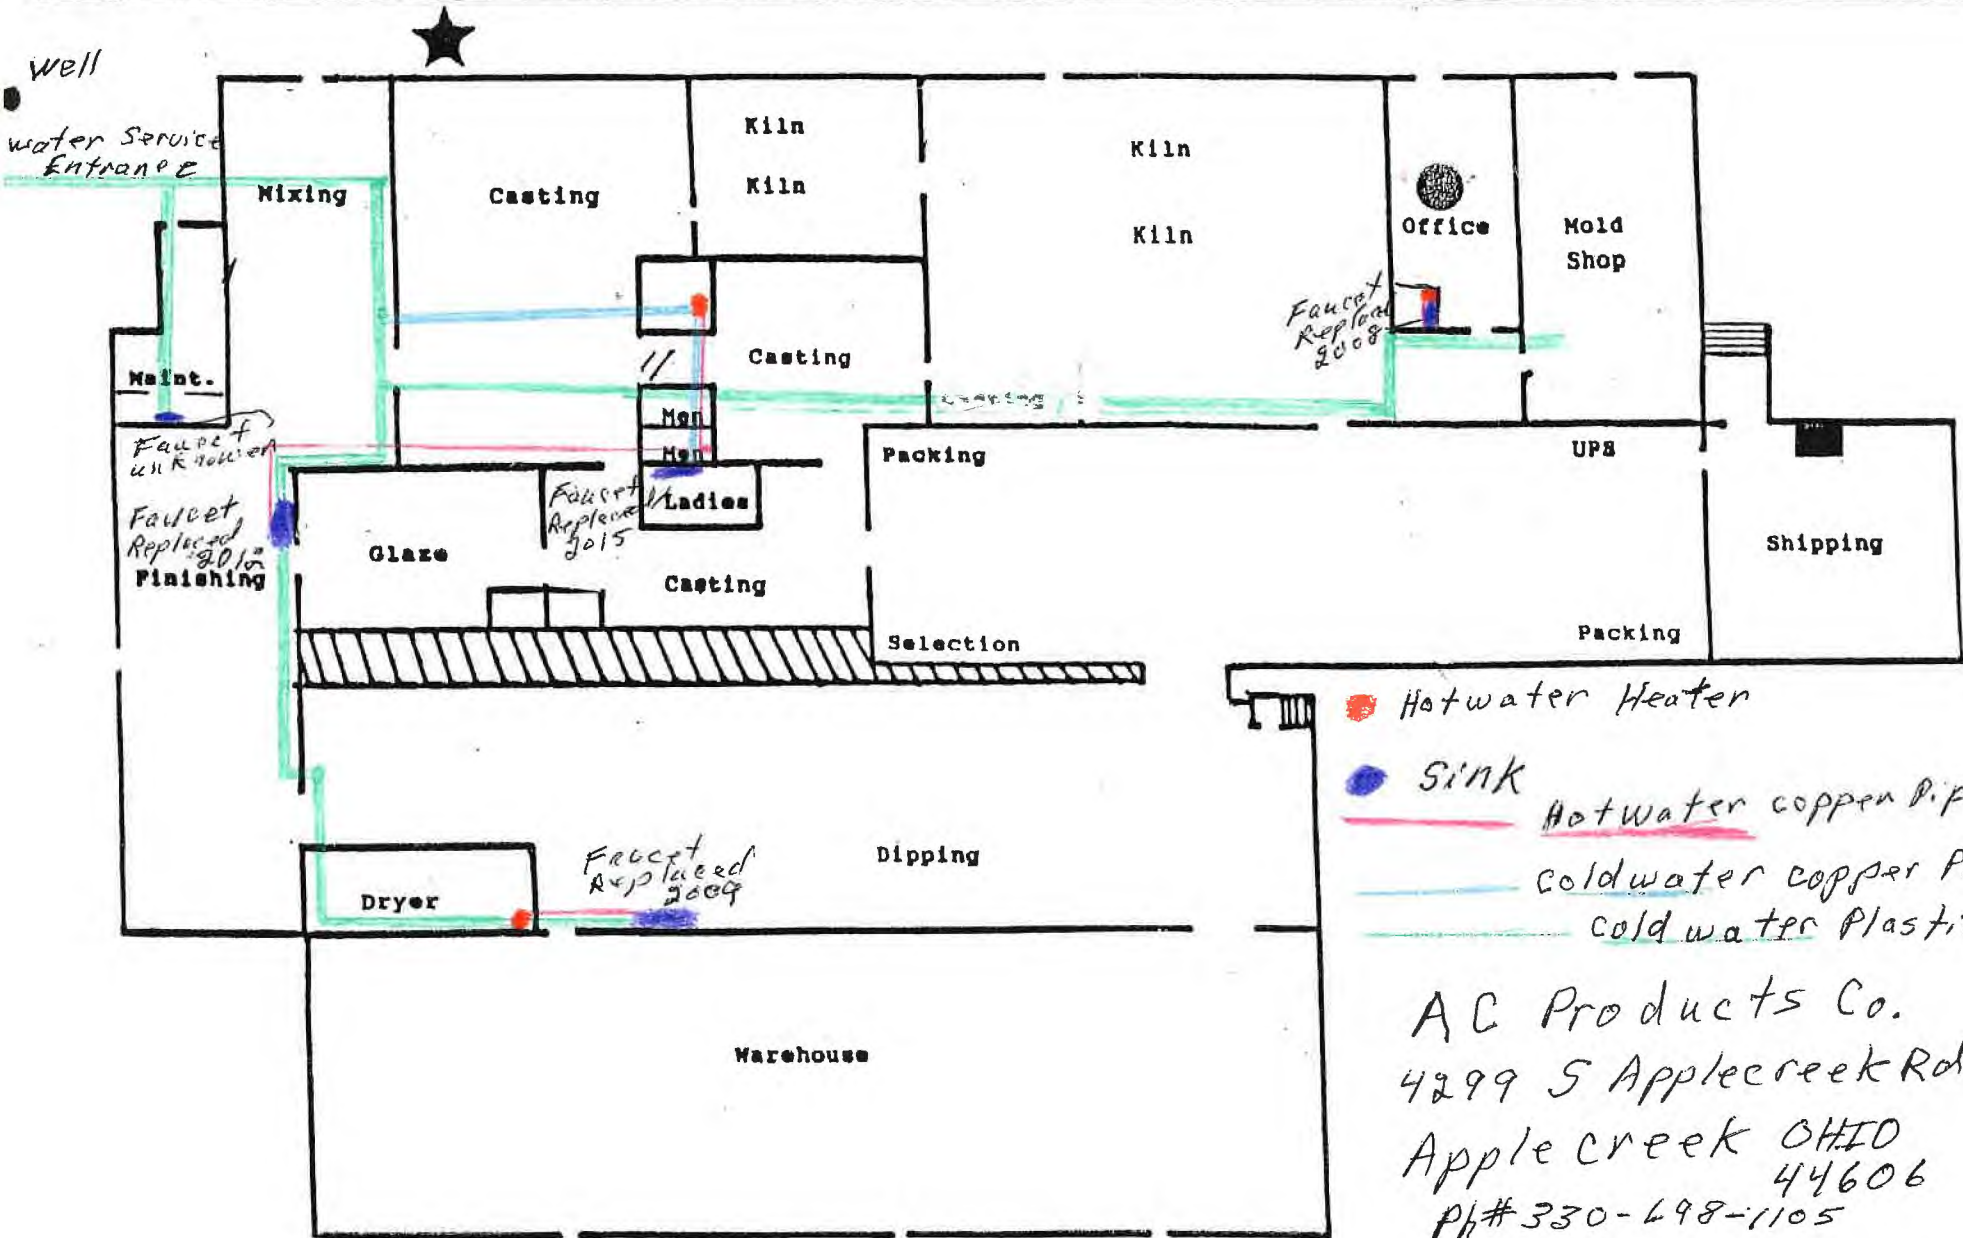

- Hotwater Heater
- Sink
- Hotwater copper Pipe
- coldwater copper Pipe
- coldwater Plastic Pipe

AC Products Co.
 4299 S Applecreek Rd.
 Apple Creek OHIO
 44606
 Ph# 330-698-1105
 PWS ID: DH 8555612