
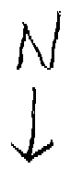


COUNTRY LAWN NURSING HOME & SPERET HALL

EMERGENCY FACILITIES LOCATIONS

- Fire Extinguisher
- Call Box
- X F.A.I.

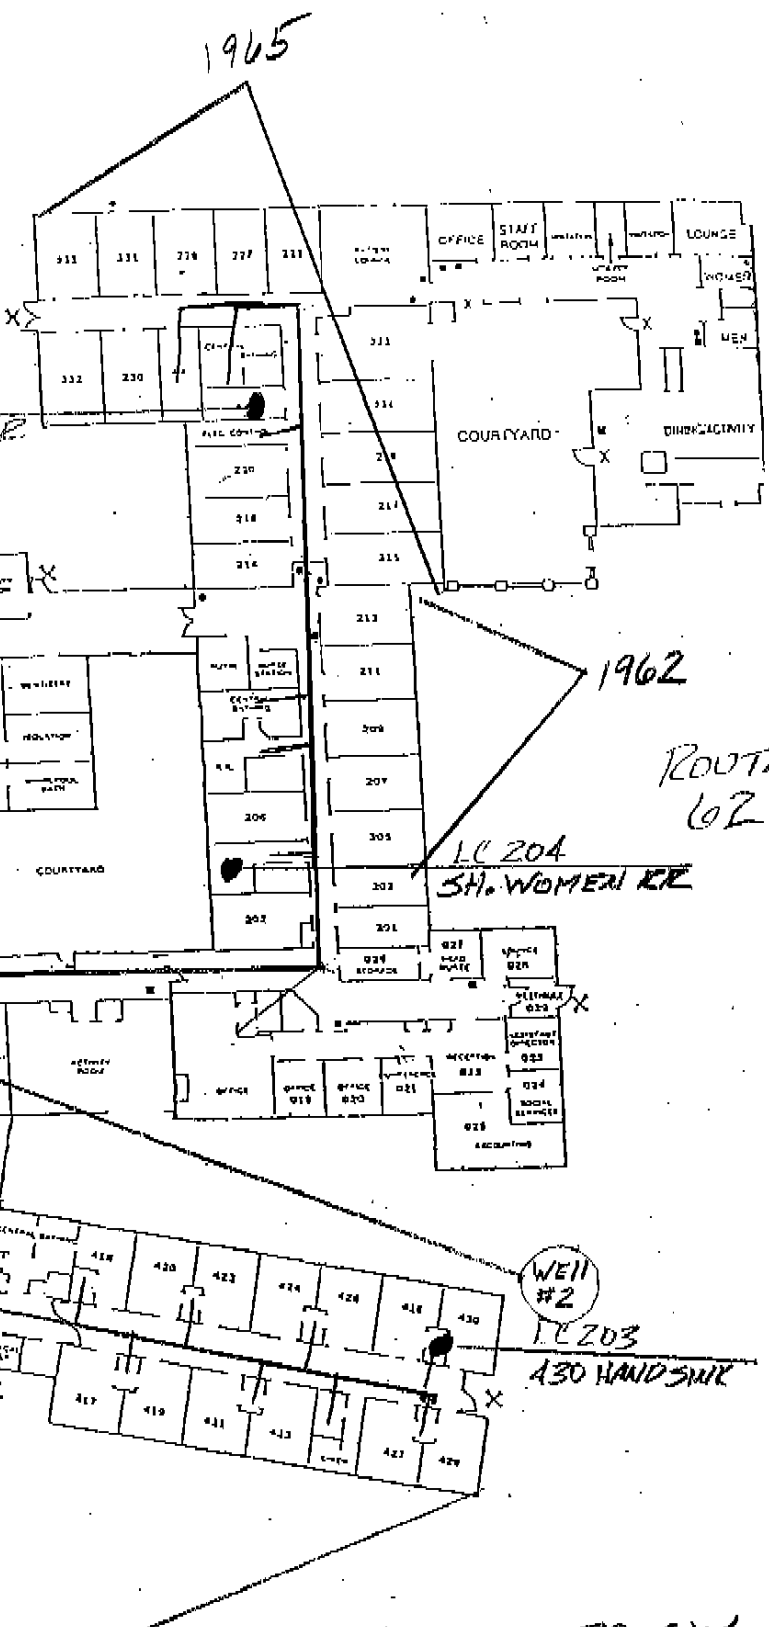

ALL COPPER LINES