


Entity: HARTVILLE ELEMENTARY
 Doc Type: REPORT
 Doc Subtype: _____
 Program: DRINKING WATER
 County: STARKE
 Secondary ID: 047654612

 Sink


 Drinking Fountain

RECEIVED
 MAY 03 2017

BY:

Hartville Elementary Lower Level


Lake Local School District
 Hartville Elementary
 245 Belle Street
 Hartville, OH 44632
 330.877.4278

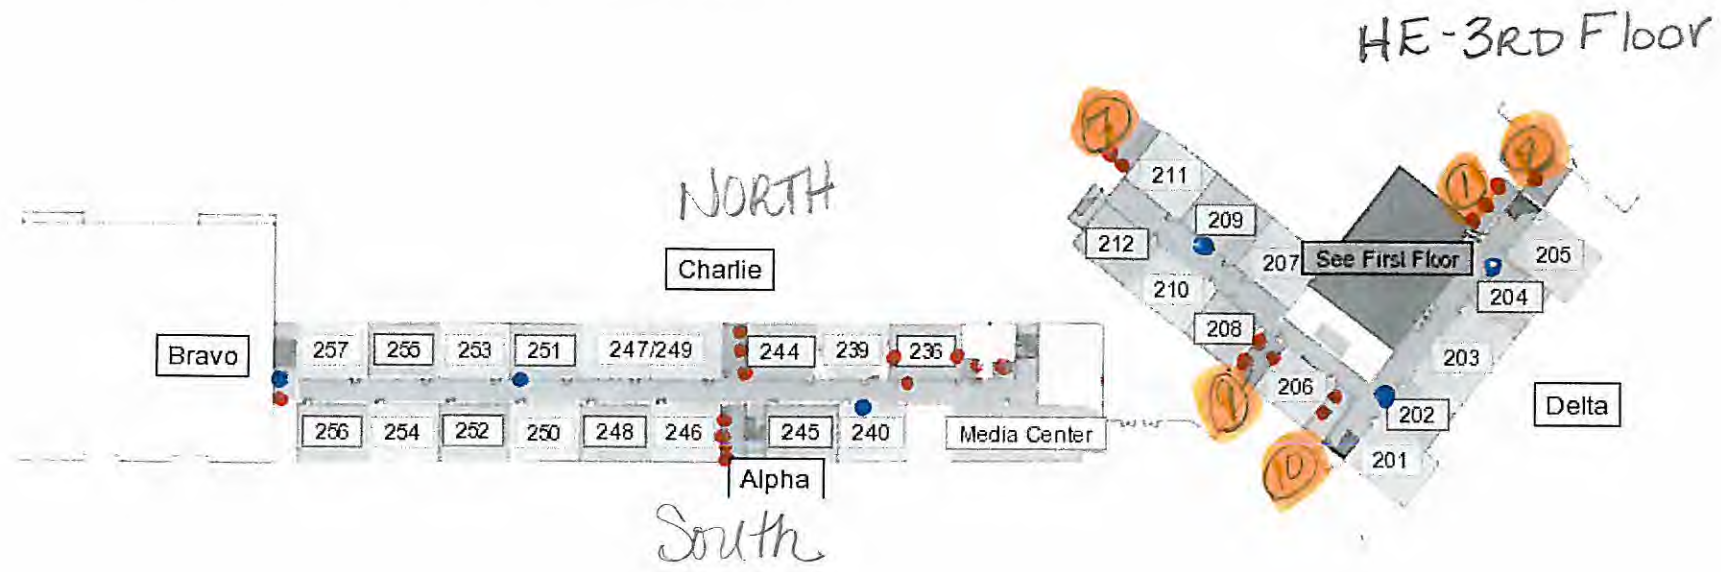

■ Sink
■ Drinking Fountain

OH 7654612
 Lake/Hartsville Elementary 2nd floor
 OH 7654512

Lake Local School District
 Lake Elementary School
 225 Lincoln Street
 Hartville, OH 44632
 330.877.4276

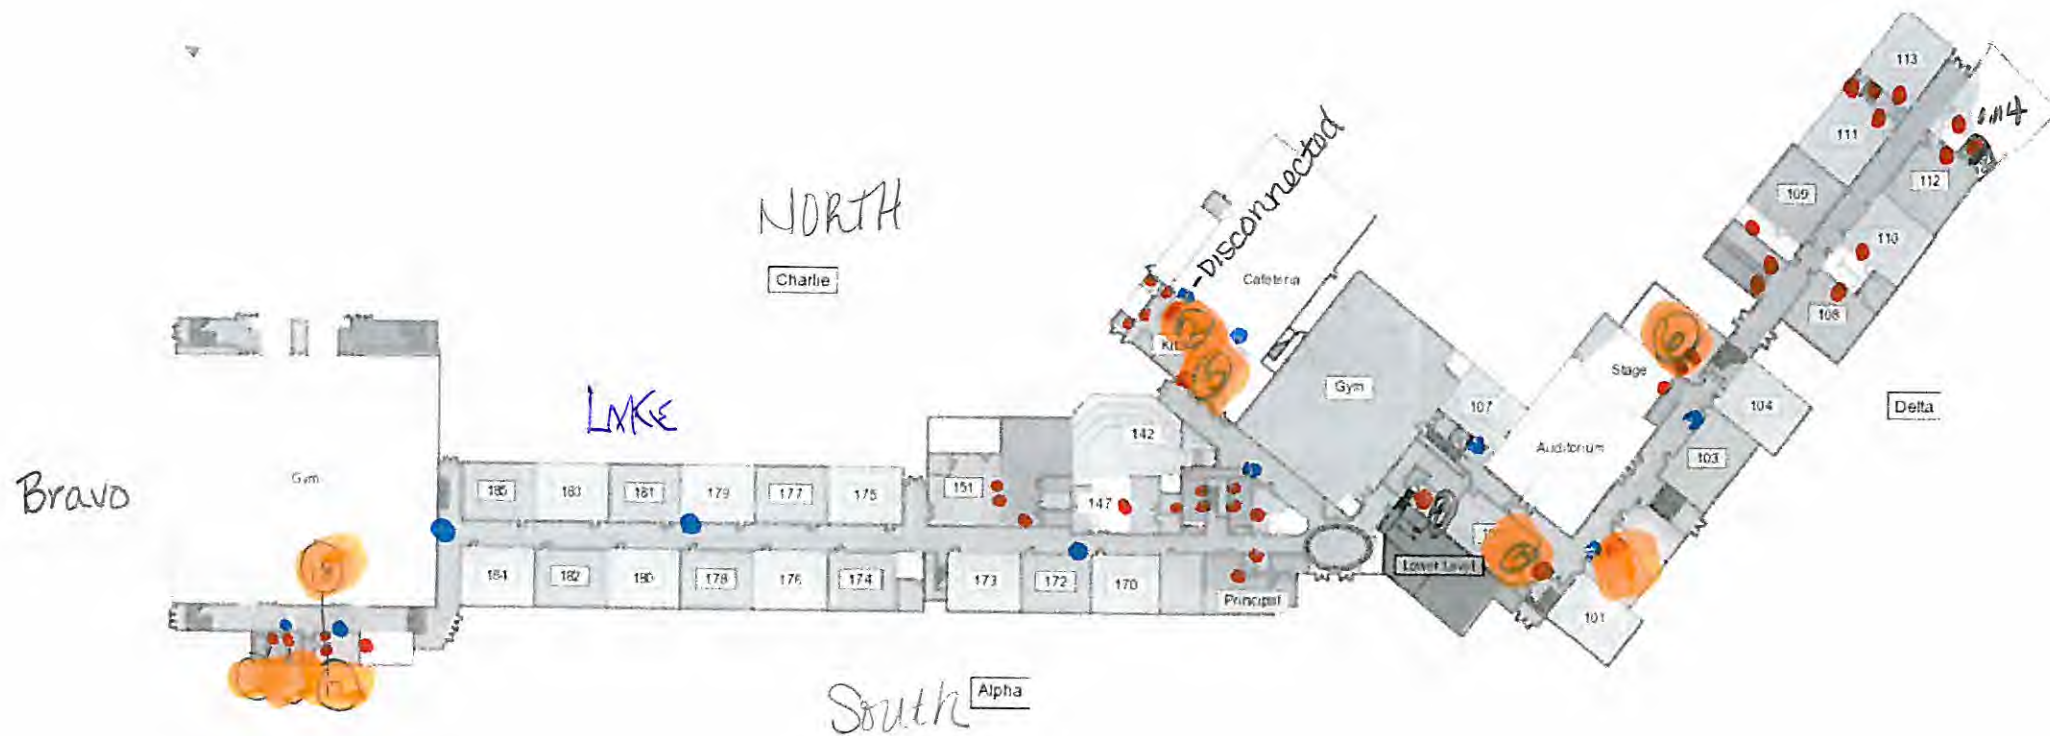

175 176 177 178 179 180 181 182 183 184

- Sink
- Drinking Fountain

04 765 4612
 Lake / Hartville Elementary - 1st floor
 04 765 4512

Lake Local School District
 Lake Elementary School
 225 Lincoln Street
 Hartville, OH 44632
 330.877.4276