

RECEIVED

MAR 02 2017

OHIO EPA NEDO

**VERIFICATION FORM FOR COMMUNITY PUBLIC WATER SYSTEMS
CLAIMING NO LEAD SERVICE LINES**

The owner or operator of all community public water systems must identify and map areas of their distribution system that are known or are likely to contain lead service lines. Systems must submit a copy of the applicable map to the Ohio Department of Health and the Ohio Department of Job and Family Services. Systems must also submit a report to the director containing at least both of the following: (1) The applicable map with narrative, and (2) A list of sampling locations used to collect samples as required by Ohio Revised Code (ORC) Section 6109.121 and any rules adopted thereunder, including contact information for the owner and occupant of each sampling site.

Should a water system determine no lead service lines exist in their distribution system, they must provide information stating they reviewed, at the minimum, historical permit records and local ordinances, distribution maintenance records and information pertaining to installation dates or materials for all services lines. This information must be verified below.

I HEREBY CERTIFY THAT THE FOLLOWING METHOD(S) WERE USED TO DETERMINE NO LEAD SERVICE LINES EXIST IN THIS WATER SYSTEM'S DISTRIBUTION SYSTEM, AS REQUIRED BY ORC 6109.121(F):

LEAD SERVICE LINE VERIFICATION

This PWS states they have no lead service lines and has reviewed the following information (select one or more of the following):

- ☒ Historical permit records and/or local ordinances
- ☒ Distribution maintenance records (i.e. meter replacement, waterline break repairs)
- ☒ Information pertaining to installation dates for all service lines (i.e. after 1986 when lead services lines were banned)
- ☐ Service line material of all service lines is known (i.e. all service lines are known to be PVC)



SCANNED

Elaine Zahurak 3/1/17
Signature of Responsible Person Date

Elaine Zahurak
Printed Name and Title of Responsible Person

PWS NAME: Nelson Ledge Estates
PWS ID: OH 6702412
COUNTY: Portage

For Ohio EPA use only:

Date Verification Rec'd: _____

Entity: Nelson Ledges Estates
Doc Type: Report
Doc Category: DPAGW
Program: Portage
County: Portage
Secondary ID: 6702412


EDA in Color

4

Nelson Ledges Estates

only copper in water plant

water plant

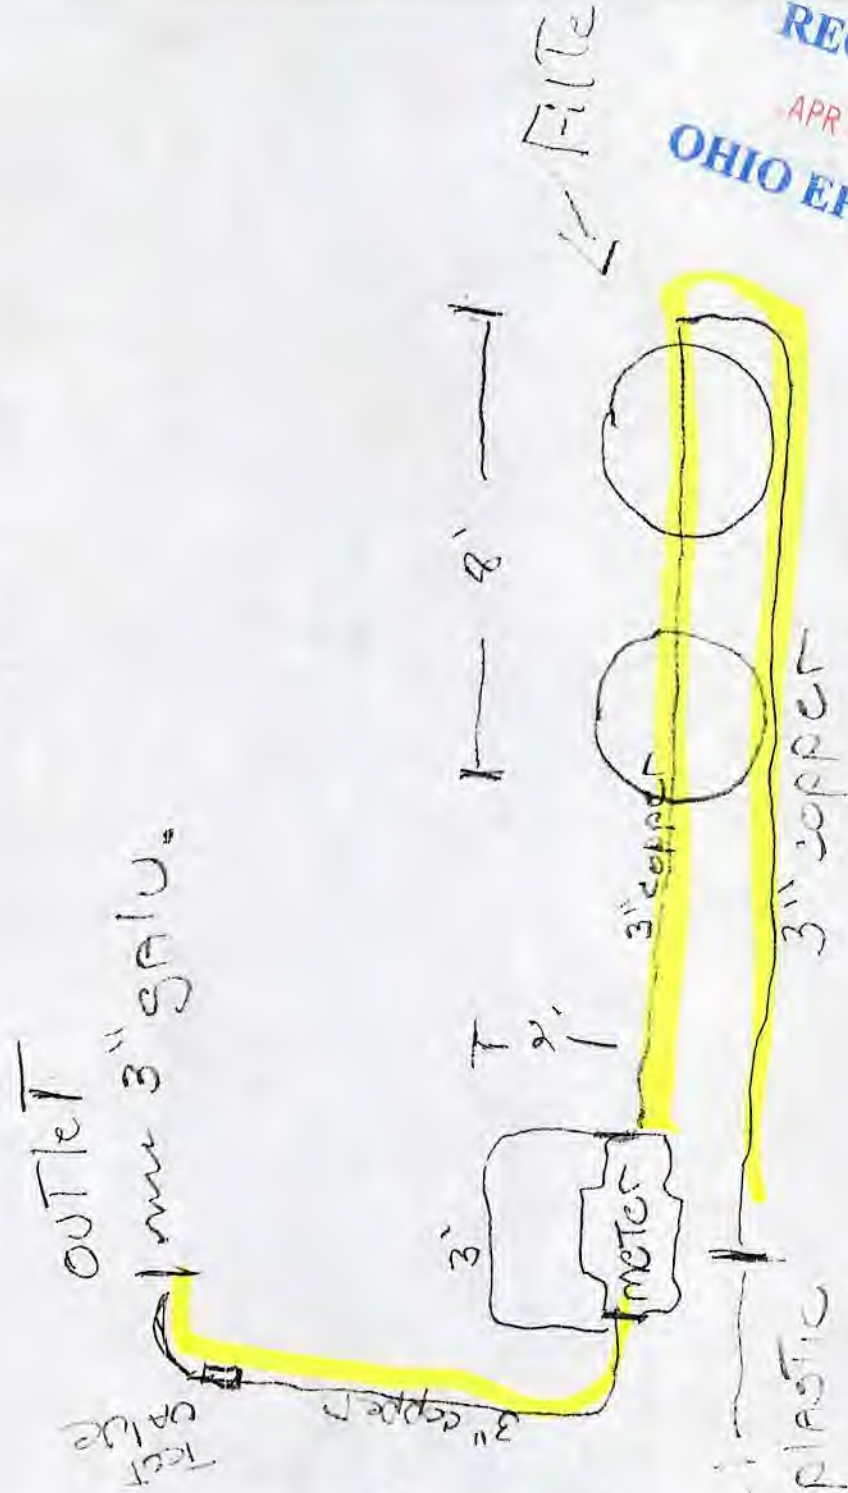


RECEIVED
APR 12 2017
OHIO EPA NEDO

Buildings in Ohio Built prior to 1998
or that use plumbing material manufactured before 1998 may have materials with greater than 8% lead and are at a higher risk of contributing lead to the drinking water than materials manufactured after 1998. In addition building built and plumbing materials manufactured after 2014 were required to have less than .25% lead by weight and have the lowest risk for contributing lead to the drinking water.

Elaine Zahrad

2" line only in service
REST HAS BEEN DISCONNECTED OR
NO LONGER THERE 4/10/17

Elaine M Zaharak

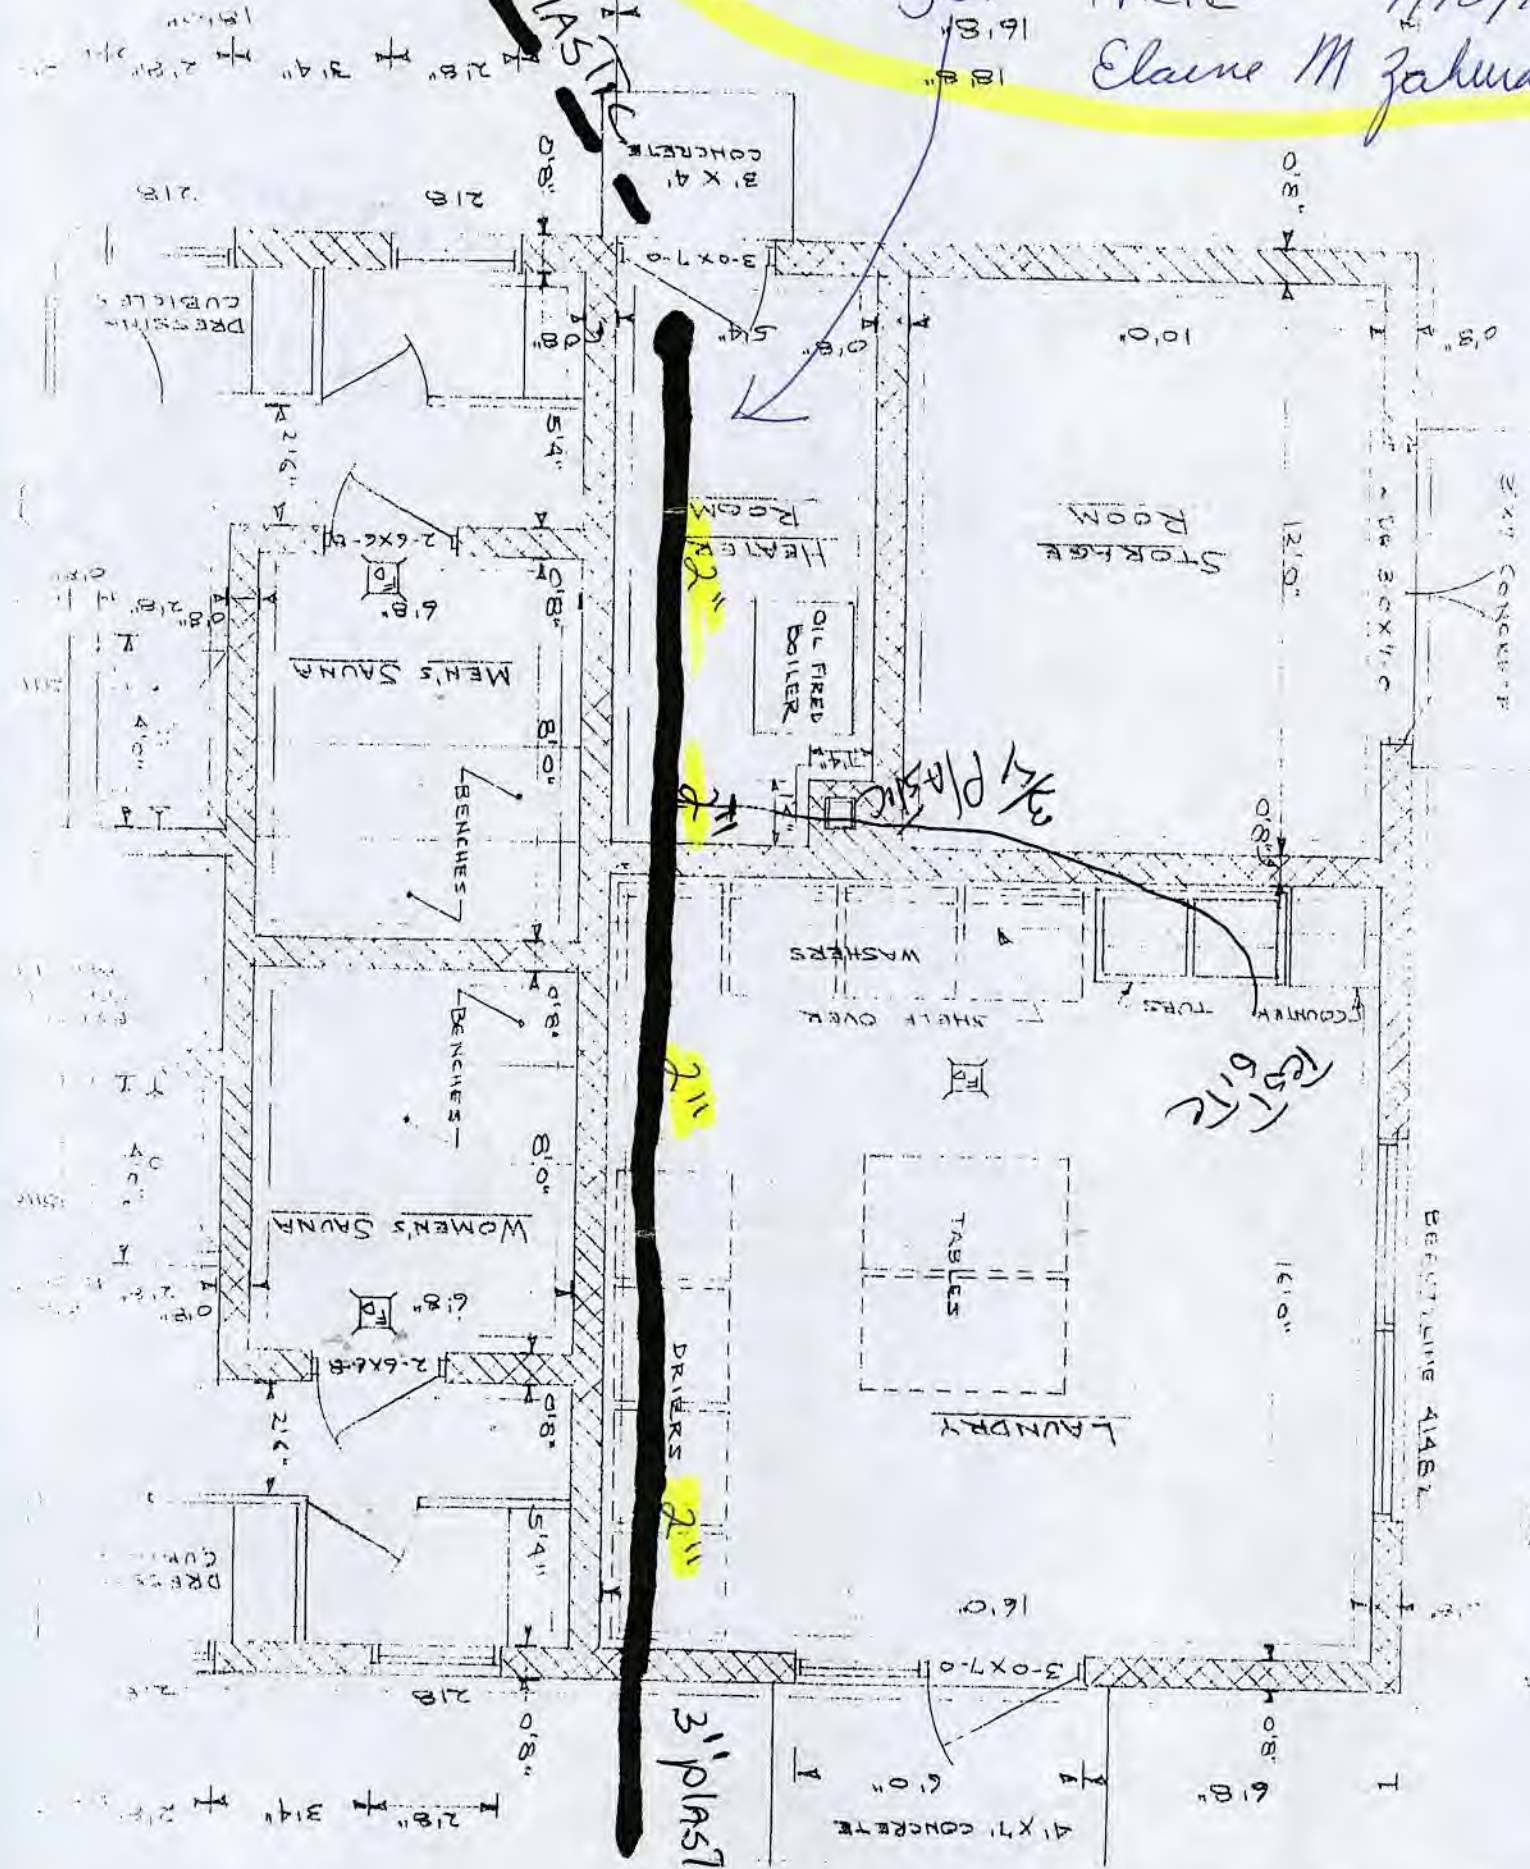

OHIO EPA NEDO
MAR 2 9 2017

RECEIVED


BANCROFT ROAD

N.E. PORTAGE COUNTY SANITARY SEWER DISTRICT
PART OF O.L. 36, NELSON TWP.
NELSON LEDGE ESTATES
PROJECT NO. _____

5
18

GARRETTSVILLE - PARKMAN

ROAD S.R.282

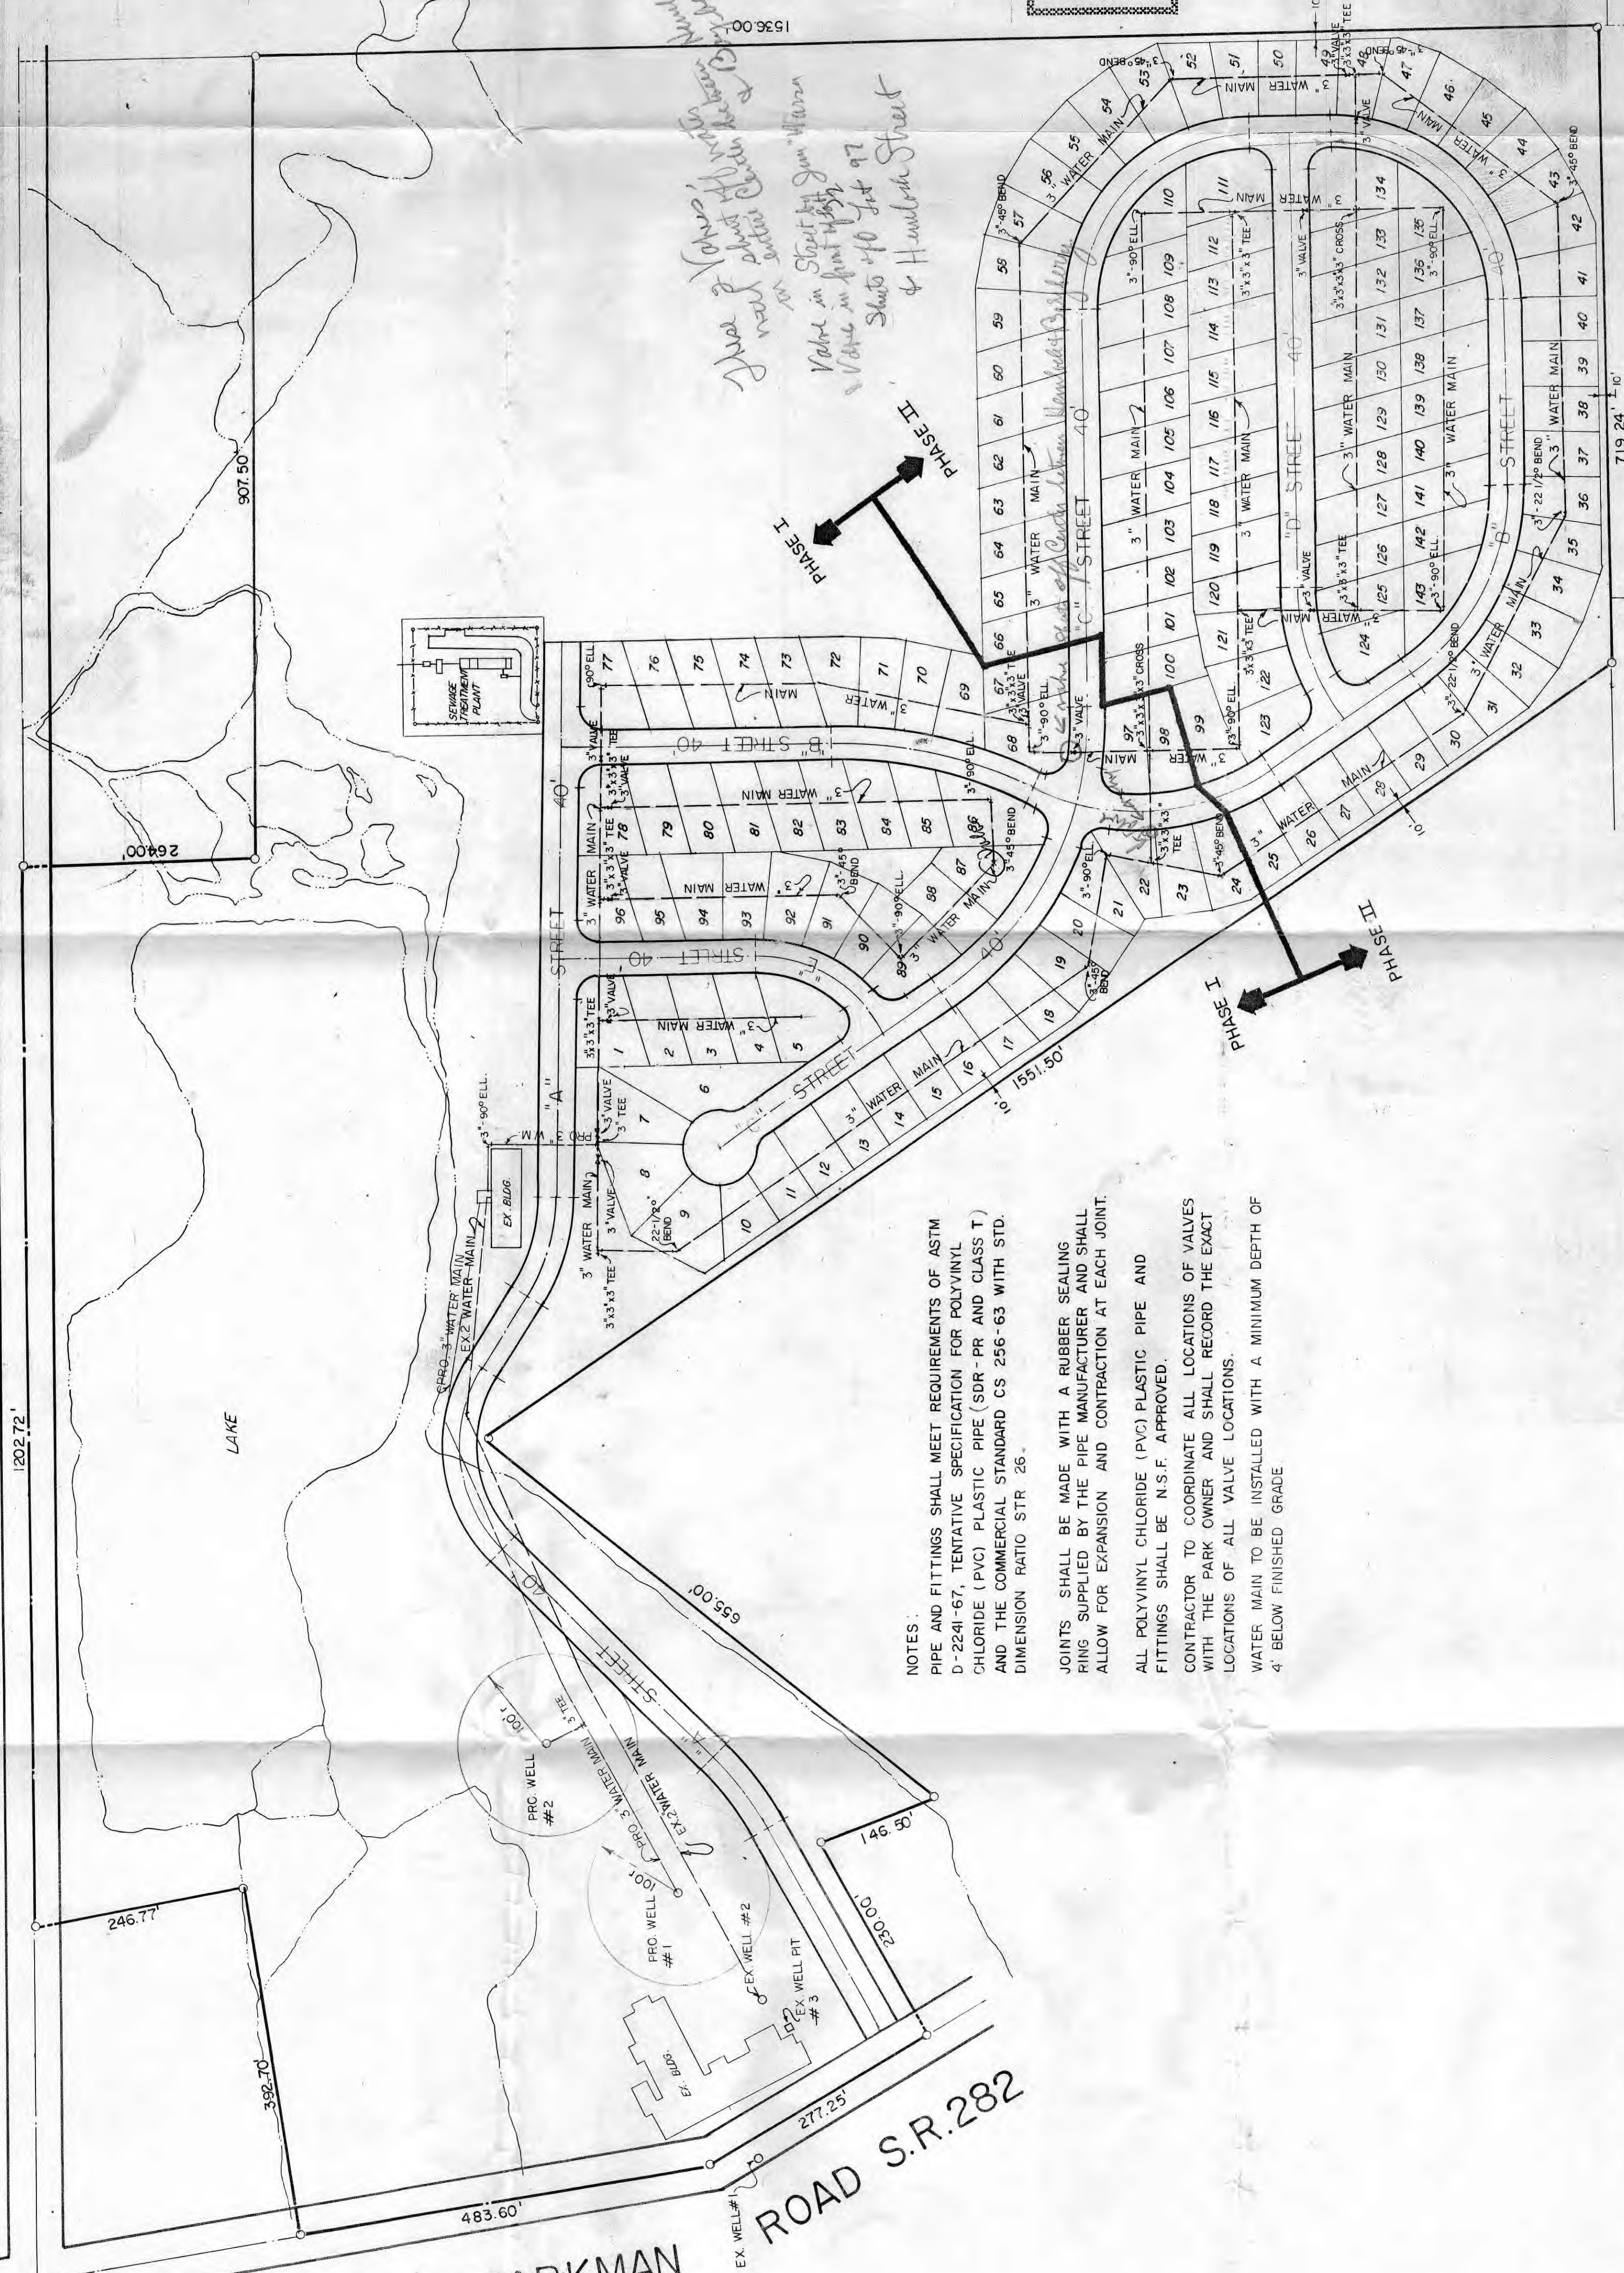

NOTES:
PIPE AND FITTINGS SHALL MEET REQUIREMENTS OF ASTM D-2241-67, TENTATIVE SPECIFICATION FOR POLYVINYL CHLORIDE (PVC) PLASTIC PIPE (SDR-PR AND CLASS T) AND THE COMMERCIAL STANDARD CS 256-63 WITH STD. DIMENSION RATIO STR 26.
JOINTS SHALL BE MADE WITH A RUBBER SEALING RING SUPPLIED BY THE PIPE MANUFACTURER AND SHALL ALLOW FOR EXPANSION AND CONTRACTION AT EACH JOINT.
ALL POLYVINYL CHLORIDE (PVC) PLASTIC PIPE AND FITTINGS SHALL BE N.S.F. APPROVED.
CONTRACTOR TO COORDINATE ALL LOCATIONS OF VALVES WITH THE PARK OWNER AND SHALL RECORD THE EXACT LOCATIONS OF ALL VALVE LOCATIONS.
WATER MAIN TO BE INSTALLED WITH A MINIMUM DEPTH OF 4' BELOW FINISHED GRADE

SEWERAGE
APPROVED
STATE OF OHIO DEPARTMENT OF HEALTH
AS EVIDENCED BY COPY OF
LETTER OF APPROVAL
HERE TO ATTACHED

BENCH MARK:
TOP OF IRON PIPE AT THE CENTERLINE
INTERSECTION OF STATE ROUTE 282
AND BANCROFT ROAD
U.S.G.S. ELEV 956.21

TRAILER PARK
APPROVED
STATE OF OHIO DEPARTMENT OF HEALTH
AS EVIDENCED BY COPY OF
LETTER OF APPROVAL
HERE TO ATTACHED

WATER SUPPLY
APPROVED
STATE OF OHIO DEPARTMENT OF HEALTH
AS EVIDENCED BY COPY OF
LETTER OF APPROVAL
HERE TO ATTACHED

RECEIVED
MAY 12 1972
OHIO DEPARTMENT OF HEALTH

ROBERT C. WINEBRENNER & ASSOCIATES CONSULTING ENGINEERS 1050 NORTH MAIN STREET • AKRON, OHIO 1-216-928-9087		NELSON LEDGE ESTATES OWNER / DEVELOPER IRENE WORK • GARRETTSVILLE, OHIO		GENERAL PLAN OF WATER SYSTEM		SCALE: 1"=100'	DRAWN BY: ejb	SHEET 5
							CHECKED BY:	
						DATE: NOV., 1971	REVISED:	
FILE NO. 590								