RECEIVED

MAY 1 5 2017

OHIO EPA NEDO

Entity:	•
Doc Type:	
Doc Subtype:	
Program:	
County:	
Secondary ID:	846714011

Add to eDOC 533902

townhomes At woodland Point

BH 6704012

Because it is practically impossible to determine the lead content of an installed fixture, fitting or pipe, it should be assumed that the manufacture or installation date is the primary indicator of the lead content. Therefore, the characteristics of buildings and piping solder or fixtures would be buildings in Ohio built prior to 1998 or that use plumbing material or solder manufactured before 1998 may have materials with greater than 8% lead and are at a higher risk of contributing lead to the drinking water than materials manufactured after 1998. In addition, built and plumbing materials manufactured after 2014 were required to have less than 0.25% lead by weight and have the lowest risk for contributing lead to the drinking water. It should be noted however that, although prohibited, some use of leaded solder or leaded components may have occurred after the prohibitions

VERIFICATION FORM FOR COMMUNITY PUBLIC WATER SYSTEMS CLAIMING NO LEAD SERVICE LINES

The owner or operator of all community public water systems must identify and map areas of their distribution system that are known or are likely to contain lead service lines. Systems must submit a copy of the applicable map to the Ohio Department of Health and the Ohio Department of Job and Family Services. Systems must also submit a report to the director containing at least both of the following: (1) The applicable map with narrative, and (2) A list of sampling locations used to collect samples as required by Ohio Revised Code (ORC) Section 6109.121 and any rules adopted thereunder, including contact information for the owner and occupant of each sampling

Should a water system determine no lead service lines exist in their distribution system, they must provide information stating they reviewed, at the minimum, historical permit records and local ordinances, distribution maintenance records and information pertaining to installation dates or materials for all services lines. This information must be verified below.


I HEREBY CERTIFY THAT THE FOLLOWING METHOD(S) WERE USED TO DETERMINE NO LEAD SERVICE LINES EXIST IN THIS WATER SYSTEM'S DISTRIBUTION SYSTEM, AS REQUIRED BY ORC 6109.121(F):

	LEAD SERVICE LINE VERIFIC	ATION
	This PWS states they have no lead service lin reviewed the following information (select on following):	nes and has le or more of the
-	 Historical permit records and/or local ordin Distribution maintenance records (i.e. me waterline break repairs) Information pertaining to installation dates (i.e. after 1986 when lead services lines w Service line material of all service lines is service lines are known to be PVC) 	ter replacement, s for all service lines
Am	14 Abunt 4/11/17 Inelof Responsible Person Date	PWS NAME: townhomes at Warthand PWS ID: OH 6704012 Pointe COUNTY: Portage
Date Ve	IO EPA use only:	NECEIVE NAPR 1-0 2017

Lead Mapping Verification Form Revised 2/14/17

I a erecuseroriencescese

Google Maps

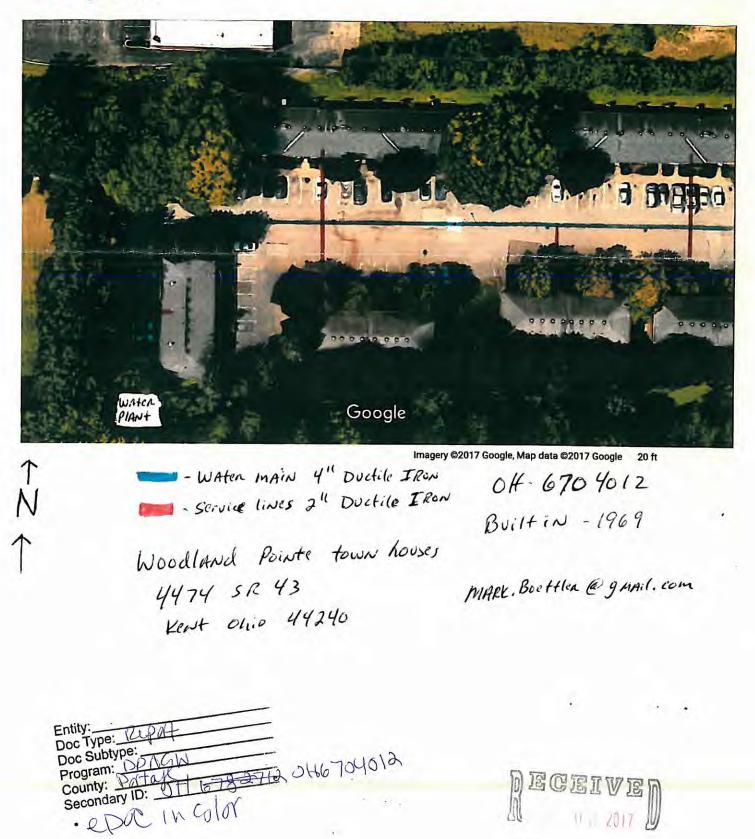

BY: